

CORNER RECORD (SEARCH)

(Ref. FSM 5151.4)

Tract or
Survey No.

**North Fork
John Dav Unit**

Cor.


No. **AP-381**

T. 7 S. R. 33 E.
Merid. Willamette

R.D. North Fork John Day
N.F. Umatilla

County Grant
State Oregon

CORNER DIAGRAM

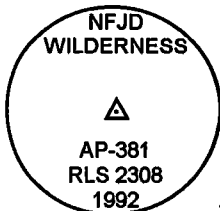

DESCRIBE CORNER MONUMENT FOUND

Found a 3 1/4" aluminum cap solidly set flush with the ground.

DESCRIBE BEARING TREES OR OTHER OFFICIAL ACCESSORIES FOUND

18" Western Larch Snag, with burnt out double blaze, S. 89 E., 33.2 feet.
23" Western Larch Snag, with burnt out double blaze, N. 1 W., 47.7 feet.

PHOTO IDENTIFICATION DATA

Photo No.
Filed At.
Object Ident.
Ident. By

Signature

DESCRIBE CORNER LOCATION RELATIVE TO NEAR-BY FEATURES, ALSO HOW TO REACH CORNER

From the junction of roads 52 and 5507 travel southerly on 5507 approximately 4.97 miles. Then walk southwesterly approximately 500 feet to the corner.

PLANE COORDINATE POSITION DATA

State: Zone:

X:

Y:

Datum:

Signature

D. Gaylord

Title

Land Surveyor

Division

Headquarters

S.O.

Date

04/25/1997

FS-7100-52 (3/97)

CORNER RECORD (PERPETUATION)

MONUMENT: DESCRIBE NEW MONUMENT SET, OR WORK DONE TO PRESERVE EXISTING MONUMENT

ACCESSORIES: DESCRIBE NEW BT'S WITNESS OBJECTS ETC. ESTABLISHED, OR WORK DONE TO PRESERVE EXISTING EVIDENCE

20" Ponderosa Pine scribed "WB/381 BT" on double blaze bears S. 23 1/4 E., 170.8 feet.

5/8" X 36" iron rod, set 35" into the ground with 3/4" brass washer "PLS 1636 WB 381" attached at ground level, bears S. 67 W., 65.5 feet.

Work Done By D. Gaylord

Title Land Surveyor

Date 04/25/1997

State Registration No.
or Agency

Certified Corner Record Prepared ?

Yes

No

Filed At:

Date

REMARKS

Index File No.

T.

R.

M.

Tract or Survey No.

NFJD Unit

Cor.

AP-381

USDA-FOREST SERVICE

Index
File No.

T. 7 S. R. 33 E.
Merid. WILLAMETTE

CORNER RECORD (SEARCH)
(Ref. FSM 7151.4)


R.D. NFJD
N.F. UMATILLA

Tract or
Survey No. NFJD Unit

County UMATILLA
State OREGON

Cor.
No. AP-381

CORNER DIAGRAM

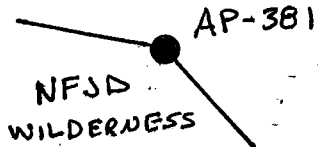

DESCRIBE CORNER MONUMENT FOUND

NONE

DESCRIBE BEARING TREES OR OTHER OFFICIAL ACCESSORIES FOUND

NONE

PHOTO IDENTIFICATION DATA

Photo No.:
Filed At.:
Object Ident.:
Ident. By:

Signature

DESCRIBE CORNER RELATIVE TO NEAR-BY FEATURES, ALSO HOW TO REACH CORNER

From the jct. of roads 52 and 5507 travel southerly on 5507 approx. 4.97 miles. Then walk southwesterly approx. 500 feet to the corner.

PLANE COORDINATE POSITION DATA

State: Oregon Zone: North
X: 2,467,022.84'
Y: 486,472.59'
Datum: NAD1927

Signature

D. Schlaich

Title

Land Surveyor

Division

Headquarters

S.O.

Date

06-1992

FS-7100-52 (3/68)

CORNER RECORD (PERPETUATION)

MONUMENT: DESCRIBE NEW MONUMENT SET, OR WORK DONE TO PRESERVE EXISTING MONUMENT
5/8" by 36" rebar, with a 3 1/4" aluminum cap, flush with the ground, marked "NFJD WILDERNESS AP-381 RLS 2308 1992".

ACCESSORIES : DESCRIBE NEW BT's WITNESS OBJECTS ETC. ESTABLISHED, OR WORK DONE TO PRESERVE EXISTING EVIDENCE
22" Western Larch, N. 8° W., 47.7 ft., mkd. "WB/381" "BT" on double blaze.
17" Western Larch, N. 82° E., 33.3 ft., mkd. "WB/381" "BT" on double blaze.
Both BT's have a 3/4" brass washer stamped "RLS 2308" nailed next to "BT" scribing on lower blaze.

Work Done By **D. Schlaich**

Title Land Surveyor

Date 06-1992

State Registration No.
or Agency

Certified Cor. Record Prepared ? NO

Filed At:

Date

REMARKS

Index File No.

T.

7 S.

R.

33 E.

M.

W.M.

Tract or Survey No.

NFJD Unit

Cor.

AP-381