

Index

File No.

T. 7 S. R. 34 E.

Merid. WILLAMETTE

CORNER RECORD (SEARCH)

(Ref. FSM 7151.4)

R.D. NFJD

N.F. UMATILLA

County GRANT

State OREGON


Tract or

Survey No. NFJD Unit

Cor.

No. AP-747

CORNER DIAGRAM

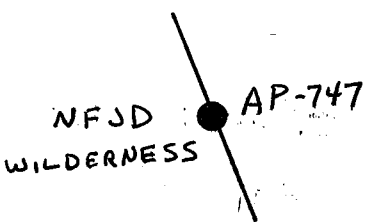

DESCRIBE CORNER MONUMENT FOUND

NONE

DESCRIBE BEARING TREES OR OTHER OFFICIAL ACCESSORIES FOUND

NONE

PHOTO IDENTIFICATION DATA

Photo No.:

Filed At.:

Object Ident.:

Ident. By:

Signature

DESCRIBE CORNER RELATIVE TO NEAR-BY FEATURES, ALSO HOW TO REACH CORNER

From the jct. of roads 52 and 5225 travel southeasterly on road 5225 approx. 2.05 miles. Then walk S. 25° W., approx. 500 feet to the corner.

PLANE COORDINATE POSITION DATA

State: Oregon Zone: North

X: 2,492,245.13'

Y: 488,227.78'

Datum: NAD1927

Signature

D. Schlaich

Title

Land Surveyor

Division

Headquarters

S.O.

Date

10-1993

FS-7100-52 (3/68)

CORNER RECORD (PERPETUATION)

MONUMENT: DESCRIBE NEW MONUMENT SET, OR WORK DONE TO PRESERVE EXISTING MONUMENT

Set a 5/8" by 36" rebar, with a 3 1/4" aluminum cap, flush with the ground, marked "NFJD WILDERNESS AP-747 RLS 2308 1993".

ACCESSORIES: DESCRIBE NEW BT's WITNESS OBJECTS ETC. ESTABLISHED, OR WORK DONE TO PRESERVE EXISTING EVIDENCE

6" Lodgepole Pine, S. 1° E., 15.1 ft., mkd. "WB/747""BT" on double blaze.

20" Western Larch, S. 83° W., 20.0 ft., mkd. "WB/747""BT" on double blaze.

Both BT's have a 3/4" brass washer stamped "RLS 2308" nailed next to "BT" scribing on lower blaze.

Work Done By **D. Schlaich**

Title Land Surveyor

Date **10-1993**

State Registration No.
or Agency

Certified Cor. Record Prepared ? **NO**

Filed At:

Date

REMARKS

Index File No.

T.

7 S.

R.

34 E.

M.

W.M.

Tract or Survey No.

NFJD Unit

Cor.

AP-747