

FIELD NOTES

Of the survey of the

*Exteriors*Lines of *Tps. 1, 2, 100**R's 31, 33, 34 & 35, E. Tps. 2, 3, 4, 35* Willamette Meridian, Oregon,as surveyed by *James P. Currier and James E. Poland*
their special

U. S. Deputy Surveyor, under his Contract No. _____

dated *May 4th*, 1887Survey commenced, *June 14th*, 1887Survey completed, *Aug 30th*, 1887

NAMES AND DUTIES OF ASSISTANTS.

L. J. Wooley, Compassman.
J. Medley, Chainman.
W. H. Medley, Chainman.
Guy Davis, Chainman.
Frank Selshard, Chainman.
J. P. Crowner, Axman.
J. A. Hadley, Axman.
_____, Flagman.

PRELIMINARY OATHS OF ASSISTANTS.

36 We, J. S. Medley, W. H. Medley, Frank Behshaw
and Guy Davis

do solemnly swear that we will faithfully execute the duties of Chain Carriers; that we will level the chain over even and uneven ground, and plumb the tally pins, either by sticking or dropping the same; that we will report the true distance to all notable objects, and the true length of all lines that we will assist in measuring, to the best of our skill and ability, and in accordance with the instructions given us in the survey

of the Exterior lines of Twp. 10, R. 32, 33 & 34 E. Twp. 21, R. 33 & 35 E. Twp. 1 lines of A. R. 32, 33, 34 & 35 E. Twp. 21, R. 32, 34 & 35 E. Willamette Meridian, Oregon.

J. S. Medley, Chainman.
W. H. Medley, Chainman.
Frank Behshaw, Chainman.
Guy Davis, Chainman.

Subscribed and sworn to before me this 14th day of June, 1887

[SEAL.] James P. Currier
U.S. Deputy Surveyor

We, B. B. Crowner and J. R. Haddley, do solemnly swear that we will well and truly perform the duties of Axmen in the establishment of corners and other duties, according to instructions given us, and to the best of our skill and ability, in the survey of the

Exterior lines, Twp. 10, R. 32, 33 & 34 E. Twp. 21, R. 33 & 35 E. Twp. 1 R. 32, 33, 34 & 35 E. Willamette Meridian, Oregon.

B. B. Crowner, Axman.
J. R. Haddley, Axman.

Subscribed and sworn to before me this 14th day of June, 1887


[SEAL.] James P. Currier
U.S. Deputy Surveyor

INDEX

365

Referring the Lines to the Pages of the Field Notes.

T. *2 South* R. *33 East* Will. Mer.

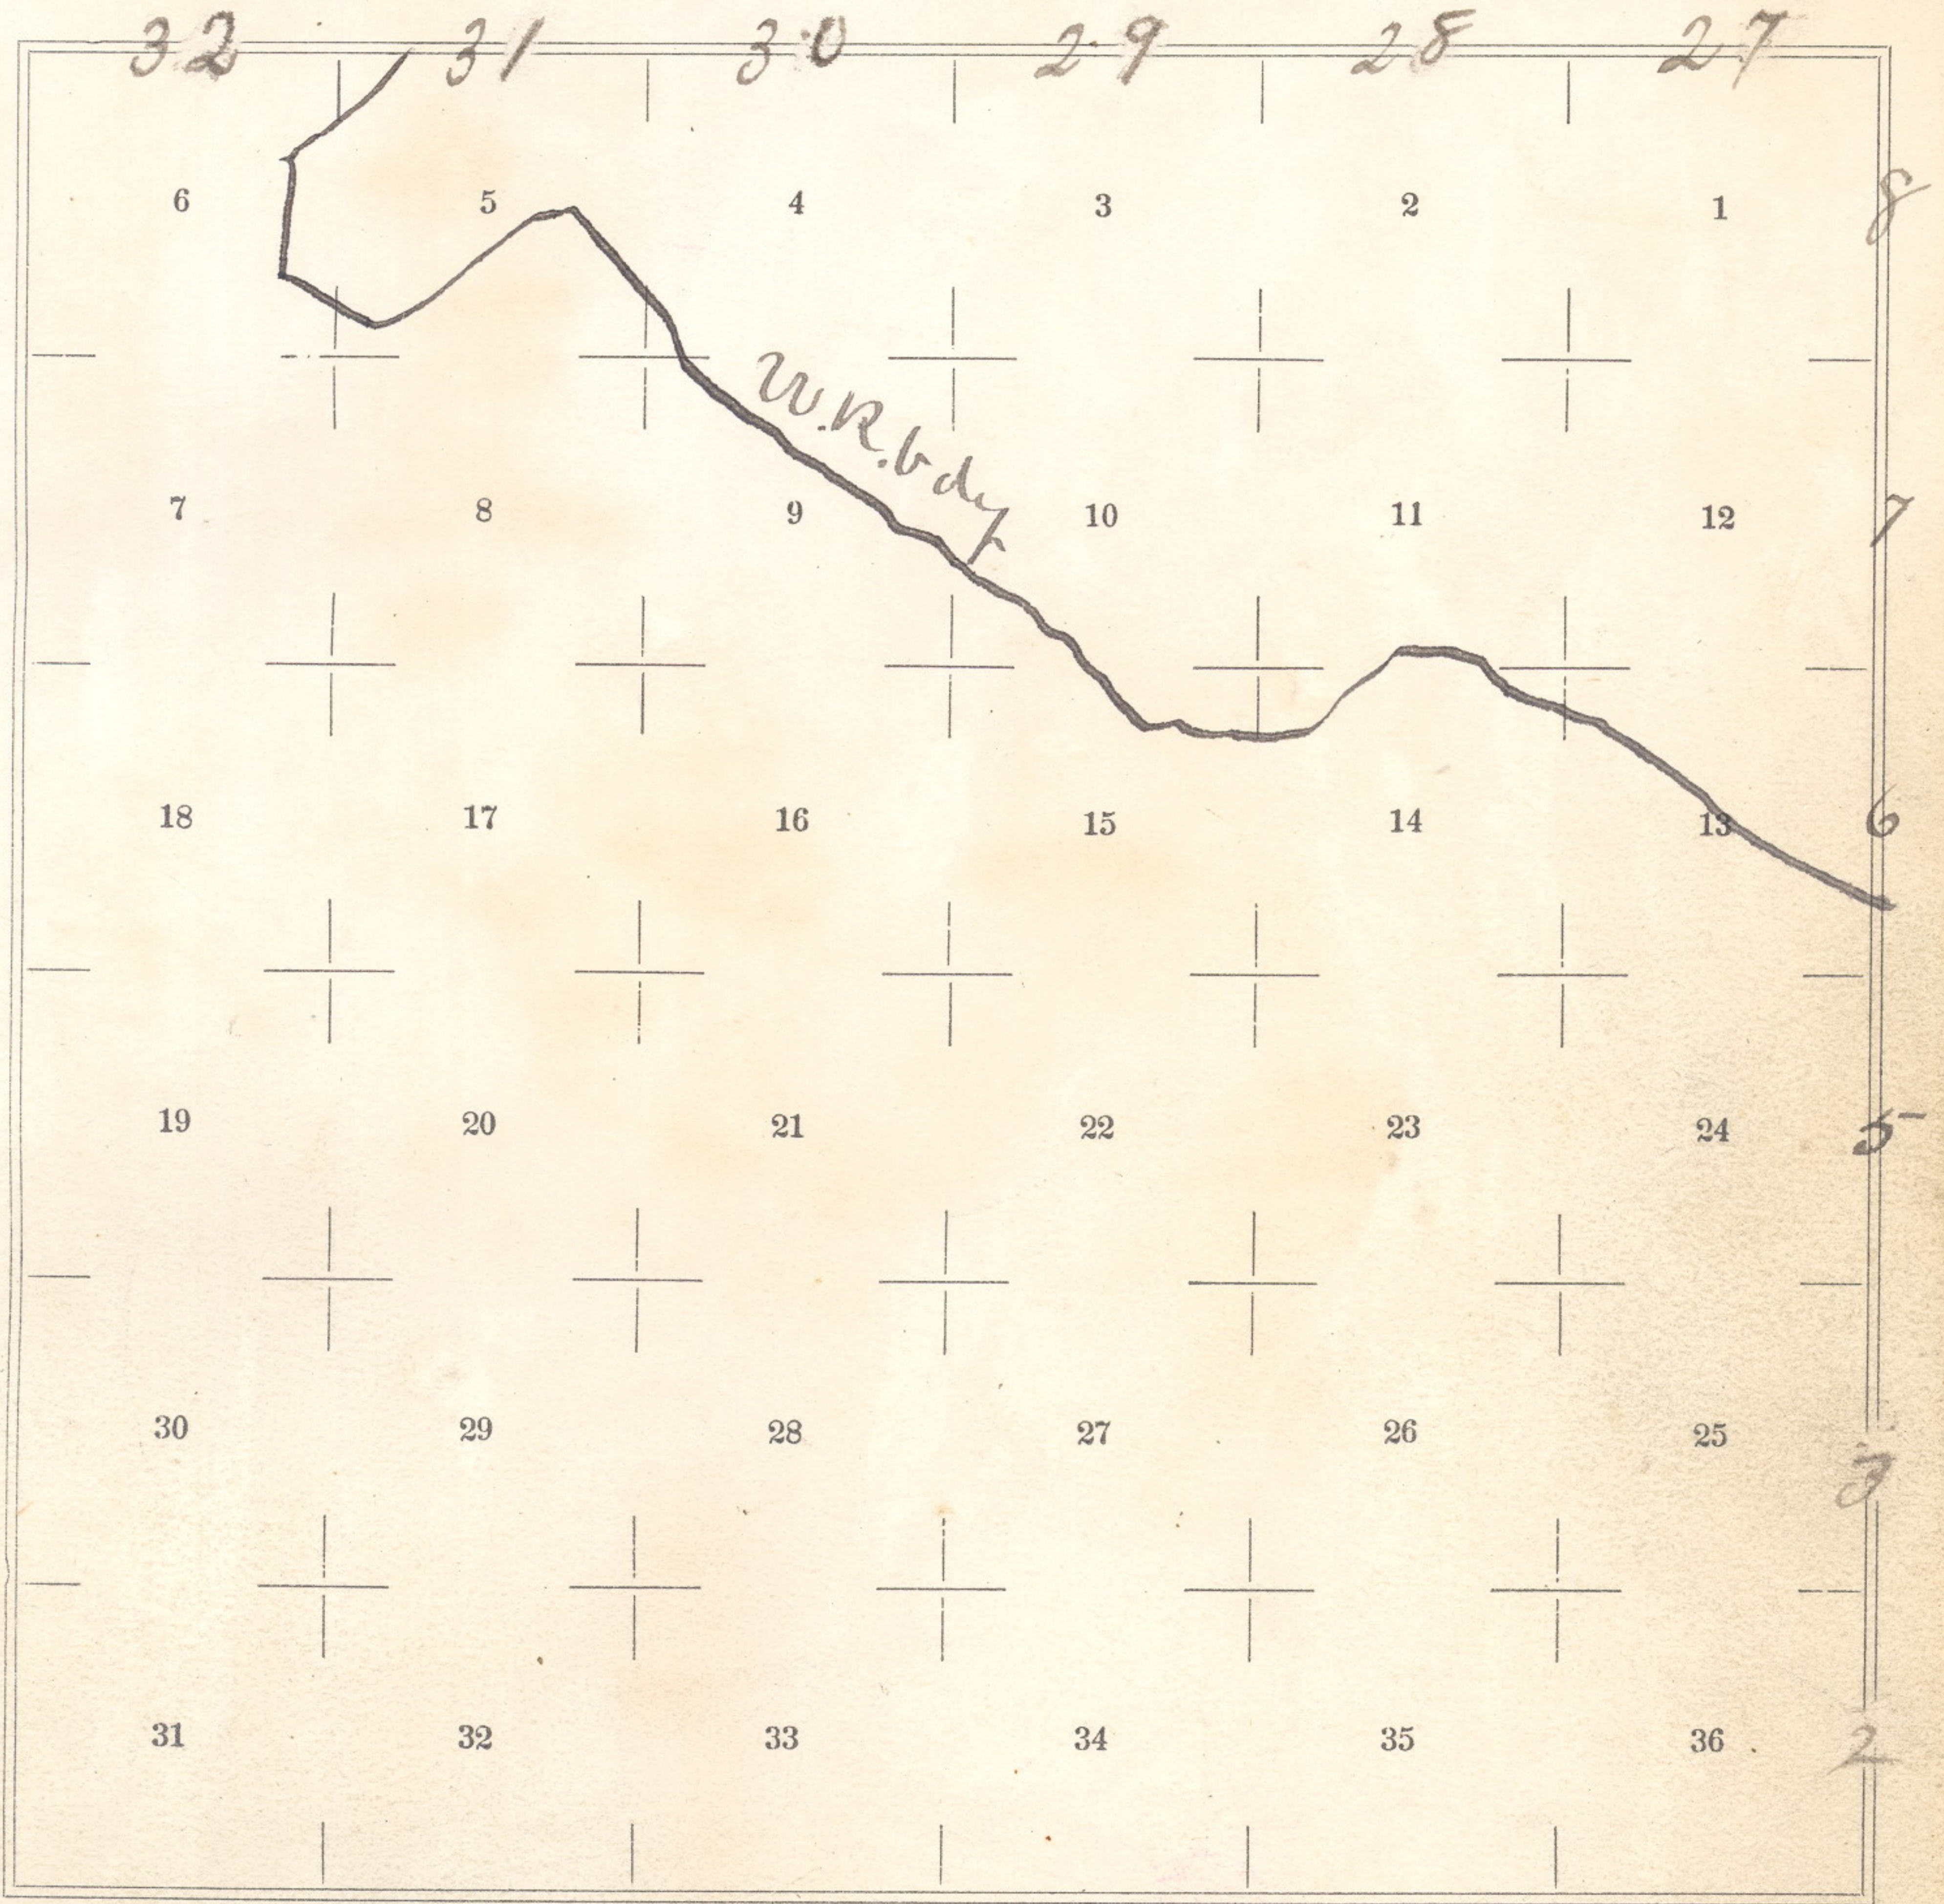

Meanders of _____, Pages _____ to _____

Meanders of _____, Pages _____ to _____

366 ~~367~~ ~~368~~ ~~369~~ ~~370~~

INDEX

Referring the Lines to the Pages of the Field Notes.

T. 1 South R. 34 East Will. Mer.

40	6	5	4	3	2	1	23
38	7	8	9	10	11	12	22
37	18	17	16	15	14	13	20
36	19	20	21	22	23	24	19
35	30	29	28	27	26	25	18
34	31	32	33	34	35	36	17
	16	15	14	13	12	11	25

Sp. 1 S. R. 35 E

Meanders of _____ Pages _____ to _____

Meanders of _____ Pages _____ to _____

T28 35 E 6

Extremities of T. 1 South R. 33 East -

Willamette Meridian, Oregon.

(8093-10 M.)

North lat. Secs. 1 + 6

Var 19° E

6.00	Common Course N.	-50	-50
18.75	" " "	-100	-100
34.00	Top of Ridge	+250	+250
40.00	Set a basalt-stone 10 x 10 x 8 ins 7 ins in the ground for 1/4 Sec. Cor. Mtcd 1/4 on W. face, from which a pine 12 ins in diam. ls. N 82° E dist. 17 lks. mtcd 1/4 S. B. T. no other tree in limits raised mound of stone alongside pits in practicable		
57.50	Enter creek bottom		
71.50	North fork of McKay Creek Course S. N. 20 lks. wide	-250	-250
86.60	Intersect-baseline 7.00 chs. W of 1/4 Sec. cor. on S. side of Sec. 31. T. 1, N. R. 34 E. At point of intersection in place, a stone 6 x 3 x 1 ft - above gr ound which I marked for Closing Cor. to T. 1 S. R. 33 + 34 E. with		

411
41

Extremities of T. 1 South R. 33 East
Willamette Meridian, Oregon.

6 notches on S. E & W edges, and C.C.
on S. face, & cross (+) at exact po-
int of intersection. Raised a road
of Stone Along side Disfranchisement
Land Mountains 86.65 Chs
Soil Rocky 3rd rate
Timber Pine & Cottonwood

This Township is rough, hilly,
& broken. Creek bottoms narrow
& gravelly, with pine & Cotton-
wood timber & dense underbr-
ush of Thorn willow Sumach &c.
Nearly all the canyons have se-
cturing pine timber. Hills are
covered with good bunch
grass

July 10-1887

FINAL OATHS FOR SURVEYS.

A list of the names of the individuals employed by James P. Currier
and James E. Holland, U. S. Deputy Surveyors, to assist in
 running, measuring, and marking the lines and corners described in the
 foregoing field notes of the survey of the Exterior lines of Tps. 1 & 2 N.
Rs. 32, 33, 34 E, Tps. 2 N. R. lines of 33 & 35 E, Tps. 1 & 2 N. Rs. 32, 33, 34 & 35 E
Tps. 2 N. Rs. 32, 34 & 35 E Willamette Meridian, Oregon,
 showing the respective capacities in which they acted:

- L. A. Wooley , Compassman.
- J. J. Medley , Chainman.
- W. H. Medley , Chainman.
- Frank Belshaw , Chainman.
- Guy Davis , Chainman.
- B. B. Crowner , Axman.
- J. R. Hadley , Axman.
- , Flagman.

FINAL OATHS OF ASSISTANTS.

We hereby certify that we assisted James P. Currier and James
E. Holland, U. S. Deputy Surveyors, in surveying
 all those parts or portions of the Exterior lines of Tps. 1 & 2 N. Rs. 32, 33, 34 E
Tps. 2 N. Rs. 33 & 35 E, Tps. 1 & 2 N. Rs. 32, 33, of 34 & 35 E, Tps. 2 N. Rs.
3, 2, 34, & 35 E Willamette Meridian, Oregon,
 as represented in the foregoing field notes as having been surveyed by
 him and under his direction; and that said survey has been in all respects,
 to the best of our knowledge and belief, well and faithfully surveyed,
 and the corner monuments established, according to the instructions
 furnished by the U. S. Surveyor General of Oregon.

- L. A. Wooley , Compassman.
- J. J. Medley , Chainman.
- W. H. Medley , Chainman.
- Frank Belshaw , Chainman.
- Guy Davis , Chainman.
- B. B. Crowner , Axman.
- J. R. Hadley , Axman.
- , Flagman.

Subscribed and sworn to before me this 30th day of
September, 1887.

[SEAL.]

James P. Currier
 U. S. Deputy Surveyor.

FINAL OATH OF DEPUTY SURVEYOR.

We, James P. Currier and James E. Poland, United States
Deputy Surveyor, do solemnly swear that in pursuance of instructions
received from Douglas H. Taylor, U. S.

Surveyor General for Oregon, bearing date of the 13th

day of May, 1887, I have well, faithfully,
and truly, in my own proper person, and in strict conformity with the
instructions furnished by the U. S. Surveyor General for Oregon, the
Surveying Manual, and the laws of the United States, surveying all

those parts or portions of Exterior lines of Twp. 1 N., R. 32, 33 & 34 E., Twp. 1

2 N., R. 33 & 35 E., Twp. 1 N., R. 32, 33, 34 & 35 E., Twp. 2 N., R. 32, 34 & 35 E.

Willamette Meridian, in the State of Oregon, as are represented in the
foregoing field notes as having been surveyed by me and under my
directions; and I do further solemnly swear that all the corners of said
survey have been established and perpetuated in strict accordance with
the Surveying Manual, printed instructions, the special written instruc-
tions of the U. S. Surveyor General for Oregon, and in the specific man-
ner described in the field notes, and that the foregoing are the *true* field
notes of such survey, and should any fraud be detected I will suffer the
penalty of perjury under the provisions of an act of Congress approved
August 8, 1846.

James P. Currier James E. Poland
U. S. Deputy Surveyors

Subscribed and sworn to before me this Fifteenth

day of February, 1888

W. Woodcock
Notary Public
for Oregon

Office of U. S. Surveyor General,

Portland, Oregon, June - 11th/₄, 1888.

foregoing

The following Field Notes of the Survey of the

Eastern lines of T. 1 S. Rgs 32.

34. E. T. 2 S. Rgs 33 and 35

T. 1 N. Rgs 32-33-34 and 35 East

T. 2 N. Rgs 32-34 and 35 East

Will. Mel. Or.

executed by James J. Currier and James E. Noel

Special Joint U.S. Dept. Surveyors

under his Contract No. —, dated May

4th, 1887, having been critically examined,

the necessary corrections and explanations made, the

said Field Notes and the survey they describe, are

hereby approved.

Douglas W. Taylor

Surveyor General.