

# FIELD NOTES

165

Of the survey of the Exterior

Lines of the diminished Umatilla

Reservation Willamette Meridian,

Oregon, as surveyed by Jas. G. Carrin and

Jos. E. Holland

U. S. Deputy Surveyor, under his Contract No. \_\_\_\_\_

dated May 4<sup>th</sup> 1888 1887 ✓

Survey commenced, Oct 24<sup>th</sup> 1887

Survey completed, November 4<sup>th</sup> 1887

## NAMES AND DUTIES OF ASSISTANTS,

- L. J. Woolley ..... , Compassman.
- E. L. Perry ..... , Chainman.
- Guy Davis ..... , Chainman.
- J. R. Hadley ..... , Chainman.
- C. L. Raper ..... , Chainman.
- C. Moore ..... , Axeman.
- J. W. Gordon ..... , Axeman.
- ..... , Flagman.



PRELIMINARY OATHS OF ASSISTANTS.

We, \_\_\_\_\_

*G. S. Perry, Guy Davis, J. R. Madley, C. Kaper*

do solemnly swear that we will faithfully execute the duties of Chain Carriers, that we will level the chain over even and uneven ground, and plumb the tally pins, either by sticking or dropping the same; that we will report the true distance to all notable objects, and the true length of all lines that we will assist in measuring, to the best of our skill and ability, and in accordance with the instructions given us in

the survey of the \_\_\_\_\_

*Exterior*

lines of \_\_\_\_\_

*Diminished*

*Reservation*

Willamette Meridian, Oregon.

\_\_\_\_\_, Chainman.

*G. S. Perry*

\_\_\_\_\_, Chainman.

*Guy Davis*

\_\_\_\_\_, Chainman.

*J. R. Madley*

\_\_\_\_\_, Chainman.

*C. Kaper*

Subscribed and sworn to before me, this \_\_\_\_\_

*Twenty fourth*

day of \_\_\_\_\_

*October*

188\_\_\_\_



[SEAL.]

*James E. Holand*

*U.S. Dept. Surveyor*

We, \_\_\_\_\_

*C. Moses, J. H. Stenison*

and \_\_\_\_\_

do solemnly swear that we will well and truly perform the duties of Axemen in the establishment of corners and other duties, according to instructions given us, and to the best of our skill and ability,

in the survey of the \_\_\_\_\_

*Exterior lines of*

*the Diminished Reservation* Willamette Meridian, Oregon.

\_\_\_\_\_, Axeman.

*C. Moses*

\_\_\_\_\_, Axeman.

*J. H. Stenison*


Subscribed and sworn to before me, this \_\_\_\_\_

*Twenty fourth*

day of \_\_\_\_\_

*October*

188\_\_\_\_

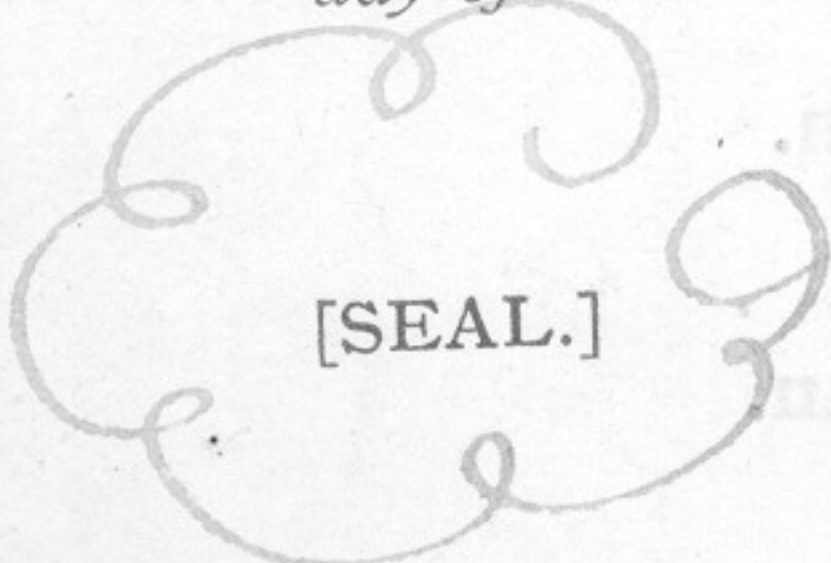

[SEAL.]

*James E. Holand*

*U.S. Dept. Surveyor*



R33E

R34E *Index*

R35E

R36E

168  
T4N

169  
T4N

T3N

T3N

T2N

T2N

T1N


T1N

R33E

R34E

R35E

R36E

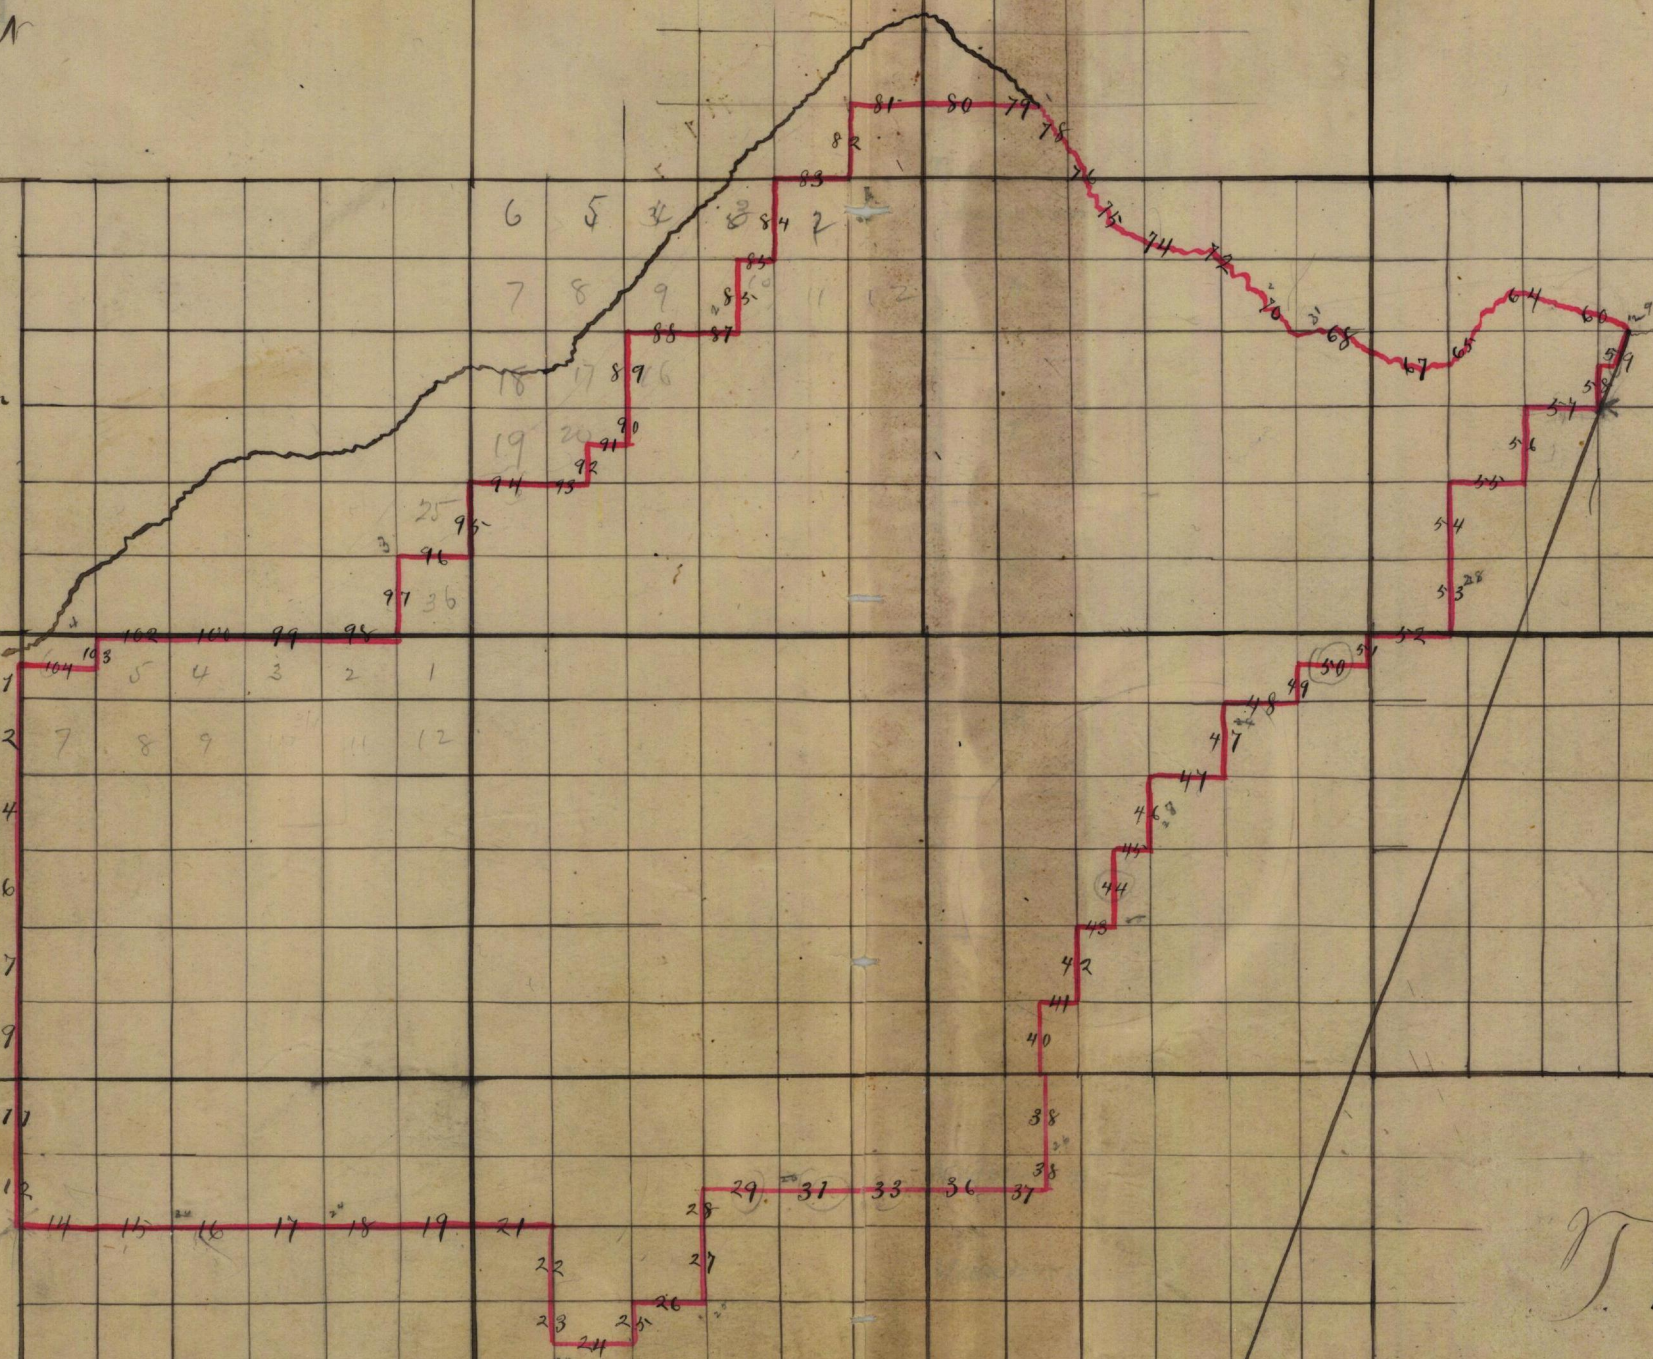



190

Exterior of T. Quinniaheo R. Reservation  
Willamette Meridian, Oregon.

(8093-10 M.)

Ascend

7975

Con to sec. 13<sup>rd</sup> and 12 on  
Township line bet. Tps 1<sup>st</sup> &  
Rgs 33<sup>rd</sup> and 34 East which  
is a basalt stone and mound  
of stone and which I mark.

Q.R. on N. face

Land mountainous and  
rocky 79.75 chs

Soil 3<sup>rd</sup> rate

Good grass



### FINAL OATHS FOR SURVEYS.

A list of the names of the individuals employed by James P. Carrin  
and James C. Roland, U. S. Deputy Surveyor, to assist in  
 running, measuring and marking the lines and corners described in the foregoing field  
 notes of the survey of the Exterior  
Umatilla Reservation lines of the Diminished  
Willamette Meridian, Oregon,  
 showing the respective capacities in which they acted:

- L. J. Woolley -----, **Compassman.**
- E. G. Perry -----, **Chainman.**
- Guy Davis -----, **Chainman.**
- A. R. Hadley -----, **Chainman.**
- C. Raper -----, **Chainman.**
- H. Moses -----, **Axeman.**
- J. H. Henderson -----, **Axeman.**
- , **Flagman.**

### FINAL OATHS OF ASSISTANTS.

We hereby certify that we assisted James P. Carrin and  
James C. Roland, U. S. Deputy Surveyor, in surveying all  
 those parts or portions of the Exterior  
lines of the Diminished  
Umatilla Reservation Willamette Meridian, Oregon,  
 as are represented in the foregoing field notes as having been surveyed by him and under  
 his direction; and that said survey has been in all respects, to the best of our knowledge  
 and belief, well and faithfully surveyed, and the corner monuments established, according  
 to the instructions furnished by the U. S. Surveyor General of Oregon.

- L. J. Woolley -----, **Compassman.**
- E. G. Perry -----, **Chainman.**
- Guy Davis -----, **Chainman.**
- A. R. Hadley -----, **Chainman.**
- C. Raper -----, **Chainman.**
- H. Moses -----, **Axeman.**
- J. H. Henderson -----, **Axeman.**
- , **Flagman.**

Subscribed and sworn to before me, this fourth day of  
November 1887

[SEAL.] James C. Roland  
U. S. Deputy Surveyor



FINAL OATH OF DEPUTY SURVEYORS

We James P. Currier and James E. Holand  
United States Deputy Surveyors, do solemnly swear that in pursuance of

instructions received from Douglas H. Taylor

U. S. Surveyor General for Oregon, bearing date of the 20<sup>th</sup>

day of August 1888, I have well, faith-

fully and truly, in my own proper person, and in strict conformity with the instructions furnished by the U. S. Surveyor General for Oregon, the Surveying Manual, and the laws of the United States, surveying all those

parts or portions of the Exterior bdy. of the Diminished Reservation

Willamette Meridian, in the State of Oregon, as are represented in the foregoing field notes as having been surveyed by me and under my directions; and I do further solemnly swear that all the corners of said survey have been established and perpetuated in strict accordance with the Surveying Manual, printed instructions, the special written instructions of the U. S. Surveyor General for Oregon, and in the specific manner described in the field notes, and that the foregoing are the true field notes of such survey, and should any fraud be detected I will suffer the penalty of perjury under the provisions of an Act of Congress approved August 8, 1846.

James P. Currier, James E. Holand  
U. S. Deputy Surveyors

Subscribed and sworn to before me, this 23<sup>rd</sup>

day of February 1888

Allen Woodcock  
Notary Public  
for Oregon





## Office U. S. Surveyor General,

Portland, Oregon, October 6<sup>th</sup> - 1888The ~~following~~ <sup>foregoing</sup> Field Notes of the Survey of the \_\_\_\_\_of the Boundary Lines  
of the Diminished \_\_\_\_\_\_\_\_\_\_ Unatilla Indian  
Reservation Oregon  
executed by James P. Curran and James O. Nolan  
Special U. S. Dept. Surveyors.  
under his Contract No. \_\_\_\_\_, dated May 4\_\_\_\_\_ 1887, having been critically examined, the  
necessary corrections and explanations made, the said Field Notes  
and the survey they describe, are hereby approved.Douglas W. Taylor  
Surveyor General.