


Township N° 1 North, of Range N° 31 East of the Willamette Meridian Oregon.

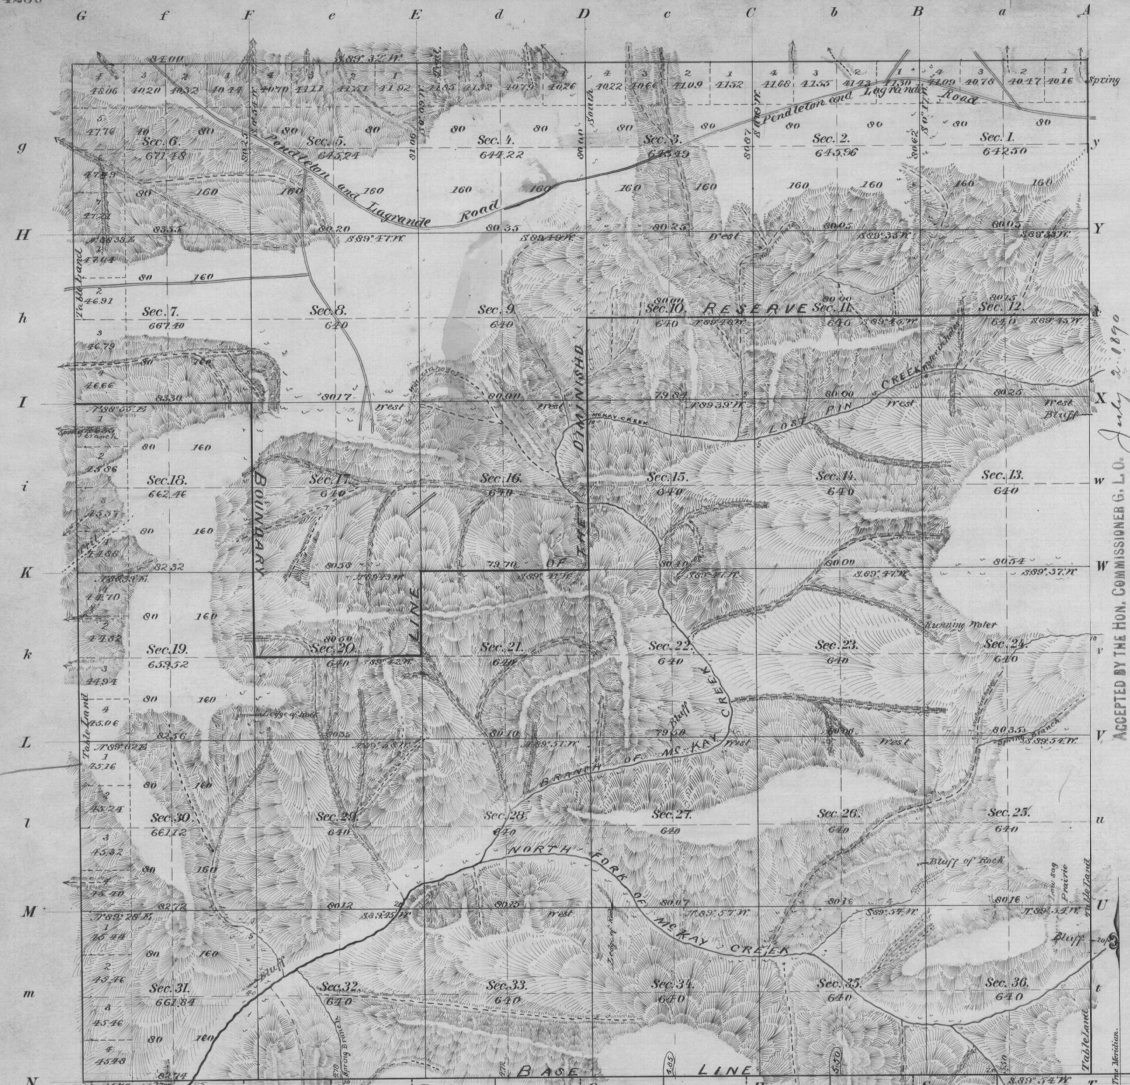

Mearners of

Paste	Courses	Ch ^t Lk ^t	Paste	Courses	Ch ^t Lk ^t	Paste	Courses	Ch ^t Lk ^t

ACCEPTED BY THE HON. COMMISSIONER G. L. O. *July 2, 1890*

Total number of Acres within Diminished Reserve 87400.25 Number of Acres outside of Diminished Reserve 19804.92
Total number of Acres 23,230.23 Scale 80 Chains to an Inch.

Surveys Designated	By Whom Surveyed	Date of Contract	Amount of Surveys M. Ch.	When Surveyed	Mean Declination
Township lines	Curran and Pitard	May 23 1887	60 20 59	Aug. 22, 1888 & 1887	19. 30' E.
Subdivisions					

The above Map of Township N° 1 North of Range N° 31 East of the Willamette Meridian, Oregon, is truly conformable to the field notes of the survey thereof on file in this Office, which have been examined and approved.

Surveyor General's Office, } Douglas W. Taylor, }
Portland, Oregon June 12 1890 } Sur. Genl.