





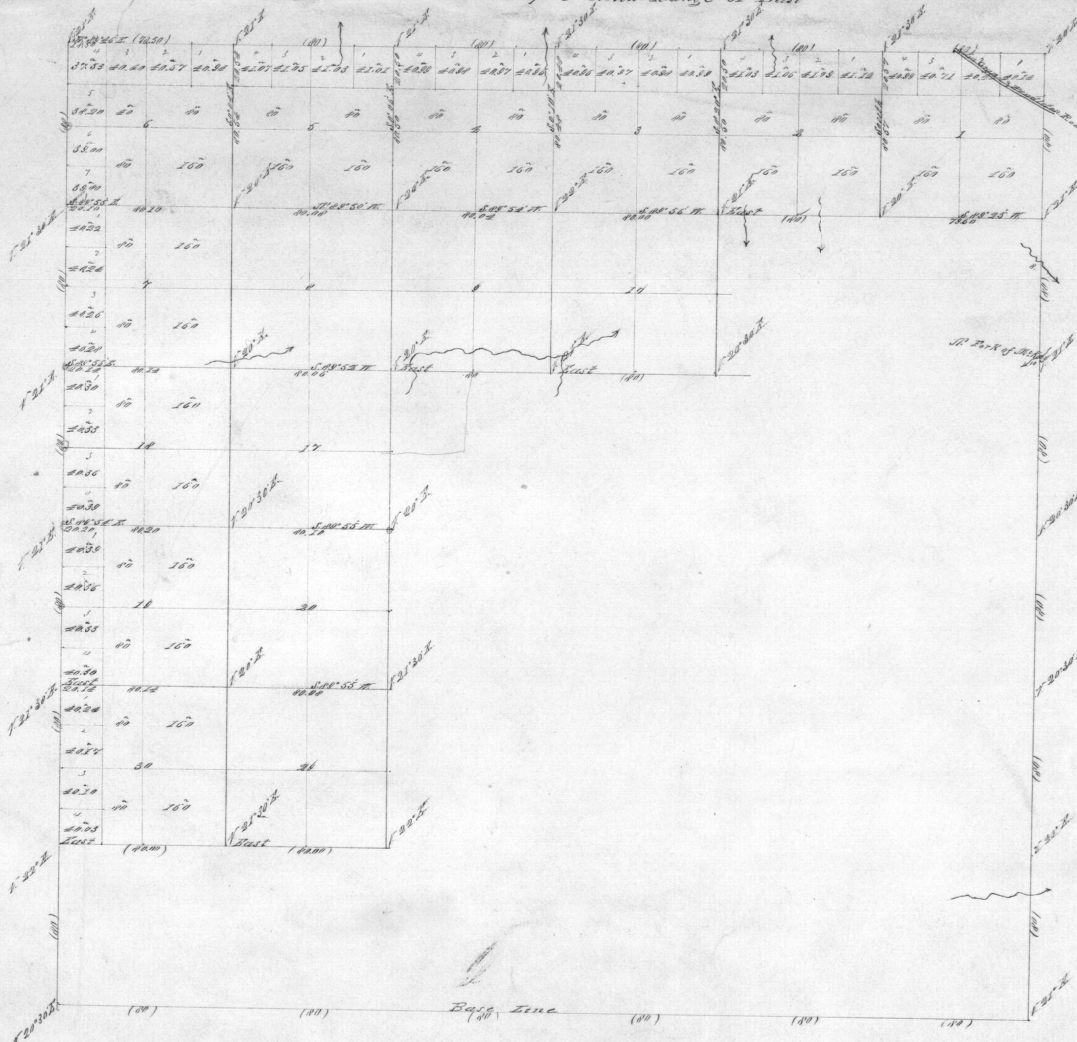

General Description  
 The land in this township  
 is hilly soil 2<sup>nd</sup> rate good  
 grade

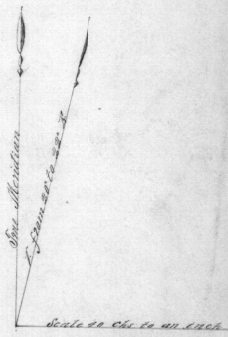

Line	Contractors	Contract No.	Contract Date	First Surveyed	Final Surveyed	Commenced	Completed


