

FIELD NOTES

Of the survey of the Subdivisional
 Lines of Township 1 North
Range 37 East, Willamette Meridian,
 Oregon, as surveyed by Human D. Graham


U. S. Deputy Surveyor, under his Contract No. H 52

dated June 16", 1882

Survey commenced, August 30", 1882

Survey completed, September 10", 1882

NAMES AND DUTIES OF ASSISTANTS.

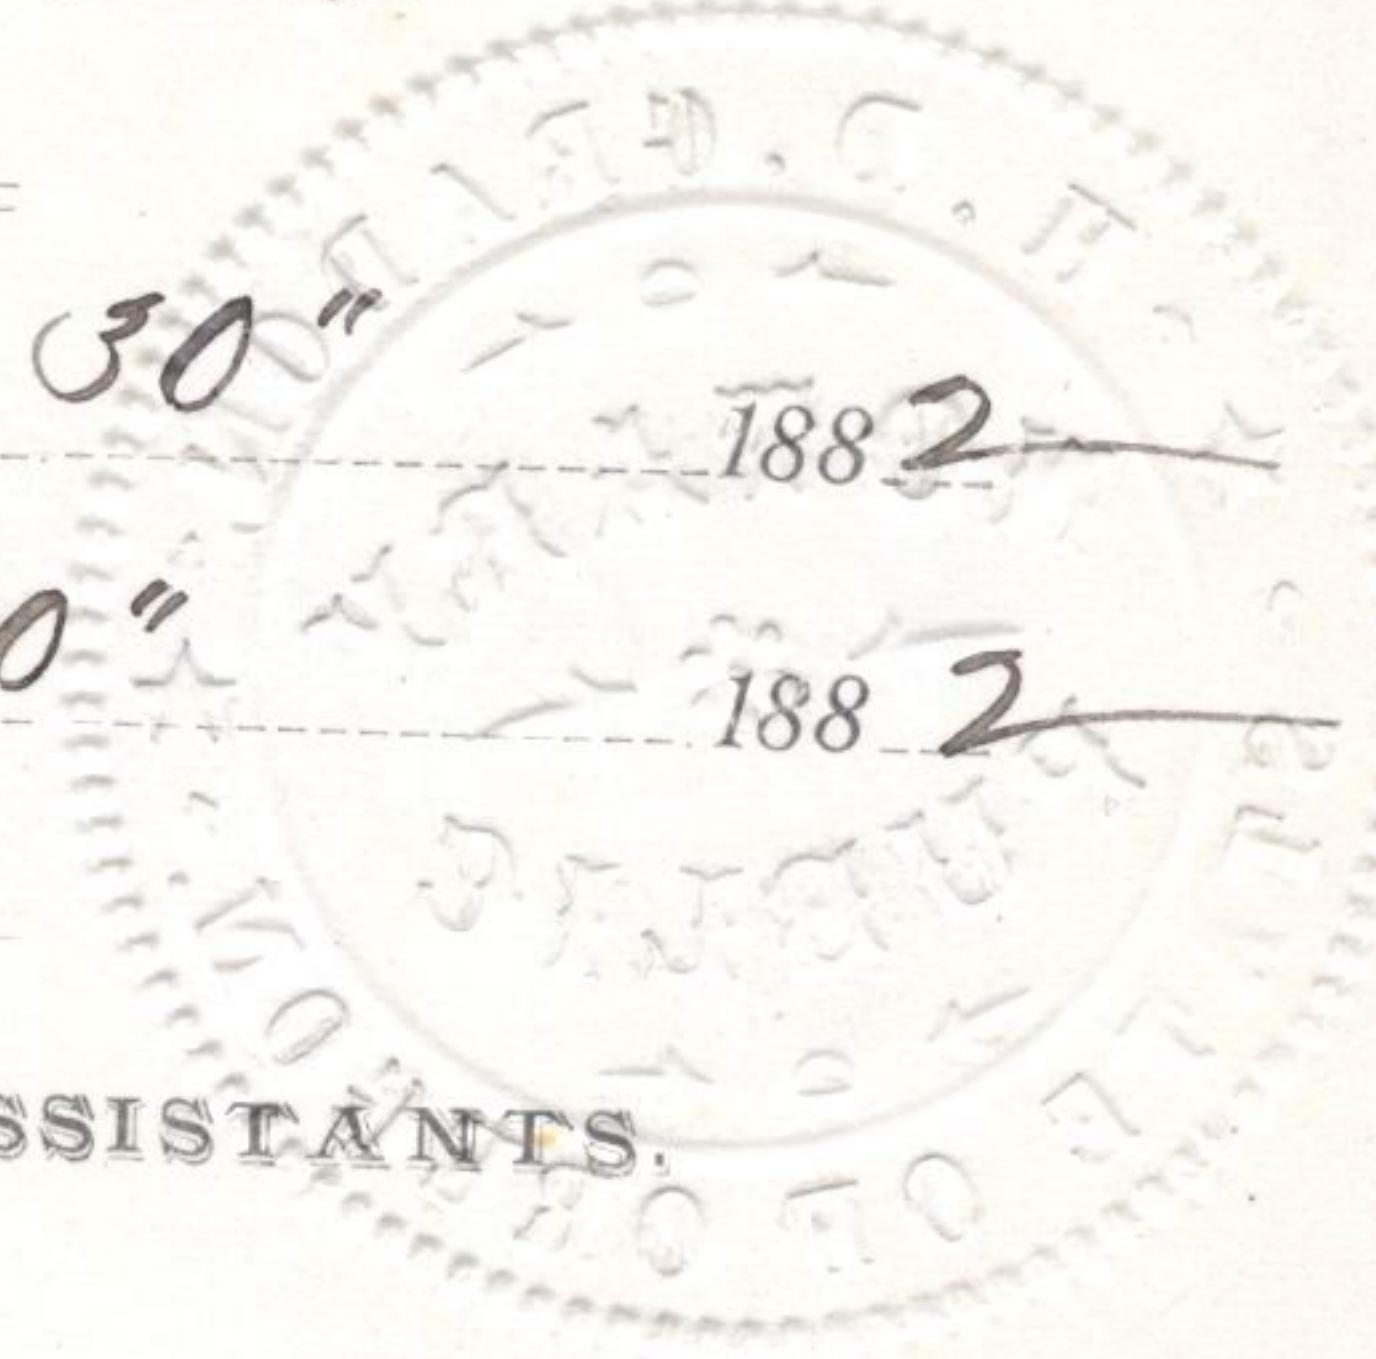

, Compassman.

Abraham Blanchard Chainman.

Henry King, Chainman.

, Chainman.

, Chainman.

Geo. W. Huitt

, Axeman.

, Axeman.

, Flagman.

104

PRELIMINARY OATHS OF ASSISTANTS:

We, Abraham Blanchard and
Henry King

do solemnly swear that we will faithfully execute the duties of Chain Carriers, that we will level the chain over even and uneven ground, and plumb the tally pins, either by sticking or dropping the same; that we will report the true distance to all notable objects, and the true length of all lines that we will assist in measuring, to the best of our skill and ability, and in accordance with the instructions given us in

the survey of the

Subdivisional
Range 37 East
lines of Township, North

Willamette Meridian, Oregon.

Abraham Blanchard, Chainman.

Henry King, Chainman.

, Chainman.

, Chainman

Subscribed and sworn to before me, this

day of

August

1882

[SEAL]

H. D. G. Radin

Notary Public

We,

J. Geo. W. Huitt

and

do solemnly swear
that we will well and truly perform the duties of Axemen in the establishment of corners
and other duties, according to instructions given us, and to the best of our skill and ability,

in the survey of the

subdivisional lines of
D. N. R 34 E

Willamette Meridian, Oregon.

J. Geo. W. Huitt, Axeman.

, Axeman.

Subscribed and sworn to before me, this

day of

August

1882

[SEAL]

H. D. G. Radin

Notary Public

INDEX.

Referring the Lines to the Pages of the Field Notes.

T. 1 N R. 3 Y E Will. Mer.

6	85	5	57	4	45	3	30	2	14	1
83		82		58		44		29		15
7	80	8	56	9	43	10	28	11	14	12
78		77		56		42		27		12
18	76	17	54	16	41	15	26	14	11	13
74		73		53		39		25		10
19	71	20	57	21	38	22	24	23	8	24
69		67		50		37		23		7
30	66	29	49	28	35	27	21	26	6	25
64		63		48		34		20		4
31	61	32	46	33	32	34	18	35	2	36

Meanders of ----- Pages ----- to -----

Meanders of ----- Pages ----- to -----

— —
Subdivisions of T. 1 N. R. 37 E. 111
Willamette Meridian, Oregon.

Preliminary to subdividing this township I ran North on a blaw's line on the East boundary of Sec. 36 and at 40.06 chs I found the $\frac{1}{4}$ sec. line and at 80.08 chs I found the sec. cor., as I have just re-run the S. boundary of Sec 36. I do not believe same

My compass will therefore run the same line as the exterior boundaries and the chaining practically agrees.
Survey commenced Aug. 30th, 1882
with a Burt's improved Solar Compass

Subdivisions of T. 1 N. R. 37 E.

Willamette Meridian, Oregon.

I commence at the Cor. to Sec's 35 + 36 on the Base Line which is a basalt stone 20x12x8 ins. marked B.L. with 1 notch on E. and 5 notches on W. edges, from which
 A fir 6 ins diam. bears N. 7° E. 49 lots dist., marked 2, N. R. 37 E. S. 36. B. I.
 A fir 22 ins diam. bears S. 85° W. 21 lots dist., marked 21, S. R. 37 E. S. 2. B. I.
 A fir 24 ins diam. bears N. 40° W. 51 lots dist., marked 3, N. R. 37 E. S. 55. B. I.

Hence down

North side Sec's 35 + 36

Va. 19° E.

	Ascend about 100 ft. to
14,00	Top of ridge, course N.
2550	Bottom of gulch, about 150 ft. below ridge, course N.
33,00	Top of ridge, about 150 ft. above gulch, course N.
40,00	Set a post 8 ft. long, 3 ins square, 24 ins in the ground. for 1/2 sec. an. marked 1/2 S.

Subdivisions of T. N. R. 578 113

Willamette Meridian, Oregon.

on W. face, from which

A tamarack 4 in diam. bears S. 60° E. 10 cm
dist., mangled $\frac{1}{4}$ S. B.-D.

A fir 4 in diam. bears S. 50° W. 8 cm
dist., mangled $\frac{1}{4}$ S. B.-D.

45.50 Bottom of gulch about 200 ft. below ridge,
course N.

54.00 Top of ridge, about 100 ft. above gulch. course N.

61.50 Bottom of gulch, about 100 ft. below ridge. course N.
Ascend about 100 ft. to

80.00 Set a basal stone 18x12x4 in., 12 in. in the
ground. for Cr. to Decr 25, 26, 35 & 36, mangled
with 1 notch in S. + E. edges + raised a
mound of stone along side -

Land mountainous

Soil stony & ~~sandy~~

Timber scattering fir, pine and
tamarac, with dense undergrowth of
mountain laurel

Subdivisions of T. 1 N. R. 38 E.

Willamette Meridian, Oregon.

East was random line lot, Secs 25 & 36

Va. 18 $\frac{1}{4}$ ° E

Ascend about 300 ft. to

2230 Top of ridge, course S.

Descend about 100 ft. to

3750 A brook, 4' wide, some S.

Set temporary $\frac{1}{4}$ sec. cor.

79,88 Intercept E. boundary 36 lots N. of the
Cor. to Secs 25, 36, 30 + 31 which is a post

+ in square, marked

J, N, S, 30 on N.E.

R 38 E. S 31 on S.E.

R 37 E. S 36 on S.W. and

S 25 on N.W. faces, with 1 notch on S
and 5 notches on N-edges, from which

A fir 30 in diam. bears N. 56° E. 130 lots
dist., marked J, N. R 38 E. S 30. B.J.

A fir 30 in diam. bears S. 82° E. 104 lots
dist., marked J, N. R 38 E. S 31. B.J.

with mound of stone alongside

Thence S. 24° W.

N. 89° 45' W. a true line lot. Secs 25 & 36

Subdivisions of T. 1 N. R. 37 E 115

Willamette Meridian, Oregon.

- 39.94 Set a basalt stone 13x9x8 in., 9 in. in the ground. for corner, marked $\frac{1}{4}$ on N. face. from which
A fir 4 in. diam bran N. 60° W. 52 col dist. marked $\frac{1}{4}$ S. B.I.
A fir 10 in. diam bran S. 10° W. 21 col dist. marked $\frac{1}{4}$ S. B.I.
49.88 The cor. to Sec's 25, 26, 30 & 36

Land mountainous
Soil sandy loam 2^{1/2} m. sat.
Heavily timbered with fir stamined

4116

Subdivision of T. 1 N. R. 37 E.

Willamette Meridian, Oregon.

Noth brk Dees 23+26

Va 18 $\frac{1}{4}$ ° E.

Ascent

40,00 Set a basalt stone 14x10x8 in. 9 in. in
the ground. for $\frac{1}{4}$ sec cor., marked $\frac{1}{4}$ in
W. face. from which

A fir 16 ino diam. bears N. 53° E. 46 lds
dist., marked $\frac{1}{4}$ S. B.D.

A fir 36 ino diam. bears N. 40° W. 13 lds
dist., marked $\frac{1}{4}$ S. B.D.

64,00 Top of ridge, about 400 ft. above sea cor.,
course N.

Set a post 4 ft. long, 4 in square, 24 ino
in the ground. for cor. to Dees 23, 24,
25+26, marked

D, N. S. 24 in N.E.

R 37 E. S. 25 in S.E.

S 26 in S.W. and

S 23 in N.W. faces, with 2 notches on
S and 1 notch on E edges, from which

A fir 5 ino diam. bears N. 78° E. 52 lds
dist., marked D, N, R 37 E. S. 24 B.D.

Subdivisions of T. 1 N. R. 34 E. 117

Willamette Meridian, Oregon.

A fine 4 in diam. brar S. 25° E. 13 lots
dist. marked T. N. R. 34 E. S. 25. B. 2.

A fine 5 in diam. brar S. 25° W. 11 lots
dist. marked T. N. R. 34 E. S. 26. B. 2.

A fine 12 in diam. brar N. 65° W. 15 lots
dist. marked T. N. R. 34 E. S. 23. B. 2.

Land mountainous
Soil 2nd sat

Strawily timbered with fine pine
stamared

East wa true line bet Decr 24 & 25
Va 20 $\frac{1}{4}$ ° E.

Through timber

40.00 Set a Basalt stone 12x10x8 in 8 in in
the ground for 1 $\frac{1}{4}$ secen, marked $\frac{1}{4}$ on
N. face raised a mound of stone
along side.

As the cor to Decr 24, 25, 19130 w
the E boundary of this township

Subdivision of T. 1 N. R. 38 E.

118

Willamette Meridian, Oregon.

has never been established, on account of the land being so rough that it is unsurveyable, I discontinued my line at this point

Land mountainous
Soil stony & gravelly
Timber, scattering fir pine & tanacetum, with dense undergrowth of mountain laurel

North brk Dec 23 + 24

Va. 20 $\frac{1}{2}$ ° E.

Through timber

40.00 Set a post 3 ft. long. 3 in square, 24 in in the ground, for ~~the~~ corner, nailed $\frac{1}{4}$ S. on N. face, from which a fir 28 in diam. bears 80° E. 9 lbs dist., nailed $\frac{1}{4}$ S. B.C.

A fir 3 in diam. bears $N.75^{\circ}W.$ 16 lbs dist., nailed $\frac{1}{4}$ S. B.C.

— 9 —

Subdivision of T. 1 N. R. 37 E. \$19
Willamette Meridian, Oregon.

80.00 Let a post 4 ft long, 4 in square, 28
in in the ground. for lot to Secs 13, 14,
23 & 24, marked

J, N. S. 13 or N.E.

R 37 E. S 24 or S E

S 23 or S W. and

S 14 or N W. faces, with 3 notches
in S and 1 notch on E edge, from which

A fir 20 in diam. bears N. 45° E. 40 etc
dist. marked J, N. R 37 E. S 13. B 2

A fir 24 in diam. bears S. 50° E. 58 etc

dist. marked J, N. R 37 E. S 24. B 2

A fir 20 in diam. bears S. 10° W. 8 etc
dist. marked J, N. R 37 E. S 23. B 2

A tamarac 16 in diam. bears N. 35° W. 5 etc

dist. marked J, N. R 37 E. S 14. B 2

Land mountainous

Soil, sandy loam 2 $\frac{1}{2}$ feet

Heavily timbered with fir, pine, and
tamarac

August 30, 1882

Subdivisions of T. 1 N. R. 37 E.

Willamette Meridian, Oregon.

Eastward random line bet Dec 13 + 24

Va. 20° E.

Over mountainous land through
scattering timber

40,00 Det temporary $\frac{1}{4}$ sec. ev.

80.36 Intersect E. boundary 60 rods N. of
the line to Secs 13, 24, 18 + 19 which is a
tamarack 5 in. in diam. marked

J, N. S, 18 m NE

R 38 E. S, 19 m S-E

R 37 E. S, 24 m SW and

S 13 m NW faces, with 3 notches on
N & S. edges, from which

A tamarack 6 in diam bears S. 73° E. 22
los dist. marked J, N, R 37 E. S, 19 B.J

A tamarack 7 in diam bears N. 58° E. 20

los dist. marked J, N, R 37 E. S, 18 B.J

A tamarack 8 in diam bears N. 53° E. 22

los dist. marked J, N, R 37 E. S, 13 B.J

A tamarack 8 in diam bears S. 39° W. 30 rods

dist. marked J, N, R 37 E. S, 24 B.J

Thence down

Suldivision

of T. 1 N.

R. 37 E. 121

Willamette Meridian, Oregon.

N 89° 34' W - on a true line bet Sec 13 & 24

40,18 Set a basalt stone 17x10x5 in 11 in in
the ground for 1/4 secen, marked 1/4 on N
face and raised a mound of stone alongside
80,36 The line to Secs 13, 14, 23 & 24

Land mountainous, Soil 3rd sat
Timber scattering pine, fir and
tamarac, with dense undergrowth of
mountain laurel

North bet Secs 13 & 14

Va 20° E.

Through timber & brush.

40,00 Set a basalt stone 16x12x10 in, 11 in in the
ground for 1/4 secen, marked 1/4 on N
face and raised a mound of stone
alongside

80,00 Set a basalt stone 18x14x7 in 12 in in the
ground. for line to Secs 11, 12, 13 & 14, marked
with 4 notches on S and 1 notch on E
edges, and raised a mound of

~~1881~~ Subdivisions of T. 1 N. R. 37 E.

Willamette Meridian, Oregon.

stone along side

Land mountainous
Soil, stony 3rd sat.

Timber, scattering pine, fir and
tamarack, with dense undergrowth
of mountain laurel

East in a random line bet Recs 12 & 13

Va $20\frac{3}{4}^{\circ}$ E

Through brush timber

40.00 Cut temporary $\frac{1}{4}$ sec or

79.82 Intersect E boundary 31 lots N of
the cor to Recs 12, 13, 14 & 18, which is
a post, 4 ins square, marked

I, N, S 7 on N-E

R 38 E, S 18 on S-E

R 37 E, S 13 on S-W and

S 12 on N-W faces, with 4 notches on
S, and 2 notches on N edges, from which
a fir $2\frac{1}{2}$ ins diam bran N 18° E. 20 rods

Subdivision of T.^o, N.^o R.^o 37 E^o 23

Willamette Meridian, Oregon.

- dist. marked J, N. R 38 E. S 4. B 2
A fir 6 in diam. brav 370° E. 18 inc
dist. marked J, N. R 38 E. S 18. B 2
A fir 7 in diam. brav 353° N. 9 inc
dist. marked J, N. R 37 E. S 13. B 2
A fir 7 in diam. brav N. 69° N. 27 inc
dist. marked J, N. R 37 E. S 12. B 2

Then I ran

N 89° 47' E. on a true line bet. Secs 12 & 13

89.91 Set a basalt stone 16 x 12 x 4 in 11 in in the ground. For $\frac{1}{4}$ sec ev., marked $\frac{1}{4}$ on N face, and raised a mound of stone alongside.

79.82 The ln. to Secs 12, 13, 7 & 18
Javel mountainous. Soil 2nd sat
Inters. scattering pine, fir and lauanacek, with dense undergrowth of mountain laurel

124

Subdivisions of T. 1 N. R. 37 E.

Willamette Meridian, Oregon.

North lot-Secs 11 & 12

Va $20\frac{3}{4}^{\circ}$ E.

Through brush & timber

40.00 Set a Basalt stone $17 \times 10 \times 6$ in., 11 in. in the ground, for 1/4 sec. end, mangled 1/4 or 1/2, face raised a mound of stone alongside

80.00 Set a Basalt stone $16 \times 11 \times 7$ in., 11 in. in the ground. For cor. to Secs 1, 2, 11 & 12, mangled with 5 notches on S & 1 notch on E-edge, dug pits $18 \times 18 \times 12$ in. in each sec. $5\frac{1}{2}$ ft dist and raised a mound of earth 2 ft high, $4\frac{1}{2}$ ft base alongside

Laurel mountainous

Soil, stony & gravelly

Timber, scattering pine & tamarac with deer under south of mountain laurel

Subdivision of T., N. R. 37 E.

Willamette Meridian, Oregon.

East

on a ravine line bet Lees 1 + 2

Va $20\frac{3}{4}^{\circ}$ E

On mountainous land

40.00 Set temporary $\frac{1}{4}$ sec. on

80.14 Intersect E. boundary 20 rods S. of the
line to Lees 1, 12, 6 & 7 which is a post
4 ins square, marked

J, N. S 6 on W.E.

R 38 E. S 7 on S.E.

R 37 E. S 12 on S.W. and

S. in N.W. face, with 5 notches on S.
+ 1 notch on N. edge, from which

A fir 10 ins diam bears S. 10° E. 98 rods dist.
marked J, N. R 38 E. 87 - B.J.

A pine 36 ins diam bears N. 27° E. 144 rods
dist. marked J, N. R 38 E. 86 - B.J.

and a mound of stone along side

Hence from

S. $89^{\circ} 51'$ N. on a tree line bet Lees 1 + 2

40.07 Set a baralt stone 12 x 10 x 10 ins. 8 ins in
the ground for $\frac{1}{4}$ sec. on, marked $\frac{1}{4}$ sec.
N. face, dug pits 18 x 18 x 12 ins E. & W.

126 Subdivision of T. 1 N. R. 37 E.

Willamette Meridian, Oregon.

of loc. 5 1/2 ft. deep and raised a mound
of earth 1 1/2 ft. high, 3 1/2 ft. base
along side

80,14

The loc. to Secs 1, 2, 11 & 12

Land mountainous

Soil stony & moderate

Timber, scattering pine & fir, with
dense undergrowth of mountain laurel
& brush.

August 31st 1882

North on a random line bet Secs 1 & 2

Va $20\frac{3}{4}^{\circ}$ E

40.00 At temporary 't' sec on

79.80 Intersect N. boundary 18 loc N of
the loc to Secs 1, 2, 3 & 3 which is a
post 4 in square, marked

2 N. S. 36 m N.E.

R 37 E. S. in S.E.

E, N. S. 2 m S.W. and

S 35 m N.W. faces, with 1 notch on E and

Subdivisions of T. 1 N. R. 3^W E^E 27

Willamette Meridian, Oregon.

5 notches on W. edges. From which
A fir 28 ins diam. bears N. 46° E. 49 lots
dist. marked 2 N. R 37 E. S 36. B 3

A fir 14 ins diam. bears S. 34° E. 140 lots dist.,
marked 2, 2 N. R 37 E. S 1. B 3

A pine 26 ins diam. bears S. 59° W. 98 lots dist.,
marked 2, 2 N. R 37 E. S 2. B 3

A pine 8 ins diam. bears N. 55° W. 80 lots
dist. marked 2 N. R 37 E. S 35. B 3

Thence I run

S. 0° 8' W. on a true line bet. Secs 1 + 2

39.88 Set a basalt stone 12x12x6 ins, 8 ins in the
ground, for 14 sec cor. marked 14 on W.
face. And raised a mound of soil
along side

79.88 The cor. to Secs 1, 2, 11 & 12

Land, mountainous
Soil 2^{1/2} feet

Timber, scattering pine, fir and
larch and with dense undergrowth
of brush

128

Subdivisions of T. 1 N. R. 37 E.

Willamette Meridian, Oregon.

From the cor. to Leis 34+35 on the
Base Line which is a post, 4 ins
square, nailed

Bd. I, N. R 37 E. or N.
S 35 m E. end

S 34 m W. faces, with 2 notches on E.
and 4 notches on W. faces, from which
A tamarac 11 ins diam. bran N. 30° E. 26 lch
dist., nailed I, N. R 37 E. S 35 - Bd.

A tamarac 10 ins diam. bran S 50° W. 17 lch
dist., nailed I, S. R 37 E. S 3 - Bd.

A tamarac 6 ins diam. bran N. 65° W. 13 lch
dist., nailed I, N. R 37 E. S 34 - Bd.

I own

North bib. Leis 34+35 —

Va. $19\frac{1}{2}^{\circ}$ E.

Descend about 100 ft. to
12.50 ^{n. fork of} Meacham creek, 10 lch wide, runs N. W.
35.00 Top of ridge, about 200 ft above creek,
course N. W.

40.00 Set a post 3 ft long, 3 ins square, 24 ins
in the ground, for 1/4 sec. cor., nailed

Subdivisions of T. 1 N. R. 37 E.

Willamette Meridian, Oregon.

- 1/4 S. on W. face, dug pits 18x18x12 ins
N & S. of ex. 5 1/2 ft. dist. and raised
a mound of earth 1 1/2 ft. high, 3 1/2 ft
base, along side
63.00 Bottom of gulch, about 150 ft. below
ridge, coarse W.
80.00 Set a basalt stone 12x12x8 ins, 8 ins in
the ground, for Cor. to Secs 26, 27, 34
& 35, marked with 1 notch on S and
2 notches on E edges, from which
A fir 5 ins diam. bears N. 15° E. 45° lode
dist., marked J, N, R 37 E. 826. BD.
A fir 5 ins diam. bears S. 60° E. 72° lode
dist., marked J, N, R 37 E. 835. BD.
no other tree within limits and raised
a mound of stone along side
Land mountainous
Soil sandy loam & stony, 2nd & 3rd rate
Timber scattering fir & pine, with dense
undergrowth of fir, pine and mountain
laurel

Subdivisions of T. 1 N. R. 37 E.

Willamette Meridian, Oregon.

East

marauder line bet. Secs 26 + 35
Va 21° E

Ascend

\$0.00 Set temporary 1/4 sec. cor.

42.00 Top of ridge, about 800 ft above cor.,
course S.W.

70.00 Bottom of gulch, about 400 ft below
ridge, course S.W.

79.80 Intersect 15th line S. of the Cor. to Secs
25, 26, 35 + 36

Then I run

S 89° 54' W on a true line bet. Secs 26 + 35

39.90 Set a basalt stone 16 x 10 x 4 in. 11 in. in
the ground, for 1/4 sec. cor., marked "H" on
N. face, and raised a mound of
stone along side

79.80 The Cor. to Secs 26, 27, 34 + 35

Land mountainous

Soil $\frac{2}{3}$ sat.

Timber, scattering fir & pine, with
dense undergrowth of mountain laurel

Subdivision of T. 1 N. R. 37 1/3 1

Willamette Meridian, Oregon.

North brt. Secs 26 + 27

Vt. 21° E.

Descend about 150 ft. to

10.00 Bottom of gulch, course W.

36.50 Top of ridge, about 300 ft. above g. ulch,
course W.

40.00 Set a post 3 ft. long, 3 ins square, 24 ins
in the ground, for $\frac{1}{4}$ sec. cor., marked $\frac{1}{4} S$
on W. face, from which

A willow 5 ins diam bears N. 20° E. 32 lbs
dist., marked $\frac{1}{4} S$. B-J.

A tamarack 8 ins diam. bears N. 60° W. 10 lbs
dist., marked $\frac{1}{4} S$. B-J.

40.50 A spring branch, 2 lbs wide, runs W., about
150 ft. below ridge, course W.

61.00 Top of ridge, about 250 ft. above branch,
course W.

Descend about 150 ft. to

76.00 A creek, 3 lbs wide, course W.

80.00 Set a basalt stone 22x12x8 ins 16 ins in the
ground, for loc. to Secs 22, 23, 26 + 27, marked
with 2 notches on S and E. edges, from which

132

Subdivisions of T. 1 N. R. 37 E.

Willamette Meridian, Oregon.

A pine 36 in diam. bears N. 65° E. 223. loc
dist. marked J, N, R37E.823. B.2

A pine 25 in diam. bears S. 68° E. 246 loc
dist. marked J, N, R37E.826. B.2

A fir 6 in diam. bears S. 50° W. 230 loc
dist. marked J, N, R34E.827. B.2

A fir 4 in diam. bears N. 3° W. 180 loc
dist. marked J, N, R37E.822. B.2

Land mountainous
Soil sandy loam & silty 2nd or 3rd rate
Timber, scattering fir open, with
a dense undergrowth of young fir
pine & mountain laurel

Subdivisions of T. 1 N. R. 37 E. - 133
Willamette Meridian, Oregon.

East on a random line bet Lees 23+26

Va. $20\frac{3}{4}^{\circ}$ E

Ascent mountain

40,00 Set temporary $\frac{1}{4}$ sec. on.

80,20 Intersect 22 loc N. of the line to
Lees 23, 24, 25 & 26

Hence I run

N. $89^{\circ}57'$ E on a true line bet Lees 23+26

40,10 Set a basalt stone $12 \times 12 \times 6$ ins. 8 ins in
the ground, for $\frac{1}{4}$ sec. on., marked $\frac{1}{4}$ on
N. face, from which
A fir 12 ins diam. trans N. 60° W. 19 loc
dist. marked $\frac{1}{4}$ S. B. D.

A first ins diam trans S. 80° E. 25 loc
dist. marked $\frac{1}{4}$ S. B. D.

80,20 The line to Lees 22, 23, 26 & 27

Land mountainous

Soil, 2nd rate

Timber, scattering fir & pine with
a dense undergrowth of mountain laurel

September 1st, 1882

691134

Subdivisions of T. 1 N. R. 37 E.

Willamette Meridian, Oregon.

North

bt-Dic's 22+23

Va. $20\frac{3}{4}^{\circ}$ E.

Ascend about 150 ft. to

Top of ridge. course 26.

Descend about 75 ft. to

28.00 A brook, 3 wide, runs N.

33.50 Set a basalt stone $12 \times 12 \times 3$ in., 8 in. in the
ground, for $\frac{1}{4}$ acre, marked $\frac{1}{4}$ on N. face,
and raised a mound of stone alongside.

40.00 Set a post 4 ft. long, 4 in. square, 24 in.
in the ground, for lot to Dic's 14, 15. 22+23
marked

J. N. S. 14 on N.E.

R 37 E. S 23 on S.E.

S 22 on S.W. and

S 15 on N.W. faces, with 3 notches on
S and 2 notches on E edges, from which

A tamarack 20 in diam. bran $N. 30^{\circ} E.$ 18' off
dist., marked J. N. R 37 E. S 14 B 3

A fir 28 in diam. bran S. 250 E. 10' off
dist., marked J. N. R 37 E. S 23 B 3

A fir 8 in diam. bran S. 30 W. 30' off

Subdivision of T. 1 N. R. 37 E. 135
Willamette Meridian, Oregon.

dist. marked. T. 1 N. R. 37 E. S. 22. B. 2

A fir 8 in. dia. brns N. 30° W. 18 loc dist.
marked T. 1 N. R. 37 E. S. 15. B. 2

Land mountainous

Soil 2nd rate

Timber, scattering fir, pine and
tamarac, with dense undergrowth
of mountain laurel

East on a road line bet. Secs 14 & 23
Va. 20½° E.

39.75 - A brook, 3 loc wide, runs S.

40.00 Set temporary ¼ sec. cor.

80.30 Intersect 40 loc N of the cor. to Secs.

13, 14, 23 & 24

Three down

N. 89° 43' W. on a true line bet. Secs 14 & 23

40.15 Set a basalt stone 16 x 12 x 4 ins, 11 ins in the
ground, for ¼ sec. cor., marked ¼ on N.
face. pine which.

Subdivisions of T. 1 N. R. 34 E.

Willamette Meridian, Oregon.

A fir 14 in diam. trans N. 20° E. 42 lots
dist. marked $\frac{1}{4}$ S. B.D.

A fir 20 in diam. trans S. 45° E. 10 lots
dist. marked $\frac{1}{4}$ S. B.D.

80.30 The cor. to Sec's 14, 15, 22 + 23

Land mountainous
Soil. sandy loam 2 in. slate
Heavily timbered with fir, tamarack
and pine. Dense undergrowth
of mountain laurel

North lot. Sec's 14 + 15

N. $20\frac{1}{2}^{\circ}$ E.

Low mountainous land

40.00 Set a basalt stone 14 x 10 x 6 in 9 in. in the
ground. for $\frac{1}{4}$ sec cor. marked $\frac{1}{4}$ on W.
face, and raised a mound of stone
along side

80.00 Set a basalt stone 16 x 12 x 10 in. 11 in.
in the ground. for cor to Sec's 10, 11, 14 +

Subdivision of T. 1 N. R. 3rd 187

Willamette Meridian, Oregon.

15. marked with 4 notches on S
and 2 notches on E. edge. And raised
a mound of stone along side

Land mountainous
Soil stony 3rd rate
Scattering pine, fir and tamarac
timber. Dense under growth
of pine, fir, tamarac and mountain
laurel

East on a random line bet. Recs 11 & 14

Va. 21° E.

40.00 Set temporary # see cor.

80.12 Intersect 25th line N. of the Cor to Recs
11, 12, 13 & 14

Therefrom

N. 89° 49' W. on a true line bet. Recs 11 & 14

40.06 Set a basalt stone 16x12x6 ins 11 ins in the
ground, for 1/4 sec cor, marked 1/4 in N.
face, & raised a mound of stone alongside

138

Subdivisions of T. 1 N. R. 37 E.

Willamette Meridian, Oregon.

80,12

The loc to Sec's 10, 11, 14 & 15

Sand mountainous

Soil, stony $3\frac{1}{2}$ ft. sat

Scattering fir, pine & stonewall
timber. Dense under south of
mountain laurel

North

ft - Sec's 10 & 11

Va. $21^{\circ} E$

Dense through scattering timber
and brush

40.00

Set a basalt stone $14 \times 10 \times 8$ in, 9 in in
the ground. for $\frac{1}{4}$ sec's, marked $\frac{1}{4}$
on W. face, and raised a mound of
stone alongside

62.00

Bottom of canon, about 700 ft below
sec's; a brook, 4 lbs wide, runs N.W.

80.00

Set a basalt stone $18 \times 12 \times 10$ in. 12 in in
the ground, for loc. to Sec's 2, 3, 10 & 11, mark-
ed with 5 notches on S and 2 notches
on E edges and raised a mound of

Subdivision of T. N R. 34 E.

Willamette Meridian, Oregon.

stone alongside

Land mountainous

Soil stony 3rd rat

Scattered pine. fir stamined
timber. Dense undergrowth
of mountain laurel

September 2nd, 1882

Cast on a random line bet Sec 2 & 11

Va. 2 1/2° E.

Ascend through brush

40.00 Det trapirang 4 sec. in.

79.90 I intersect 40 lots S of the cor. to Secs.

1, 2, 11 & 12

Hence from

S 89° 43' W on a tree line bet Secs 2 & 11

39.95 Det a basal stone 15 x 10 x 5 ins 10 ins in the
ground, for 1/4 sec. in. marked X
on N. face, raised a mound of

stone alongside

The cor. to Secs 2, 3, 10 & 11

140

Subdivisions of T. N. R. 34 E.

Willamette Meridian, Oregon.

Land mountainous
Soil. stony 3rd rate
Scattering pine, fir & stonewall
timber. Dense undergrowth of
mountain laurel

North on a random line bet. Secs 2 & 3
Va. $2\frac{1}{2}^{\circ}$ E.

25,00 A brook, 4 lds wide, runs S.W.

Lat temperature 48 sec cor.

Intersect N. boundary 25 lds E. of
the bro. to Secs 2, 3, 34 & 35 which is a
post 4 ins square, marked

② N. S 35 m N.E.

R 34 E. S 2 m S.E.

③ N. S 3 m S 2 h. ^{and}

S 34 m N.W. faces, with 2 notches on
E and 4 notches on W. edges, from which

A fir 26 in diam. bears S. 10° E. 136 lds
dist., marked ④ N. R 34 E. S 2 B.D.

A fir 12 in diam. bears N. 34° W. 70 lds

Subdivisions of T. / N. R. 37 E. 834 B. D.

Willamette Meridian, Oregon.

dist. marked T2 N. R37 E. 834 B.D.

A fir 16 in diam. bears S. 36° W. 92 loc.

dist. marked T. N. R37 E. 83. B.D.

and a mound of stone around post

Thence I ran

S. 0° 11' E. on a true line bet Dec 2 + 3

40.36 Set a basalt stone 12 x 10 x 8 in 8 in in
the ground. fm 'tesser, marked $\frac{1}{4}$ m
W. face, and raised a mound of
stone alongside

80.36 Th. lin. to Dec 2, 3, 10 & 11

Land mountainous

Soil stony 3rd rate

Timber scattering pine + fir

Dense undergrowth of mountain
laurel

Subdivisions of T. 1 N. R. 37 E.

Willamette Meridian, Oregon.

From the cut to Sec's 33 & 34 on
the Base Line which is a post
4 in square, marked
B.L. 1 N. R. 37 E. on N.
S. 34 on E. end
S. 33 on W. face, with 3 notches on
E. & W. faces, from which
A fir 30 in diam. trans N. 10° E. 19 ft
dist., marked 1 S. N. R. 37 E. S. 34. B. J.
A fir 24 in diam. trans S. 10° E. 76 ft
dist., marked 1 S. R. 37 E. S. 34. B. J.
A fir 18 in diam. trans N. 40° W. 10 ft
dist., marked 1 N. R. 37 E. S. 33. B. J.

I saw

North cut Sec's 33 & 34

Va. $20\frac{1}{4}^{\circ}$ E.

Through timber

14.00 A board, 4 ft wide. runs N. & S.
40.00 Set a baralt stone 14 x 10 x 4 in, 9 in in
the ground, for 14 sec. or, marked $\frac{1}{4}$ in
W. face, from which
A fir 30 in diam. trans N. 85° E. 50 ft

Subdivisions of T. 1 N. R. 34 E.

Willamette Meridian, Oregon.

- dist., marked $\frac{1}{4}$ S. B.D.
 A fir 28 ins diam. bears N. $50^{\circ} W.$ 66 deg
 dist., marked $\frac{1}{4}$ S. B.D.
 78.50 Top of ridge, about 200 ft above brook,
 course N.W.
 80.00 Set a post 4 ft. long, 4 ins square, 24 ins
 in the ground, for lot to Sec's 27, 28, 33
 & 34, marked
 J. N. S 27 on N.E.
 R 37 E. S 34 on S.E.
 S 33 on S.W. and
 S 28 on N.W. faces, with 1 notch on
 S and 3 notches on E. edges, from which
 a willow 6 ins diam. bears N. $45^{\circ} E.$ 8 deg
 dist., marked J. N. R 37 E. S 27 B.D.
 An alder 4 ins diam. bears S. $70^{\circ} E.$ 23 deg
 dist., marked J. N. R 37 E. S 34 B.D.
 An alder 3 ins diam. bears S. $25^{\circ} W.$ 14 deg
 dist., marked J. N. R 37 E. S 33 B.D.
 An alder 4 ins diam. bears N. $45^{\circ} W.$ 20 deg
 dist., marked J. N. R 37 E. S 28 B.D.

Subdivisions of T. 1 N. R. 37 E.

Willamette Meridian, Oregon.

Land mountainous
Soil sandy loam 2nd rate
Heavily timbered with fir, tamarac & pine - Dense undergrowth of fir tamarac, pine, mountain laurel, alder & willows

*
East

in a random line bet. Sec's 27 + 34

Va. 21° E.

Descend through timber & brush

40.00 Set temporary $\frac{1}{4}$ sec cor-

52.00 Foot of hill, about 1500 ft. below sec cor., course N.W.

54.50 N. fork of Meacham creek, 10 lbs wide, running S.

80.54 Intersect 60 lbs N. of the cor. to Sec's

26.27, 34 + 35

Then I ran

N. 89° 34' W. in a true line bet. Sec's 27 + 34

40.27 Set a basalt stone 16 x 10 x 4 in. 11 in. in the ground, for $\frac{1}{4}$ sec cor., maoled $\frac{1}{4}$ on N. face, and raised a mound of stone alongside.

Subdivisions of T. 1^{1/2} N. R. 37 E.

Willamette Meridian, Oregon.

80.54 The cor. to Rec's 27, 28, 33 + 34

Land mountainous

Soil stony 3rd rate

Heavily timbered with fir and tamarac

Dense undergrowth of fir, tamarac and mountain laurel

North bet. Rec's 27 + 28

Va. 210 E.

Descend through timber

40.00 Set a basalt stone 12 x 9 x 5 ins. 8 ins in the ground. for 1/4 sec. cor., marked 1/4 on N. face, from which

A pine 6 ins diam. bears S. 20° E. 50 lote dist. marked 1/4 S. B. I.

A fir 6 ins diam. bears S. 10° W. 37 lote dist. marked 1/4 S. B. I.

51.50 A spring branch, 3 lote wide, runs N. E.

Foot of hill, about 1500 ft. below sec. cor. course N. W.

6400 N. fork of Meacham creek, 10 lote wide, runs N. W.

176 Subdivisions of T. 1 N. R. 37 E.

Willamette Meridian, Oregon.

66.00

Ascend hill

80.00

Set a post 4 ft. long, 4 ins square, 24
ins in the ground, for Cor. to Recs 21,
22, 27 & 28, marked

J. N. S 22 on N.E.

R 37 E. S 27 on S.E.

S 28 on S.W. and

S 21 on N.W. faces, with 2 notches on S.
and 3 notches on E. edges, from which
a pine, 6 ins diam. bears N. 65° E. 9 lots
dist. marked J. N. R 37 E. S 22. B.D.

A pine 4 ins diam. bears S. 60° E. 8 lots
dist. marked J. N. R 37 E. S 27. B.D.

A pine 5 ins diam. bears S. 35° W. 15 lots
dist. marked J. N. R 37 E. S 28. B.D.

A pine 6 ins diam. bears N. 20° W. 7 lots
dist. marked J. N. R 37 E. S 21. B.D.

Land mountainous

Soil stony 3rd rate

Heavily timbered with fir, tamarack & pine.

Dense small growth of pine, fir, tamarack
& mountain laurel

September 3rd, 1882

Subdivision of T. 1 N. R. 37 E.

Willamette Meridian, Oregon.

147

East on a random line bet. Secs 22+27
Va. 20° E.

Ascend mountain

40.00 Set temporary $\frac{1}{4}$ sec cor.

79.82 A point about 1500 ft above last sec cor;
Intersect 35 lbs N. of the Cor. to Secs
22, 23, 26+27

Hence I ran

N. 89° 45' W on a true line bet. Secs 22+27

39.96 Set a post 3 ft. long. 3 in square. 24 in in
the ground, for $\frac{1}{4}$ sec cor., marked $\frac{1}{4}$ S.
on N. face, and raised a mound of
stone around post

79.82 The cor. to Secs. 21, 22, 27+28

Land mountainous

Soil 2 m^s rate

Scattering fir & pine timber

Dense under growth of mountain
laurel

Subdivisions

of T. 1 N. R. 37 E.

Willamette Meridian, Oregon.

North ft - Recs 21+22

Va. 20° E.

15.00 Dry bed of creek, course N.

40.00 Set a basalt stone 14x10x4 ins 9 ins in the ground, for 1/4 sec. cor., marked 1/4 on W. face, from which

A fir 24 ins diam. trans N. 85° W. 100 lbs dist., marked 1/4 S. B.C.

no other tree within limits and raised a mound of stone alongside

94.50 Summit of ridge, about 1200 ft above creek bed, course N.W.

80.00 Set a post 4 ft. long, 4 ins square, 24 ins in the ground, for cor. to Recs 15, 16, 21+22 marked

J. N. S. 15 m N.E.

R 37 E. S. 22 m S.E.

S. 21 m S.W. and

S. 16 m N.W. faces, with 3 notches on S. & E. edges, from which

A fir 12 ins diam. trans N. 37° E. 15 lbs dist., marked J. N. R 37 E. S. 15. B.C.

Subdivisions of T. 1 N. R. 37¹⁴⁹ E.

Willamette Meridian, Oregon.

A fir 8 ins diam. bears S. 55° E. 15 lbs
dist. marked J, N. R 37 E. 822. B.J.

A fir 10 ins diam. bears S. 65° N. 24 lbs
dist. marked J, N. R 37 E. 821. B.J.

A fir 6 ins diam. bears N. 70° W. 20 lbs
dist. marked J, N. R 37 E. 816. B.J.

Land mountainous
Soil sandy loam 2^{1/2} ft. rate
Timber, scattering fir pine, with
dense thicket of young fir pine and
mountain laurel

East on a random line bet. Secs 15 & 22
Va. 22° E.

Ascend

40.00 Cut temporary $\frac{1}{4}$ sec cor.

80.38 Intersect 18 lbs N. of the cor. to Secs

14, 15, 22 & 23

Thence I run

N. 89° 52' W. on a true line bet. Secs 15 & 22

130
Subdivisions of T. 1 N. R. 37 E.

Willamette Meridian, Oregon.

40,19 Set a post 3 ft. long, 3 in square, 24 in
in the ground, for $\frac{1}{4}$ sec. cor., marked $\frac{1}{4} S$
on N. face, dug pits $18 \times 18 \times 12$ in. depth
of cor. $5\frac{1}{2}$ ft. dist. and raised a mound
of earth $1\frac{1}{2}$ ft. high, $3\frac{1}{2}$ ft. base around
post.

80,38 The cor. to Recs 15, 16, 21 & 22

Land mountainous
Soil 2 in. slate
Timber scattering fir & pine, with
dense undergrowth of fir pine and
mountain laurel

Subdivisions of T. 1 N. R. 37 E.

Willamette Meridian, Oregon.

North fort. Secr 15-16

Va 250 E

Descend through brush & timber

10.00 Bottom of gulch, about 100 ft below cor., course N.

20.00 Top of ridge, about 150 ft above gulch, course N.

40.00 Set a basalt stone 14×10×4 in. 9 ins in the ground, for $\frac{1}{4}$ sec. cor., marked $\frac{1}{4}$ on W. face, and raised a mound of stone along side

80.00 Set a basalt stone 16×12×12 ins 11 ins in the ground, for cor. to Secr 9, 10, 15 & 16, marked with 4 notches on S. and 3 notches on E. edges, and raised a mound of stone along side

Land mountainous

Soil stony 3rd rate

Scattering fir & pine timber

Dense undergrowth of mountain laurel, young fir and pine

152
Subdivisions of T. 1 N. R. 37 E.

Willamette Meridian, Oregon.

East

on a random line bet. Secs 10 & 15

Va. $20\frac{1}{4}^{\circ}$ E.

Ascend through brush

30.00 Top of ridge, about 400 ft. above cor.,
course N.

40.00 Set temporary $\frac{1}{4}$ sec. cor.

79.88 Intersect 37 lots N. of the cor. to Secs 10,
11, 14 & 15

Hence I run

N. $89^{\circ} 44' W.$ on a true line bet. Secs 10 & 15

39.99 Set a basalt stone $14 \times 10 \times 6$ in. 9 in. in
the ground. for $\frac{1}{4}$ sec. cor., marked $\frac{1}{4}$ in
N. face, and raised a mound of
stone along sides

79.88 The cor. to Secs 9, 10, 15 & 16

Land mountainous
Soil 2 m. rate
Scattering fir & pine timber with dense
undergrowth of mountain laurel,
young fir & pine

September 4 1882

Subdivisions of T. 1 N. R. 34 E.

Willamette Meridian, Oregon.

'North brt.-Dec's 9+10

Va. $20\frac{1}{4}^{\circ}$ E.

Descend about 300 ft. to

30.00 A creek, 8 ft wide, runs S. Ascend

40.00 Set a basalt stone 16x12x4 in., 11 in
in the ground. For $\frac{1}{4}$ sec. or. marked
14 in. N. face, and raised a mound of
stone alongside

80.00 A point about 700 ft. above creek:

Set a basalt stone 15x12x8 ins 10 ins in
the ground for loc. to Dec's 3, 4, 9+10
marked with 5 notches on S, and 3
notches on E edges, and raised
a mound of stone alongside

Land mountainous

Soil, stony 3rd rate

Timber, scattering pine, fir and
tamaracel with dense undergrowth
of mountain laurel

1154

Subdivisions of T. 1 N. R. 37 E.

Willamette Meridian, Oregon.

East

on a random line bet. Secs 3 & 10
Lat. $21^{\circ} E$.

Dressed

40.00 Set temporary 1/4 sec cor.

45.00 A creek, 1 lot wide, runs SW.

63.00 Same creek, runs NW.

80.22 Intersect 10 lots S. of the cor. to
Secs 2, 3, 10 & 11

Hence from

S 89° 56' W. on a true line bet. Secs 3 & 10

40.11 Set a basalt stone 16 x 12 x 4 in 11 in
in the ground, for 1/4 sec cor., marked
1/4 in N. face, and raised a mound
of stone along side

80.22 The cor. to Secs 3, 4, 9 & 10

Land mountainous

Soil stony 3rd rate

Timber, scattering pine, fir and
tamarack with dense undergrowth
of buck brush

Subdivisions of T. 1 N. R. 37 E.

Willamette Meridian, Oregon.

North on a random line bet. Secs 3 & 4
Va. 21° E.

Ascending

40,00 Set temporary 4 sec on.

80,12 I intersect N. boundary 90 lots
E. of the lot to Secs 3, 4, 33 & 34
which is a post 4 ins square, marked
J2 N. S. 34 on N.E.
R37 E. S 3 on S.E.

J, N. S 4 on S.W. and
S 33 on N.W. faces, with 3 notches
on E. & W. edges, from which

A fir 20 ins diam, bare S. 85° W. 295 lots
dist., marked J, N. R37 E. S 4. B.J.

and a mound of stone around post.

Hence I run

S. 0° 39' E. on a true line bet. Secs 3 & 4

40,12 Set a basalt stone 16 x 10 x 6 ins 11 ins in
the ground, for 4 sec on, marked 1/4 on
W. face, and raised a mound of
stone along side

80,12 The line to Secs 3, 4, 9 & 10

Subdivisions ¹⁵⁶ of T. 1 N. R. 36 E.

Willamette Meridian, Oregon.

Land mountainous
Soil, stony & ^{3rd} rate
Timber, scattering pine, fir and
larch, with dense undergrowth
of mountain laurel

From the Cor. to Sec's 82 & 83 on
the Baseline which is a post
4 ins square, marked

B.L. S, N. R. 37 E. on N.

833 m E. and

832 m W. faces, with 4 notches
on E and 2 notches on W. face, from which

A larch 15 ins diam. bears N. 53° E 16 lvs

dist., marked S, N. R. 37 E. 833 B. 2

A fir 10 ins diam. bears S. 170° N. 26 lvs
dist., marked S, S. R. 37 E. 833 - B. 2

A larch 14 ins diam. bears N. 40° W. 26 lvs
dist., marked S, N. R. 37 E. 832 - B. 2

From

North bet. Sec's 82 & 83

Subdivisions of T. 176 R. 37 E.

157

Willamette Meridian, Oregon.

Va. $20\frac{1}{2}^{\circ}$ E.

Through timber

- 2.50 A brook, 4 lds wide, runs N.
20.00 Top of ridge, about 150 ft above brook,
course N.
35.00 Bottom of gulch, about 150 ft below ridge;
a brook, 5 lds wide, runs N.
37.00 Leave heavy timber scattering timber
40.00 Set a post 3 ft. long, 3 in square, 24 in
in the ground, for tree to be cut, marked
N & S. on N. face, dug pit 18 x 18 x 12 in
N & S. of cor. 5 1/2 ft. dist., and raised a
mound of earth 1 1/2 ft. high 3 1/2 ft.
face, around post
80.00 A point about 1000 ft above brook;
Set a tall stem 18 x 12 x 6 in. 12 in in
the ground, for cor. to be cut 28, 29, 32 &
33, marked with 1 notch on S. and 4
notches on E. edges, and raised a
mound of stem along side

Larch mountainous Soil 2 $\frac{1}{2}$ " pale

Heavily timbered with fir scattered on
S. 37.00 ac. scattering timber on remainder

158

Subdivisions of T. 1 N. R. 37 E.

Willamette Meridian, Oregon.

East

on a random line bet. Sec's 28 & 33

Va. $21\frac{1}{4}^{\circ}$ E.

Descend about 150 ft. to

20.00 Bottom of gulch, course S.

40.00 Set temporary $\frac{1}{4}$ sec. cor.

41.00 Top of ridge, about 100 ft. above gulch,
course S.

60.00 Bottom of gulch, about 100 ft. below
ridge, course S.

73.00 Top of ridge, about 100 ft. above gulch,
course N. W.

79.66 Induced 20 lots N. of the lot, to Sec's
27, 28, 33 & 34

Thence I run

N $89^{\circ} 49'$ W. a true line bet. Sec's 28 & 33

39.83 Set a salt stone $14 \times 8 \times 6$ in 9 ins in
the ground, for $\frac{1}{4}$ sec. cor., marked $\frac{1}{4}$ w
N. face, and raised a mound of
stone along side

The lot to Sec's 28, 29, 32 & 33

Land mountainous. Soil 2 $\frac{1}{2}$ slate

Timber scattering pine fir & stewartia

Dense undergrowth of mountain laurel

September 5th 1882

Subdivisions of T. 1 N. R. 37 E \$59

Willamette Meridian, Oregon.

North lat. Sec's 28 & 29

Va. $21\frac{1}{4}$ E.

Ascend

40.00 Set a post 3 ft. long, 3 ins square, 24 ins
in the ground, for $\frac{1}{4}$ sec. cor., marked $\frac{1}{4} S$.
on N. face, from which
A tamarac 20 ins diam. ^{bran} S. 40° E. 13 lote
dist. marked $\frac{1}{4} S. B. J.$

A tamarac 18 ins diam. bran S. 40° N. 9 lote
dist. marked $\frac{1}{4} S. B. J.$

45.00 Summit of mountain, course N. N. E.

80.00 Set a basalt stone $1\frac{1}{4} \times 1\frac{1}{4} \times 4$ ins 9 ins in the
ground, for Lm. to Sec's 20, 21, 28 & 29
marked with 2 notches on S. and 4
notches on E edges, from which

A fir 8 ins diam. bran S. 65° E 43 lote
dist. marked J. N. R. 37 E. 828. B. J.

A fir 10 ins diam. bran S. 10° N. 20 lote
dist. marked J. N. R. 37 E. 829. B. J.

no other tree within limits and
raised a mound of stem alongside

Subdivisions of T. N. R. 37 E.

Willamette Meridian, Oregon.

Land mountainous
Soil 2nd rate
Heavily timbered with fir, pine and
tamarac.

East on a random line bet Secs 21 + 28
Va. 22° E.

Ascend about 75 ft. to
Top of ridge, course N.
Set temporary 1/4 sec cor.
Foot of hill, about 1500 ft. below last
ridge, course N.W.

72.00 North fork of Meacham creek, 10 rods
wide, runs N.W.

73.50 Ascend hill

80.36 I intersect 26 lots S. of the Cor. to Secs
21, 22, 27 + 28

I hence I run

S. 89° 49' W. on a true line bet Secs 21 + 28

40.18 Set a basalt stone 16 x 12 x 4 ins 11 ins in
the ground for 1/4 sec cor, marked 1/4 on

Subdivisions of T. 1 N. R. 34 E.

Willamette Meridian, Oregon.

N. face, and raised a mound of
stone along side
80.36 The cor. to Sec's 20, 21, 28 & 29

Land mountainous
Soil stony & dry
Timber, scattering pine, fir and
tamarac with dense undergrowth
of yew, tamarac and buck brush.

North lat. Decr 20 & 21

Va. 22° E.

40.00 Descend steep mountain
Set a basalt stone $14 \times 10 \times 7$ in 9 in in
the ground. for 4 sec. air, marked $\frac{1}{4}$ in
N. face, and raised a mound of stone
along side

60.00 Bottom of canon, about 1500 ft. below
sec. cor.: N. foot of Meacham creek 10 lds
wide, runs N.W.

70.00 Top of ridge, about 200 ft. above creek, course N.E.

Subdivision
162

of T. N. R. 37 E.

Willamette Meridian, Oregon.

80,00

Descend about 200 ft. to
Set a basalt stone $16 \times 8 \times 8$ in. 11 in. in
the ground. for loc. to Secs 16, 17, 20 &
21, marked with 3 notches on S. and
4 notches on E. edges from which
A fir 8 in. diam. bears N. 60° E. 30 ele
dist., marked J, N. R 37 E. S 16. B.J.
An alder 3 in. diam. bears S. 65° E. 7 ele
dist., marked J, N. R 37 E. S 21. B.J.
An alder 4 in. diam. bears S. 70° W. 12 ele
dist., marked J, N. R 37 E. S 20. B.J.
An alder 7 in. diam. bears N. 60° W. 32 ele
dist., marked J, N. R 37 E. S 17. B.J.

Land mountainous
Soil stony 3^d. rate
Timber, scattering fir & tamarac
Dense undergrowth of fir, tamarac,
buck brush and alder

Subdivisions of T. 1 N. R. 37 E. ¹⁶³
Willamette Meridian, Oregon.

East on a random line bet Dec 16 & 21

Va. $20\frac{1}{2}^{\circ}$ E

Ascend steep hill

40.00 Set temporary sec. cor.

80.32 A point about 1500 ft above sec. cor.;
Intersect 50 lots S. of the Cor. to Sec's

15, 16, 21 + 22

Hence from

S. $89^{\circ}39' W$ on a true line bet Dec 16 & 21

40.16 Set a basal stem 14 x 4 x 4 in 9 in in
the ground. for $\frac{1}{4}$ sec. cor., marked $\frac{1}{4}$ m
N. face, from which
A pine 28 in diam. bears $N. 60^{\circ} W. 166$ lots
dist. marked $\frac{1}{4}$ S. B. I.

A fir 12 in diam. bears $S. 75^{\circ} W. 111$ lots
dist. marked $\frac{1}{4}$ S. B. I.

80.32 The cor. to Sec's 16, 17, 20 + 21

Land mountainous

Soil 2 $\frac{1}{2}$ vel. rate

Timber scattering fir & pine

16¹

Subdivisions of T. 1 N. R. 37 E.

Willamette Meridian, Oregon.

North

frt. Sec's 16 + 17

Va. $20\frac{1}{2}^{\circ}$ E.

- 0.50 A creek, 13 lots wide, runs S.W.
23.00 Top of ridge, about 150 ft above creek, course S.E.
36.00 Bottom of gulch, about 100 ft below ridge;
a brook, 5 lots wide, runs S.E.
40.00 Set a basalt stone 24x16x4 in., 18 in. in the
ground, for 1/4 section, marked 1/4 on W. face,
from which
A pine 6 in diam. bears S. 70° E. 19 lots
dist. marked 1/4 S. B.D.
A fir 6 in diam. bears N. 70° W. 32 lots
dist. marked 1/4 S. B.D.
80.00 Set a basalt stone 13x11x6 in 9 in. in the
ground, for lot to Sec's 8, 9, 16 + 17, marked
with 4 notches on S + E edges, from which
A fir 15 in diam. bears N. 50° E. 104 lots dist.,
marked 3, N. R 37 E. 8 q. B.D.
A fir 8 in diam. bears S. 870° E. 56 lots dist.
marked 3, N. R 37 E. 8 16. B.D.
no other tree within limits and raised a
mound of stone along side

Subdivisions of T. 1 N. R. 37 E.

Willamette Meridian, Oregon.

Land mountainous
Soil stony $\frac{3}{4}$ rock
Timber scattering fir, pine and
tamarac. Dense undergrowth of
brush.

September 6th, 1882

East on a random line bet. Secs 9+16

V. $21^{\circ} E$.

Ascend about 100 ft. to
Top of ridge, course S.
Set temporary $\frac{1}{4}$ sec. cor.
Bottom of canon, about 600 ft. below ridge;
a creek, 8 feet wide. same S.W.
Intersect 25 lots N. of the Cr. to Secs 9,
10, 15 + 16.

Hence from

N. $89^{\circ} 49' W$. on a true line bet. Secs 9+16

40.18 Set a basalt stone $14 \times 10 \times 6$ ins 9 ins in the
ground. for $\frac{1}{4}$ sec. cor. marked $\frac{1}{4}$ on N.-
face & raised a mound of stone along side
The Cr. to Secs 8, 9, 16 + 17

1866

Subdivisions of T. 1 N. R. 37 E.

Willamette Meridian, Oregon.

Land mountainous

Soil 3rd rate

Timber, scattering fir & pine

North lot. Decr 8 & 9

Va 210 E.

Ascend along side hill

20.00 Cross ridge, course S.E.

40.00 Set a basalt stone 14x10x10 ins 9 ins in
the ground. for 1/4 sec. cor., marked 1/4 on
W. face, and raised a mound of stone
alongside

80.00 Set a post 4 ft. long, 4 ins square, 24
ins in the ground, for loc. to Decr 4,
5, 8 & 9, marked

J, N. 54 on N.E.

R 37 E. S 9 on S.E.

S 8 on S.W. and

S 5 on N.W. faces, with 5 notches on
S and 4 notches on E edges, from which
a fir 45 ins diam. bears N. 33° E. 54 lads

Subdivision of T. 1 N. R. 37 E.
Willamette Meridian, Oregon.

dist. marked I, N. R 37 E. S 4. B. D.

A spruce 14 in diam. brns 840° E 15 lds

dist. marked I, N. R 37 E. S 9. B. D.

A fir 30 in diam. brns 870° N. 30 lds

dist. marked I, N. R 37 E. S 8. B. D.

A fir 20 in diam. brns $N. 60^{\circ}$ N. 150 lds

dist. marked I, N. R 37 E. S 5. B. D.

Land mountainous

Soil stony & $\frac{3}{2}$ rate

Timber, scattering pine. fir,
tamarac and spruce, with dense
undergrowth of buck brush

Jan 168

Subdivisions of T. 1 N. R. 37 E.

Willamette Meridian, Oregon.

East

on a random line bet. Secs 4 & 9

Via $19\frac{1}{2}^{\circ}$ E

Over mountainous laurel

40.00 Set temporary $\frac{1}{4}$ sec cor.

80.16 Intercept 15 rods S. of the cor. to Secs
3, 4, 9 & 10

Thence I run

S $89^{\circ} 54' W.$ on a true line bet. Secs 4 & 9

40.08 Set a cast stone 12 x 10 x 6 in 8 in in
the ground. for $\frac{1}{4}$ sec cor., marked $\frac{1}{4}$ on
N. face, and raised a mound of
stone along side

80.16 The cor. to Secs 4, 5, 8 & 9

Laurel mountainous

Soil, 2% rate

Timber scattering pine fir and
larchwood, with dense undergrowth
of mountain laurel

Subdivision of T. 1 N. R. 34 E.

Willamette Meridian, Oregon.

North on a random line bet. Secs 4+5
Va. $19\frac{1}{2}^{\circ}$ E.

Over mountainous land

40,00 Set temporary 'N' sec. m.

80,10 Intersect N. boundary 152 lots E. of
the lot to Secs 4, 5, 32 + 33 which is a
post 4 ins square, marked

J 2 N. S 33 m N.E.

R 34 E. S 4 m S. ~~E~~

J 1 N S 5 m S.W. and

S 32 m N.W. faces, with 4 notches on
E and 2 notches on W. edges, from which
a fir 16 ins diam bears S. 39° N. 100 lots
dist. marked J 2 N. R 34 E. S 5 - B.J.

A fir 24 ins diam bears N. 38° E. 130 lots
dist. marked J 2 N. R 34 E. S 33 - B.J.

A fir 12 ins diam bears N. 20° N. 48 lots
dist. marked J 2 N. R 34 E. S 32 - B.J.
and a mound of stone around post

Hence I run

S. 1° 5' E. on a true line bet. Secs 4+5

40,10 Set a post 3 ft long, 3 ins square, 24 ins

Subdivisions of T. 1 N. R. 37 E.

Willamette Meridian, Oregon.

in the ground. for $\frac{1}{4}$ sec. or, measured
 $\frac{1}{4}$ S. on W. face, from which
A tamarac 20 in diam. bears S. 30° E. 23
lde dist., measured $\frac{1}{4}$ S. B. I.

A fir 22 in diam. bears S. 40° W. 17 lde
dist., measured $\frac{1}{4}$ S. B. I.

80,10 The br. to Secs 4, 5, 8 & 9

Land mountainous
Soil sandy loam - 2nd rate
Timber, fir pine, tamarac
& spruce. Dense undergrowth
of mountain laurel

Subdivisions of T. 1 N. R. 3¹⁷E.

Willamette Meridian, Oregon.

I ran the cor. to Secs 31 & 32 on
the Base Line, which is a post 4
in square, marked

B-L. 1, N. R₃4 E. on N.

S 32 on E. and

S 31 on N. faces, with 5 notches on
E. and 1 notch on N. faces, from which
a fir 10 in diam. bears N. 80° E. 60 rods
dist., marked 1, N. R₃4 E. S 32. B-L.

A pine 10 in diam. bears S. 50° E. 46 rods
dist., marked 1, S. R₃4 E. S 6. B-L.

A fir 7 in diam. bears N. 20° W. 72 rods
dist., marked 1, N. R₃4 E. S 31. B-L.

I ran

North ft. Secs 31 & 32

Va. 20½° E.

Through timber

1.00 Dry bed of creek, 25 lbs wide, runs N. W.

5.00 Ascend hill about 200 ft. to

29.00 Top of ridge, course N. W.

34.50 Bottom of gulch, about 200 ft. below ridge;
a creek, 6 lbs wide, runs N. W.

Subdivisions of T. 1 N. R. 34 E.

Willamette Meridian, Oregon.

- 40.00 Set a basalt stone $16 \times 7 \times 5$ in 11 in in the ground. for $\frac{1}{4}$ sec cor., marked $\frac{1}{4}$ on W. face. from which
A pine 14 in diam, bears S. 75° E. 39 deg dist. marked $\frac{1}{4}$ S. B.D.
A pine 7 in diam, bears N. 15° W. 55 deg dist. marked $\frac{1}{4}$ S. B.D.
- 61.50 Top of ridge, about 250 ft above creek, course W.
- 68.50 Bottom of gulch, about 100 ft below ridge, course W.
- 80.00 Set a basalt stone $15 \times 8 \times 5$ in 10 in in the ground, for lots to Sec's 29, 30, 31 & 32 marked with 1 notch on S. and 5 notches on E. edges. from which
A fir 14 in diam bears N. 50° E. 60 deg dist. marked S. N. R. 34 E. S. 29. B.D.
A fir 7 in diam. bears S. 80° W. 38 deg dist. marked S. N. R. 34 E. S. 31. B.D.
A fir 20 in diam. bears N. 20° W. 77 deg dist. marked S. N. R. 34 E. S. 30. B.D.
no other tree within limits and raised

Subdivisions of T. 1 N. R. 87 E. ¹⁷³

Willamette Meridian, Oregon.

a mound of stone alongside

Land mountainous

Soil 2nd or 3rd rate

Timber scattering fir pine and
tamarac, with dense undergrowth
of buck brush

September 7th, 1882

East on a random line bet. Sec's 29 & 32
Va. 210 E.

Ascend

40.00 Set temporary 1/4 sec. cor.

79.78 I intersect 13 lots N. of the Cor to Secs
28, 29, 32 & 33

I hence I run

N 89° 54' W on a true line bet. Secs 29 & 32

39.89 Set a basalt stone 17x10x4 in 11 in in
the ground. for 1/4 sec. cor. marked 1/4 on
W. face, and raised a mound of stone
alongside

The cor to Secs 29, 30, 31 & 32

174

Subdivision of T. 1 N. R. 37 E.

Willamette Meridian, Oregon.

Land mountainous

Dov't 2nd rate

Timber. scattering fir & pine with
dense undergrowth of buck brush

West

on a random line bet Decr 30 & 31

Va 21° E.

Descend

40,00 Ret temporary 1/4 sec cor.

43,50 Bottom of canon, about 700 ft. below sec cor.
a creek, 10 lds wide, runs N.W.

90,00 Top of ridge, about 1000 ft. above creek, course N.

103,24 Intersect N boundary 64 lds S. of the
Cor. to Decr 30, 31, 25 + 36 which is a
post 4 in square, marked

T, N. S 30 a N.E.

R 37 E. S 31 a S ~~26~~

R 36 E. S 36 a S 26 and

S 25 a N.W. faces, with 1 notch on S.

and 5 notches on N. edges, from which

A pine 24 in diam. from N. 50 W. 360 lbs

Subdivisions of T. 1 N. R. 37¹/₂ E.
Willamette Meridian, Oregon.

dist., marked T. N. R. 36 E. 825- B. D.

and a mound of stone around post

Hence I saw

8.89⁰ S. E. on a true line bet. Secs 30 & 31

63.24 Set a tall stone 18x7x5 in, 12 in. in the
ground. for $\frac{1}{4}$ sec. en., marked $\frac{1}{4}$ a N. face
from which

A pine 12 in diam. brans N. 35° W. 28 coh
dist., marked $\frac{1}{4}$ S. B. D.

A fir 7 in diam. brans S. 10° E. 22 coh
dist., marked $\frac{1}{4}$ S. B. D.

103.24 The lin. to Secs 29, 30, 31 & 32

Land mountainous

Soil stony $\frac{3}{2}$ rd sat.

Gimbr, scattering pine, fir and
tamarac

1761

Subdivisions of T. 1 N. R. 34 E.

Willamette Meridian, Oregon.

North

ft. Decr 29+30

Va 21° E.

Ascend about 250 ft. to

17.00 Top of ridge. course N.

40.00 Set a basalt stone 15x9x6 in 10 in in
the ground. for corner, marked 1/4 in
W. face, and raised a mound of
stone alongside.

80.00 Set a post 4 ft. long, 4 in square, 24
in in the ground. for cor. to Decr 19, 20.
29+30, marked

J, N. S 20 on N-E.

R 34 E. S 29 on S-E.

S 30 on S-W. and

S 19 on N-W. faces, with 2 notches on S.
and 4 notches on E. edges, from which
a fir 18 in diam. brans N. 40° E. 117 lode
dist., marked J, N. R 34 E. S 29. B.D.

A fir 20 in diam. brans S. 35° E. 14 lode
dist., marked J, N. R 34 E. S 29. B.D.

A fir 6 in diam. brans S. 50° W. 40 lode
dist., marked J, N. R 34 E. S 30. B.D.

Subdivisions of T. N. R. 37 E.

of T.

N.

R.

177

37 E.

Willamette Meridian, Oregon.

A fir tree diam. brns N. 65° W. 40 lots
dist., mndul 2, N. R. 37 E. 819 B. I.

Land mountainous
Soil 2 $\frac{1}{2}$ to 3 $\frac{1}{2}$ feet
Timber scattering fir tamarack
& pine, with dense undergrowth
of buck brush

East on a random line bet. Sec's 20 & 29

V. 20 $\frac{1}{4}$ E.

Ascend about 100 ft. to

9.00 Top of ridge, course N.

19.00 Bottom of gulch, about 100 ft. below
ridge, course N.

40.00 Set temporary $\frac{1}{4}$ sec. on

48.00 Top of ridge, about 500 ft. above gulch, course N.
Descend about 150 ft. to

63.00 A spring branch, 3 lbs wide, runs N.

80.14 Intersect 42 lots N. of the Cor. to Sec's

20, 21, 28 & 29

1781

- 68 -

Subdivision of T. 1 N. R. 37 E.

Willamette Meridian, Oregon.

Hence I run

N. 89° 42' W. a true line bet. Sec's 20 & 29

40, 07 Set a post 3 ft long, 3 in square, 24 in in
the ground. for 4 sec. on, marked $\frac{1}{4}$ S. on
N. face, from whichA fir 18 in diam. bears N. 30° W. 36 sec
dist., marked $\frac{1}{4}$ S. B. D.A fir 20 in diam. bears S. 25° E. 16 sec
dist., marked $\frac{1}{4}$ S. B. D.

80, 14 The lin. to Sec's 19, 20, 29 & 30

Land mountainous

Soil 2 $\frac{1}{2}$ yds. + 3 $\frac{1}{2}$ rodsHeavily timbered with pine, fir
stamarac. Dense undergrowth
of pine, fir + buck brush

Subdivisions of T. 1 N. R. 34 E.

Willamette Meridian, Oregon.

- Hut on a random line bth. Decr 19 & 30
Va. $20\frac{1}{4}^{\circ}$ E.
- 7.50 Descend through timber
foot of hill, about 200 ft below cr.,
course S.W.
- 10.00 N. fork of Mecham creek, 30 ft wide,
runs S.W.
- 20.00 Foot of hill - Ascend
- 40.00 Set temporary $\frac{1}{4}$ sec. cr.
- 50.00 Top of ridge, about 1000 ft above creek,
course S.E.
- 99.00 Bottom of canon about 1000 ft below
ridge, course S.E.
- 103.64 Intersect N. boundary 44 lds S. of the
cr. to Decr 19. 30. 24 + 25 which is 4
flat stones laid flat way $\frac{1}{4} \times \frac{1}{4}$ ins
marked with a + on top and
2, N. S. 19 on N.E.
R. 34 E. S. 30 on S.E.
R. 36 E. S. 25 on S.W. and
S. 24 on N.W. angles of t, from which
a pine 18 ins diam. brns S. 28 W. 48 lds

Subdivisions of T. 1 N. R. 37 E.

Willamette Meridian, Oregon.

dist., marked J.N.R 36 & S 25. B.J.

Thence from

S 89° 47' E. on a true line b.b. Decr 19 + 30

63.64 Let a basalt stone 18x10x4 ins 12 ins in
the ground, for $\frac{1}{4}$ sec. cor., marked $\frac{1}{4}$ on
N. face, from which

A cherry 4 ins diam. bears N. 25° E. 20 lds
dist., marked $\frac{1}{4}$ S. B.J.

A fir 20 ins diam. bears S. 10° W. 61 lds
dist., marked $\frac{1}{4}$ S. B.J.

103.64 The cor. to Decr 19, 20, 29 + 30

Land mountainous

Soil sandy loam resting $2\frac{1}{2}$ ft. + 3 ft. slate
tributary, scattering pine, fir and
tamarack

September 8th 1882

Subdivisions of T. N. R. 37 E.

Willamette Meridian, Oregon.

North bit - Recs 19 & 20

Va. 20 $\frac{1}{4}$ ° E.

Descend about 200 ft. to
North fork of Meacham creek, 30 rods
wide, runs S.W.

11.00 Ascend hill

40.00 Set a basalt stone 14x6x6 ins 9 ins in
the ground, for 4 sec. cor., marked $\frac{1}{4}$ on
W. face, from which
A pine 8 ins diam. bears N. 20° E. 139 rods
dist., marked $\frac{1}{4}$ S. B.J.

A pine 10 ins diam. bears N. 55° W. 185 rods
dist., marked $\frac{1}{4}$ S. B.J.

61.00 Top of ridge, about 1000 ft. above
creek, course S.E.

Descend about 300 ft. to

7900 Bottom of gulch, course S.E.

80.00 Set a basalt stone 24x10x8 ins, 18 ins
in the ground, for loc. to Recs 17, 18, 19
& 20, marked with 3 notches on S. and
5 notches on E. edges, from which
A fir 24 ins diam. bears N. 40° E. 138 rods

Subdivisions of T. N. R. 34 E.

Willamette Meridian, Oregon.

dist. marked T. N. R. 34 E. 8, 7 B. I.

A cherry tree diam. base 345° E. 8 W.

dist. marked T. N. R. 34 E. 8 20. B. I.

A pine 36 in diam. base 780° N. 260 E. W.

dist. marked T. N. R. 34 E. 8 18. B. I.

no other tree within limits and
raised a mound of stone alongside

Land mountainous
Soil stony & dry
Timber scattering fir & pine,
Dense undergrowth of mountain
laurel & vine maple

Subdivisions of T. 1 N. R. 37 E. ¹⁸³

Willamette Meridian, Oregon.

East

on a random line bet. Secs 17 & 20

Va. $20\frac{1}{4}^{\circ}$ E

Over rough mountainous land

Set temporary $\frac{1}{4}$ sec. on.

80.00 A creek, 12 rods wide, runs S.W.

Intersection 18 rods N. of the Cr. to Secs

16, 17, 20 & 21

Hence from

N. $89^{\circ} 52' W.$ on a tree line bet. Secs 17 & 20

40.18 Set a basalt stone $12 \times 12 \times 10$ in., 8 in.
in the ground, for $\frac{1}{4}$ sec. on., marked
 $\frac{1}{4}$ on N. face, and raised a mound of
stone alongside

80.36 The Cr. to Secs 17, 18, 19 & 20

Land mountainous

Soil 2 w. rats

Timber, scattering pine & fir

Dense undergrowth of mountain
laurel

Subdivisions of T. 1 N. R. 37 E.

Willamette Meridian, Oregon.

West

on a random line brt. Secs 18 + 19

Va. $20\frac{1}{4}^{\circ}$ E.

Descend about 75 ft. to

0.75 Bottom of gulch, course S.E.

Ascend about 700 ft. to

28.50 Top of ridge, course S.E.

Set temporary $\frac{1}{4}$ sec. cor.50.00 Bottom of canon, about 1000 ft. below ridge;
a spring branch, 3 lbs wide, runs S.E.103.35 Intersect W. boundary 12 lbs S. of the
Cor. to Secs 18, 19, 13 + 24 which is a
post 4 ins square, marked

J, N. S, 8 on N.E.

R 34 E. 8 1/2 a S.E.

R 36 E. 8 1/2 a S.W. and

8 1/2 a N.W. faces, with 3 notches
on N. & S. edges, from whichA pine 24 ins diam. bears N. 30° E. 119 lbs
dist., marked J, N. R 34 E. 8 1/2. B.J.A fir 24 ins diam. bears N. 61° W. 80 lbs
dist., marked J, N. R 36 E. 8 1/2. B.J.A pine 16 ins diam. bears S. 67° W. 62 lbs

Rubdivisive

of T. 1 N.

R. 34 E. 185

Willamette Meridian, Oregon.

dist. marked T. N. R. 36 E. S. 24. B. 2

Hence I ran

S. 89° 56' E. on a true line bet Recs 18 & 19

63,33 Set a baralt stone 14x14x8 in 9 ins in
the ground. for $\frac{1}{4}$ sec on, marked $\frac{1}{4}$
on N. face and raised a mound
of stone alongside

10335 The lin to Recs 17, 18, 19 & 20

Land mountainous

Soil stony 3rd rate

Scattering fir, pine & ammonia timber

Bruse undergrowth of buck brush

Subdivisions

of T. 1 N. R. 34 E.

Willamette Meridian, Oregon.

North Sat. Dec 17 & 18

Va. 20 $\frac{1}{4}$ E.

Ascend

40.00 Set a basalt stone 14x10x6 ins 9 ins in
the ground, for 1/4 sec. cor., marked 1/4 on
W. face, and raised a mound of

stone, along side
summit of mountain, course E. Descend

64.00 80.00 Set a basalt stone 17x12x10 ins 11 ins in
the ground, for 1 m. to Rec'd 7.8, 17 & 18,
marked with 4 notches on S. and 5 notches
on E. edges from which

A tamarack 3 ins diam. brans N. 40° E. 96 lck
dist., marked J, N. R 34 E. 88. B.J.

A fir 3 ins diam. brans S. 25° E. 26 lck
dist., marked J, N. R 34 E. 81.7. B.J.

A fir 3 ins diam. brans S. 25° W. 30 lck
dist., marked J, N. R 34 E. 81.8. B.J.

A tamarack 4 ins diam. brans N. 50° W. 62 lck
dist., marked J, N. R 34 E. 84. B.J.

Land mountainous. Soil $3\frac{1}{2}$ to 4 ft.
Scattering pine, fir & tamarack timber.

Dense undergrowth of pine, fir tamarack
and buck brush.

Subdivisions of T. 1 N. R. 34 E.

Willamette Meridian, Oregon.

East on a random line bet. Secs 8 & 17

Va. $20\frac{1}{2}^{\circ}$ E.

Descend mountain through brush

40.00 Set temporary $\frac{1}{4}$ sec cor.

49.50 Bottom of canon, about 1000 ft. below cor.,
a brook, 5 lds wide, runs S.

Ascend about 600 ft. to

80.5# Intersect 45 lds S. of the Cor. to Secs

8, 9, 16 & 17

Hence I run

S. $89^{\circ} 41' W$ on a tree line bet. Secs 8 & 17

40.2# Set a post 3 ft. long, 3 in. square, 2 4 in.
in the ground, for $\frac{1}{4}$ sec cor., marked
 $\frac{1}{4} S$. on N. face, from which

A fir 5 in diam bears $N. 35^{\circ} W.$ 25 lds
dist., marked $\frac{1}{4} S. B. J.$

A fir 15 in diam bears $S. 20^{\circ} E.$ 25 lds
dist., marked $\frac{1}{4} S. B. J.$

80.5# The Cor. to Secs 7, 8, 17 & 18

Sand mountainous. Soil stony $\frac{3}{4}$ rd rock
Scattering fir, pine & tamarac timber.

Dense undergrowth of young fir, pine & tamarac

September 9th 1882

188

Subdivision of T. 1 N. R. 37 E.

Willamette Meridian, Oregon.

West

on a random line bet. Secs 7 & 18

Va. $20\frac{1}{2}^{\circ}$ E.

Ascend through brush & timber

40.00 Set temporary $\frac{1}{4}$ sec. on

45.00 Top of ridge, course S.

68.50 Bottom of gulch, about 100 ft deep, course S.

94.50 Top of ridge, about 100 ft above gulch, course S.

103.50 Intersect W. boundary line 45 locs S. of
the line to Secs 7, 18, 12 & 13 which is
a stone 24 x 30 ins. marked with a +
on N. face and

J, N. S 7 on N. E.

R 37 E. S 18 on S. E.

R 36 E. S 13 on S. W. and

S 12 on the N. W. angles of + with 4 notches
on S. and 2 notches on N. edges, from which
a pine 24 ins diam. bran 82° N. 200 locs

distr. marked J, N. R 36 E. S 13. B. 2.

Hence from

S. $89^{\circ} 45' E.$ on a tree line bet. Secs 7 & 18

63.50 Set a basalt stone 18 x 16 x 10 ins, 12 ins. in
the ground, for $\frac{1}{4}$ sec. on, marked $\frac{1}{4}$ on

Subdivisions of T. 1 N. R. 3 $\frac{1}{2}$ E

Willamette Meridian, Oregon.

N. face, from which

A tamaracel 15 ins diam. bran N. 45° E. 113
lde dist. marked $\frac{1}{4}$ S. B.-J.

A fir 40 ins diam. bran S. 65° E. 200
lde dist. marked $\frac{1}{4}$ S. B.-J.

103,50 The loc. to Secs 7, 8, 17 & 18

Land mountainous

Soil sandy loam or stony 2 $\frac{1}{2}$ to 3 $\frac{1}{2}$ rods
inches scattering fir, pine and
tamaracel. Dense undergrowth
of fir, pine, tamaracel and buck
brush.

Subdivision 1⁸² of T. 1 N. R. 37 E.

Willamette Meridian, Oregon.

North 8 ft. Secs 7 & 8

Va. $20\frac{1}{2}^{\circ}$ E.

Descend through brush timber

40.00 Set a post 3 ft long, 3 in square, 24 in
in the ground. for $\frac{1}{4}$ sec cor. marked $\frac{1}{4} S$.
on W. face, from which

A fir 4 in diam. bears East 33 deg
dist., marked $\frac{1}{4} S$. B.I.

A fir 5 in diam. bears $8.5^{\circ} W.$ 17 deg
dist., marked $\frac{1}{4} S$. B.I.

48.00 Bottom of canon, about 500 ft. below
last sec cor.; a brook, 5 lbs wide. runs S.E.

Ascend about 600 ft. to

78.00 Top of ridge. course S.E.

80.00 Set a post 4 ft. long. 4 in square, 24 in
in the ground. for cor. to Secs 5, 6, 7 & 8
marked

J. N. S 5 m N.E.

R 34 E. S 8 m S.E.

S 7 m S.W. and

S 6 m N.W. faces, with 5 notches on
S & E edges. from which

Subdivisions of T. 1 N. R. 3 Y. 6¹⁹¹

Willamette Meridian, Oregon.

A fir 8 in diam. trans N. 10° E. 45 rods
dist. marked J, N. R 34 E. S 5 - B. 2

A fir 14 in diam. trans S. 40° E. 30 rods
dist. marked J, N. R 34 E. S 8 - B. 2

A fir 12 in diam. trans S. 10° W. 41 rods
dist. marked J, N. R 34 E. S 4 - B. 2

A fir 20 in. diam. trans N. 40° W. 32 rods
dist. marked J, N. R 34 E. S 6 - B. 2

Land mountainous
Soil 2 wet spots

Timber scattering pine, fir and
tamarac. Dense undergrowth
of pine, fir tamarac and mountain
laurel

Subdivision of T. 1 N. R. 58 E.

Willamette Meridian, Oregon.

East on a random line bet. Sec's 5 & 8

Via $19^{\circ} E.$

14.00 Bottom of gulch, about 100 ft. below cor.,
course S.E.

40.00 Set temporary $\frac{1}{4}$ sec cor.

Top of ridge, about 300 ft. above
gulch, course S.E.

79.92 Intercept 25° W. of the cor. to Sec's

4, 5, 8 & 9

Then I run

$889^{\circ} 49' W.$ on a true line bet. Sec's 5 & 8

39.96 Set a base alt. stme 12x10x8 in., 8 in. in
the ground. for $\frac{1}{4}$ sec cor. marked $\frac{1}{4}$ cor
N. face, from which
A fir 5 in. diam. bears $N. 50^{\circ} E.$ 11 cal. dist.,
marked $\frac{1}{4}$ S. B.-J.

A fir 8 in. diam. bears $S. 10^{\circ} E.$ 26 cal. dist.,
marked $\frac{1}{4}$ S. B.-J.

7992 The cor. to Sec's 5, 6, 7 & 8

Land mountainous. Soil $I \frac{1}{2}$ sec. late

Heavily timbered with fir, pine & tanacet.

Dense undergrowth of mountain laurel

Subdivisions of T. 1 N. R. 34 E 193

Willamette Meridian, Oregon.

West on a random line bet. Secs 6 & 7

Va. 19° E.

Through timber

40.00 Set temporary '4 sec. cor.

103.70 Intersect W. boundary '10 lots S. of
the cor. to Secs 6, 7, 10 & 12 which is a
post 4 in square, marked

J. N. 86 on N.E.

R 34 E. 84 on S.E.

R 36 E. 812 on S.W. and

S 1 on N.W. face, with 1 notch on N.
and 5 notches on S. edge, from which

A fir 12 in diam. bears S 41° W. 50 lots
dist. marked J. N. R 36 E. 82 B.D.

A fir 20 in diam. bears S 57° E. 62 lots
dist. marked J. N. R 34 E. 84 B.D.

A fir 30 in diam. bears N. 38° E. 57 lots
dist. marked J. N. R 34 E. 86 B.D.

A fir 14 in diam. bears N. 130° W. 32 lots
dist. marked J. N. R 36 E. 81 B.D.

Then down

S $89^{\circ} 57'$ E. on a tree line bet. Secs 6 & 7

Subdivisions of T. 1 N. R. 37 E.

Willamette Meridian, Oregon.

- 63,70 Set a post 3 ft. long, 3 in. square, 24 in
in the ground. for $\frac{1}{4}$ sec. cor., maoled $\frac{1}{4}$ S.
on N. face, from which
A fir 28 in diam. bears N. 10° E. 28 lch
dist., maoled $\frac{1}{4}$ S. B. D.
A fir 16 in diam. bears S. 30° E. 158 lch
dist., maoled $\frac{1}{4}$ S. B. D.
- 103,70 The last Decr 5, 6, 7 & 8

Sand mountainous
Soil 2nd rate
Heavily timbered with fir, pine and
tamarac. Dense undergrowth
of fir pine tamarac & alder.

Subdivisions of T. 1 N. R. 37 E. 195

Willamette Meridian, Oregon.

North or a random line bet Secs 5 & 6

V. 19° E.

Through timber

15.00 Bottom of gulch, about 100 ft below
course S.E.

24.00 Top of ridge, about 75 ft above
gulch, course E.

40.00 Set temporary $\frac{1}{4}$ sec. en.

68.00 Bottom of gulch, about 100 ft deep, course N.E.

80.76 Intersect N. boundary 211 lots E. of the
Cr. to Deer St. 6. 31 + 32 which is a
post 4 in square, marked

I 2 N. S 32 m N.E.

R 37 E. S 3 m S.E.

I 2 S. S 6 m S.W. and

S 31 m N.W. face, with 5 notches on
E and 1 notch on W. edge, from which
A fir 16 in diam. bears S. 39° W. 100 lots
dist., marked I, N. R 37 E. S 6. B 3

A fir 24 in diam. bears N. 38° E. 130 lots
dist., marked I 2 N. R 37 E. S 32. B 3

A fir 12 in diam. bears N. 20° W. 48 lots

1906
Subdivisions of T. 1 N. R. 36 E.
Willamette Meridian, Oregon.

dist. marked $\frac{1}{2}$ R. 57 E. S. 31. B. 2
and mound of straw around post
Thenee Drane

S. 1° 30' E. on a tree line bet. Secs 5 & 6

40,76 Let a post 3 ft long, 3 in square, 2 1/4 in
in the ground for 1/4 sec on, marked
 $\frac{1}{4}$ S. on N. face, from which
An alder 4 in diam bran S. 30° E. 20 late
dist. marked $\frac{1}{4}$ S. B. 2.

An alder 4 in diam bran S. 40° W. 11 late
dist. marked $\frac{1}{4}$ S. B. 2

80,76 The lot to Secs 5, 6, 7 & 8

Land mountainous
Soil 2 nd rate

Heavily timbered with pine, fir
tamarack - Dense undergrowth of
pine, fir, tamarack + alder

September 10th 1882

General Description —

The land in this township is entirely rough and mountainous. The soil is mostly third rate, but there is some fair second rate. There is an abundance of bunch grass over most of the hills and it is splendid for grazing purposes. The entire township is covered with pine, fir and tamarack timber, mostly scattering but quite dense in places. The timber is of good quality, but is too scarce and secluded to be of much value.

I found no settler in this township

Human D. Gradow
U.S. Dept Surveyor

FINAL OATHS FOR SURVEYS.

A list of the names of the individuals employed by *D. G. Graden*, U. S. Deputy Surveyor, to assist in running, measuring and marking the lines and corners described in the foregoing field notes of the survey of the *Subdivisional lines of Township 1 North Range 37 East*, Willamette Meridian, Oregon, showing the respective capacities in which they acted:

<i>Abraham Blankard</i>	, Compassman.
<i>Henry King</i>	, Chainman.
<i>Geo. W. Huitt</i>	, Chainman.
	, Flagman.

FINAL OATHS OF ASSISTANTS.

We hereby certify that we assisted *D. G. Graden*, U. S. Deputy Surveyor, in surveying all those parts or portions of the *Subdivisional lines of Township 1 North, Range 37 East*, Willamette Meridian, Oregon, as are represented in the foregoing field notes as having been surveyed by him and under his direction; and that said survey has been in all respects, to the best of our knowledge and belief, well and faithfully surveyed, and the corner monuments established, according to the instructions furnished by the U. S. Surveyor General of Oregon.

<i>Abraham Blankard</i>	, Compassman.
<i>Henry King</i>	, Chainman.
<i>Geo. W. Huitt</i>	, Chainman.
	, Flagman.

Subscribed and sworn to before me, this *22nd day of September* *H. D. Graden* Notary Public

[SEAL]

FINAL OATH OF DEPUTY SURVEYOR.

I,

Henry D Graden

United States Deputy Surveyor, do solemnly swear that in pursuance of instructions received from

U. S. Surveyor General for Oregon, bearing date of the

16thday of *June*, 1882, I have well, faithfully and truly, in my own proper person, and in strict conformity with the instructions furnished by the U. S. Surveyor General for Oregon, the Surveying Manual, and the laws of the United States, surveying all thoseparts or portions of *the subdivisional lines
of S. N. R 34 E*Willamette Meridian, in the State of Oregon, as are represented in the foregoing Field Notes as having been surveyed by me and under my directions; and I do further solemnly swear that all the corners of said survey have been established and perpetuated in strict accordance with the Surveying Manual, printed instructions, the special written instructions of the U. S. Surveyor General for Oregon, and in the specific manner described in the field notes, and that the foregoing are the *true* field notes of such survey, and should any fraud be detected I will suffer the penalty of perjury under the provisions of an Act of Congress approved August 8, 1846.*Henry D Graden*
U. S. Deputy Surveyor.

Subscribed and sworn to before me, this 22d day of December 1882

*Bamford Robb
Notary Public*

262

Office U. S. Surveyor General,

Portland, Oregon, March 31 1883.

The ~~following~~ ^{forgoing} Field Notes of the Survey of the
Subdivisional lines of Township 1 North
Range 3 $\frac{1}{4}$ East Mill. Mer. Oregon

executed by Herman D. Braden U.S. Dept. Surv.
under his Contract No. ~~3452~~, dated June 16, 1882
1882, having been critically examined, the
necessary corrections and explanations made, the said field notes
and the survey they describe, are hereby approved.

James C. Tolman
Surveyor General.