

## FIELD NOTES

Of the survey of the

*Exteriors*Lines of *Tps. 1, 2, 100**R's 31, 33, 34 & 35, E. Tps. 2, 3, 4, 35* Willamette Meridian, Oregon,as surveyed by *James P. Currier and James E. Poland*  
*their special*

U. S. Deputy Surveyor, under his Contract No. \_\_\_\_\_

dated *May 4<sup>th</sup>*, 1887Survey commenced, *June 14<sup>th</sup>*, 1887Survey completed, *Aug 30<sup>th</sup>*, 1887

## NAMES AND DUTIES OF ASSISTANTS.

*L. J. Wooley*, Compassman.  
*J. Medley*, Chainman.  
*W. H. Medley*, Chainman.  
*Guy Davis*, Chainman.  
*Frank Selshard*, Chainman.  
*J. P. Crowner*, Axman.  
*J. A. Hadley*, Axman.  
\_\_\_\_\_, Flagman.



PRELIMINARY OATHS OF ASSISTANTS.

36 We, J. S. Medley, W. H. Medley, Frank Behshaw  
and Guy Davis

do solemnly swear that we will faithfully execute the duties of Chain Carriers; that we will level the chain over even and uneven ground, and plumb the tally pins, either by sticking or dropping the same; that we will report the true distance to all notable objects, and the true length of all lines that we will assist in measuring, to the best of our skill and ability, and in accordance with the instructions given us in the survey

of the Exterior lines of Twp. 10, R. 32, 33 & 34 E. Twp. 21, R. 33 & 35 E. Twp. 1 lines of Twp. 32, 33, 34 & 35 E. Twp. 21, R. 32, 34 & 35 E. Willamette Meridian, Oregon.

J. S. Medley, Chainman.  
W. H. Medley, Chainman.  
Frank Behshaw, Chainman.  
Guy Davis, Chainman.

Subscribed and sworn to before me this 14th day of June, 1887

[SEAL.] James P. Currier  
U.S. Deputy Surveyor

We, B. B. Crowner and J. R. Haddley, do solemnly swear that we will well and truly perform the duties of Axmen in the establishment of corners and other duties, according to instructions given us, and to the best of our skill and ability, in the survey of the

Exterior lines Twp. 10, R. 32, 33 & 34 E. Twp. 21, R. 33 & 35 E. Twp. 1 R. 32, 33, 34 & 35 E. Twp. 21, R. 32, 34 & 35 E. Willamette Meridian, Oregon.

B. B. Crowner, Axman.  
J. R. Haddley, Axman.

Subscribed and sworn to before me this 14th day of June, 1887

[SEAL.] James P. Currier  
U.S. Deputy Surveyor




INDEX

365

Referring the Lines to the Pages of the Field Notes.

T. *2 South* R. *33 East* Will. Mer.

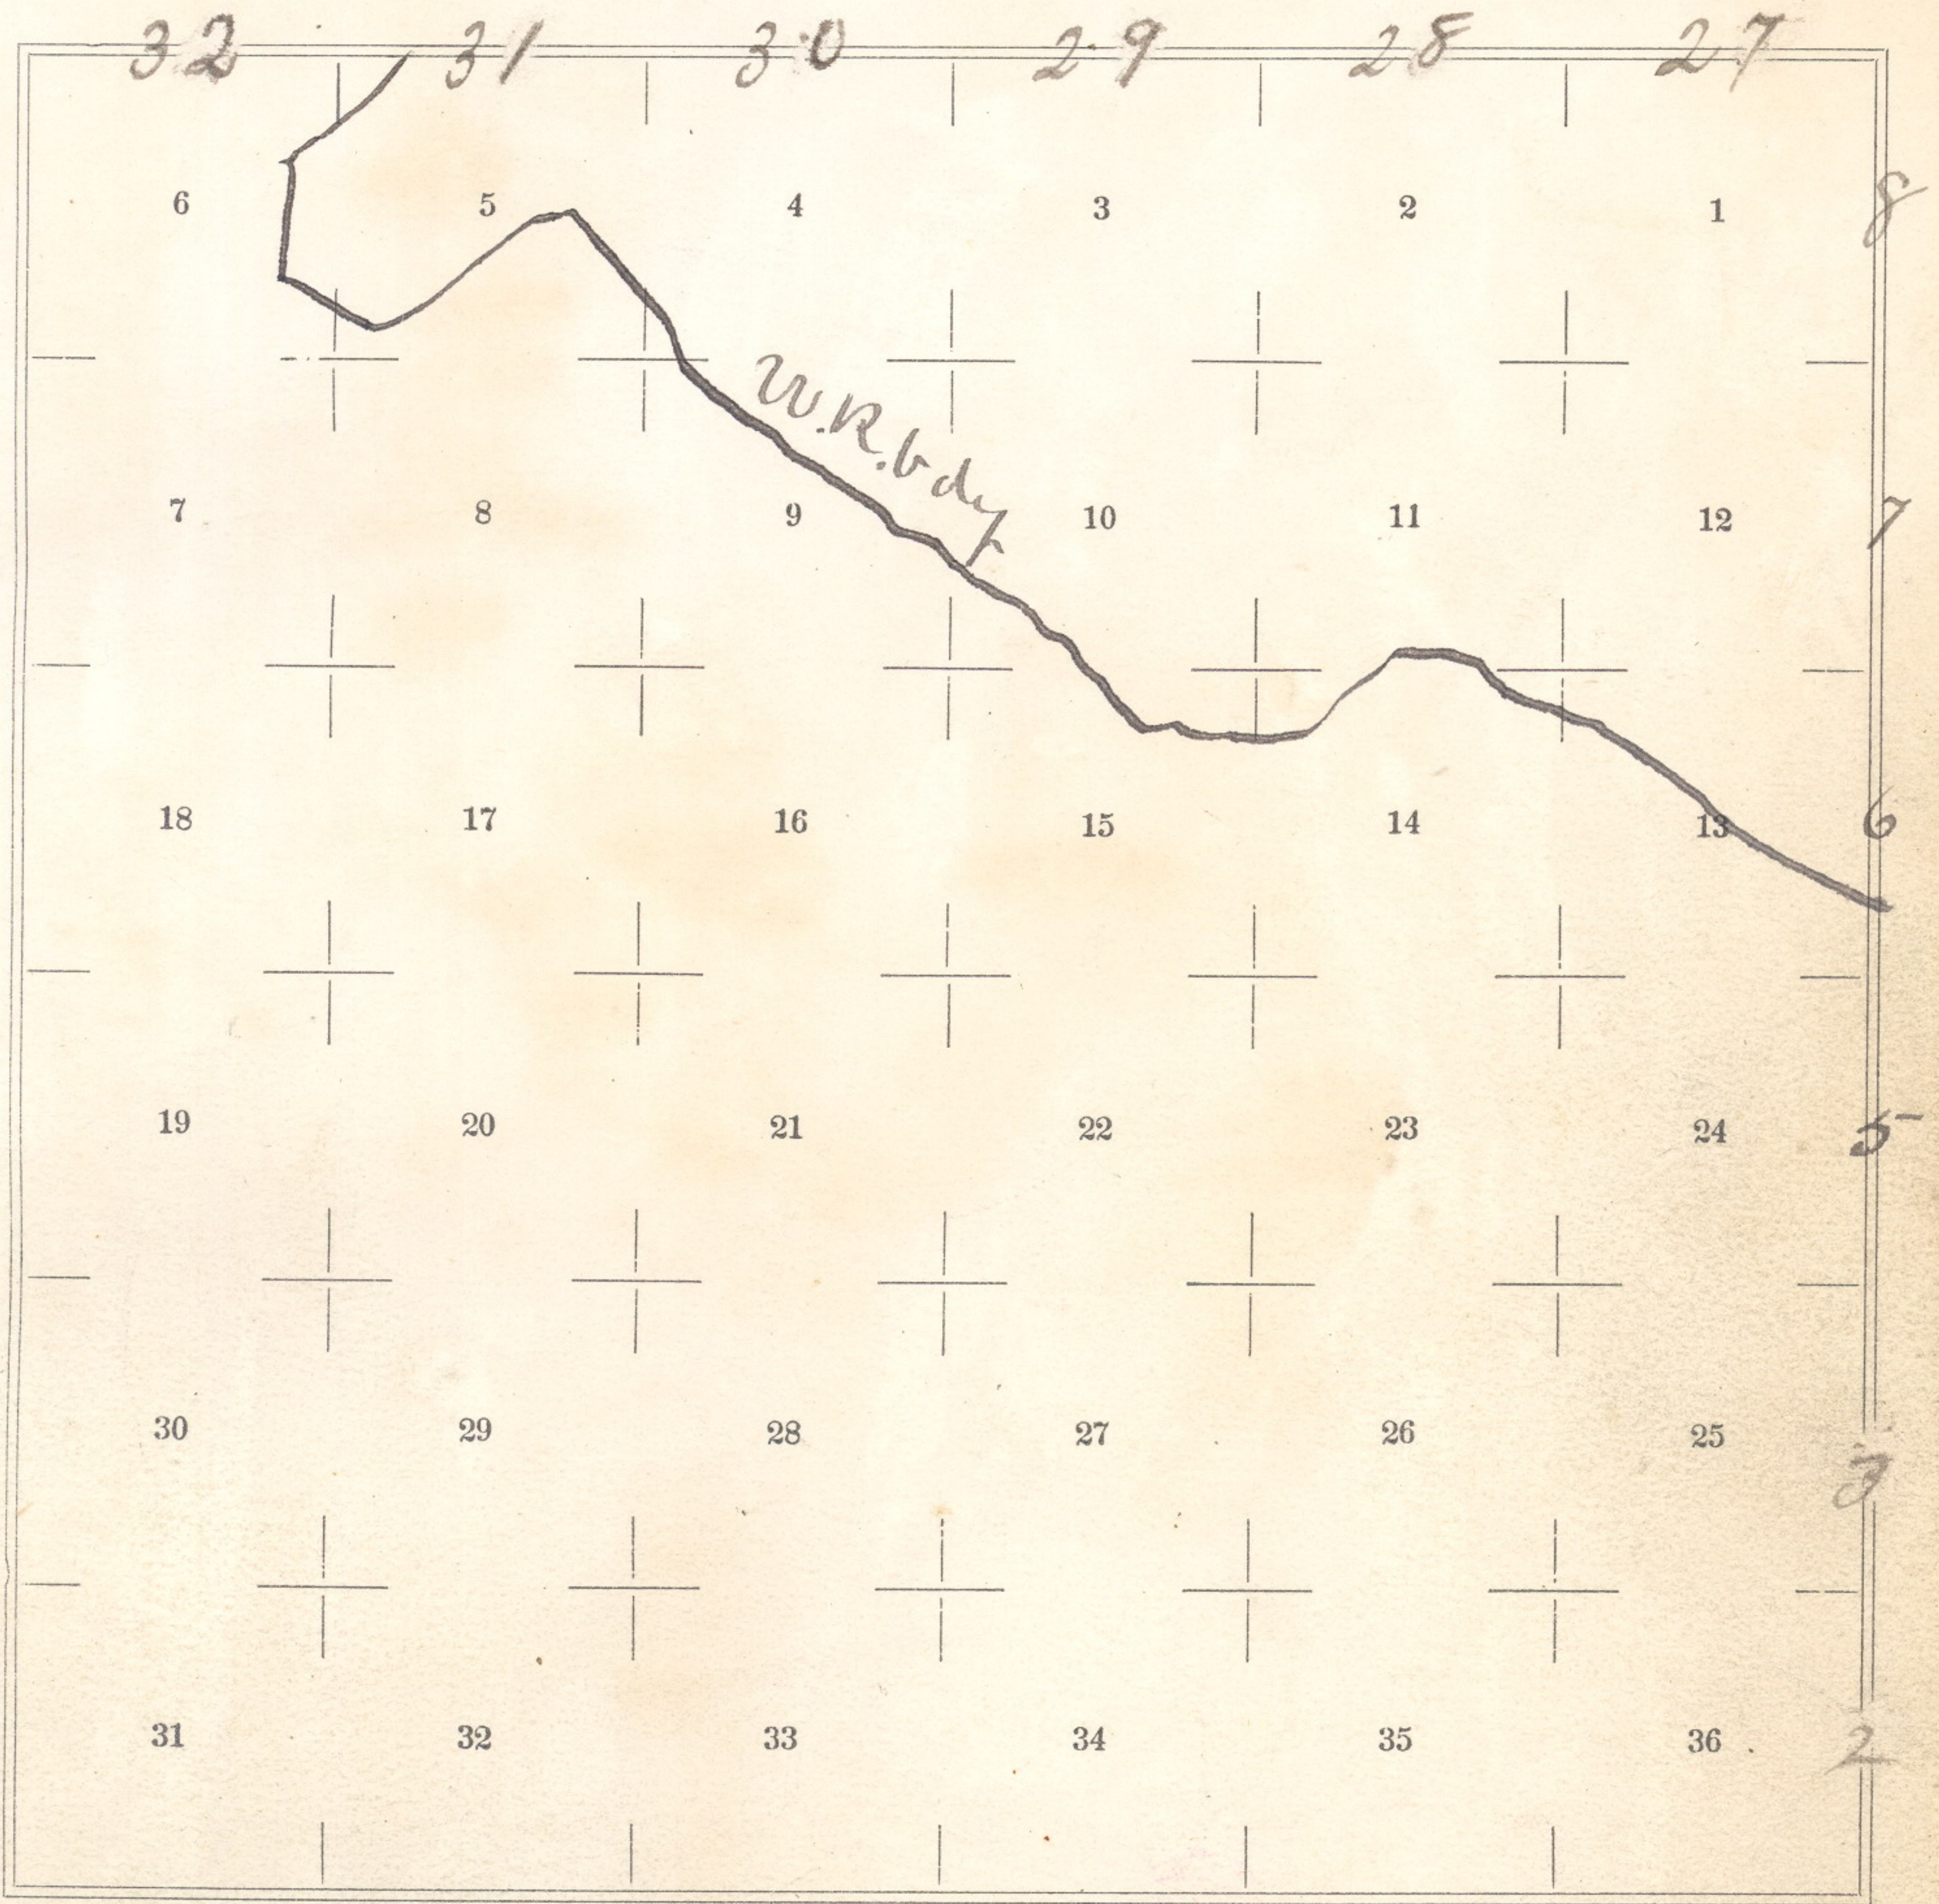

Meanders of \_\_\_\_\_, Pages \_\_\_\_\_ to \_\_\_\_\_

Meanders of \_\_\_\_\_, Pages \_\_\_\_\_ to \_\_\_\_\_



366 ~~367~~ ~~368~~ ~~369~~ ~~370~~

# INDEX

Referring the Lines to the Pages of the Field Notes.

T. 1 South R. 34 East Will. Mer.

40	6	5	4	3	2	1	23
38	7	8	9	10	11	12	22
37	18	17	16	15	14	13	20
36	19	20	21	22	23	24	19
35	30	29	28	27	26	25	18
34	31	32	33	34	35	36	17
	16	15	14	13	12	11	25

Sp. 1 S. R. 35 E

Meanders of \_\_\_\_\_ Pages \_\_\_\_\_ to \_\_\_\_\_  
 Meanders of \_\_\_\_\_ Pages \_\_\_\_\_ to \_\_\_\_\_

T28 35 E 6



Extensions of T. 7 South R. 34 East-  
Willamette Meridian, Oregon.

North an E. Bay, Sec. 1  
Var 1907

16.00 Descend

26.00 Branch 10 lks. wide Course N.W. -500

32.00 Top of Hill +600

40.00 Set a Charred post-36x3x3 ins 2 ft-  
in the ground for 1/4 Sec. Cor. marked  
1/4 S. and W. face. From which a fir 12  
ins in diam. ls. N 88° E dist-175 lks.

marked 1/4 S. B.T. a Pine 20 ins in diam. ls  
N 70° W dist-192 lks. marked 1/4 S. B.T.

61.50 Bed of creek Water in holes -800

82.90 Intersect-Base line 5.93 chs W. of  
1/4 Sec. Cor. on S. Bay. of Sec. 31 T. 1 N.

R. 35 E Set a basalt-stone 12x9x7 ins  
8 ins in the ground for Closing Cor.

To Tps. 1 S. Rs. 34 + 35 E. Marked 6 note  
hs on S. E + N. edges. + C.C. on S. <sup>face</sup> from

which a pine 12 ins in diam. ls. S 40° E

190 lks dist: marked T. 1 S. R. 35 E. S. C. C.C.

B.T. A pine 20 in. in diam. ls. S 20° W



2494

Extensions of T. 1 South R. 34 East

Willamette Meridian, Oregon.

(8093-10 M.)

208 aks. dist. W. of R. 34 E. S. 1 C.C. B.D.

No other trees in limits

Land level 16.00 chs

Mountains 66.90 chs.

Soil 3rd Rate

timber pine, fir + Tamarack with  
dense thickets of underbrush

June 27th 1884

This township is very rough  
& mountainous,

It contains some good timber  
but it is only valuable for  
grazing. Nearly the whole  
of it being covered with fine  
brush grass & being well  
watered by the McKay  
creek & its tributaries



# FINAL OATHS FOR SURVEYS.

A list of the names of the individuals employed by James P. Currier  
and James E. Holland, U. S. Deputy Surveyors, to assist in  
 running, measuring, and marking the lines and corners described in the  
 foregoing field notes of the survey of the Exterior lines of Tps. 1 & 2  
Rs. 32, 33, 34 & 35, Tps. 2 & 1, R. lines of 33 & 35 E, Tps. 1 & 2, Rs. 32, 33, 34 & 35 E  
Tps. 2 & 1, Rs. 32, 34 & 35 E Willamette Meridian, Oregon,  
 showing the respective capacities in which they acted:

- L. A. Wooley....., Compassman.
- J. J. Medley....., Chainman.
- W. H. Medley....., Chainman.
- Frank Belshaw....., Chainman.
- Guy Davis....., Chainman.
- B. B. Crowner....., Axman.
- J. R. Hadley....., Axman.
- ....., Flagman.

## FINAL OATHS OF ASSISTANTS.

We hereby certify that we assisted James P. Currier and James  
E. Holland, U. S. Deputy Surveyors, in surveying  
 all those parts or portions of the Exterior lines of Tps. 1 & 2, Rs. 32, 33, 34 & 35 E  
Tps. 2 & 1, Rs. 33 & 35 E, Tps. 1 & 2, Rs. 32, 33, 34 & 35 E, Tps. 2 & 1, Rs.  
3, 2, 34, & 35 E Willamette Meridian, Oregon,  
 as represented in the foregoing field notes as having been surveyed by  
 him and under his direction; and that said survey has been in all respects,  
 to the best of our knowledge and belief, well and faithfully surveyed,  
 and the corner monuments established, according to the instructions  
 furnished by the U. S. Surveyor General of Oregon.

- L. A. Wooley....., Compassman.
- J. J. Medley....., Chainman.
- W. H. Medley....., Chainman.
- Frank Belshaw....., Chainman.
- Guy Davis....., Chainman.
- B. B. Crowner....., Axman.
- J. R. Hadley....., Axman.
- ....., Flagman.

Subscribed and sworn to before me this 30<sup>th</sup> day of  
September, 1887.

[SEAL.]

James P. Currier  
 U. S. Deputy Surveyor.



## FINAL OATH OF DEPUTY SURVEYOR.

We, James P. Currier and James E. Poland, United States  
Deputy Surveyor, do solemnly swear that in pursuance of instructions  
received from Douglas H. Taylor, U. S.

Surveyor General for Oregon, bearing date of the 13<sup>th</sup>

day of May, 1887, I have well, faithfully,  
and truly, in my own proper person, and in strict conformity with the  
instructions furnished by the U. S. Surveyor General for Oregon, the  
Surveying Manual, and the laws of the United States, surveying all

those parts or portions of Exterior lines of Tps. 10, R. 32, 33 & 34 E. Tps.

20, R. 33 & 35 E. Tps. 10, R. 32, 33, 34 & 35 E. Tps. 20, R. 32, 34 & 35 E.

Willamette Meridian, in the State of Oregon, as are represented in the  
foregoing field notes as having been surveyed by me and under my  
directions; and I do further solemnly swear that all the corners of said  
survey have been established and perpetuated in strict accordance with  
the Surveying Manual, printed instructions, the special written instruc-  
tions of the U. S. Surveyor General for Oregon, and in the specific man-  
ner described in the field notes, and that the foregoing are the *true* field  
notes of such survey, and should any fraud be detected I will suffer the  
penalty of perjury under the provisions of an act of Congress approved  
August 8, 1846.

James P. Currier James E. Poland  
U. S. Deputy Surveyors

Subscribed and sworn to before me this Fifteenth

day of February, 1888

W. Woodcock  
Notary Public  
for Oregon



## Office of U. S. Surveyor General,

Portland, Oregon, June - 11<sup>th</sup>/<sub>4</sub>, 1888.*foregoing*

The following Field Notes of the Survey of the

Eastern lines of T. 1 S. Rgs 32.

34. E. T. 2 S. Rgs 33 and 35

T. 1 N. Rgs 32-33-34 and 35 East

T. 2 N. Rgs 32-34 and 35 East

Will. Mel. Or.

executed by James J. Currier and James E. Noel

Special Joint U.S. Dept. Surveyors

under his Contract No. —, dated May

4<sup>th</sup>, 1887, having been critically examined,

the necessary corrections and explanations made, the

said Field Notes and the survey they describe, are

hereby approved.

Douglas W. Taylor

Surveyor General.