

July 15 1874

304

Platted
C.S.

Field Notes of the Survey
of the Exterior Boundaries
and of the Subdivision Lines
of Township 3 South. of Range 36 East
of " 2 " " " 36 "
and of " 2 " " " 37 "
of the Willamette Meridian
in the State of Oregon.

by John A. Hurst. Deputy Surveyor
under his contract - No 201. bearing
date the 5th day of August 1873.

John

Casius. S. L. S.

Index

Referring here to pages of field notes.

JSS-R366. Willamette Meridian

	20	19	18	17	16	15						
13	6	94	5	81	4	72	3	63	2	54	1	1
	94		93		80		71		62		53	
12	7	92	8	80	9	71	10	61	11	52	12	
	91		91		79		70		60		51	
11	18	90	17	78	16	69	15	59	14	50	13	
	89		88		77		68		59		49	
10	19	87	20	76	21	67	22	58	23	48	24	
	86		85		75		66		57		48	
10	30	84	29	75	28	65	27	56	26	47	25	
	83		82		74		65		55		46	
9	31	82	32	73	33	64	34	55	35	45	36	
	8		7		6		5		4		3	

Index

Referring the lines to the pages of the field notes

T2S. R37E. Willamett Meridian.

29

S.6

28

S.7

27

S.18

26

S.19

25

S.30

24

S.31

112

111

109

107

105

99

110

32

108

33

106

34

104


35

98

36

97

97

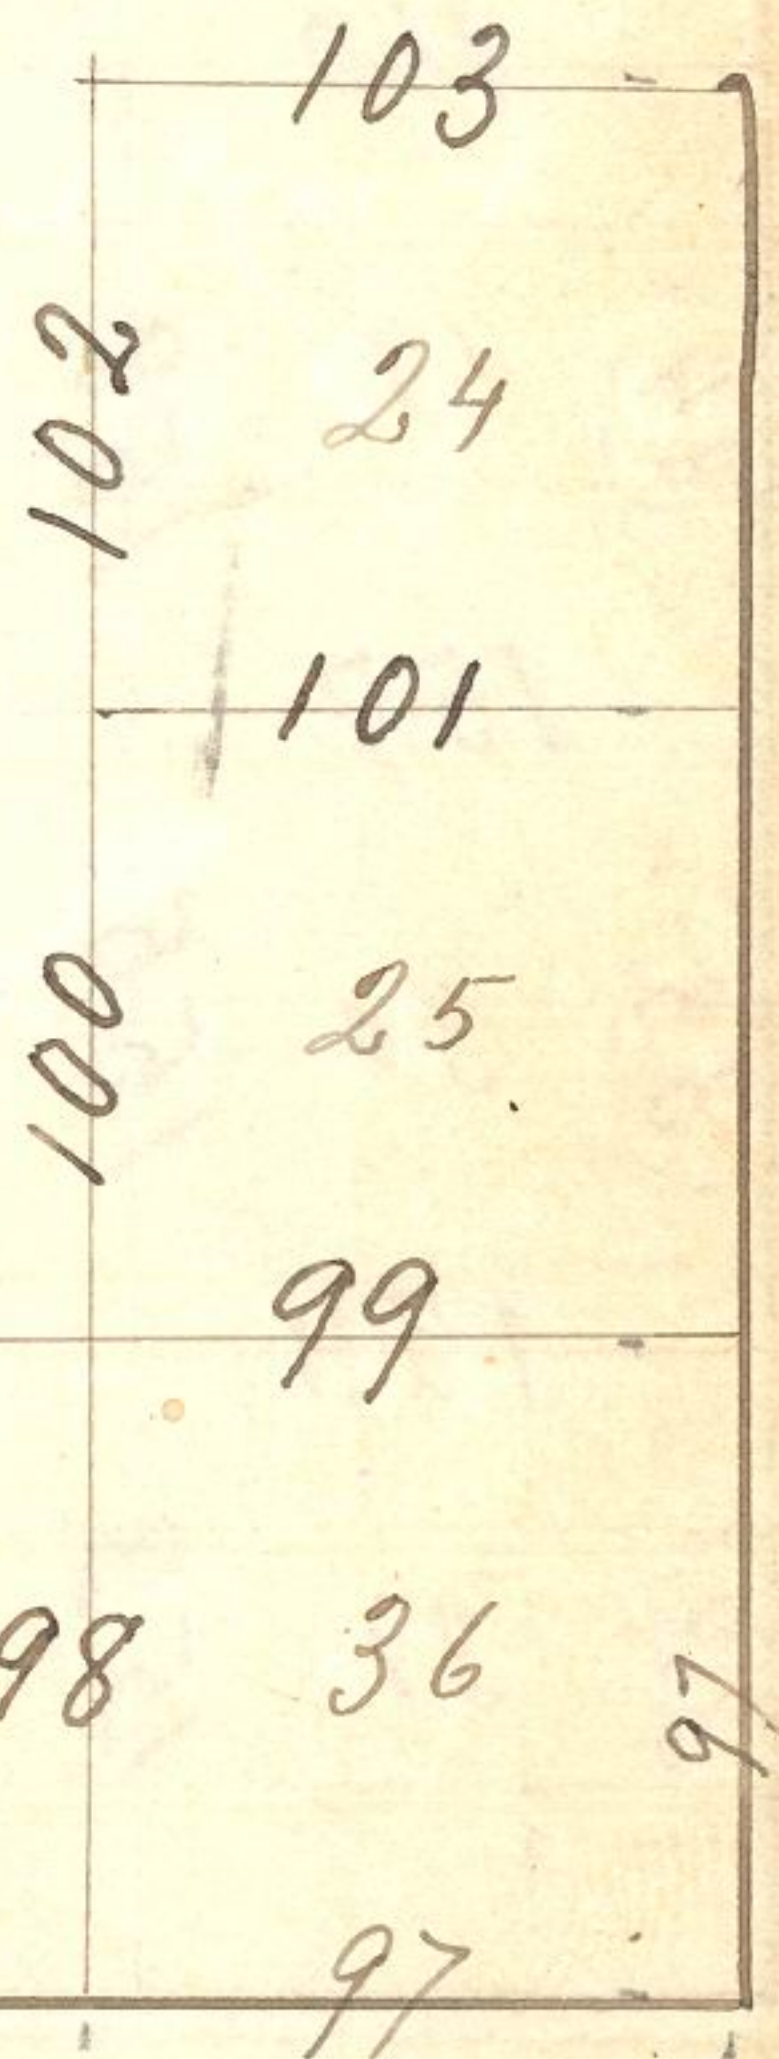

We Samuel Bacon and
 Caleb E. Cross do solemnly
 swear, that we will faithfully execute
 the duties of **Chain carriers**. That
 we will level the chain upon uneven
 ground, and plumb the tally pins,
 whether by sticking or dropping the same,
 that we will report the true distances to
 all notable objects, and the true length
 of all lines that we assist in meas-
 uring, to the best of our skill and
 ability.

Samuel Bacon
 Caleb E. Cross

Subscribed and sworn to
 before me 12th day of May 1874

W. W. Baker

Justice of the peace

I William Kee do solemnly
swear that I will well and
truly perform the duties of Appraiser
according to the instructions given
me, and to the best of my skill
and ability.

W^m Kee

Subscribed and Sworn
to before me ~~the~~ day of May 1874

W. W. Baker Justice of the Peace

Field Notes of the Survey
 of the Exterior boundaries of
 Township 3 South of Range 36 East
 Township 2 South of Range 36 East
 and Township 2 South of Range 37 East
 of the Willamette Meridian
 in the State of Oregon.

By John A. Harbort: Deputy Surveyor.
 under his Contract No. 201 bearing
 date the 5th day of August 1873.

East boundary of T 3 S. R 36 E.
 Willamette Meridian

Begin at South East cor of Sec 1

T 3 S. R 36 E. The witness trees all
 standing and agree with the description
 furnished me by the office. viz:

Pins 20 in dia S 8° E. 63 lks

Pins 10 in dia S 45° W. 104 lks

Pins 12 in dia N 20° W 39 lks.

North on East boundary of Sec 1

Var 21° - 00' East.

Willamette Meridian

North on West boundary of sec 6.

Var 21°-45' East

^{27.50} 27.50 Old road. Course East & West +210

^{40.00} 40.00 Set pine post 4 ft long. 3 in thick +100

2 ft in ground. for 1/4 sec cor

Pine 20 in dia N 68° W 44 lks

Fir 24 in dia N 70° E 48 lks

^{60.00} 60.00 brow of hill + level

^{80.00} 80.00 Set pine post 5 ft long. 5 in square -300

2 ft in ground. for corner to

townships 1 and 2 South. of range

35 and 36 East

Fir 12 in dia N 64° W 24 lks

Pine 8 in dia N 17° W 21 lks

Pine 8 in dia N 23° E 35 lks

Pine 10 in dia S 65° E 14 lks

Land. high and rolling. Soil

1st to 3rd rate. dense growth

of small black pine tam-
arack fir and spruce.

Land rolling soil fine
to 3rd class, but little grass.

Dense growth of black pine
Tamarack fir and spruce.

July 15th 1874. ~~There is a large~~

~~amount of fine grazing and~~
~~to this township containing a small~~
~~to large amount of fine timber~~
~~and grass land, and is farming~~

U.S. Surveyor General's Office
Eugene City Oregon

1874

The foregoing field notes of the survey of the
exterior lines of Tps 27 38 R 36 E and
T 28 R 37 E Will Mer Oregon executed
by John A. Hurlburt under his
contract No 201 bearing date
August 5th 1873 having been
critically examined the necessary corrections

and explanations made the said field notes
and the surveys they describe are hereby approved
Su Gen