4333 **Township No. 1 South Range No. 35 East Willamette Meridian Oregon**

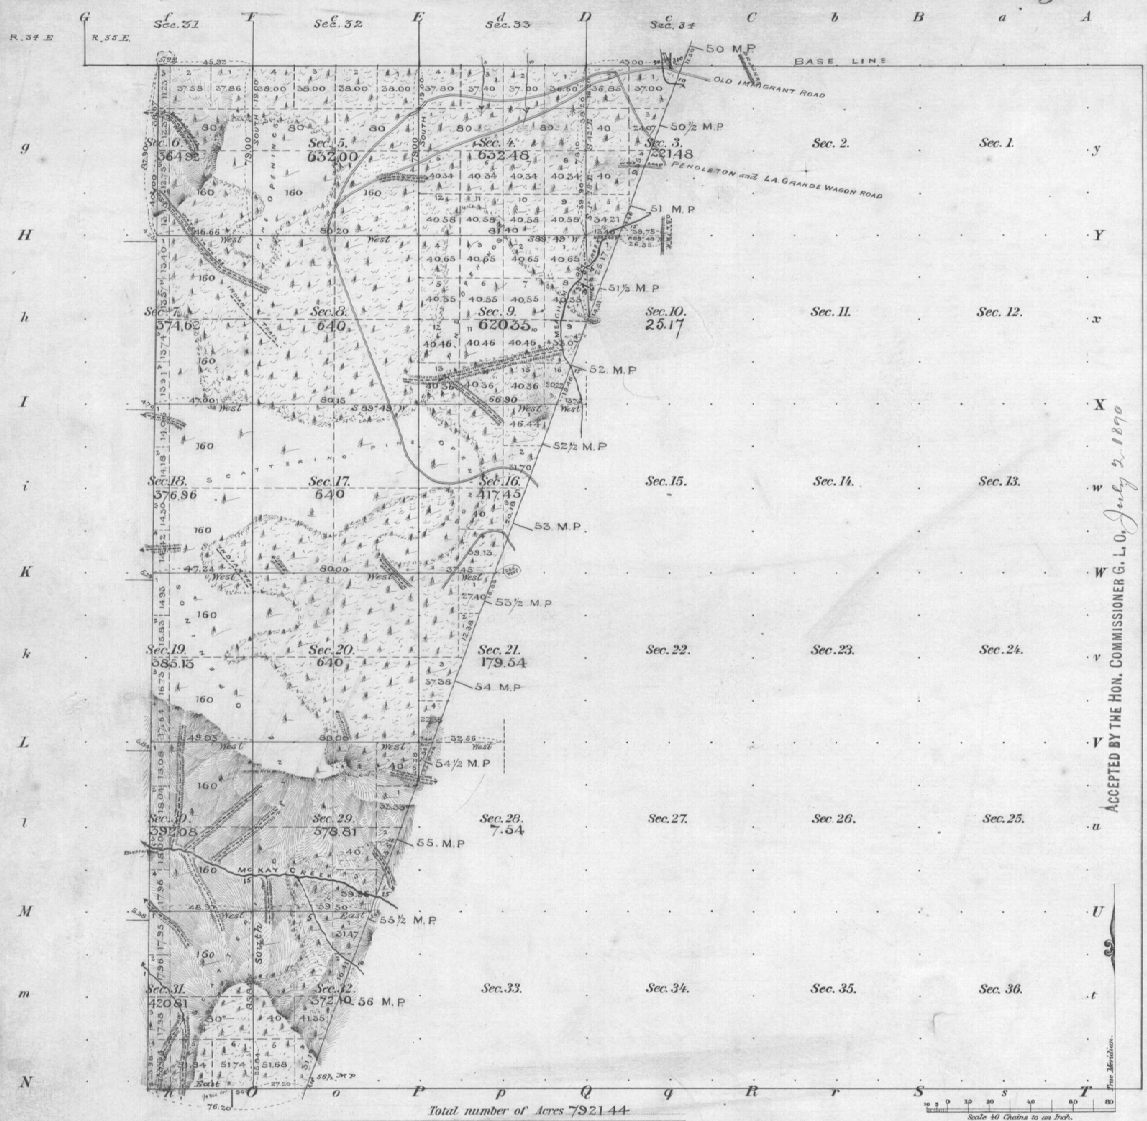

Total number of Acres 7921.44

ACCEPTED BY THE HON. COMMISSIONER G. L. O. July 2. 1870

Meanders of								
Posts	Courses	Ch.'s Lk.'s	Posts	Courses	Ch.'s Lk.'s	Posts	Courses	Ch.'s Lk.'s

Surveys Designated	By Whom Surveyed	Date of Contract	Amount of Surveys M. Ch.s Lk.s	When Surveyed	Mean Declination
Township lines	Curran & Noland	May 4th 1887			
Subdivisions	" "	" "	22. 05. 15	June 23d to July 3. 1887	18° 15' to 25° 30' E.
Connections	" "	" "	1. 46. 66	" "	" "

The above Map of Township No. 1 South of Range No. 35 East Willamette Meridian, Oregon, is strictly conformable to the field notes of the survey thereof on file in this Office, which have been examined and approved.

Surveyor Generals Office, Portland, Oregon June 14. 1890

Douglas W. Taylor Surv. Gen.