


Township No. 1 South Range No. 35 East Will. Mer.

4331

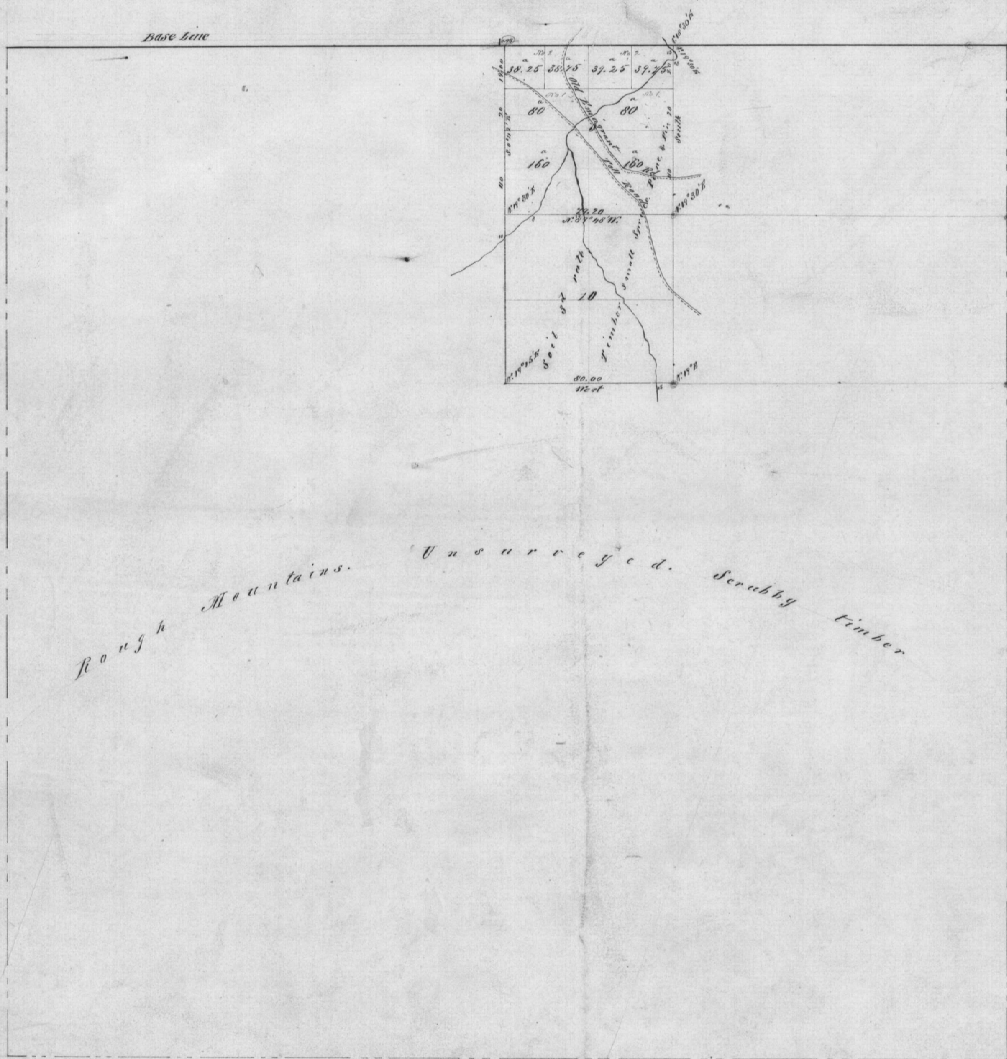


From Meridian  
No. 10000 of 18 11 20 1/2

Scale 10 Chains to an inch

Survey designated	By whom surveyed	Contract		Acut of Survey	When surveyed
		No.	Date		
Subdivisions	Thompson & Ogden	104	Apr. 18th 1863	5 20	May 1st 1863
Total Acres 9,572.88					

The above map of the Survey of Subdivisional lines in Town 16 Range 35 East Will. Mer. Oregon, is truly conformable to the file plats of the Survey, kept on file in this office, which have been examined and approved.  
 Surveyor General's Office  
 Oregon City, Aug. 24 1864  
 J. J. Rogers  
 Secy. Gen. of Div.