

Washington transcripts made





13

D. H. Murphy

Q


Index Diagram

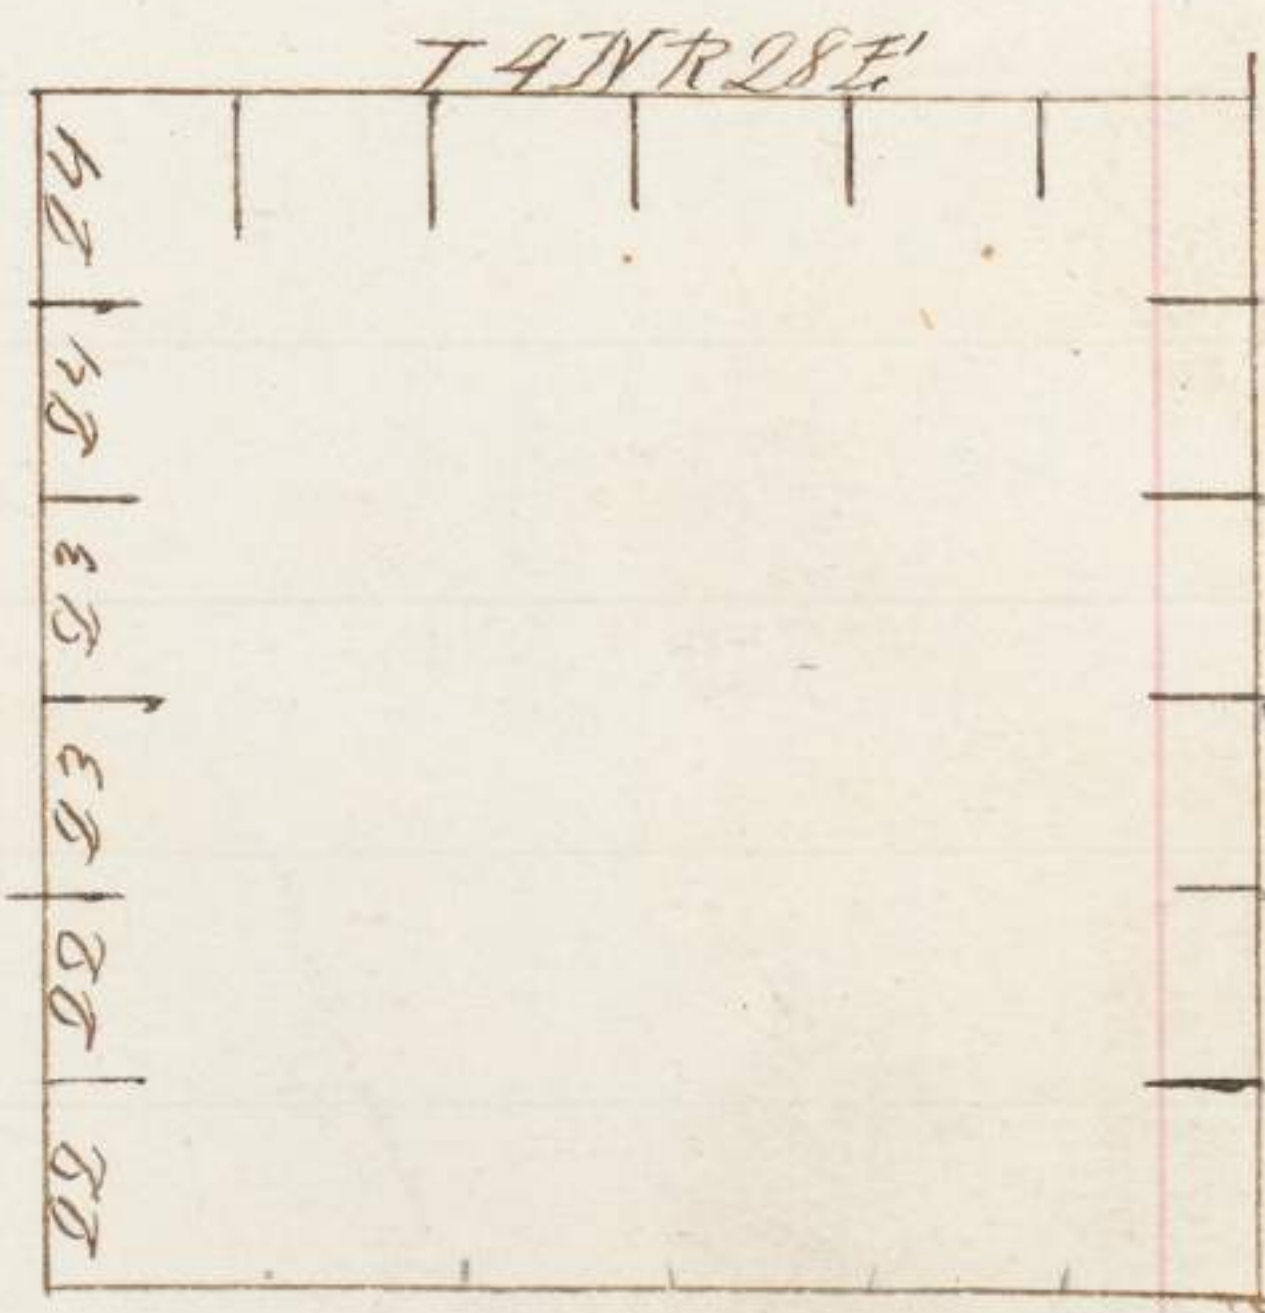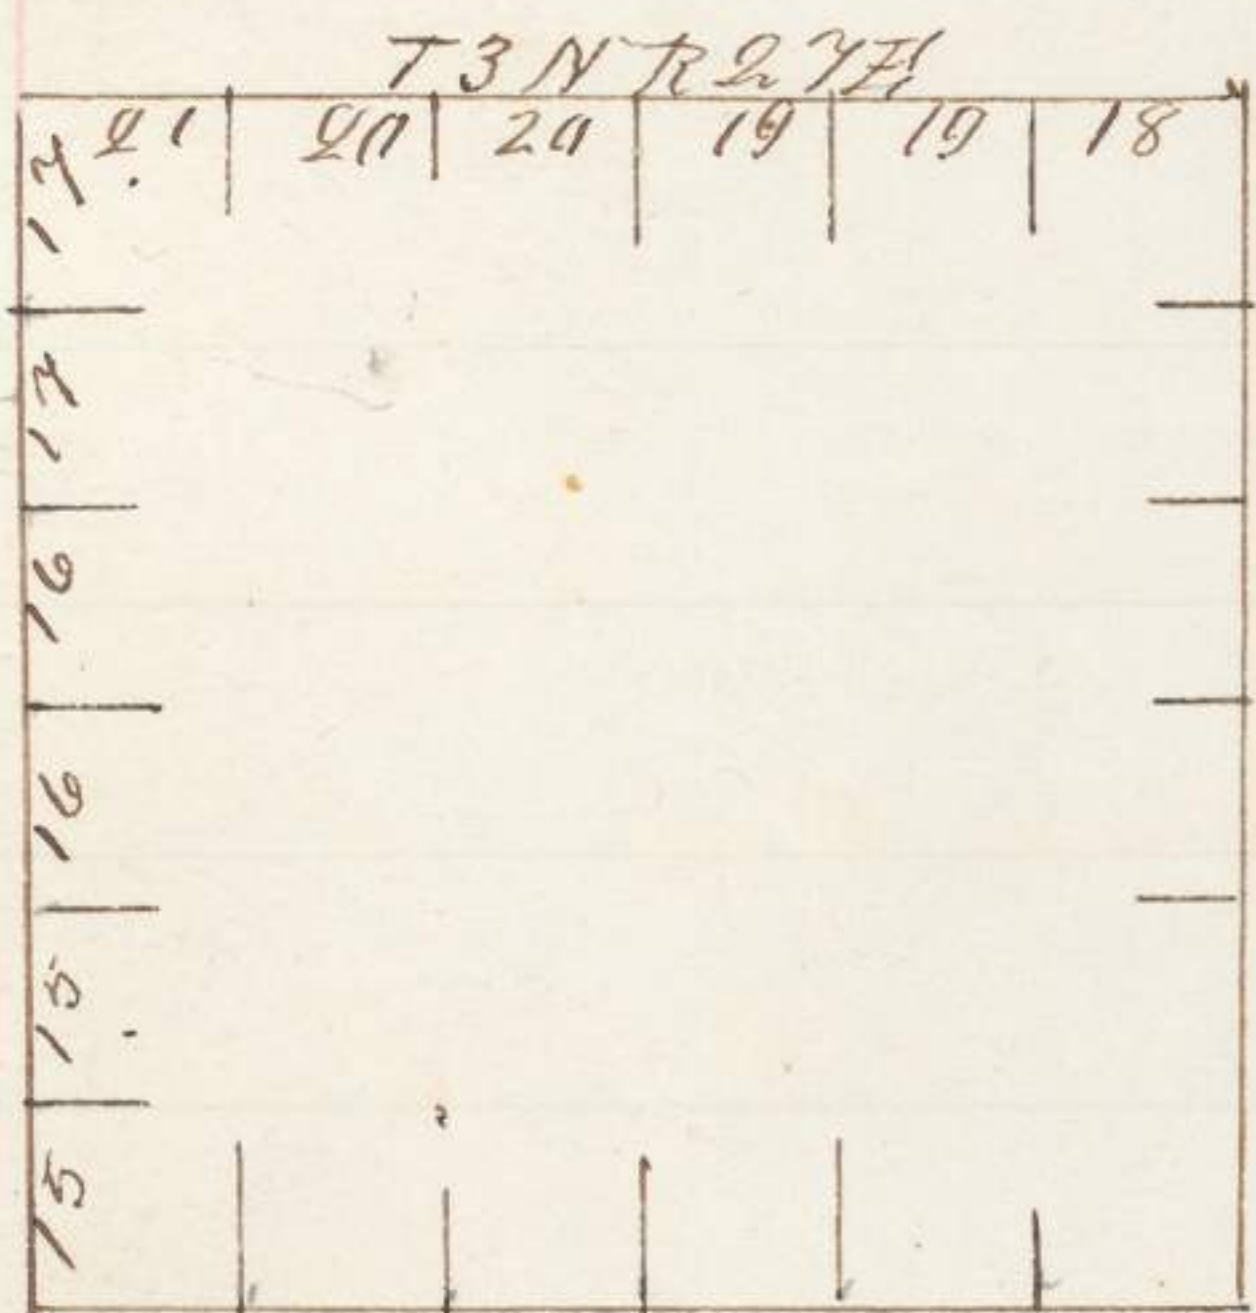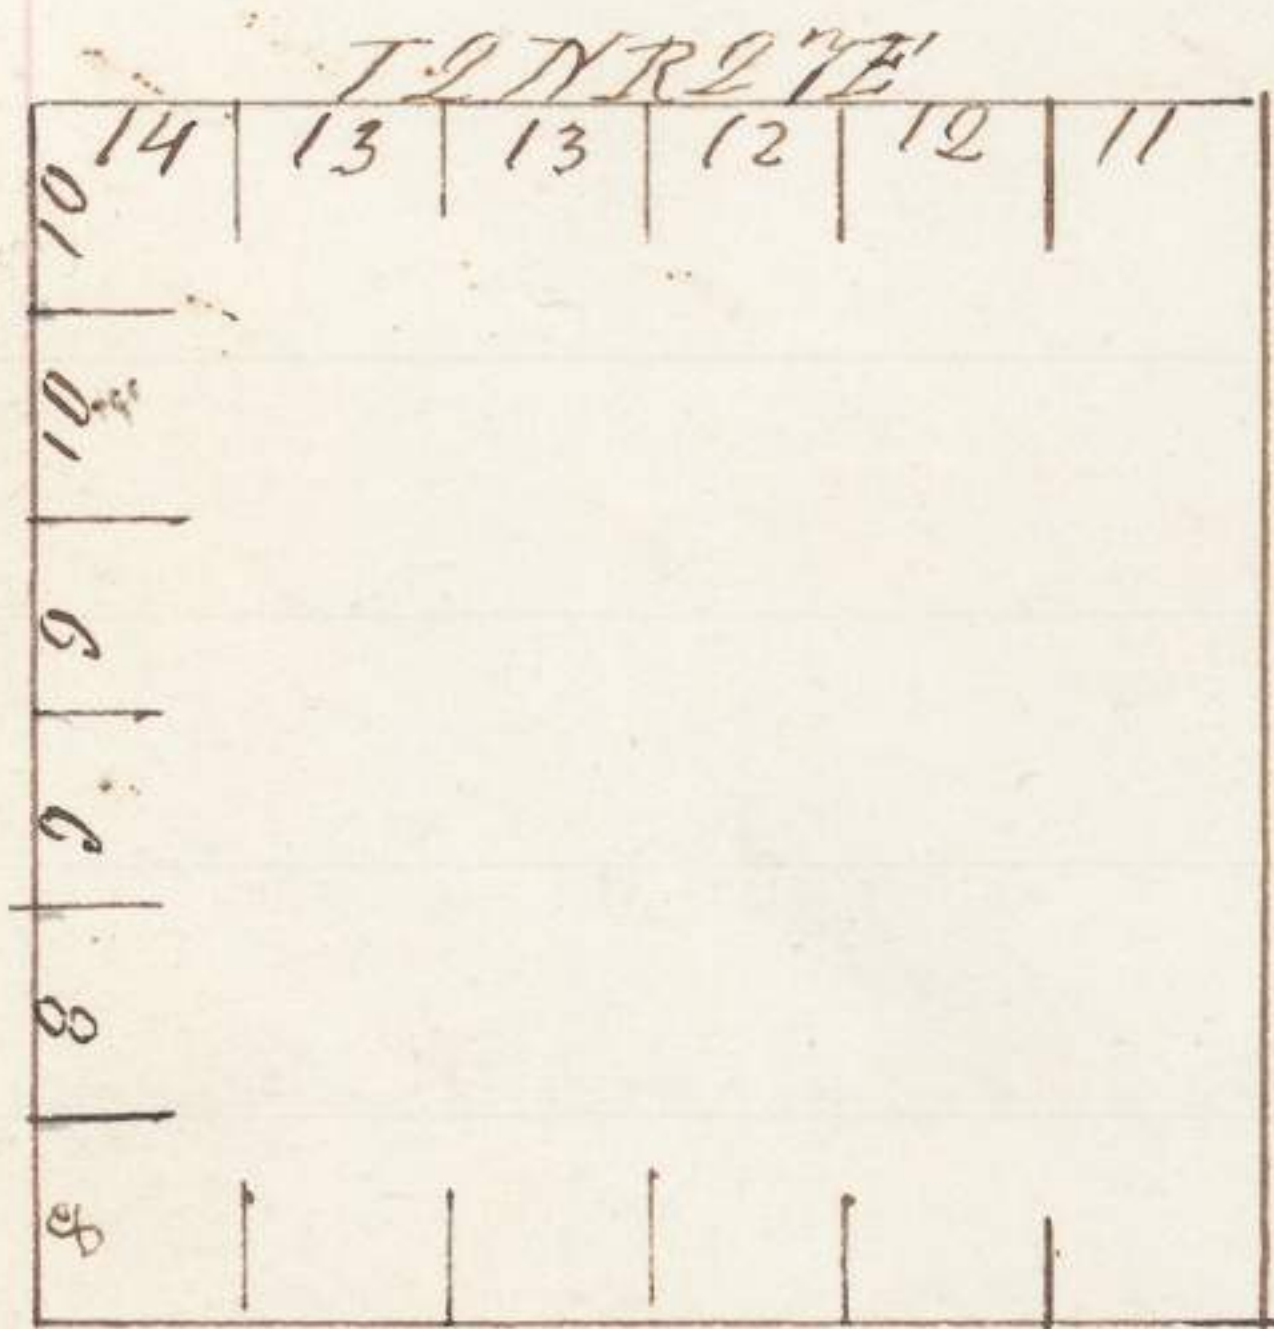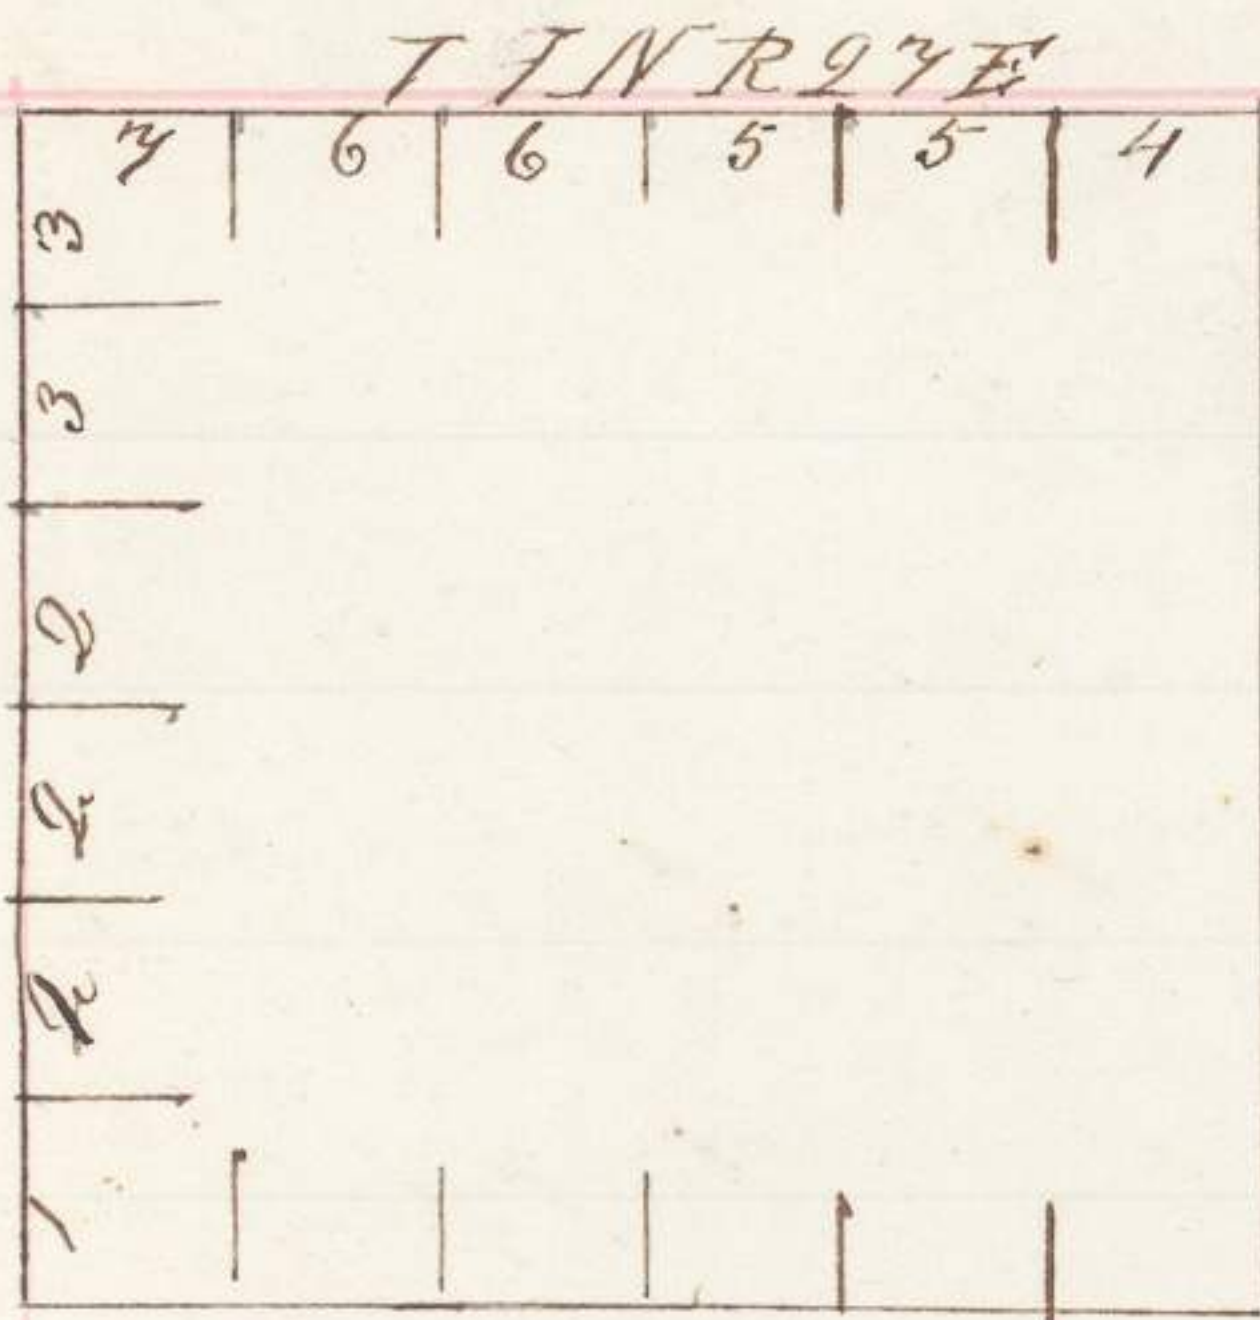

We William McKealy, A. J. Chapman, C. H. Miller

~~August Moor~~ do solemnly swear, that we will faithfully execute the duties of chain carriers that we will level the chain upon uneven ground and plumb the tally pins whether by sticking or dropping the same; that we will report the true distance to all notable objects, and the true length of all lines that we ^{may} assist in measuring to the best of our skill and ability

William McKealy
A. J. Chapman
C. H. Miller
August Moor

Subscribed and sworn to before me a Notary Public for Lane County ^{of the} 10th day of September 1860.

A. W. Patterson
Notary Pub.

Mr. Jacob McDaniel & F. M. Mansfield

do solemnly swear that we
 will faithfully execute the duties of
 chain carriers, that we will level the
 chain upon uneven ground and plumb
 the tally pins whether by sticking or
 dropping the same. That we will report
 the true distance to all notable objects
 and the true length of all lines, that
 we assist in measuring to the best
 of our skill and ability

Jacob McDaniel
 F. M. Mansfield

Jacob McDaniel and F. M. Mansfield subscribed
 and swore to the above at my office in ^{Oregon} Lincoln County
 this 12th day of September 1860

Moses Mansfield
 Justice of the Peace

Mr F. M. Mansfield and William
H. Healey do solemnly swear that ^{we} will
well and truly perform the duties of
a juror according to instructions given
us and to the best of our skill and
ability

F. M. Mansfield
William H. Healey

Subscribed and sworn to before me
a Justice of the Peace at ^{my} office in Linn
County on this 12th day of September
1850

Moses Mansfield
Justice of the Peace

Field Notes of the Survey of the
exterior boundaries of Townships 1, 2, 3
North Range 27 East and Township
No 4 North of Range 28 East of the
Willamette Meridian in the State of
Oregon by Ebenezer E Hoast, deputy,
Surveyor, under his contract No 93
bearing date the 11th day of September
1860

Commenced September 23rd 1860

Completed October 18th 1860

Between Ranges 26827E T 1 North

Chains North between Secs 7812

Mar 19th 30th

- 40.00 Set post for gr see corner in mound
with trench and pits and deposited
1 pint of charcoal as per instructions
- 80.00 Set post for corner to Sec 112, 687
in mound with trench, and pits and
deposited 1 pint of charcoal as per
instructions, Soil 2nd & 3rd rate
Land gently rolling

North between Sec 146

Mar 20th

- 40.00 Set post for gr see corner in mound
with trench and pits and deposited
1 pint charcoal as per instructions
- 80.00 Set post for corner to Townships 149 North
Ranges 26827 East in mound
with trench and pits and deposited
1 pint charcoal as per instructions
Soil 2nd & 3rd rate
Land gently rolling

Between Ranges 26427E T^h North

Chains

September 25th 1860

From the corner to Township 182 N Ranges 26427E

with a north Meridian from

North between Secs 31 & 36

Var 20° 10' E

- 40.00 Set post for gr sec corner in mound
with trench and pits and deposited
1 pint of charcoal, as per instructions
- 80.00 Set post for corner to Secs 30, 31, 25 & 36
in mound with trench and pits and
deposited 1 pint of charcoal as per instructions
Soil 2nd rate Land gently rolling

North between Secs 30 & 25

Var 19° 45' E

- 40.00 Set post for gr sec corner in mound
with trench and pits and deposited
1 pint of charcoal as per instructions
- 80.00 Set post for corner to Secs 19, 30 & 24 & 25
in mound with trench & pits and deposited
1 pint of charcoal, as per instructions
Soil 3rd rate Land high and rolling

Between Ranges 26427E T2N

Chains North between Secs 19 & 24

Mar 19th 30th E

40.00 Set post for gr sec corner in mound
with trench and pits and deposited
1 pint of charcoal, as per instructions

80.00 Set post for corner to Secs 18, 19, 13 & 14
in mound with trench, and pits and
deposited 1 pint charcoal, as per instructions

Soil 2nd & 3rd rate, producing grass

Land rolling

North between Secs 13 & 18

Mar 19th 40th E

40.00 Set post for gr sec corner in mound
with trench and pits and deposited
1 pint of charcoal, as per instructions

80.00 Set post for corner to Secs 7, 18, 12 & 13 in
mound with trench and pits and
deposited 1 pint charcoal as per
instructions

Soil 2nd rate Land rolling

39

(10)

Between Ranges 26 & 27 East T2 North

Chairs North between Sec 12 & 7

Nov 19th 45th

40.00 Set post for gr see corner in mound with trench and pits and deposited 1 pint of charcoal, as per instructions in Road from Dulles to Walla Walla bearing N60^oE

80.00 Set post for corner to Sec 6. 7 1412 in mound with trench and pits and deposited 1 pint of charcoal as per instructions
Soil 3rd rate light, sandy
~~Soil~~ Sand rolling

North between Secs 1 & 6

Mar 19th 50th

40.00 Set post for gr see corner in mound with trench and pits, and deposited 1 pint of charcoal, as per instructions

80.00 Set post for corner to Township 203 N. Ranges 26 & 27 East in mound with trench & pits and deposited 1 pint of charcoal, as per instructions
Soil 3rd rate Sand rolling

List of Names

List of the names of the individuals employed to assist in running measuring or marking the lines and corners described in the foregoing field notes of the exterior lines of Townships No 1, 2, & 3 North of the base line of Range No 27 East and townships No 4 North of Range No 28 East of the Millonette Meridian showing the respective capacities in which they acted

C. H. Miller } Chairman
 Jacob M. Daniel } Chairman
 F. M. Mansfield } Axeman

We hereby certify, that we assisted Ebenezer
 & Haft Deputy Surveyor, in surveying the
 western lines of Townships No One (11)
 Two (2) and Three (3) North of the Base
 line of Range Number 27 East of the Will
 amette Meridian, and Township No Four
 (4) North of Range 28 East of the
 Willamette Meridian, and that said Townships
 have been in all respects, to the best of
 our knowledge, and belief, well and
 faithfully surveyed, and the boundary
 monuments planted according to the
 instructions furnished by the Surveyor General

Jacob McDaniel, Chairman
 C. H. Miller, Chairman
 F. McHansfield, Axeman

Subscribed and sworn to before me
 a County Judge for Lane County in the
 State of Oregon this the 19th day of
 November A.D. 1861

W. S. Brock
 County Judge

I Ebenezer E. Hoft deputy Surveyor
do solemnly swear that in pursuance
of a contract with W. W. Chapman Surveyor
of the Public Lands of the United States
in the State of Oregon, bearing date the
11th day of September 1860 and in strict
conformity to the laws of the United States
and the instructions furnished by said
Surveyor General, I have faithfully surveyed
the Exterior boundaries of Townships No
One, Two and Three North of the base
line of Range, No twenty seven East of
the Willamette Meridian, and Townships
No four, North of the base line of Range
No Twenty eight East of the Willamette
Meridian in the state aforesaid, and
do further solemnly swear that the
foregoing are the true and original
field notes of such survey

Ebenezer E. Hoft

Deputy Surveyor

Subscribed and sworn to by
said Ebenezer E. Hoft deputy Surveyor

before me a Notary public for Lane
County in the State of Oregon. This
11th day of November A.D. 1860

A. W. Patterson
Not. Pub.

Surveyor General's Office
 Eugene City, Decr. 31st 1860.
 The foregoing field notes of the
 Survey of the the Exterior Lines
 of Townships No. 1, 2 & 3 N. Range
 No. 27 East - and Townships No.
 4 N. Range No. 28 East of
 the Willamette Meridian - execu-
 ted by Ebenezer C. Haft, deputy
 Surveyor, under his contract
 of the 11th day of September 1860
 having been critically exam-
 ined, the necessary corrections
 and explanations made, the
 said field notes and the sur-
 veys they describe are hereby
 approved.

W. W. Chapman

Surv. Genl. of Oregon