4066

Township No. 2 North Range No. 32 East Willamette Meridian Oregon.

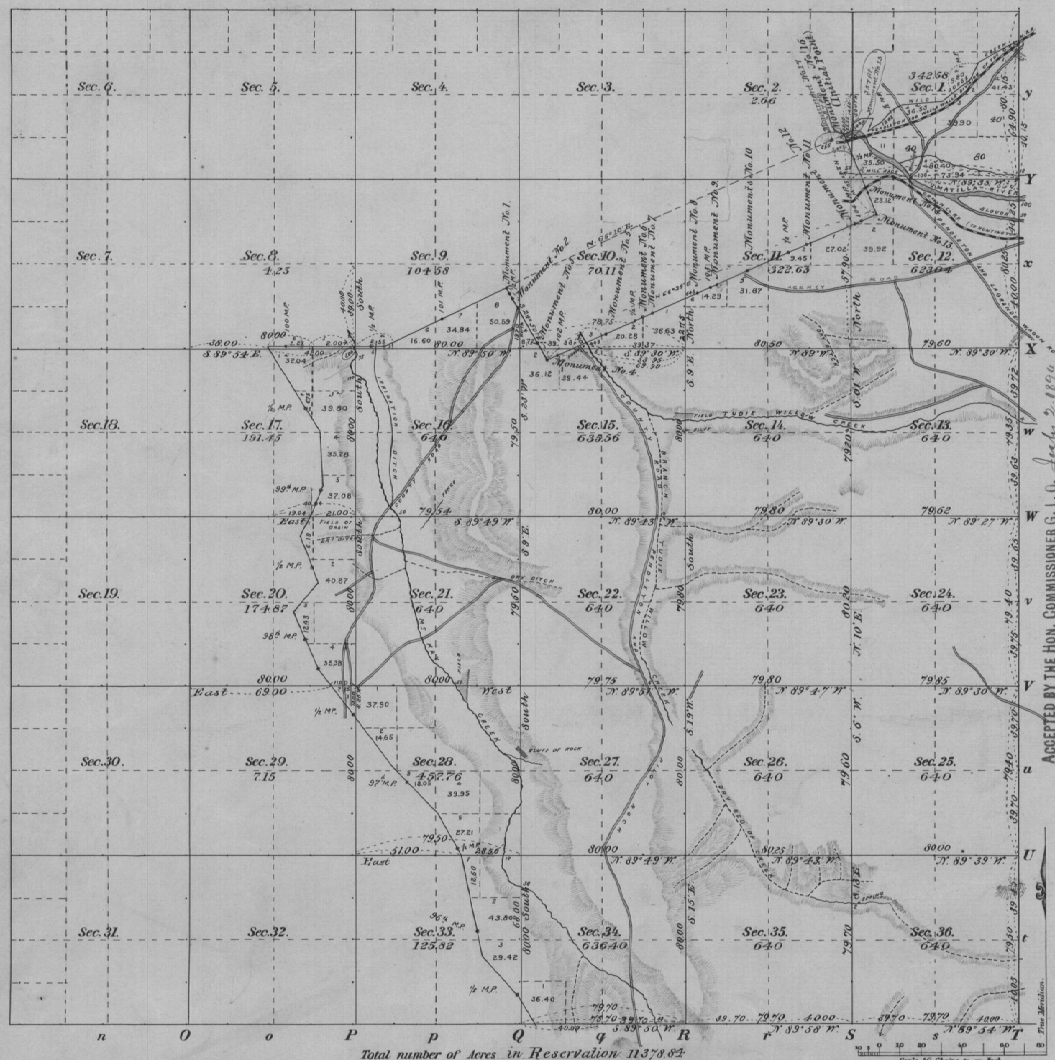

Total number of Acres in Reservation 11378.84

Meanders of								
Posts	Courses	Ch'l Lks	Posts	Courses	Ch'l Lks	Posts	Courses	Ch'l Lks

By Executive Order No. 4662 dated June 7, 1927, parts of Sections 34 & 35 are included in the McKay Creek Bird Refuge. (See Commissioner's letter 1266.717 A.B.V.C dated July 18, 1927.)

ACCEPTED BY THE HON. COMMISSIONER G. L. O. July 2, 1890

Surveys Designated	By Whom Surveyed	Date of Contract	Amount of Surveys M.	Ch's	Lks	When Surveyed	Mean Declination
Township lines Subdivisions	Currin & Noland	May 4th 1887	56	04	35	July 27 and 29 1887	20° 30' E.

The above Map of Township No. 2 North, of Range No. 32 East Willamette Meridian, Oregon, is strictly conformable to the field notes of the survey thereof on file in this Office, which have been examined and approved.

Surveyor Generals Office, Portland Oregon June 14, 1890.

Douglas W. Taylor, Sur. Gen'l