

(4-674.)

Township 2N

R. 33E

			79.90		
			79.80	4990	8000
6	5	4	3	2	1
			79.90	7980	8000
				7970	8000
			79.92		
			79.84		
7	8	9	10	11	12
			79.80	4970	
				4980	7980
			79.90		
			80.00	7970	79.75
18	17	16	15	14	13
			80.00	7975	79.88
				7990	7990
			80.10	8000	80.00
			80.00	8000	4990
19	20	21	22	23	24
			79.92		
				79.90	79.85
			79.80		
			49.95		
			79.70	79.70	79.88
30	29	28	27	26	25
			80.00	79.80	79.75
				79.80	
			80.00		
			79.60	79.90	
			79.60	79.90	
31	32	33	34	35	36
			79.80	79.90	
			8000	8000	8000

# FIELD NOTES

Of the survey of the Sub-Subdivisional

Lines of Township 2 North

Range 33 East Willamette Meridian,

Oregon, as surveyed by Jas. P. Corrin and Jas. Nolan

U. S. Deputy Surveyor, <sup>their</sup> under his Contract No. \_\_\_\_\_

dated May 4<sup>th</sup> 1887

Survey commenced, October 20<sup>th</sup> 1887

Survey completed, October 28<sup>th</sup> 1887

## NAMES AND DUTIES OF ASSISTANTS.

Frank Hooley, Compassman.

G. G. Perry, Chainman.

Guy Davis, Chainman.

J. R. Hadley, Chainman.

A. L. Rapier, Chainman.

C. Hoels, Axeman.

J. H. Herndon, Axeman.

\_\_\_\_\_, Flagman.

# PRELIMINARY OATHS OF ASSISTANTS.

We, E. G. Perry, Guy Davis  
J. R. Hadley, O. S. Raper

do solemnly swear that we will faithfully execute the duties of Chain Carriers, that we will level the chain over even and uneven ground, and plumb the tally pins, either by sticking or dropping the same; that we will report the true distance to all notable objects, and the true length of all lines that we will assist in measuring, to the best of our skill and ability, and in accordance with the instructions given us in

the survey of the Sub-Subdivisional

lines of T 2 North

Range 33 East Willamette Meridian, Oregon.

E. G. Perry, Chainman.


Guy Davis, Chainman.

J. R. Hadley, Chainman.

O. S. Raper, Chainman.

Subscribed and sworn to before me, this 20th

day of October 1887

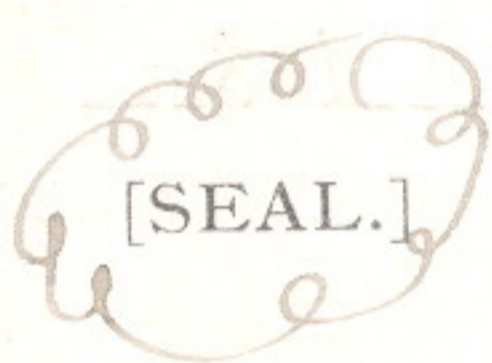

James E. Toland  
U.S. deputy Surveyor

We, C. Moses and

J. H. Henderson, do solemnly swear

that we will well and truly perform the duties of Axemen in the establishment of corners and other duties, according to instructions given us, and to the best of our skill and abil-

ity, in the survey of the Sub-Subdivisional lines


of T 2 North 33 East Willamette Meridian, Oregon.

C. Moses, Axeman.

J. H. Henderson, Axeman.

Subscribed and sworn to before me, this 20th

day of October 1887

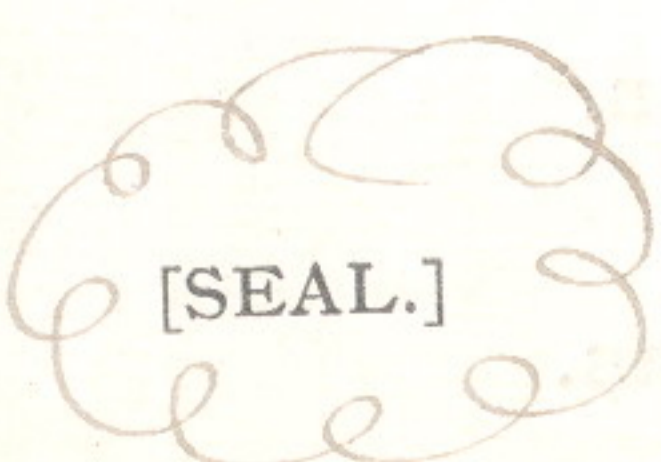

James E. Toland  
U.S. deputy Surveyor

# INDEX

Referring the Lines to the Pages of the Field Notes.

T. *2 North* R. *33 East* Will. Mer.

			93	057	23
6	5	4	391	255	121
			89	53	19
			87		
7	8	9	1085	1151	12
			83	49	17
			81	47	15
18	17	16	1579	1445	1313
			77	43	11
			75	41	9
19	20	21	2273	2339	247
			71	37	5
			105	69	3
30	29	28	103	2767	2633
			101	65	31
			99	63	29
31	32	33	97	3461	3527
			95	59	025
					36

Meanders of \_\_\_\_\_ Pages \_\_\_\_\_ to \_\_\_\_\_

Meanders of \_\_\_\_\_ Pages \_\_\_\_\_ to \_\_\_\_\_

Sub. Subdivision of T. 2 North R. 33 East  
Willamette Meridian, Oregon.

From the 1/4 sec. cor. between 25 & 26  
(25-26)

- 7975 East through center of sec 25  
    Ca 19° East  
Commencing at 1/4 sec. cor. bet sec  
25 and 26, Set temporary  
sec. cors at 2040 and 60 chains and at  
Intersect E. bdy. Township at  
1/4 sec cor bet sec 25 and 30.  
Thence West on true line Ca same
- 1994 Deposited charred stake 12 ins. in  
the ground for 1/4 sec. cor. dug  
pits 18 x 18 x 12 ins E and W. of stake  
5 1/2 ft. dist raised mound of earth  
1 1/2 ft. high 3 1/2 ft. base over it  
and in E pit drove stake 2 ft long  
2 ins square 12 ins in the ground  
marked 1/4 S. on N. face
- 3000 Spring branch 2 lbs. course N.
- 3988 Deposited charred stake 12  
ins. in the ground for 1/4 sec  
cor. dug pits 18 x 18 x 12 ins  
E and W. of stake 5 1/2 ft. dist

Sub-Subdivisions of T. 2 North R. 33 East  
Willamette Meridian, Oregon.

(8093-10 M.)

- raised mound of earth  
1 1/2 ft high 3 1/2 ft base  
over it and in E pit drove  
stake 2 ft long 2 ins square  
12 ins in the ground  
marked 4 on N. face
- 4800 Wagon road to La Grande T. C.
- 5982 Deposited charred stake 12 ins  
in the ground for 1/16 sec.  
cor. dug pits 18 x 18 x 12 ins  
E and W. of stake 5 1/2 ft dist  
raised mound of earth 1 1/2  
ft high 3 1/2 ft base over  
it and in E pit drove stake  
2 ft long 2 ins square  
12 ins in the ground  
marked 1/16 on N. face.
- 7975 1/4 sec. cor. bet. sec. 25 & 26.  
Land rolling  
Soil 2nd rate  
Very little grass

Sub-Subdivision of T. 2 North R. 33 East  
 Willamette Meridian, Oregon.

East on random through N<sup>1</sup>/<sub>2</sub> of  
 Sec 25

To 19° East

Commencing at <sup>1</sup>/<sub>16</sub> sec. cor. 20 chains  
 N of <sup>1</sup>/<sub>4</sub> sec. cor. bet. sees. 25<sup>th</sup> & 26

Set temporary <sup>1</sup>/<sub>16</sub> sec. cor. at  
 20, 40 and 60 chains, and at

7948 Intersect E bdy Township

S. lks S of <sup>1</sup>/<sub>16</sub> sec. cor. bet. sees  
 25<sup>th</sup> & 30 Thence <sup>to</sup> 89° 57' Hon

true line To same

1997 Deposited charred stake 12 ins

in the ground for <sup>1</sup>/<sub>16</sub> sec  
 cor. dug pits 18 x 18 x 12 ins  
 E. end N. of stake 5 1/2 ft diam

raised mound of earth  
 1 1/2 ft. high 3 1/2 ft base

over it and in E pit drove

stake 2 ft long 2 ins square

12 ins in the ground marked

<sup>1</sup>/<sub>16</sub> S on N. face

Subdivisions of T. 2 North R. 33 East  
Willamette Meridian, Oregon.

(8093-10 M.)

3450 Canon Red Spring branch course N.

3994 Deposited charred stake 12 ins in the ground for  $\frac{1}{16}$  sec. cor. dug pits 18x18x12 ins E Red N of stake 5 1/2 ft. dist. raised mound of earth 1 1/2 ft high 3 1/2 ft. base over it. Red in E pit drove stake 2 ft long 2 ins square 12 ins in the ground marked  $\frac{1}{16}$  S. on N. face

5300 Wagon road course N. W. Red S. E.

5991 Deposited charred stake 12 ins in the ground for  $\frac{1}{16}$  sec. cor. dug pits 18x18x12 ins E Red N of stake 5 1/2 ft. dist. raised mound of earth 1 1/2 ft. high 3 1/2 ft. base over it. Red in E pit drove stake 2 ft long 2 ins square 12 ins in the ground marked  $\frac{1}{16}$  S. on N. face

6200 Gulch course N -100

7100 Top of ridge 2 course N +250

7988  $\frac{1}{16}$  sec cor bet sees 25 and 26  
Land hilly and rolling  
Soil 1st rate



Sub. Subdivision of T. 2 North R. 33 East  
Willamette Meridian, Oregon.

(M 01-008)

East on ran<sup>down</sup> through S<sup>h</sup> of sec 24  
Va 19 1/2° East

Commencing at 1/4 sec cor. 20 chains  
N of S. N. cor of sec 24 and  
Set temporary 1/4 sec cor at  
20.40 and 60 chains and at

7985 Intersect E bdy Township 10 N  
N. of 1/4 sec corner sec 24 and 19  
Thence N 89° 56' N. on true line Va same

300 Fence and enter field N. and S.

1996 Deposited charred stake 12 ins in  
the ground for 1/4 sec cor. dug  
pits 18 x 18 x 12 ins E. and N. of  
stake 5 1/2 ft. diam and raised  
mound of earth 1 1/2 ft. high  
8 1/2 ft base over it and in  
E pit drove stake 2 ft. long.  
2 ins square, 12 ins in the  
ground marked 1/4 S on  
N face

3850 Fence and leave field

Sub-Subdivision of T. 2 North R. 33 East  
 Willamette Meridian, Oregon.

(8093-10 M.)

- 3992 Deposited charred stake 12 ins  
 in the ground for  $\frac{1}{16}$  sec. cor.  
 dug pits 18 x 18 x 12 ins E and  
 W of stake 5  $\frac{1}{2}$  ft. dist  
 raised mound of earth  
 1  $\frac{1}{2}$  ft high 3  $\frac{1}{2}$  ft. base  
 over it and in E. pin drove  
 stake 12 ins in the ground  
 2 ft long 2 ins square marked  
 $\frac{1}{16}$  S on N face
- 5988 Deposited charred stake 12 ins  
 in the ground for  $\frac{1}{16}$  sec. cor.  
 dug pits 18 x 18 x 12 ins E and  
 W of stake 5  $\frac{1}{2}$  ft. dist raised mound  
 of earth 1  $\frac{1}{2}$  ft high 3  $\frac{1}{2}$  ft base over  
 it and in E. pin drove stake 2 ft  
 long 2 ins square, 12 ins, in the ground  
 marked  $\frac{1}{16}$  S on N face
- 7985  $\frac{1}{16}$  sec cor bet. secs. 23 and 24  
 Land gently rolling  
 Soil good

Sub-Subdivision of T. 2 North R. 33 East  
Willamette Meridian, Oregon.

(16 01-0705)

East on ran<sup>down</sup> through center of  
sec 24

On 19° East

Commencing at 1/4 sec. cor. bet sec.  
23 and 24 set temporary ~~side~~ ~~corners~~  
at 20, 40 and 60 chains and at

7990 Intersect E. bdy. Township at  
1/4 sec. cor. bet sec. 24 and 19

Thence West on true line to same

1998 Deposited charred stake 12 ins in the  
ground for 1/4 sec. cor. dug pits  
18 x 18 x 12 ins E. and N. of stake 5 1/2 ft.  
diam. raised mound of earth 1 1/2 ft.  
high 3 1/2 ft base over it and in  
East pit drove stake 2 ft  
long. 2 ins square 12 ins in  
the ground marked  
1/4 on N. face.

3995 Deposited charred stake 12 ins  
in the ground for 1/4 sec.  
cor. dug pits 18 x 18 x 12 ins

Sub-Subdivision of T. 2 North R. 39 East  
 Willamette Meridian, Oregon.

(8093-10 M.)

East side West of stake 5 1/2 ft  
 dist. raised mound of  
 earth 1 1/2 ft high 3 1/2 ft.  
 base over it and in E.  
 pin drove stake 2 ft. long  
 2 ins square 12 ins in the  
 ground marked N.D. on  
 N. face.

5993 Deposited charred stake 12 ins  
 in the ground for 1/16 sec  
 cor. dug pits 18 x 18 x 12 ins  
 E. side W. of stake 5 1/2 ft. dist.  
 raised mound of earth 1 1/2 ft.  
 high 3 1/2 ft. base over it  
 and in E. pin drove stake  
 2 ins square 2 ft long 12 ins  
 in the ground marked  
 N.D. on N. face.

7990 1/16 sec cor bet. 225 and 24  
 sand level Soil 1st rate  
 Grass poor

Sub-Subdivision of T. 2 North R. 33 East  
Willamette Meridian, Oregon.

Cast on random through N<sup>1</sup>/<sub>2</sub> of  
sec 24

Pa 20<sup>o</sup> East

Commencing at <sup>1</sup>/<sub>4</sub> sec cor  
20 chains N of <sup>1</sup>/<sub>4</sub> sec cor. between  
23<sup>rd</sup> and 24. Set temporary  
corns at 20:40<sup>th</sup> and 60 chains<sup>rd</sup> at  
8000 Intersect & bdy sec. at <sup>1</sup>/<sub>4</sub> sec  
cor. Thence West on true line

Pa 21<sup>o</sup> East

1200 Gulch corner N.

2000 Deposited charred stake 12 ins  
in the ground from <sup>1</sup>/<sub>4</sub> sec. cor  
dug pits 18 x 18 x 12 ins E. and N.  
of stake 5 1/2 ft dia raised mound  
of earth 1 1/2 ft high. 3 1/2 ft base.  
over it and in E. pit drove stake  
2 ft long 2 ins square 12 ins in  
the ground marked <sup>1</sup>/<sub>4</sub> Sec on  
N. face.

4000 Deposited charred stake 12 ins

Sub-Subdivisions of T. 2 North R. 33 East

Willamette Meridian, Oregon.

(8093-10 M.)

in the ground for 1/6 sec cor  
dug pits 18x18x12 ins Q. Red H.  
of stake 5 1/2 ft. dist raised  
mound of earth 1 1/2 ft high  
3 1/2 ft base over it Red in E side  
dug stake 2 ft long 2 ins  
square 12 ins in the ground  
marked 1/6 Sec N. face

6000 Deposited charred stake 12 ins  
in the ground for 1/6 sec cor  
dug pits 18x18x12 ins Q. Red H.  
of stake 5 1/2 ft. dist Red raised  
mound of earth 1 1/2 ft high  
3 1/2 ft. base over it Red in  
East side dug stake 2 ft long  
2 ins square 12 ins in the  
ground marked 1/6 Sec N. face

8000 1/6 sec. cor. bet sec 23 and 24  
Land mostly level  
Soil part water

Sub-Subdivisions of T. 2 North R. 33 East 21  
Willamette Meridian, Oregon.

on raised rim  
East through  $\frac{1}{2}$  of sec 13  
Ba  $20\frac{3}{4}^{\circ}$  E.

Beginning at  $\frac{1}{4}$  sec cor bet. sees 13 and 14  
20 chains N of S. W. cor to sec 13  
Set temporary ~~lines~~ corrs, at  
20.40 and 60 chains and at

7992 Intersect E bdy of sec 10 N. W.  
of  $\frac{1}{4}$  sec. cor. ~~...~~  
Thence N  $89^{\circ} 55'$  W  
on true line Ba  $20\frac{3}{4}^{\circ}$  East

1998 Deposited charred stake 12 ins.  
in the ground for  $\frac{1}{4}$  sec. cor.  
dug pits 18 x 18 x 12 ins E and W of  
stake 5 ft. dist. raised mound  
of earth  $1\frac{1}{2}$  ft. high  $3\frac{1}{2}$  ft base  
over it. and in E pit drove stake  
2 ft long 2 ins square 12 ins  
in the ground marked  
 $\frac{1}{4}$  S. on N. face

2175 Wagon road course N. and S.  
3085 Enter Indian field N. and S.

Sub-Subdivision of T. 2 North R. 33 East  
Willamette Meridian, Oregon.

(8093-10 M.)

- 3750 Branch 2 lbs course N.
- 3996 Deposited charred stake 12 ins. in the ground for  $\frac{1}{6}$  sec. cor. dug pits 18 x 18 x 12 ins & Red W. of stake 5  $\frac{1}{2}$  ft. dist. raised mound of earth 1  $\frac{1}{2}$  ft high 3  $\frac{1}{2}$  ft base over it and in & pit drove stake 2 ft long, 2 ins square 12 ins in the ground marked  $\frac{1}{6}$  S. on N. face
- 5100 Leave Indians field N. and S.
- 5994 Deposited charred stake 12 ins. in the ground for  $\frac{1}{6}$  sec. cor. dug pits 18 x 18 x 12 ins & Red W. of stake 5  $\frac{1}{2}$  ft dist raised mound of earth 1  $\frac{1}{2}$  ft high 3  $\frac{1}{2}$  ft base over it and in & pit drove stake 2 ft long 2 ins square 12 ins in the ground marked  $\frac{1}{6}$  S. on N. face
- 6500 Wagon road course N.
- 7992  $\frac{1}{6}$  sec cor bet secs 13 and 14  
Land mostly level Soil. good partly cultivated



Sub-Subdivision of T. 2 North R. 33 East  
Willamette Meridian, Oregon.

Castrow <sup>ran down</sup> through center of  
sec 13

Pa 20 1/2° E

commencing at 1/4 sec. cor. bet sec  
13 and 14 Set temporary  
corn at 20.40 and 60 chains and at

7988 Intersect E. bdy. of sec. 12 N. of  
of 1/4 sec. cor. Hence N. 89° 55' W.  
on true line Pa same

1997 Deposited charred stake, 12 ins in  
the ground for 1/4 sec. cor, dug pits  
18x18x12 ins E and W. of stake 5 1/2 ft  
dist. raised mound of earth 1 1/2 ft.  
high 3 1/2 ft. base over it and  
in E. dir drove stake 2 ft. long,  
2 ins square 12 ins in the ground  
marked 1/4 S. on N. face

3994 Deposited charred stake 12 ins in  
the ground for 1/4 sec cor, dug  
pits 18x18x12 ins E and W. stake  
5 1/2 ft. dist. raised mound of

Sub-Subdivision of T. 2 North R. 33 East  
Willamette Meridian, Oregon.

(8093-10 M.)

Earth 1 1/2 ft high 3 1/2 ft base  
over it Aid in Campir drove stake  
2 ft long 2 ins square 12 ins  
in the ground marked  
1/4 S on N. face.

4175 Wagon road N. H.

4700 Creek course N.

5991 Deposited charred stake 12 ins  
in the ground for 1/16 sec. cor.  
dug pits 18 x 14 x 12 ins E Aid N  
of stake 5 1/2 ft. dia. raised  
mound of earth 1 1/2 ft. high  
3 1/2 ft. base over it Aid in  
Campir drove stake 2 ft. long  
2 ins square 12 ins in the  
ground marked 1/16 S on  
N. face

7988 1/4 sec. cor. bet sees 13 and 14

Land level or nearly so  
Soil 1st rate

Oct. 20th 1887

Sub-Subdivisions of T. 2 North R. 33 East  
Willamette Meridian, Oregon.

East on <sup>and down</sup> through N<sup>1/2</sup> of sec 13  
T<sup>2</sup> R<sup>33</sup> E<sup>3</sup>

Commencing at the sec. cor. bet sec  
13 and 14 20 chains N of 1/4 sec. cor.  
Set temporary <sup>1/4 sec. cor.</sup>  
at 20, 40 and 60 chains and at

7975 Intersect E. bdy. sec. at the or bet  
secs 13 and 18 Thine Weston  
town line Kasam

820 Wagon road N. and S.

1800 Wagon road N. and S.

1994 Deposited charred stake 12 ins  
in the ground for 1/4 sec. cor.  
dug pits 18 x 18 x 12 ins E. and N.  
of stake 5 1/2 ft dia rained mound  
of earth 1 1/2 ft high 3 1/2 ft base  
over it and in E pit drove stake  
2 ft long 2 ins square 12 ins  
in the ground marked 1/4 S.  
on N. face

3988 Deposited charred stake 12 ins

Sub-Subdivision of T. 2 North R. 33 East  
Willamette Meridian, Oregon.

(8093-10 M.)

in the ground for  $\frac{1}{16}$  sec. cor.  
dug pits 18 x 18 x 12 ins E and W.  
of stake 5  $\frac{1}{2}$  ft. dist raised

mound of earth  $\frac{1}{2}$  ft. high 3  $\frac{1}{2}$  ft  
base over it and in E pit drove  
stake 2 ft long 2 ins square  
12 ins in the ground marked  
 $\frac{1}{4}$  S. on N. face

4925 Wagon road N. and S.

5982 Draw course North and S - 20

Set charred stake 12 ins in  
the ground for  $\frac{1}{16}$  sec. cor.  
dug pits 18 x 18 x 12 ins E and W.  
of stake 5  $\frac{1}{2}$  ft. dist raised  
mound of earth  $\frac{1}{2}$  ft. high  
3  $\frac{1}{2}$  ft. base over it and in E pit  
drove stake 2 ft long 2 ins square  
12 ins in the ground marked  $\frac{1}{4}$  S on N face

7975  $\frac{1}{16}$  sec. cor. bet secs 13 and 14.

land rolling Soil in rate

Sub-Divisions of T. 2 North R. 33 East  
Willamette Meridian, Oregon.

Oak on ran<sup>down</sup> through S 1/2 of sec 12.  
Pa 20° East.

Commencing at 1/6 sec. cor. bet.  
secs 11 and 12 20 chains S. of 1/4 sec. cor.  
Set temporary 1/6 sec. cor. at  
20.40 and 60 chains and at  
7980 Intersect E. bdy. sec. 8 the N  
of cor. Thence N 89° 57' 1/2 horizontal line  
Pa same

1995 Set post 9 ft long 3 ins square  
24 ins in the ground marked  
1/6 S. on N. face for 1/6 sec. cor.  
dug pits 18 x 18 x 12 ins E and W  
of post 5 1/2 ft. dist raised  
mound of earth 1 1/2 ft. high  
3 1/2 ft. base around post ground pit

3990 Set post 9 ft. long 3 ins  
square 24 ins in the ground  
for 1/6 sec. cor. marked  
1/6 S on N. face, dug pits  
18 x 18 x 12 ins E and W. of

18 28

Sub-Subdivision of T. 2 North R. 33 East  
Willamette Meridian, Oregon.

(8093-10 M.)

Post 5 1/2 ft. dia raised  
 mound of earth 1 1/2 ft  
 high 3 1/2 ft base  
 over it, around post

5360 Outer field and pasture N. and S.

5800 Wagon road course N. E.

5985 Set post 3 ft long 3 ins  
 square 24 ins in the ground  
 for 1/16 sec. cor. dug pits  
 marked 1/16 S over N. face  
 18 x 18 x 12 ins E. and S.  
 of post 5 1/2 ft dia and  
 raised mound of earth  
 1 1/2 ft high 3 1/2 ft base  
 around post, around post

7980 to beginning cor.  
 Land rolling Soil good  
 Grass fair  
 The remainder of sec 12  
 is unfit for agricultural  
 purposes

Oct 20 - 1887

Sub-Subdivision of T. 2 North R. 33 East  
Willamette Meridian, Oregon.

(S. 01-1908)

East on ran<sup>down</sup> through  $\frac{1}{4}$  of sec. 7  
Va 20° East

Set temporary ~~marker~~ cor at  
20, 40 and 60 chains and at  
8000 Intersect E. by sec. 12 N. S. of  
 $\frac{1}{16}$  sec. cor. Thence S 95° 55' W  
on true line Va same

2000 Descend gradually  
Deposited charred stake 12 ins  
in the ground for  $\frac{1}{16}$  sec. cor.  
dug pits 18 x 18 x 12 ins. E. end of  
stake 5 ft. dist raised, mound  
of earth 1 1/2 ft. high 3 1/2 ft base  
over it and in E. pit drove  
stake 2 ft. long 2 ins square  
12 ins 12 ins in the ground  
marked  $\frac{1}{16}$  Sec. N. S. E. corner

4000 Deposited charred stake 12 ins  
in the ground for  $\frac{1}{16}$  sec. cor  
dug pits 18 x 18 x 12 ins. E. end of  
of stake 3 1/2 ft dist raised.

Sub-Subdivision of T. 2 North R. 33 East  
Willamette Meridian, Oregon.

(8093-10 M.)

mound of earth 1 1/2 ft high  
3 1/2 ft base over it <sup>Q. d. in</sup>  
East pivot drove stake 2 ft long  
2 ins square 12 ins in the  
ground marked 1/6 Ton  
N. face.

6000 Deposited charred stake 12 ins  
in the ground for <sup>1/6</sup> sec. cor.  
dig pits 18x18x12 ins <sup>Q. d. in</sup>  
of stake 5 1/2 ft. dist. raised  
mound of earth 1 1/2 ft high  
3 1/2 ft base over it <sup>Q. d. in</sup>  
East pivot drove stake 2 ft  
long 2 ins square 12 ins in  
the ground marked 1/6 Ton  
N. face.

7000 1/6 sec cor. place of beginning  
land slightly rolling Soil good  
Grass fair



Sub Divisions of T. 2 North R. 33 East

Willamette Meridian, Oregon.

East on ran<sup>down</sup> through center of sec 7  
Va 20° East

Commencing at 1/4 sec cor bet sec 1 and 2  
Set temporary ~~in sec 1~~ <sup>in sec 1</sup> cor.  
at 20 40 and 60 chains and at

8000 Intersect E bdy of sec 15 Sks S of  
1/4 sec cor bet sec 1 and 6 Thence

S 89° 54' W on true line Va same

2000 Deposited charred stake 12 ins in  
the ground for 1/4 sec cor. dig pits  
18x18x12 ins E and W of stake 5 1/2 ft. dist  
raised mound of earth 1 1/2 ft. high  
3 1/2 ft. base over it and in E pit drove  
stake 2 ft. long, 2 ins square 12  
ins in the ground marked  
1/6 S on N. face.

4000 Deposited charred stake 12 ins  
in the ground for 1/4 sec cor.  
dig pits 18x18x12 ins E and W  
of stake 5 1/2 ft. dist raised  
mound of earth 1 1/2 ft. high

Sub-Subdivision of T. 2 North R. 33 East  
Willamette Meridian, Oregon.

(8093-10 M.)

3 1/2 ft. base over in <sup>Quad</sup> Q  
spir drove stake 2 ft long  
2 ins square 12 ins in  
the ground marked  
1/4 S. on N. face

6000 Spir post 3 ft long 3 ins.  
square <sup>12</sup> 24 ins in the ground  
for 1/6 sec. cor. marked 1/46  
S. on N. face dug pits  
18 x 18 x 12 ins. Q. mid N. of stake  
5 1/2 ft. dist raised mound  
of earth 1 1/2 ft. high 3 1/2 ft.  
base <sup>around post</sup> ~~around post~~ Quad Q  
spir drove stake 2 ft long  
2 ins square 12 ins in the  
ground marked 1/4 S. on  
N. face

7600 Wagon road Quad Canon - 100  
8000 cor of beginning  
Land rolling Soil 1<sup>st</sup> rate  
Some Alkali

Sub-Subdivision of T. 2 North R. 33 East  
Willamette Meridian, Oregon.

Eastward <sup>down</sup> through N<sup>h</sup> of sec 1  
Va 20 1/2 East

Commencing at 1/4 sec. cor. 20 chains  
N of 1/4 sec cor bet sees 1 and 2

Set temporary ~~lines~~ cons.  
at 20.40 and 60 chains and at

1000 Intersect E. bdy. of sec. 12 N. S. D.  
of 1/4 sec cor bet sees 1 and 6  
Thence S 89° 55' Non true line  
Va same

2000 Deposited charred stake 12 ins  
in the ground for 1/4 sec. cor.  
dug pits 18x18x12 ins E and N.  
of stake 5 1/2 ft dis. raised  
mound of earth 1 1/4 ft high  
3 1/2 ft base over it and in  
E pin drove stake 2 ft long  
2 ins square 12 ins in  
the ground marked  
1/4 S. on N. face.

4000 Deposited charred stake 12 ins

Sub-Subdivision of T. 2 North R. 33 East  
Willamette Meridian, Oregon.

(8093-10 M.)

in the ground for  $\frac{1}{6}$  sec.  
cor. dug pits 18 x 18 x 12 ins  
E. end H. of stake 5  $\frac{1}{2}$  ft  
dist raised mound  
of earth 1  $\frac{1}{2}$  ft high 3  $\frac{1}{2}$  ft  
base over it and in East  
pit drove stake 2 ft long  
2 ins square 12 ins in  
the ground marked  
 $\frac{1}{6}$  S. or N. face.

6000 Deposited charred stake 12 ins in the  
ground for  $\frac{1}{6}$  sec. cor. dug pits  
18 x 18 x 12 ins E. end H. of stake 5  $\frac{1}{2}$  ft  
dist. raised mound of earth 1  $\frac{1}{2}$  ft  
high 3  $\frac{1}{2}$  ft base over it and in E.  
pit drove stake 2 ft long 2 ins square  
12 ins in the ground marked  $\frac{1}{6}$   
S. or N. face.

7000 Wagon road N. W.

-200

7000  $\frac{1}{6}$  Sec at place  
Cor of beginning

Land rolling Oct. 21st 1887.

Subdivision of T. 2 North R. 33 East

Willamette Meridian, Oregon.

Eastward <sup>down</sup> through T<sup>h</sup> of sec 35  
On 20<sup>th</sup> East

Commencing at  $\frac{1}{4}$  sec. cor. 20 chains  
N of S. W. cor of sec 35

Set temporary  $\frac{1}{4}$  sec. cor.  
at 20.48 and 60 chains and at

1000 Intersect E. bdy of sec 15 N<sup>th</sup> of  
 $\frac{1}{4}$  sec cor bet sec 35 and 36

Thence S 89° 54' West on true line  
On 21<sup>st</sup> East

Descend hill

2000 Deposited charred stake 12 ins in  
the ground for  $\frac{1}{4}$  sec. cor, dug pit  
18 x 18 x 12 ins E. and N. of stake 5 $\frac{1}{2}$  ft.  
dirt raised, mound of earth 1 $\frac{1}{2}$  ft  
high 3 $\frac{1}{2}$  ft base over it and in  
E pit drove stake 2 ft. long,  
2 ins square 12 ins in the  
ground marked  $\frac{1}{4}$  S on N. face

2900 Dry ditch course N<sup>th</sup> — 100

4000 Deposited charred stake 12 ins

Sub-Subdivisions of T. 2 North R. 33 East  
Willamette Meridian, Oregon.

(8093-10 M.)

in the ground for  $\frac{1}{16}$  sec. cor.  
dug pits  $18 \times 18 \times 12$  ins  
E and W. of stake  $5\frac{1}{2}$  ft.  
diam raised mound of  
earth  $1\frac{1}{2}$  ft high  $3\frac{1}{2}$  ft  
base over it  $\frac{1}{16}$  in E pit  
drove stake 2 ft long 2 ins  
square 12 ins in the ground  
marked  $\frac{1}{16}$  D. on N. face

6000 Repeated charred stake 12 ins in  
the ground for  $\frac{1}{16}$  sec. cor. dug pits  
 $18 \times 18 \times 12$  ins E and W. of stake  $5\frac{1}{2}$  ft.  
diam. raised mound of earth  
 $1\frac{1}{2}$  ft. high  $3\frac{1}{2}$  ft. base over  
it  $\frac{1}{16}$  in E pit. drove stake  
2 ft. long 2 ins square 12 ins in the  
ground marked  $\frac{1}{16}$  D. on N. face.

6020 Dry bed of creek course N. W.

7000  $\frac{1}{16}$  S. cor. of beginning

land rolling Soil 2<sup>nd</sup> rate

Sub-Subdivision of T. 2 North R. 33 East  
Willamette Meridian, Oregon.

East on random through center of sec 35  
Va 20° East

Beginning at 1/4 sec. cor. between  
35 and 34. Set temporary  
cor. at 20, 40 and 60 chains and at

7990 Intersect E. bdy sec 20 hrs S of  
1/4 sec. cor. bet secs. 35 and 36.  
Thence S 79° 51' W on true line  
Va same

Descend

1997 Deposited charred stake 12 ins  
in the ground for 1/4 sec. cor  
dug pits 18 x 18 x 12 ins E and W.  
of stake 5/8 ft. dia. raised mound  
of earth 1 1/2 ft high 3 1/2 ft base  
over it and in E pit drove  
stake 2 ft. long 2 ins square  
12 ins in the ground marked  
1/4 S. on N. face.

3995 Deposited charred stake 12 ins  
in the ground for 1/4 sec. cor.

Sub-Subdivision of T. 2 North R. 33 East

Willamette Meridian, Oregon.

(8093-10 M.)

Dug pits 18x18x12 ins E. end W. of stake 5 1/2 ft. dia. raised mound of earth 1 1/2 ft high 3 1/2 ft base over it and in E. pit drove stake 2 ft long 2 ins square 12 ins in the ground marked 1/4 S. on N. face.

5993 Reported charred stake 12 ins. in the ground for 1/6 sec. cor. dug pits 18x18x12 ins E. end W. of stake 5 1/2 ft dia. raised mound of earth 1 1/2 ft high 3 1/2 ft base over it and in E. pit drove stake 2 ft long 2 ins square 12 ins in the ground marked 1/4 S. on N. face.

6500 Dry bed of creek course N.

7990 1/4 Sec. at place Cor. of beginning

land level mostly Soil good



Sub-Subdivision of T. 2 North R. 39 East.

Willamette Meridian, Oregon.

East on random through N. 1/2 of sec 35  
Va 28° East

Commencing at 1/4 sec cor 20 chains  
N. of 1/4 sec. cor. bet. secs. 34 and 35  
Set temporary ~~1/4 sec~~ cor. at  
20 40. and 60 chains and at

7992 Intersect E. bdy. sec. 5 N. of S. of  
1/4 sec. cor. bet. secs 35 and 36  
Thence S 89° 58' W on bearing  
Va same

1998 Deposited charred stake 12 ins in  
the ground for 1/4 sec. cor. dug pits  
18 x 18 x 12 ins E. and W. of stake  
5 1/2 ft dist. raised mound of earth  
1 1/2 ft high 3 1/2 ft base over it and  
in E. pit drove stake 2 ft long.  
2 ins square 12 ins in the ground  
marked 1/4 Sec N. face

3996 Deposited charred stake 12 ins  
in the ground for 1/4 sec cor.  
dug pits 18 x 18 x 12 ins E. and W.

Subdivisions of T. 2 North R. 33 East

Willamette Meridian, Oregon.

(8093-10 M.)

of stake 5 1/2 ft. dist raised mound of earth 1 1/2 ft high 3 1/2 ft. base over it and in Q pit drove stake 2 ft long 2 ins square 12 ins in the ground marked 1/16 S on N. face.

5994

Deposited charred stake 12 ins in the ground for 1/16 sec. cor. dug pits 15x15x12 ins Q. and N. of stake 5 1/2 ft dist raised mound of earth 1 1/2 ft high 3 1/2 ft base over it and in Q pit drove stake 2 ft long 2 ins square 12 ins in the ground marked 1/16 S on N. face.

7992

1/16 sec cor of commencing. Land level. Soil 1st rate

West boundary of  
Klamath Indian Reservation.

31

of T. R.

Willamette Meridian, Oregon.

Timber, pine of good quality.  
Septbr 8th 1887.

North.

Through open pine flat.

Chms. Var.  $20^{\circ} 20' E$

35.00. Leave level flat, begin ascent.

40.00. Set a basalt stone  $18 \times 12 \times 6$  ins.

12 ins. in the ground, <sup>from 16 1/2 mile corner</sup> marked  
 $16\frac{1}{2}$  (Miles) on the S. face, K. I. R.  
on the E. face, P. T. on the W.  
face, and raised a mound  
of stone alongside,  
from which

a yellow pine 48" ins. dia. bears

S.  $21^{\circ} N$ . 15 lks dist. marked

K. I. R. B. T. Var.  $20^{\circ} 35' E$ .

75.50. Top of spur, about 90 ft high, course  
E & W.

80.00. Set a basalt stone  $18 \times 10 \times 8$  ins.

12 ins. in the ground, <sup>from 0.7 mile corner</sup> marked

Sub-Subdivision of T. 2 North R. 33 East

Willamette Meridian, Oregon.

(8093-10 M.)

dug pits 18x18x12 ins E and N.  
of stake 5 1/2 ft dist raised  
mound of earth 1 1/2 ft high  
3 1/2 ft base over it and in  
E pit drove stake 2 ft long  
2 ins square 12 ins in the  
ground marked 1/6 S on  
N face.

5985 Deposited charred stake 12  
ins in the ground ~~marked~~  
for 1/6 sec. cor, dug pits  
18x18x12 ins E and N. of stake  
5 1/2 ft. dist raised mound  
of earth 1 1/2 ft. high 3 1/2 ft.  
base over it and in E pit  
drove stake 2 ft long 2 ins  
square 12 ins in the ground  
marked 1/6 S on N face

7980 <sup>see at blue</sup> to cor. of beginning  
fund level soil for d.

Sub-Subdivision of T. 2 North R. 33 East  
Willamette Meridian, Oregon.

East on random <sup>down</sup> through center of  
sec 26

On 20° East

Commencing at 1/4 sec. cor. ~~between~~  
~~secs 26 & 27~~ bet. Sec. 26 & 27

Set temporary ~~at~~ sec. cor. at  
28 and 60 chains and at

7980 Intersect E. bdy. 4 hrs S of 1/4 sec.  
cor. Thence S 89° 58' W on true  
line On 19° East

1995 Deposited charred stake 12 ins  
in the ground for 1/16 sec. cor.  
dug pits 18 x 18 x 12 ins E. and W.  
of stake 5 1/2 ft dist raised  
mound of earth 1 1/2 ft. high  
3 1/2 ft. base over it and in E  
pit drove stake 2 ft long, 2 ins  
square 12 ins in the ground  
marked 1/4 S on N. face

2075 Wagon road course N.

3990 Deposited charred stake 12 ins

Sub-Subdivisions of T. 2 North R. 33 East  
Willamette Meridian, Oregon.

(8093-10 M.)

in the ground for  $\frac{1}{4}$  sec. cor.  
dug pits 18x18x12 ins E. and W.  
of stake 5 1/2 ft. dist. raised  
mound of earth 1 1/2 ft. high  
3 1/2 ft. base over it and in  
E. pit drove stake 2 ft.  
long 2 ins square 12 ins  
in the ground marked  
 $\frac{1}{4}$  S. on N. face,

5525

Dry ditch N. W.

5985

Spouted charred stake 12 ins  
in the ground for  $\frac{1}{16}$  sec  
cor dug pits 18x18x12 ins  
E. and W. of stake 5 1/2 ft. dist  
raised mound of earth  
1 1/2 ft. high 3 1/2 ft. base over it  
and in E. pit drove stake 2 ft.  
long 2 ins square 12 ins in the  
ground marked  $\frac{1}{16}$  S on N face

7980

$\frac{1}{16}$  place of  
to cor of commencement  
Laid level Soil 1st rate

Sub-Subdivision of T. 2 North R. 33 East  
Willamette Meridian, Oregon.

East on ran<sup>down</sup> through N. of sec 26  
Pa 20° East

Commencing at 1/4 sec. cor. 20 chains  
N. of 1/4 sec. cor. bet sec 26 and 27  
Set temporary ~~in~~ core at  
20 40 and 60 chains and at

7992 Intersect E. bdy, sec. at 1/4 sec.  
cor bet sec 25 and 26 Hence

West on true line Pa 19° East

1998 Deposited charred stake 12  
ins in the ground for 1/4 sec.  
cor. dug pit 18x18x12 ins E and  
W of stake 5 1/2 ft. dist raised  
mound of earth 1 1/2 ft high 3 1/2 ft  
base over it and in E. pit drove  
stake 2 ft long 2 ins square 12 ins  
in the ground marked 1/4 S on  
N. face.

2800 Wagon road course S. W.

3996 Deposited charred stake 12 ins  
in the ground for 1/4 sec cor

Sub-Subdivisions of T. 2 North R. 33 East  
Willamette Meridian, Oregon.

(8093-10 M.)

Dug pits 18 x 18 x 12 ins E and W.  
of stake 5 1/2 ft. dist raised  
mound of earth 1 1/2 ft. high,  
3 1/2 ft. base over it and in E.  
pit drove stake 2 ft. long  
2 ins square 12 ins in the  
ground, marked 1/6 S. on N. face

5994 Deposited charred stake 12 ins  
in the ground for 1/6 sec cor  
dug pits 18 x 18 x 12 ins E and  
W of stake 5 1/2 ft. dist raised  
mound of earth 1 1/2 ft. high  
3 1/2 ft. base over it and in  
E pit drove stake 2 ft. long  
2 ins square 12 ins in the ground  
marked 1/6 S. on N. face.

7992 <sup>1/16 Sec</sup> ~~1/16 Sec~~  
to <sup>beginning</sup> ~~beginning~~  
land level Soil good  
not cultivated

Oct 2 1897



Sub-Subdivisions of T. 2 North R. 33 East  
Willamette Meridian, Oregon.

East on random through S. 1/2 sec 23  
Va. 20° East

Commencing at 1/4 sec. cor.  
20 chain S. of S. 1/2 cor of sec 23  
Set temporary brass cor.  
at 20, 40 and 60 chains and at

7990 Intersect E. bdy of sec. 7 S. 1/2 N.  
of 1/4 sec corner sec 23 and 24  
Thence N 89° 57' from true line  
Va 19 1/2° East

1997 Deposited charred stake 12 ins  
in the ground for 1/4 sec. cor.  
dug pits 18x18x12 ins E. and N.  
of stake 5 1/2 ft dist raised mound  
of earth 1 1/2 ft high 3 1/2 ft. base  
over it and in E. pit. drove stake  
2 ft. long, 2 ins. square, 12 ins in the  
ground, marked 1/4 S. on N. face.

3995 Deposited charred stake 12 ins in the  
ground for 1/4 sec. cor. dug pits  
18x18x12 ins E. and N. of stake

Sub-Subdivisions of T. 2 North R. 33 East.  
Willamette Meridian, Oregon.

(8093-10 M.)

5 1/2 ft. dia. raised mound of earth 1 1/2 ft. high 3 1/2 ft. base over it. And in E pit drove stake 2 ft. long, 2 ins square 12 ins in the ground marked 1/6 S on N. face.

5992 Deposited charred stake 12 ins in the ground, for 1/6 sec. cor. dug pits 18x18x12 ins E. and W. of stake 5 1/2 ft. dia. raised mound of earth 1 1/2 ft. high 3 1/2 ft. base over it. And in E pit drove stake 2 ft. long, 2 ins square 12 ins in the ground marked 1/6 S. on N. face

7990 To cor of beginning land level  
Tail 1st rate

Sub-division of T. 2 North R. 33 East 49  
Willamette Meridian, Oregon.

East on <sup>town</sup> ran through center of sec. 23.  
Va 21° East

Commencing at 1/4 sec. cor. bet  
secs 22 and 23. Set temporary  
cons. at 2040 and 60 chains and

8000 Intersect E. bdy. of sec. 14 bk. bk.  
of 1/4 sec. cor. Thence 189° 54' N.  
on true line Va. 19° East

2000 Deposited charred stake 12 ins  
in the ground, for 1/4 sec. cor.  
dug pits 18 x 18 x 12 ins E. and N.  
of stake 5 1/2 ft. dist raised  
mound of earth 1 1/2 ft high  
3 1/2 ft. base over it and in  
East pin wood stake 2 ft long  
2 ins square 12 ins in the  
ground, marked ~~to~~ Town N. face.

4000 Deposited charred stake 12 ins  
in the ground for 1/4 sec  
cor. dug pits 18 x 18 x 12 ins  
E. and N. of stake 5 1/2 ft dist

Sub-Divisions of T. 2 North R. 99 East

Willamette Meridian, Oregon.

(8093-10 M.)

raised mound of earth  $1\frac{1}{2}$  ft.  
high  $3\frac{1}{2}$  ft. base over it  
And in E pit drove stake 2 ft.  
long 2 ins square 12 ins  
in the ground marked  
 $\frac{1}{4}$  S. on N. face.

6000 Deposited charred stake 12 ins  
in the ground for  $\frac{1}{16}$  sec. cor.  
dug pits  $18 \times 18 \times 12$  ins E and W of  
stake  $5\frac{1}{2}$  ft. dist raised  
mound of earth  $1\frac{1}{2}$  ft high  
 $3\frac{1}{2}$  ft base over it And in  
E pit drove stake 2 ft long  
2 ins square 12 ins in the  
ground marked  $\frac{1}{16}$  S on  
N. face.

8000  $\frac{1}{4}$  sec. cor. of beginning point  
land level Soil 1st rate  
Not cultivated.

Oct. 22nd 1847

Sub-Subdivision of T. 2 North R. 93 East  
 Willamette Meridian, Oregon.

East on ran. <sup>down</sup> through N. E. of sec 23  
 Pa 20° East

Commencing at  $\frac{1}{4}$  sec. cor. 20 chains  
 North of  $\frac{1}{4}$  sec. cor. bet sec 22 and 23

Set temporary <sup>wood</sup> cons.  
 at 20, 40 and 60 chains and at

8000 Intersect E. bdy. of sec 7 N. E. of  
 $\frac{1}{4}$  sec. cor. Thence N 89° 57' W  
 on true line Pa 2 am

9000 Deposited chaired stake 12 ins.  
 in the ground for  $\frac{1}{4}$  sec. cor.  
 dug pits 18 x 18 x 12 ins. E. and N.  
 of stake 5  $\frac{1}{2}$  ft. dia. raised  
 mound of earth 1  $\frac{1}{2}$  ft. high  
 3  $\frac{1}{2}$  ft. base over it and in E.  
 pit drove stake 2 ft. long.  
 2 ins square 12 ins. in the ground  
 marked N on N. face

4000 Deposited chaired stake 12 ins.  
 in the ground for  $\frac{1}{4}$  sec. cor.  
 dug pits 18 x 18 x 12 ins. E. and N.

Sub-Subdivisions of T. 2 North R. 33 East  
 Willamette Meridian, Oregon.

(8093-10 M.)

of stake 5 1/2 ft. dist. raised mound  
 of earth 1 1/2 ft high 3 1/2 ft base  
 over it. And in E. pit drove  
 stake 2 ft long 2 ins square  
 12 ins in the ground marked  
 1/16 S. on N. face

0000

Deposited charred stake 12 ins in  
 the ground, for 1/16 sec. cor.  
 dug pits 18 x 18 x 12 ins E. and W.  
 of stake 5 1/2 ft. dist. raised mound  
 of earth 1 1/2 ft. high 3 1/2 ft. base  
 over it And in E. pit drove stake  
 2 ft long 2 ins square 12 ins  
 in the ground marked  
 1/16 S. on N. face

8000

to 1/16 sec. cor. beginning point  
 Land level Soil 1<sup>st</sup> rate  
 Not cultivated

Sub-Subdivision of T. 2 North R. 93 East  
Willamette Meridian, Oregon.

East over random through  $\frac{1}{4}$  of  
sec 14

Ba. 20° East.

Commencing at  $\frac{1}{4}$  sec. cor. 20 chains  
N. of S. W. cor. of sec 14.

Set temporary ~~marked~~ <sup>marked</sup> corners  
at 20, 40 and 60 chains and at

1992 <sup>begin here</sup> Intersect E. bdy. of sec. at cor.  
Thence West on true line

Ba 20 $\frac{1}{4}$ ° East

1998 Deposited charred stake 12 ins  
in the ground for  $\frac{1}{4}$  sec. cor.  
dug pits 18 x 18 x 12 ins E. and N.  
of stake 5 ft. dist raised  
mound of earth  $1\frac{1}{2}$  ft. high  
8 $\frac{1}{2}$  ft. base over it and in E.  
set drove stake 2 ft long 2 in  
square 12 ins in the ground  
marked  $\frac{1}{4}$  S. on N. face

2925 Wagon road course N.

3996 Deposited charred stake

Sub-Subdivisions of T. 2 North R. 33 East  
Willamette Meridian, Oregon.

(8093-10 M.)

12 ins in the ground for  $\frac{1}{4}$  sec. cor dug pits 18x18x12 ins E. & W. of stake 5  $\frac{1}{2}$  ft. dist raised mound of earth  $\frac{1}{2}$  ft high 3  $\frac{1}{2}$  ft. base over it  $\frac{1}{4}$  in E. pit drove stake 2 ft long 2 ins square 12 ins in the ground marked  $\frac{1}{4}$  Ton N. face

4250 Wagon road course N.

5994 Deposited charred stake 12 ins in the ground for  $\frac{1}{4}$  sec. cor. dug pits 18x18x12 ins E. & W. of stake 5  $\frac{1}{2}$  ft dist raised mound of earth  $\frac{1}{2}$  ft high 3  $\frac{1}{2}$  ft base over it  $\frac{1}{4}$  in E. pit drove stake 2 ft long 2 ins square 12 ins in the ground marked  $\frac{1}{4}$  Ton N. face

6960 Wagon road N. & S.

7992 To cor of commencement  
Land level Soil good



Sub-Subdivision of T. 2 North R. 33 East  
Willamette Meridian, Oregon.

(M of - 500)

East on ran<sup>down</sup> through center  
of sec 14

By 20 1/2 East

commencing at 1/4 sec. cor. bet  
secs 14 and 15, Section 14  
1/4 sec. cor. at 20.40 and 60 chains and at

7975 Intersect E. bdy of sec 7 1/2 N of  
1/4 sec. cor. Thence N 89 57' W.  
on true line Va same

1994 Deposited charred stake 12 ins  
in the ground for 1/4 sec. cor.  
dug pits 18 x 18 x 12 ins E and W.  
of stake 5 1/2 ft. dist raised  
mound of earth 1/2 ft high  
3 1/2 ft. base over it and in E  
pit drove stake 2 ft long  
2 ins square 12 ins in the  
ground marked 1/4 S on  
N. face.

3987 Deposited charred stake 12 ins  
in the ground for 1/4 sec. cor.

Sub-Subdivision of T. 2 North R. 33 East

Willamette Meridian, Oregon.

(8093-10 M.)

- dug pits 18 x 18 x 12 ins E. End N.  
 of stake 5 1/2 ft dist raised  
 mound of earth 1 1/2 ft high  
 3 1/2 ft. base over it and in  
 E. pit drove stake 2 ft. long  
 2 ins square 12 ins in the  
 ground marked 1/4 S. on N. face.
- 5980 Deposited charred stake 12 ins  
 in the ground for 1/4 sec. cor.  
 dug pits 18 x 18 x 12 ins E. End N.  
 of stake 5 1/2 ft. dist. raised  
 mound of earth 1 1/2 ft. high.  
 3 1/2 ft. base over it and in  
 E. pit drove stake 2 ft. long  
 2 ins square, 12 ins in the  
 ground marked 1/4 S. on  
 N. face.
- 7975 1/4 sec. cor. beginning point  
 land level. Soil 1st rate  
 Not cultivated

Sub-Subdivision of T. 2 North R. 33 East  
Willamette Meridian, Oregon.

East on random through A k of  
Sec 14.

Run 20° East  
Commencing at  $\frac{1}{4}$  sec. cor.  
20 chains N. of  $\frac{1}{4}$  sec. cor. bet.  
secs 14 and 15.

Set temporary  $\frac{1}{4}$  sec. cor.  
at 20 40 and 60 chains and at

7970 Intersect E. bdy. 14. A k. N. of  
 $\frac{1}{4}$  sec. cor. Thence N 89° 54' W  
on true line to same.

1130 Wagon road N. and S.

1992 Deposited charred stake 12 ins  
in the ground for  $\frac{1}{4}$  sec. cor.  
dug pits 18 x 18 x 12 ins E and W.  
of stake 5 1/2 ft. dist raised  
mound of earth 1 1/2 ft. high  
3 1/2 ft. base over it and in E pit  
drove stake 2 ft long 2 ins square 12 ins  
in the ground marked  $\frac{1}{4}$  S. on N. face

2475 Wagon road N. and S.

Sub-Subdivision of T. 20 North R. 33 East  
 Willamette Meridian, Oregon.

(8093-10 M.)

3985<sup>5</sup> Deposited charred stake 12 ins  
 in the ground for  $\frac{1}{16}$  sec. cor.  
 dug pits 18 x 18 x 12 ins East  
 of stake  $5\frac{1}{2}$  ft. dist. raised  
 mound of earth  $1\frac{1}{2}$  ft. high  
 $3\frac{1}{2}$  ft. base over it and in  
 Osprey stake 2 ft long  
 2 ins square 12 ins in  
 the ground marked  $\frac{1}{16}$  S.  
 on N. face.

5976 Deposited charred stake 12 ins  
 in the ground for  $\frac{1}{16}$  sec. cor.  
 dug pits 18 x 18 x 12 ins East  
 of stake  $5\frac{1}{2}$  ft. dist. raised mound  
 of earth  $1\frac{1}{2}$  ft. high  $3\frac{1}{2}$  ft. base  
 over it and in Osprey  
 stake 2 ft long 2 ins  
 square 12 ins in the ground  
 marked  $\frac{1}{16}$  S. on N. face

7970 To cor of beginning  
 Land level. Soil 1st rate

Sub-Subdivision of T. 2 North R. 33 East  
Willamette Meridian, Oregon.

Coat on random through S 1/2 of sec 11  
Va 20 1/2 East

Commencing at 1/6 sec. cor. 20 chains  
N. of S. W. cor of sec 11

Set temporary 1/6 sec. cor. at  
20 40 and 60 chains and at

7980 Intersect E. bdy of sec. 20 to N  
of 1/6 sec. cor. Thence  
N. 89° 51' W. on true line Va. 20° East

500 Gulch N. - 20

1995 Set post 3 ft long 3 ins square  
marked 1/6 S on W face  
24 ins in the ground for 1/6 sec  
cor. dig pits 18 x 18 x 12 ins E and W  
of stake 5 h. ft. dia. raised  
mound of earth 1 1/2 ft high  
3 1/2 ft base, around post.  
fill door stake 2 ft long  
3 ins square 12 ins in the ground  
marked 1/6 S on W face

2020 Wagon road course N. E.

2485 Rail fence and leave pasture N. and S.

Subdivisions of T. 2 North R. 39 East  
Willamette Meridian, Oregon.

(8093-10 M.)

- 3975 Out to river bottom
- 3990 Set post 9 ft long 3 ins square  
24 ins in the ground for  $\frac{1}{16}$  sec  
cor and marked  $\frac{1}{16}$  S on N. face  
dug pits 18 x 18 x 12 ins E. and W.  
of post 5 ft dia raised mound  
mound of earth 1 1/2 ft high  
3 ft base around post
- 5570 Wagon road course N
- 5985 Set post 9 ft long 3 ins square  
24 ins in the ground for  $\frac{1}{16}$  sec  
cor marked  $\frac{1}{16}$  S on N. face  
dug pits 18 x 18 x 12 ins E. and W.  
of post 5 ft dia raised mound  
of earth 1 1/2 ft high 3 ft base  
around post
- 7090 Creek 15 ft wide S. N.
- 7980 To  $\frac{1}{16}$  cor<sup>and place</sup> of beginning  
land level Soil 1<sup>st</sup> rate  
Not cultivated

Sub-Subdivision of T. 2 North R. 33 East  
 Willamette Meridian, Oregon.

East on ran<sup>down</sup> through center of  
 sec. 11

Va 20 1/2 East

Commencing at 1/4 sec cor. bet. secs  
 10 and 11. Set temporary  
 cor. at 20, 40 and 60 chains and at

7970 Intersect E. bdy. of sec. at cor.  
 Thence West on true line Va same

1992 Set post 3 ft long 3 ins square  
 24 ins in the ground for 1/4 sec  
 cor. marked 1/4 Don N. fac. from which  
 A palm 12 ins diam bears S 70° W 53 ft dist  
 marked 1/4 S. B. J.  
 no other tree in limits and raise  
 mound of stone around post

3984 Set post 3 ft long 3 ins square  
 24 ins in the ground for 1/4 sec.  
 cor. marked 1/4 Don N. fac. from which  
 A palm 12 ins diam bears S 40° W 77 ft dist  
 marked 1/4 S. B. J.

A cherry 4 ins diam bears N 45° E 18 ft dist

Subdivisions of T. 2 North R. 33 East  
Willamette Meridian, Oregon.

(8093-10 M.)

marked  $\frac{1}{4}$  S. B. T.

4750 Wagon road course N.

5150 Wagon road " N

5977 Let. Basalt stone  $9 \times 8 \times 7$  ins  
6 ins in the ground for  $\frac{1}{16}$  sec  
cor marked  $\frac{1}{16}$  on N. face  
from which  
A balu 18 ins diam bars,  $S 45^{\circ} N 95$  N, dit  
marked  $\frac{1}{16}$  S. B. T. and raised  
mound of earth and stone around  
corner

7970 To point of beginning  
land mostly in river bottom  
Soil fair.  
Timber Balu, pine & cherry  
and considerable underbrush  
The remainder of this sec is  
unfit for agricultural purposes  
Oct 22 - 1887



Sub-Divisions of T. 2 North R. 33 East  
Willamette Meridian, Oregon.

(L.S. 01-3309)

Go on <sup>random</sup> through  $\frac{1}{4}$  of sec 2.  
Va  $20^{\circ}$  East

Commencing at  $\frac{1}{4}$  sec. cor. 20 chains  
N. of S. W. cor. of sec. 2

Set temporary ~~in~~ <sup>in</sup> ~~the~~ <sup>the</sup> ~~sec.~~ <sup>sec.</sup> ~~cor.~~ <sup>cor.</sup> at  
20, 40 and 60 chains and at

7970 Intersect. E. bdy of sec., 14 lks. S.  
of  $\frac{1}{4}$  sec. cor. Thence S.  $89^{\circ} 54'$  W.  
on true line Va same

1992 Set post 3 ft long 3 ins square  
24 ins in the ground marked  
 $\frac{1}{4}$  S on N. face for  $\frac{1}{4}$  sec. cor.  
dug pits 18 x 18 x 12 ins E. and W.  
of post 5  $\frac{1}{2}$  ft. dist and raised  
mound of earth 1  $\frac{1}{2}$  ft high  
3  $\frac{1}{2}$  ft. base. around post

3985 Set post 3 ft long 3 ins square  
24 ins in the ground for  $\frac{1}{4}$  sec.  
cor. marked  $\frac{1}{4}$  S. on N. face  
dug pits 18 x 18 x 12 ins E. and  
W. of post 5  $\frac{1}{2}$  ft dist

Sub-Subdivision of T. 2 North R. 34 East  
Willamette Meridian, Oregon.

(8093-10 M.)

- 5977 raised mound of earth  
1 1/2 ft. high 3 1/2 ft. base  
around post mound post  
Set post 3 ft long 3 ins  
square 24 ins in the ground  
for 1/6 sec cor marked  
1/6 D. on N. face dug pits  
18 x 15 x 12 ins E. and W. of  
post 5 1/2 ft. diam. raised  
mound of earth 1 1/2 ft. high  
3 1/2 ft. base around post
- 60.50 Enter field, N and S.
- 7970 To point of beginning  
Land level or bottom  
Soil generally good  
partly cultivated

Sub-Subdivision of T. 2 North R. 33 East  
Willamette Meridian, Oregon.

East on random through center of  
Tree 2

Va 20° East

Commencing at 1/4 sec. cor. bet  
secs 2 and 3 T 2 N, R 33 E,  
sec. cor., at 20, 40 and 60 chains and at

1980 Intersect East bdy. 7th S.  
of 1/4 sec. cor. Thence S 89° 57' W,  
on true line Va same

1995 Set post 3 ft. long 3 ins  
square 24 ins in the ground  
for 1/4 sec. cor. marked 1/4  
S. on N. face dug pits  
18 x 18 x 12 ins E. and W. of  
post 5 1/2 ft. dist. raised  
mound of earth 1 1/2 ft.  
high. 3 1/2 ft. base around post

3990 Set post 3 ft. long 3 ins  
square 24 ins in the  
ground, marked 1/4 S  
on N. face. for 1/4 sec. cor.

Sub-Subdivision of T. 2 North R. 33 East

Willamette Meridian, Oregon.

(8093-10 M.)

- dug pits 18x18x12 ins  
 E. End of post, 5 1/2 ft.  
 dist. raised mound  
 of earth 1 1/2 ft. high 3 1/2 ft. base  
 around post.
- 4400 Gulch, S.
- 5985 Set post 3 ft. long 3 ins  
 square 2 1/4 ins in the  
 ground. for 1/4 sec. cor.  
 marked 1/4 S on N. face  
 dug pits 18x18x12 ins  
 E. End of stake 5 1/2 ft.  
 dist. raised mound  
 of earth. 1 1/2 ft. high  
 3 1/2 ft. base, around post
- 7980 To point of beginning  
 land rolling  
 Soil good  
 Not cultivated

Sub-Subdivision of T. 2 North R. 33 East  
Willamette Meridian, Oregon.

East our and <sup>down</sup> through A 1/2 of  
Sec 2

Pa 21° East

Commencing at 1/6 sec. cor.  
20 chains N. of 1/4 sec. cor. bet.  
secs. 2 and 3.

Set temporary ~~...~~ cons at  
20, 40 and 60 chains and at

7996 Intersect E. by, 10 lbs N of  
1/6 sec. cor. Thence N 89° 56' W.  
on true line Pa 20 1/2 East

1997 Set post 3 ft long 3 ins  
square 2 1/4 ins in the ground  
for 1/6 sec. cor. marked

1/6 S. on N. face, dug pits  
18 x 18 x 12 ins E. and W. of  
post 5 1/2 ft. dia raised  
mound of earth 1 1/2 ft.  
high 3 1/2 ft. base, around post

3995 Set post 3 ft long,  
3 ins square 2 1/4 ins in

Sub-Subdivision of T. 2 North R. 33 East

Willamette Meridian, Oregon.

(8093-10 M.)

the ground for  $\frac{1}{16}$  sec. cor. marked  $\frac{1}{16}$  S. on N. face dug pits 18x18x12 ins E. and W. of post  $5\frac{1}{2}$  ft. dist and raised mound of earth  $1\frac{1}{2}$  ft. high  $3\frac{1}{2}$  ft. base around post

5998

Set post 9 ft long 3 ins square 24 ins in the ground marked  $\frac{1}{16}$  S. on N. face for  $\frac{1}{16}$  sec. cor. dug pits 18x18x12 ins E. and W. of post  $5\frac{1}{2}$  ft. dist raised mound of earth  $1\frac{1}{2}$  ft. high  $3\frac{1}{2}$  ft. base around post

7200

Canon S.

-50

7990

To point of beginning land rolling Soil food

Oct. 24th 1887

Not cultivated

Sub-Subdivision of T. 2 North R. 33 East  
Willamette Meridian, Oregon.

East on random through S 1/2 of  
Sec. 34

Ca 21° East

Commencing at 1/4 sec cor 20 chains  
N of S. W. cor of sec 34.

S. W. temporary ~~1/4 sec~~ cor  
at 20 40 and 60 chains and at

800 Intersect E. bdy. 14 lbs N  
of 1/4 sec. cor. Thence N 89° 54' W.  
on true line Ca 20° East

2000 Deposited charred stake 12 ins  
in the ground for 1/4 sec. cor.  
dig pits 18 x 18 x 12 ins E and W.  
of stake 5 1/2 ft dist raised mound  
of earth 1 1/2 ft. high 8 1/2 ft base  
over it and in E pin drove stake  
2 ft long 2 ins square 12 ins in  
the ground marked 1/4 S.  
on N face

4000 Deposited charred stake 12 ins  
in the ground for 1/4 sec. cor.

Sub-Subdivision of T. 2 North R. 33 East

Willamette Meridian, Oregon.

(8093-10 M.)

dug pits 18 x 18 x 12 ins E. and W.  
 of stake 5 kft. dia. raised  
 mound of earth 1 1/2 ft. high  
 3 kft. base over it and in  
 E. <sup>pits</sup> drove stake 2 ft. long  
 2 ins square 12 ins in the  
 ground marked 1/6 S. on N. face  
 6000 Deposited charred stake 12 ins  
 in the ground for 1/6 sec. cor.  
 dug pits 18 x 18 x 12 ins E. and W.  
 of stake 5 kft. dia. raised  
 mound of earth 1 1/2 ft. high  
 3 1/2 ft. base over it and in  
 E. pit drove stake 2 ft. long  
 2 ins square 12 ins in the  
 ground marked 1/6 S. on N. face  
 8000 To point of beginning  
 Land level Soil 12 yr. old  
 Not cultivated



Sub-Subdivision of T. 2 North R. 33 East  
Willamette Meridian, Oregon.

East on random through center  
of sec 34

Pa 20° East  
commencing at 1/4 sec corner  
secs 33 and 34

Set temporary  
corners at 2040 and 60 chain and at

7980 Intersect E. bay 17 Sec N of  
1/4 sec. cor. Thence N 89° 53' W  
on true line Pa same

440 Thence and leave field N. and E.

1995 Deposited charred stake 12 ins  
in the ground for 1/16 sec. cor.  
dug pits 18 x 18 x 12 ins E. and W.  
of stake 5 1/2 ft. dist. raised mound  
of earth 1 1/2 ft. high 3 1/2 ft base  
over it and in E. side drove stake  
2 ft long 2 ins square 12 ins  
in the ground marked 1/16 Sec N. face.

3990 Deposited charred stake 12 ins  
in the ground for 1/4 sec cor.

Sub-Subdivisions of T. 2 North R. 33 East  
 Willamette Meridian, Oregon.

(8093-10 M.)

- 5985 dug pits 18x18x12 ins E and W of stake 5 1/2 ft dist raised mound of earth 1 1/2 ft. high 8 1/2 ft. base over it and in E. pit drove stake 2 ft. long 2 ins square 12 ins in the ground marked 1/4 Ton N. face
- Deposited charred stake 12 ins in the ground for <sup>160</sup> 200 cor. dug pits 18x18x12 ins E and W. of stake 5 1/2 ft. dist. raised mound of earth. 1 1/2 ft. high. 8 1/2 ft base over it and in E pit drove stake 2 ft long 2 ins. square 12 ins in the ground marked 1/4 Ton N. face
- 7980 To point of beginning Land rolling Soil 1<sup>st</sup> rate Partly cultivated

Sub-Subdivisions of T. 2 North R. 38 East  
Willamette Meridian, Oregon.

Post our ran<sup>down</sup> through  $\frac{1}{4}$  of  
Sec. 34

Var  $20^{\circ}$  East

Commencing at  $\frac{1}{16}$  sec. cor, 20 chains  
of  $\frac{1}{4}$  sec. cor. Set ten ~~more~~  
corns at 20 40 and 60 chains and at

7960 Intersect E. by 20 to N.  
of  $\frac{1}{16}$  sec. cor. Thence  
N.  $89^{\circ} 5'$  It on true line

Var. same

1990 Deposited charred stake 12 ins  
in the ground for  $\frac{1}{16}$  sec  
cor. dug pits  $18 \times 18 \times 12$  ins  
and W of stake  $5\frac{1}{2}$  ft dist  
raised mound of earth  $1\frac{1}{2}$  ft.  
high  $3\frac{1}{2}$  ft base over it  
and in E pit drove stake  
2 ft long 2 ins square 12 ins  
in the ground marked  $\frac{1}{16}$  S. on N face

3980 Deposited charred stake 12  
ins in the ground for

Sub-Sub of T. 2 North R. 33 East

Willamette Meridian, Oregon.

(8093-10 M.)

1/6 sec cor dug pits  
18 x 18 x 12 ins E. & N. of stake  
5 1/2 ft. dia raised mound  
of earth 1 1/2 ft. high 3 1/2 ft.  
base over it and in E. pit  
drove stake 2 ft. long 2 ins  
square 12 ins in the ground  
marked 1/6 S. on N. face

5970 Deposited charred stake 12 ins  
in the ground for 1/6 sec. cor.  
dug pits 18 x 18 x 12 ins E. & N.  
of stake 5 1/2 ft. dia. raised mound  
of earth 1 1/2 ft. high 3 1/2 ft. base  
over it and in E. pit drove stake  
2 ft. long 2 ins square 12 ins in the  
ground marked 1/6 S. on N. face.

6250 Dry branch of Tudi Hillons St.

7960 To point of beginning  
Land level Soil good  
Not cultivated

Sub-Subdivision of T. 2 North R. 39 East  
Willamette Meridian, Oregon.

East on ran<sup>down</sup> through  $\frac{1}{4}$  of  
sec. 27

Va 20° East

commencing at  $\frac{1}{4}$  sec. cor. 20  
chains N. of S. W. cor of sec 27  
Set temporary ~~15~~ <sup>15</sup> chains. end at  
at 20.40 <sup>and</sup> 60 chains. end at

1960

Intersect E. by. 17  $\frac{1}{2}$  N of  
 $\frac{1}{4}$  sec. cor. Thence N 89° 53' W  
on true line Va same

1990

Deposited charred stake 12 ins  
in the ground for  $\frac{1}{4}$  sec. cor.  
dug pits 18 x 18 x 12 ins E. end of  
of stake 5  $\frac{1}{2}$  ft. dist. raised  
mound of earth 1  $\frac{1}{2}$  ft. high  
3  $\frac{1}{2}$  ft. base over it end in E.  
pit drove stake 2 ft. long  
2 ins square 12 ins in the ground  
marked  $\frac{1}{4}$  S. on N. face

2500

dry ditch course N.

3980

Deposited charred stake 12 ins

Sub-Subdivision of T. 2 North R. 38 East  
Willamette Meridian, Oregon.

(8093-10 M.)

in the ground for  $\frac{1}{16}$  sec. cor.  
dug pits 18x18x12 ins E<sup>and</sup>  
W<sup>of</sup> stake 5 $\frac{1}{2}$  ft. dist. raised  
mound of earth 1 $\frac{1}{2}$  ft. high  
3 $\frac{1}{2}$  ft base over it and in  
E<sup>and</sup> W<sup>of</sup> pit drove stake 2 ft long  
2 ins square 12 ins in the  
ground marked  $\frac{1}{16}$  S. on N. face

5970

Deposited charred stake  
12 ins in the ground for  $\frac{1}{16}$   
sec. cor. dug pits 18x18x12 ins  
E<sup>and</sup> W<sup>of</sup> stake 5 $\frac{1}{2}$  ft dist  
raised mound of earth 1 $\frac{1}{2}$  ft  
high 3 $\frac{1}{2}$  ft base over it and in  
E<sup>and</sup> W<sup>of</sup> pit drove stake 2 ft long  
2 ins square 12 ins in the ground  
ground marked  $\frac{1}{16}$  S. on N. face

7960

To point of beginning  
Land level  
Soil 1<sup>st</sup> rate

Sub-Subdivision of T. 2 North R. 33 East

Willamette Meridian, Oregon.

East on ran<sup>down</sup> through center  
of sec 27

Va. 20° East

Commencing at 1/4 sec. cor. bet sec 27  
and 28. For temporary ~~1/4 sec. cor.~~  
1/4 sec. cor. at 20.40 and 60 chains and at

7970 Intersect E bdy 12 fms. N of  
1/4 sec. cor. Thence N 89° 55' W  
on true line Va. same.

1993 Deposited charred stake 12 ins in  
the ground for 1/4 sec. cor. dug  
pits 18x18x12 ins E and W. of stake  
5 1/2 ft dist raise a mound of earth  
1 1/2 ft high. 8 1/2 ft base over it. And  
in E pit drove stake 2 ft long 2 ins  
square 12 ins in the ground  
marked 1/16 S on N face

2100 Gulch & dry ditch course N. W.

3985 Deposited charred stake 12 ins  
in the ground for 1/4 sec cor dug  
pits 18x18x12 ins E and W.

Sub-Subdivision of T. 2 North R. 33 East

Willamette Meridian, Oregon.

(8093-10 M.)

- of stake 5 1/2 ft. dia. raised mound of earth 1 1/2 ft. high 3 1/2 ft. base over it. And in E. pit drove stake 2 ft. long 2 ins. square 12 ins. in the ground marked 1/4 S. on N. face.
- 5977 Deposited charred stake 12 ins. in the ground for 1/6 sec. cor. dug pits 18 x 18 x 12 ins. E. and W. of stake 5 1/2 ft. dia. raised mound of earth 1 1/2 ft. high 3 1/2 ft. base over it. And in E. pit drove stake 2 ft. long 2 ins. square. 12 ins. in the ground marked 1/6 S. on N. face.
- 7970 To point of beginning Soil 1<sup>st</sup> rate Land level



Subdivisions of T. 2 North R. 99 East  
Willamette Meridian, Oregon.

(12 of 37)

East on ran<sup>down</sup> through N<sup>W</sup> of sec 27  
Va. 20° East

Commencing at  $\frac{1}{4}$  sec. cor. 20 chains  
North of  $\frac{1}{4}$  sec. cor. bet sees  
27 and 28. Set temporary  
cors. at 20, 40 and 60. Chs. and at

7980 Intersect E bdy. at  $\frac{1}{4}$  sec cor  
thence West on true line  
Va James

1995 Deposited charred stake 12 ins  
in the ground for  $\frac{1}{4}$  sec. cor. dug  
pits 18 x 18 x 12 ins E and N. of stake  
5 1/2 ft. dist raised mound of  
earth. 1 1/2 ft. high 3 1/2 ft. base  
over it dug in E pit drove stake  
2 ft. long 2 ins square 12 ins  
in the ground marked  $\frac{1}{4}$  E on  
N. face

3990 Deposited charred stake 12 ins  
in the ground for  $\frac{1}{4}$  sec. cor.  
dug pits 18 x 18 x 12 ins E and N.

Sub-Subdivision of T. 2 North R. 33 East

Willamette Meridian, Oregon.

(8093-10 M.)

of stake 5 1/2 ft dist raised mound of earth 1 1/2 ft high 3 1/2 ft base over it. In E. side of stake 2 ft long 2 ins square 12 ins in ground marked 1/6 S. on N. face

4000

Gulch course N.

5985

Deposited charred stake 12 ins in the ground for 1/10 sec

cor dug pits 18 x 18 x 12 ins

E. side of stake 5 1/2 ft dist raised mound of earth 1 1/2 ft

high and 3 1/2 ft base over it. In E. side of stake 2 ft long

2 ins square 12 ins in the ground marked 1/6 S. on N. face

7950

To place of beginning

land level. Soil good

Not cultivated

Ad 24-188

Sub-Division of T. 2 North R. 33 East  
Willamette Meridian, Oregon.

East on ran<sup>down</sup> through S. 1/2 of sec 22  
on 20 East

Commencing at 1/4 sec. cor. 20 chains  
N of S. 1/2 cor of sec 22  
Set temporary <sup>to sec. cor.</sup>  
at 20, 40 and 60 chains and at

7992 Intersect E. bdy of sec at 1/4 sec  
cor. Thence West on true line  
on same

1998 Deposited charred <sup>stake</sup> 12 ins in the  
ground for 1/4 sec. cor. dug pits  
18 x 18 x 12 ins E. and N. of stake  
5/8 ft. dist. raised mound of earth  
1 1/2 ft. high 3 1/2 ft base over it and  
in E. pit brove stake 2 ft. long  
2 ins square 12 ins in the ground  
marked 1/4 S. on N. face.

3996 Deposited charred stake 12 ins  
in the ground for 1/4 sec. cor.  
dug pits 18 x 18 x 12 ins E. and N.  
of stake. 5/8 ft dist raised

Sub-Subdivisions of T. 2 North R. 33 East  
 Willamette Meridian, Oregon.

(8093-10 M.)

- mound of earth  $1\frac{1}{2}$  ft. high  
 $3\frac{1}{2}$  ft. base over it and in Epit  
 drove stake 2 ft. long 2 ins  
 square 12 ins in the ground  
 marked  $\frac{1}{6}$  S. on N. face.
- 5600 Dry Gulch course N.
- 5994 Deposited charred stake  
 12 ins in the ground for  
 $\frac{1}{6}$  sec. cor. dug pits  $18 \times 18 \times 12$   
 ins E. and W. of stake  $5\frac{1}{2}$  ft.  
 dist. raised mound of earth  
 $1\frac{1}{2}$  ft. high  $3\frac{1}{2}$  ft. base over  
 it and in Epit drove stake  
 2 ft. long 2 ins square  
 12 ins in the ground  
 marked  $\frac{1}{6}$  S. on N. face
- 7992 To point of beginning  
 Land level soil 1<sup>st</sup> rate  
 Not cultivated  
 Some Grass.  
 Oct. 25<sup>th</sup> 1887,

Sub-Subdivision of T. 2 North R. 33 East  
Willamette Meridian, Oregon.

Cast on ran<sup>down</sup> through center of  
sec 22

Pa. 20° East  
Commencing at 1/4 sec. cor. bet  
secs. 21 and 22

Set temporary ~~...~~ cons  
at 20.40 and 60 chains and at  
1000 Intersect E. bdy 16 lks S. of  
1/4 sec. cor. Thence S. 89° 53' W  
on true line Pa 21° E.

2000 Deposited charred stake 12 ins  
in the ground for 1/4 sec cor.  
dug pits 18 x 18 x 12 ins E. and N.  
of stake 5 1/2 ft. dirt raised  
mound of earth 1 1/2 ft. high  
3 1/2 ft base over it and in E  
pit drove stake 2 ft long.  
2 ins square 12 ins in the  
ground marked 1/4 S. on N  
face.

4000 Deposited charred stake 12 ins

Sub-Subdivision of T. 2 North R. 33 East  
Willamette Meridian, Oregon.

(8093-10 M.)

in the ground for  $\frac{1}{4}$  sec.  
cor. dug pits 18 x 18 x 12 ins  
&  $\frac{1}{4}$  and  $\frac{1}{2}$  of stake 5  $\frac{1}{2}$  ft. dist  
raised mound of earth 1  $\frac{1}{2}$  ft.  
high 3  $\frac{1}{2}$  ft. base over it  
and in  $\frac{1}{4}$  pit drove stake  
2 ft. long, 2 ins. square. 12 ins.  
in the ground marked

$\frac{1}{4}$  S. on N. face

6000

Deposited charred stake 12 ins  
in the ground for  $\frac{1}{16}$  sec. cor.  
dug pits 18 x 18 x 12 ins &  $\frac{1}{4}$  and  $\frac{1}{2}$   
of stake 5  $\frac{1}{2}$  ft. dist raised mound  
of earth 1  $\frac{1}{2}$  ft. high. 3  $\frac{1}{2}$  ft. base  
over it and in  $\frac{1}{4}$  pit drove  
stake 2 ft. long, 2 ins. square  
12 ins. in the ground marked

$\frac{1}{16}$  S. on N. face

8000

Sketch and point of beginning  
land level Soil 1<sup>st</sup> rate  
Not cultivated

Sub-Subdivision of T. 2 North R. 39 East  
Willamette Meridian, Oregon.

East on ran<sup>dom</sup> through N 1/2 of  
Sec 22

Pa 20° 10' East

Commencing at 1/6 sec. cor, 20 chains  
N. of 1/4 sec. cor. bet. secs. 21 and 22.  
Set temporary (or. cor.) at  
20.40 and 60 chains and at

2010 Intersect E. bdy 20 N. S. of  
1/6 sec. cor. Thence S 89° 51' W.  
on true line Pa 20° East

2002 Deposited charred stake 12 ins in  
the ground for 1/6 sec. cor. dug pits  
18 x 18 x 12 ins E. and N. of stake  
5 1/2 ft. dist. raised mound of  
earth 1 1/2 ft. high 8 1/2 ft base  
over it and in E. pit drove stake  
2 ft. long 2 ins square 12 ins  
in the ground marked  
1/6 S. on N. face

4005 Deposited charred stake 12 ins  
in the ground for 1/6 sec. cor.

Sub-Subdivision of T. 2 North R. 33 East  
Willamette Meridian, Oregon.

(8093-10 M.)

dug pits 18 x 18 x 12 ins E. and W.  
of stake 5 1/2 ft dist. raised  
mound of earth 1 1/2 ft high  
3 1/2 ft base over it and in  
E. pit drove stake 2 ft. long,  
2 ins square 12 ins in the  
ground marked 1/6 S. on  
N. face.

6007 Deposited charred stake 12 ins  
in the ground for 1/6 sec. cor.  
dug pits 18 x 18 x 12 ins E. and W.  
of stake 5 1/2 ft dist raised mound  
of earth 1 1/2 ft high 3 1/2 ft base  
over it and in E. pit drove stake  
2 ft long 2 ins square 12 ins  
in the ground. marked  
1/6 S. on N. face.

8010 To point of beginning  
land level Soil 1st rate  
Not cultivated



Sub-Subdivision of T. 2 North R. 93 East  
 Willamette Meridian, Oregon.

East on ran<sup>down</sup> through  $\frac{1}{4}$  of  
 sec. 15

Pa  $20\frac{1}{2}^{\circ}$  East.

Commencing at  $\frac{1}{4}$  sec. cor. 20 chains  
 N. of S. W. cor of sec 15  
 Set temporary  $\frac{1}{4}$  sec. cor. at  
 20, 40 and 60 chains and at

1000 Intersect body 7 N. S. of  $\frac{1}{4}$  sec cor  
 Thence S  $89^{\circ} 57'$  It on true line

Pa  $20^{\circ}$  East

2000 Deposited charred stake 12 ins in  
 the ground for  $\frac{1}{4}$  sec. cor. dug  
 pits 18 x 18 x 12 ins Q and N. of  
 stake  $5\frac{1}{2}$  ft. dist raised mound  
 of earth  $1\frac{1}{2}$  ft. high.  $3\frac{1}{2}$  ft. base  
 over it, and in Q pit drove  
 stake 2 ft. long 2 ins square  
 12 ins in the ground marked  
 $\frac{1}{4}$  S. on N. face.

4000 Deposited charred stake 12 ins  
 in the ground for  $\frac{1}{4}$  sec. cor.

Sub-Subdivision of T. 2 North R. 33 East  
Willamette Meridian, Oregon.

(8093-10 M.)

dug pits 18 x 18 x 12 ins Q and N.  
 of stone 5 1/2 ft dia raised  
 mound of earth 1 1/2 ft <sup>high 3 1/4</sup> base  
 over it Q and in E pit drove  
 stake 2 ft long 2 ins square  
 12 ins in the ground  
 marked 1/16 S on N. face  
 6000 Deposited charred stake 12 ins  
 in the ground for 1/16 sec. cor.  
 dug pits 18 x 18 x 12 ins Q and N.  
 of stake 5 1/2 ft dia raised  
 mound of earth 1 1/2 ft high  
 3 1/2 ft base over it Q and in  
 E pit drove stake 2 ft long  
 2 ins square 12 ins in the  
 ground marked 1/16 S on N. face.  
 2000 To point of beginning  
 Q and level Soil 1st rate  
 Not cultivated

Subdivision of T. 2 North R. 33 East

Willamette Meridian, Oregon.

East on ran<sup>down</sup> through center of sec 15.

Pa 20 1/2 East

Commencing at 1/4 sec. cor. bet sec 15 and 16 Set temporary ~~and~~ ~~at~~ cor. at 20.40 and 60 chains and at

5000 Intersect E. bdy. 12 lks. S of 1/4 sec cor. Thence S 89° 55' W on true line

Pa same

2000 Deposited charred stake 12 ins in the ground for 1/4 sec. cor. dug pits 18 x 18 x 12 ins E and W of stake 5 1/2 ft. dist. raised mound of earth 1 1/2 ft. high 3 1/2 ft. base over it and in E. spr drove stake 2 ft. long 2 ins square 12 ins in the ground marked 1/4 S. on N. face.

4000 Deposited charred stake 12 ins in the ground for 1/4 sec. cor. dug pits 18 x 18 x 12 ins E and W.

Sub-Subdivision of T. 2 North R. 39 East  
Willamette Meridian, Oregon.

(8093-10 M.)

of stake  $5\frac{1}{2}$  ft. dia. raised  
mound of earth  $1\frac{1}{2}$  ft. high  
 $3\frac{1}{2}$  ft. base over it and in  
E. pit drove stake 2 ft. long,  
2 ins square 12 ins in the  
ground marked  $\frac{1}{4}$  S on N.  
face.

6000 Deposited charred stake 12 ins  
in the ground for  $\frac{1}{6}$  sec. cor.  
dug pits  $18 \times 18 \times 12$  ins E. and W.  
of stake  $5\frac{1}{2}$  ft. dia. raised  
mound of earth  $1\frac{1}{2}$  ft. high  
 $3\frac{1}{2}$  ft. base over it and in E.  
pit drove stake 2 ft. long,  
2 ins square ~~12 ins in the~~  
12 ins in the ground marked  
 $\frac{1}{6}$  S on N. face

2000 To point of beginning,  
Land level  
Soil food

Sub Division of T. 2 North R. 33 East  
Willamette Meridian, Oregon.

East on ran<sup>down</sup> through N 1/2 of  
sec 15

Pa. 28° East.

Commencing at 1/6 sec. cor. 20 chains  
S. of 1/4 Sec. cor. bet. sec. 15 and 16  
For temporary ~~mark~~ cor.  
at 20.40 and 60 chains and at

7990 Intersect E. by. 15 N. S. of 1/6  
sec. cor. Thence S. 89° 54' W.  
on true line. Pa. same

1998 Deposited charred stake 12 ins  
in the ground for 1/6 sec. cor.  
dug pits 18 x 18 x 12 ins E. and W.  
of stake 5 1/2 ft. dist raised mound  
of earth 1 1/2 ft high 3 1/2 ft base  
over in and in E pit drove stake  
2 ft. long 2 ins square 12 ins  
in the ground marked 1/6 S.  
on N. face.

3995 Deposited charred stake 12 ins  
in the ground for 1/6 sec. cor.

Sub-Subdivisions of T. 2 North R. 33 East

Willamette Meridian, Oregon.

(8093-10 M.)

dug pits  $18 \times 18 \times 12$  ins E. and W. of stake  $5\frac{1}{2}$  ft. dist raised mound of earth  $1\frac{1}{2}$  ft. high  $3\frac{1}{2}$  ft. base over it and in E. pit drove stake 2 ft long 2 ins square. 12 ins in the ground marked  $\frac{1}{16}$  S. on N. face.

5992 Deposited charred stake 12 ins in the ground for  $\frac{1}{16}$  sec cor. dug pits  $18 \times 18 \times 12$  ins E. and W. of stake  $5\frac{1}{2}$  ft. dist raised mound of earth  $1\frac{1}{2}$  ft. high,  $3\frac{1}{2}$  ft. base over it and in E. pit drove stake 2 ft long 2 ins square. 12 ins in the ground marked  $\frac{1}{16}$  S. on N. face.

7990 To point of beginning land level soil rate not cultivated

Sub-Subdivision of T. 2 North R. 33 East  
Willamette Meridian, Oregon.

(M 01-100)

East on random through S. 1/2 of sec.  
10 Va 20 1/2 East

Commencing at 1/4 sec. cor. 20  
chains N of S. 1/2 cor. of sec. 10

Set temporary ~~to~~ cor. at  
20 40 and 60 chains and at

7980 Intersect Eddy 16 lbs N of 1/4  
sec. cor. Thence N 89° 53' E  
on true line Va. same

1400 Branch 20 lbs wide course N. W.

1995 Deposited charred stake 12 ins in  
the ground for 1/4 sec. cor. dug  
pits 18 x 18 x 12 ins E. and S. of stake  
5 1/2 ft. dist raised mound of  
earth 1 1/2 ft. high 3 1/2 ft. base over  
it and in E. pit drove stake 2 ft.  
long 2 ins square 12 ins in the ground  
marked 1/4 S. on N. face x

2650 touch grave yard x

3990 Deposited charred stake 12 ins in  
the ground for 1/4 sec. cor.

Sub-Subdivisions of T. 2 North R. 33 East  
Willamette Meridian, Oregon.

(8093-10 M.)

dug pits 18 x 18 x 12 ins E and W.  
of stake 5 1/2 ft. dist raised mound  
of earth 1 1/2 ft. high 3 1/2 ft. base  
over it and in E pit drove  
stake 2 ft long 2 ins square  
12 ins in the ground  
marked 1/6 S on N. face

5985 Deposited charred stake 12 ins  
in the ground for 1/6 sec  
Cor. dug pits 18 x 18 x 12 ins E and  
W. of stake 5 1/2 ft. dist

raised mound of earth 1 1/2 ft.  
high 3 1/2 ft. base over it and in  
E pit drove stake 2 ft long  
2 ins square 12 ins in the  
ground marked 1/6 S on N. face,

7980. To point of beginning  
Land level  
Soil 1<sup>st</sup> rate



Sub-Subdivision of T. 2 North R. 39 East

Willamette Meridian, Oregon.

(22 of 200)

East on ran<sup>down</sup> through center of sec 10  
Pa 21° East

Commencing at 1/4 sec. cor. bet. secs.  
9 and 10 Set temporary ~~1/4 sec. cor.~~  
at 20, 40 and 60 chains and at

7984 Intersect E. bdy. 7 lks N. of 1/4 sec.  
cor. Thence N 89° 57' W on true line

Pa 20 1/2° East

1150 Indian House N of line

1450 Cuts Dry. & fence in brush,

1996 Set post 3 ft. long, 3 ins. square,  
12 ins in the ground marked 1/16 S,  
on N face for 1/16 sec. cor. dug pits  
18 x 18 x 12 ins E. end of post 5 1/2 ft.  
diam raised mound of earth 1 1/2 ft.  
high 3 ft base around post

3250 Fence N. and S.

3992 Set post 3 ft. long, 3 ins. square,  
24 ins in the ground for 1/4  
sec. cor. marked 1/4 S. on N. face,  
dug pits 18 x 18 x 12 ins E. end of

Sub Divisions of T. 2 North R. 38 East  
Willamette Meridian, Oregon.

(8093-10 M.)

of stake 5 1/2 ft. dist. And raised mound of earth 1 1/2 ft. high 3 1/2 ft. base around post

4800 Fence course N. E.

5200 Fence course N. W.

5988 Set basalt stone 14 x 12 x 10 ins 10 ins in the ground for 1/6 sec cor <sup>marked 1/16 on N. face</sup> dig post 18 x 18 x 12 ins E. and W. of stone 5 1/2 ft. dist raised mound of stone and earth 1 1/2 ft. high 3 1/2 ft. base <sup>along side</sup> ~~over it~~ and marked same <sup>on N. face</sup>

7225 Wagon road course N. & S.

7250 Fence course N. & S.

7984 To point of beginning Land mostly river bottom Soil 2nd rate Some brush  
Oct. 20th 1887

Sub-Subdivisions of T. 2 North R. 33 East

Willamette Meridian, Oregon.

(K 01-000)

East on random through N. 1/2 of sec. 10.

On 20 1/2 East

Commencing at 1/4 sec cor 20 chains N. of 1/4 sec. cor. <sup>Set pins 9x10</sup> Set ten ~~pins~~ pins. cor. at 20, 40 and 60 chains. And at

7992 Intersect E. bdy. at 1/4 sec. cor. Thence West on true line. Va. same

1998 Set point 8 ft. long 3 ins. square 2 1/2 ins. in the ground for 1/4 sec. cor. marked 1/4 S. on N. face

from which

A birch 13 ins. diam. bears N. 45° E. 40 ft. dist marked 1/4 S. B. T.

A balin 18 ins diam bears S 70° W 68 ft dist marked 1/4 S. B. T.

2400 Leave brush

3996 Set basalt stone 9x8x7 ins 6 ins in the ground for 1/4 sec. cor. marked

1/4 on N. face and rained

Sub-Subdivision of T. 2 North R. 33 East

Willamette Meridian, Oregon.

(8093-10 M.)

- 4070 mound of stone 1 1/2 ft high  
3/4 ft base over it  
Fits in fracture  
Fence N. and S.
- 5994 Ser basalt stone 12x8x5  
ins 8 ins in the ground  
for 1/6 sec. cor. marked  
1/6 on N. face and raised  
mound of stone 1 1/2 ft.  
high 3/4 ft base over it.
- 6565 Wagon road N. and S. and  
Indian house bears N 20° E 300 ft
- 6790 Fence N. and S.
- 7992 To point of beginning,  
land mostly river bottom  
considerable brush and  
some timber Balm &c.  
Soil 1st rate

Oct 25-1887

Sub-Subdivisions of T. 2 North R. 38 East  
Willamette Meridian, Oregon.

East on ran<sup>down</sup> through S. H. of sec 3.  
Va. 20° East

Commencing at  $\frac{1}{4}$  sec. cor, 20 chains  
N of S. H. cor of sec 3.

Set temporary ~~in sec. cor.~~ cons.  
at 20, 40 and 60 chains and at

7990 Intersect E. bdy. at  $\frac{1}{4}$  sec. cor.  
Thence West on true line  
Va. same

1600 Fence course N. and S.

1998 Deposited charred stake 12 ins  
in the ground for  $\frac{1}{4}$  sec. cor.  
dug pits 18 x 18 x 12 ins E. and N.  
of stake  $\frac{5}{8}$  ft. dist, raised  
mound of earth  $1\frac{1}{2}$  ft. high,  
 $3\frac{1}{2}$  ft. base over it and in C.  
pit drove stake 2 ft. long 2 ins  
square 12 ins in the ground  
marked  $\frac{1}{4}$  S. on N. face

3995 Set post 3 ft. long, 3 ins square  
24 ins in the ground for  $\frac{1}{4}$  sec.

90

100

Sub-Subdivision of T. 2 North R. 33 East

Willamette Meridian, Oregon.

(8093-10 M.)

see: cor. marked  $\frac{1}{16}$  D on N. face. And raised mound of stone  $1\frac{1}{2}$  ft. high  $3\frac{1}{2}$  ft base around post

5650 Fence And Enter field N. and S.

5994 Set post 3 ft. long, 3 ins square 24 ins in the ground for.  $\frac{1}{16}$  see. cor. marked  $\frac{1}{16}$  D. on N. face. dig pits.  $18 \times 18 \times 12$  ins E. and N. of post.  $5\frac{1}{2}$  ft. dist. And raised mound of earth  $1\frac{1}{2}$  ft. high  $3\frac{1}{2}$  ft base around post

7990 To point of beginning Land rolling Soil bad rate little grass

Sub Divisions of T. 2 North R. 33 East  
Willamette Meridian, Oregon.

(11 01-500)

East on random through center of  
sec 3.

Pa 21° East.

Commencing at 1/4 sec cor bet  
secs 3<sup>rd</sup> & 4<sup>th</sup> E. temporary ~~line~~  
cons at 20.40 and 60 chains and at

7980 Intersect E bdy. at 1/4 sec. cor.  
Thence West on true line.

Pa 20° East

1995 Deposited charred stake 12 ins  
in the ground for 1/6 sec. cor.  
dug pits 18 x 18 x 12 ins E. and W.  
of stake 5 1/2 ft. dist. raised mound  
of earth 1 1/2 ft. high 3 1/2 ft base  
over it and in E pit drove stake  
2 ft. long 2 ins square 12 ins in  
the ground marked 1/6 Sec N face

3990 Deposited charred stake 12 ins in  
the ground for 1/4 sec. cor. dug  
pits 18 x 18 x 12 ins E. and W. of stake  
5 1/2 ft. dist raised mound of

Sub-Subdivision of T. 2 North R. 33 East

Willamette Meridian, Oregon.

(8093-10 M.)

- earth  $1\frac{1}{2}$  ft high  $3\frac{1}{2}$  ft.  
base over it and in Q. pit  
drove stake 2 ft long 2 ins  
square 12 ins in the ground  
marked  $\frac{1}{4}$  S. on N. face
- 4400 Gulch course S.
- 5985 Opposite charred stake 12 ins  
in the ground for  $\frac{1}{4}$  sec. cor.  
dug pits  $8 \times 18 \times 12$  ins Q. and N.  
of ~~stake~~ <sup>stake</sup> 5 ft dist raised  
mound of earth  $1\frac{1}{2}$  ft.  
high  $3\frac{1}{2}$  ft base over  
it and in Q. pit drove stake  
2 ft long 2 ins square 12 ins  
in the ground marked  
 $\frac{1}{4}$  S. on N. face.
- 7980 To point of beginning  
Lands Rolling  
Dial 1<sup>st</sup> rate



Sub-Division of T. 2 North R. 33 East  
Willamette Meridian, Oregon.

(.11 01-1000)

East on random through N. 1/2 of sec. 3.  
Pa. 21° East

Commencing at 1/4 sec. cor. 20 chains  
N. of 1/4 sec. cor. bet sec 3 and 4  
Set temporary ~~5~~ <sup>60</sup> chains and at  
20.40 and 60 chains and at

7990 Intersect Q. bdy. 10 lks. N. of  
1/4 sec. cor. Thence

N. 89° 56' W. on true line Pa. same

1998 Set post 3 ft long 3 ins square  
24 ins in the ground for 1/4 sec  
cor dug pits 18 x 18 x 12 ins Q. and N.  
of stake 5 1/2 ft. dist raised mound  
of earth 1 1/2 ft high 3 1/2 ft base  
around post ~~as and post~~ ~~Q. post crossed stake~~  
~~lines in the ground 2 ft long~~  
~~3 ins square, see sketch~~  
~~1/4 sec. cor. Pa.~~

3995 Set post 3 ft long 3 ins square  
24 ins. in the ground for 1/4  
sec. cor. marked 1/4 Ton

Sub-Subdivision of T. 2 North R. 33 East  
Willamette Meridian, Oregon.

(8093-10 M.)

N. face, dug pits 18x18x12  
ins Quad W. of post 5 1/2  
ft dist. and raised mound  
of earth 1 1/2 ft high 3 1/2 ft  
base around post

5992 Set post 3 ft long,  
3 ins square 2 1/2 ins in  
the ground for 1/6 sec.  
cor. marked 1/6 S. on  
N. face, dug pits 18x18x12  
ins Quad W. of post  
5 1/2 ft dist raised mound  
of earth 1 1/2 ft high 3 1/2 ft  
base around post

6500 Canon course S. - 250

7990 To point of beginning  
and rolling,  
Soil grad rate,

Sub-Subdivision of T. 2 North R. 33 East  
Willamette Meridian, Oregon.

East on random through  
S 1/2 of sec. 33

Pa 20 East

Commencing at 1/4 sec. cor. 20.  
chains N. of S. H. cor. of sec.  
33. Set temporary  
cors. at 20. 40 and 60 chains and at

8000

Intersect Q bdy 10 H. N.  
of 1/4 sec cor. Thence  
N. 89° 56' W. on true line

Pa 21 East

2000

Deposited charred stake 12 ins.  
in the ground for 1/4 sec. cor.  
dug pits 18 x 18 x 12 ins Q and H.  
of stake 5 1/2 ft. dist and raised  
mound of earth 1 1/2 ft. high  
3 1/2 ft. base over it, and

in Q pit drove stake 2 ft.  
long 2 ins square 12 ins in the  
ground marked 1/4 S. on N. face

4000

Deposited charred stake 12 ins

Sub-Subdivision of T. 2 North R. 33 East

Willamette Meridian, Oregon.

(8093-10 M.)

in the ground for  $\frac{1}{4}$  sec  
con. dug pits 18x18x12 ins  
E. and W. of stake  $5\frac{1}{2}$  ft. dist.  
raised mound of earth  
 $1\frac{1}{2}$  ft. high  $3\frac{1}{2}$  ft. base over  
it. Put in E. pit drove stake  
2 ft. long 2 ins square 12 ins  
in the ground marked  $\frac{1}{6}$  S  
on N. face

4950 Wagon road course N.

6000 Deposited charred stake 12 ins in the  
ground for  $\frac{1}{4}$  sec. con. dug pits 18x18x12  
ins E. and W. of stake  $5\frac{1}{2}$  ft. dist. raised  
mound of earth  $1\frac{1}{2}$  ft. high  $3\frac{1}{2}$  ft  
base over it. Put in E. pit drove stake  
2 ft. long 2 ins square 12 ins in the  
ground marked  $\frac{1}{6}$  S on N. face.

6600 Little Tindie Killons <sup>creek</sup> to the N. W.

7100 Same

8000 To point of beginning  
Land level Soil 1st rate

Sub-Subdivision of T. 2 North R. 33 East  
 Willamette Meridian, Oregon.

Wagon ran <sup>down</sup> through center  
 of sec 33

Pa.  $20\frac{1}{2}^{\circ}$  East

Commencing at  $\frac{1}{4}$  sec cor. bet. secs  
 32 and 33. Set temporary  
 cor. at 20.40 and 60 chains and at

7995 Intersect E. bdy sec 10 kts  
 of  $\frac{1}{4}$  sec cor. June 1890 56' N  
 on true line Pa.  $20^{\circ}$  East

1998 Deposited charred stake 12 ins in  
 the ground for  $\frac{1}{4}$  sec cor. dug pits  
 18 x 18 x 12 ins E. and N. of stake  $5\frac{1}{2}$  ft  
 dist raised mound of earth  
 1 $\frac{1}{2}$  ft high  $3\frac{1}{2}$  ft <sup>base</sup> over it and  
 in E pit drove stake 2 ft long  
 2 ins square 12 ins in the  
 ground marked  $\frac{1}{4}$  Sec N. face

2575 Wagon road course N. E.

3997 Set post 2 ft long 3 ins square  
 24 ins in the ground for  
 $\frac{1}{4}$  sec cor. marked  $\frac{1}{4}$  Sec N. face

Sub-Subdivision of T. 2 North R. 33 East

Willamette Meridian, Oregon.

(8093-10 M.)

dug pits 18x18x12 ins Q. and H. of stake 5 1/2 ft dist. raised mound of earth 1 1/2 ft high 3 1/2 ft base around post.

5600 Gulch St.

5996 Deposited charred stake 12 ins in the ground for 1/4 sec. cor. dug pits 18x18x12 ins Q. and H. of stake 5 1/2 ft; dist raised mound of earth 1 1/2 ft high 3 1/2 ft base over it and in Q. pin drove stake 2 ft long. 2 ins square 12 ins in the ground marked 1/4 S. on N. face.

7995 To point of beginning Land level.

Soil 1st rate, Not cultivated

Some grass. Oct. 27. 1887

Sub-Subdivision of T. 2 North R. 33 East.  
Willamette Meridian, Oregon.

East on random through N. 1/2 of  
sec 33

Ba 21° East

Commencing at 1/4 sec. cor. 20  
chains N. of 1/4 sec. cor. between  
32<sup>nd</sup> and 33<sup>rd</sup> Set temporary ~~line~~ cor.  
at 20.40<sup>th</sup> and 60 chains and at

2000 Intersect E. bdy. 14<sup>th</sup> Sec N. of  
1/4 sec. cor. Thence N 89° 54' W  
on true line Ba 20° East

2000 Deposited charred stake 12 ins  
in the ground for 1/4 sec. cor.  
dug pits 18 x 18 x 12 ins E. and W.  
of stake 5 1/2 ft diam raised mound  
of earth 1 1/2 ft high 8 1/2 ft base  
over it and in E pit drove stake  
2 ft long 2 ins square 12 ins  
in the ground marked

1/4 S. on N. face

4000 Deposited charred stake 12 ins  
in the ground for 1/4 sec. cor.

Sub-Subdivision of T. 2 North R. 33 East

Willamette Meridian, Oregon.

(8093-10 M.)

dug pits 18 x 18 x 12 ins <sup>E. and W.</sup>  
 of stake 5 1/2 ft. dist raised  
 mound of earth 1 1/2 ft high  
 3 1/2 ft base over it <sup>E. and W.</sup>  
 in <sup>E. and W.</sup> pindrove stake 2 ft.  
 long 2 ins square 12 ins  
 in the ground marked  
 1/6 S. on N. face

6.000 Deposited charred stake 12 ins  
 in the ground for 1/6 sec cor.  
 dug pits 18 x 18 x 12 ins <sup>E. and W.</sup>  
 of stake 5 1/2 ft. dist raised  
 mound of earth 1 1/2 ft high  
 3 1/2 ft base over it <sup>E. and W.</sup> in <sup>E. and W.</sup>  
 pindrove stake 2 ft long.  
 2 ins square 12 ins in the  
 ground marked 1/6 S. on N. face

8.000 To point of beginning  
 Land mostly level  
 Soil pt rate



Sub Divisions of T. 2 North R. 38 East  
Willamette Meridian, Oregon.

East on ran<sup>dow</sup> through S  $\frac{1}{2}$  of sec 28  
Pa 21° East.

Commencing at  $\frac{1}{4}$  sec. cor. 20 chains  
N. of S.  $\frac{1}{2}$  of <sup>corner</sup> sec. 28

Set temporary horse cor. at  
20.40 and 00 chains and at

8000 Intersect E. bay. 10 lks N. of  
 $\frac{1}{4}$  sec. cor. Thence N 89° 56' W  
on true line Pa 20° East

275 Fence course N. and S.

2000 Deposited charred stake 12 ins  
in the ground for  $\frac{1}{4}$  sec. cor.  
dug pits 18x18x12 ins E. and W.  
of stake 5  $\frac{1}{2}$  ft <sup>dirt</sup> raised mound  
of earth 1  $\frac{1}{2}$  ft high 3  $\frac{1}{2}$  ft base  
over it and in E pit drove  
stake 2 ft long 2 ins square  
12 ins in the ground marked

$\frac{1}{4}$  S. on N. face.

2080 In die Willows creek Dry course N. W.

2775 Fence and leave field N. E. & S. W.

Sub Divisions of T. 2 North R. 33 East

Willamette Meridian, Oregon.

(8093-10 M.)

4000

Deposited charred stake 12 ins in the ground for  $\frac{1}{16}$  sec. cor. dug pits 18x18x12 ins E. and W. of stake  $5\frac{1}{2}$  ft dist raised mound of earth  $1\frac{1}{2}$  ft high  $3\frac{1}{2}$  ft base over it and in E pit drove stake 2 ft long 2 ins square 12 ins in the ground marked  $\frac{1}{16}$  S. on N. face.

5000

True course N. E. and S. W.

6000

Deposited charred stake 12 ins in the ground for  $\frac{1}{16}$  sec cor. dug pits 18x18x12 ins E. and W. of stake  $5\frac{1}{2}$  ft dist raised mound of earth  $1\frac{1}{2}$  ft high  $3\frac{1}{2}$  ft base over it and in E pit drove stake 2 ft long, 2 ins square, 12 ins in the ground marked  $\frac{1}{16}$  S. on N. face

7200

Wagon road. N. and S.

8000

To point of beginning Land rolling soil 1<sup>st</sup> rate
















Sub Divisions of T. 2 North R. 99 East

Willamette Meridian, Oregon.

(8093-10 M.)

- of stake 5 1/2 ft dist raised mound of earth 1 1/2 ft high 3/4 ft base over it and in E pin drove stake 2 ft long 2 ins square 12 ins in the ground marked 1/4 S. on N. face
- 4275 Lane and Wagon road N. and S.
- 5992 Deposited charred stake 12 ins in the ground for 1/6 sec. cor. dug pits 18 x 18 x 12 ins and N. of stake 5 1/2 ft dist raised mound of earth 1 1/2 ft high 3/4 ft base over it and in E pin drove stake 2 ft long 2 ins square 12 ins in the ground marked 1/6 S. on N. face
- 7200 True course N.
- 7990 To point of beginning land mostly level Soil 1st rate

Sub-Subdivision of T. 2 North R. 38 East  
Willamette Meridian, Oregon.

East on ran<sup>down</sup> through N 1/2  
of sec 28

Pa. 20° East

Commencing at 1/4 sec. cor. 20 chains  
N of 1/4 sec cor bet sec 28 and 29  
Set temporary 1/4 sec. cor. at  
20 40 and 60 chains and at

7995

Intersect E. bdy 17 1/2 N of  
1/4 sec. cor. Azim S. 89° 53' W.  
on true line Pa same

1228

Wagon road N. and S.

1650

Truce and center field N. and S.

1999

Deposited charred stake 12 ins in  
the ground for 1/4 sec. cor.  
dug pits 18 x 18 x 12 ins E. and W.  
of stake 5 1/2 ft dist raised  
mound of earth 1 1/2 ft high  
3 1/2 ft. base over it and in E.  
pit drove stake 2 ft long 2 ins  
square 12 ins in in the ground  
marked 1/4 S. on North face

Sub-Subdivision of T. 2 North R. 88 East

Willamette Meridian, Oregon.

(8093-10 M.)

2175

Low course N. C.

3997

Deposited charred stake 12 ins  
in the ground for  $\frac{1}{4}$  sec cor  
dug pits 18 x 18 x 12 ins E and  
W of stake  $5\frac{1}{2}$  ft dist raised  
mound of earth  $1\frac{1}{2}$  ft  
high  $3\frac{1}{2}$  ft base over it  
and in C. spr. drove  
stake 2 ft long 2 ins  
square 12 ins in the ground  
marked  $\frac{1}{4}$  S on N. face

5998

Deposited charred stake  
12 ins in the ground for  
 $\frac{1}{4}$  sec. cor. dug pits 18 x 18 x 12  
ins E and W of stake  $5\frac{1}{2}$  ft  
dist. raised mound of earth  
 $1\frac{1}{2}$  ft high  $3\frac{1}{2}$  ft base over  
it and in C. spr. drove  
stake 2 ft long 2 ins  
square 12 ins in the  
ground marked  $\frac{1}{4}$  S on

Sub Divisions of T. 2 North R. 33 East  
Willamette Meridian, Oregon.

117

At face

6425 Cross creek dry, and repeatedly  
crossed until ab.

6900 leave creek

7995 Cor. point of beginning  
land gently rolling  
Soil good

Partly Cultivated  
very little grass.

Oct. 28th 1887,

### FINAL OATHS FOR SURVEYS.

A list of the names of the individuals employed by Gas P. Curran  
and Gas. Holand, U. S. Deputy Surveyor, to assist in  
 running, measuring and marking the lines and corners described in the foregoing field  
 notes of the survey of the Sub-Subdivisional  
 lines of Township 2 North  
Range 33 East Willamette Meridian, Oregon,  
 showing the respective capacities in which they acted:

- L. D. Hooley -----, **Compassman.**
- E. G. Perry -----, **Chainman.**
- Guy Davis -----, **Chainman.**
- J. R. Madley -----, **Chainman.**
- C. L. Raper -----, **Chainman.**
- E. Moses -----, **Axeman.**
- J. W. Herndon -----, **Axeman.**
- , **Flagman.**

### FINAL OATHS OF ASSISTANTS.

We hereby certify that we assisted Gas P. Curran and  
Gas. Holand, U. S. Deputy Surveyor, in surveying all  
 those parts or portions of the Sub-Subdivisional lines  
of Township 2 North  
Range 33 E. Willamette Meridian, Oregon,  
 as are represented in the foregoing field notes as having been surveyed by him and under  
 his direction; and that said survey has been in all respects, to the best of our knowledge  
 and belief, well and faithfully surveyed, and the corner monuments established, according  
 to the instructions furnished by the U. S. Surveyor General of Oregon.

- L. D. Hooley -----, **Compassman.**
- E. G. Perry -----, **Chainman.**
- Guy Davis -----, **Chainman.**
- J. R. Madley -----, **Chainman.**
- C. L. Raper -----, **Chainman.**
- E. Moses -----, **Axeman.**
- J. W. Herndon -----, **Axeman.**
- , **Flagman.**

Subscribed and sworn to before me, this 28th day of  
October 1887

[SEAL.] James E. Holand  
U. S. Deputy Surveyor



FINAL OATH OF DEPUTY SURVEYOR.

*Me Jas T. Curran & Jas Notand*

United States Deputy Surveyor, do solemnly swear that in pursuance of

instructions received from *Congress W Taylor*

U. S. Surveyor General for Oregon, bearing date of the *28th*

day of *August* 188*7*, I have well, faith-

fully and truly, in ~~my~~ own proper person, and in strict conformity with the instructions furnished by the U. S. Surveyor General for Oregon, the Surveying Manual, and the laws of the United States, surveying all those

parts or portions of *Township 2 North*

*Range 33 East*

Willamette Meridian, in the State of Oregon, as are represented in the foregoing field notes as having been surveyed by me and under my directions; and I do further solemnly swear that all the corners of said survey have been established and perpetuated in strict accordance with the Surveying Manual, printed instructions, the special written instructions of the U. S. Surveyor General for Oregon, and in the specific manner described in the field notes, and that the foregoing are the true field notes of such survey, and should any fraud be detected I will suffer the penalty of perjury under the provisions of an Act of Congress approved August 8, 1846.

*James P. Curran*  
*James E. Notand* U. S. Deputy Surveyor.

Subscribed and sworn to before me, this *15th*

day of *February* 188*8*

*A. Woodcock*  
*Notary Public*  
*for Oregon*

Office U. S. Surveyor General,

Portland, Oregon, *August 8* 188*8*

*beginning*  
The following Field Notes of the Survey of the

*Sub-Subdivisional Lines*  
of Township 2 North Range  
33 East Willamette Mer. Co.

executed by *James P. Currier and James E.*  
*Special* *Voland U S Dept Surveyors*  
under ~~his~~ Contract No. \_\_\_\_\_, dated *May*

*4th.* 188*7*, having been critically examined, the  
necessary corrections and explanations made, the said Field Notes  
and the survey they describe, are hereby approved.

*Douglas W. Taylor*  
Surveyor General.