

FIELD NOTES

Of the survey of the Subdivisional Allotment,

Lines of T. 2. N. R. 33 E

of the Willamette Meridian,

Oregon, as surveyed by James Pleurissie

U. S. Deputy Surveyor, under his Contract No. 537

dated March 5th 1889

Survey commenced, July 1st 1889

Survey completed, July 2nd 1889

NAMES AND DUTIES OF ASSISTANTS,

J. R. Laramore, ^{Chainman} Compassman.

J. L. Brown, Chainman.

....., Chainman.

....., Chainman.

....., Chainman.

L. M. Stone, Axeman.

R. E. Long, Axeman.

....., Flagman.

188
220

PRELIMINARY OATHS OF ASSISTANTS.

We, J. R. Saramore and
J. L. Brown

do solemnly swear that we will faithfully execute the duties of Chain Carriers, that we will level the chain over even and uneven ground, and plumb the tally pins, either by sticking or dropping the same; that we will report the true distance to all notable objects, and the true length of all lines that we will assist in measuring, to the best of our skill and ability, and in accordance with the instructions given us in

the survey of the subdivisional and
Allotment lines of T. 2 N. R.
33 E Willamette Meridian, Oregon.

J. R. Saramore, Chainman.
J. L. Brown, Chainman.
_____, Chainman.
_____, Chainman.

Subscribed and sworn to before me, this 1st
day of July 1889
[SEAL.] Thos Fitz Gerald
Notary Public

We, C. M. Stone and
R. E. Long

do solemnly swear that we will well and truly perform the duties of Axemen in the establishment of corners and other duties, according to instructions given us, and to the best of our skill and ability, in the survey of the

subdivisional &
Allotment Willamette Meridian, Oregon.


C M Stone, Axeman.
R E Long, Axeman.

Subscribed and sworn to before me, this 1st
day of July 1889
[SEAL.] Thos Fitz Gerald
Notary Public

INDEX

Referring the Lines to the Pages of the Field Notes.

T. 2 North R. 33 East Will. Mer.

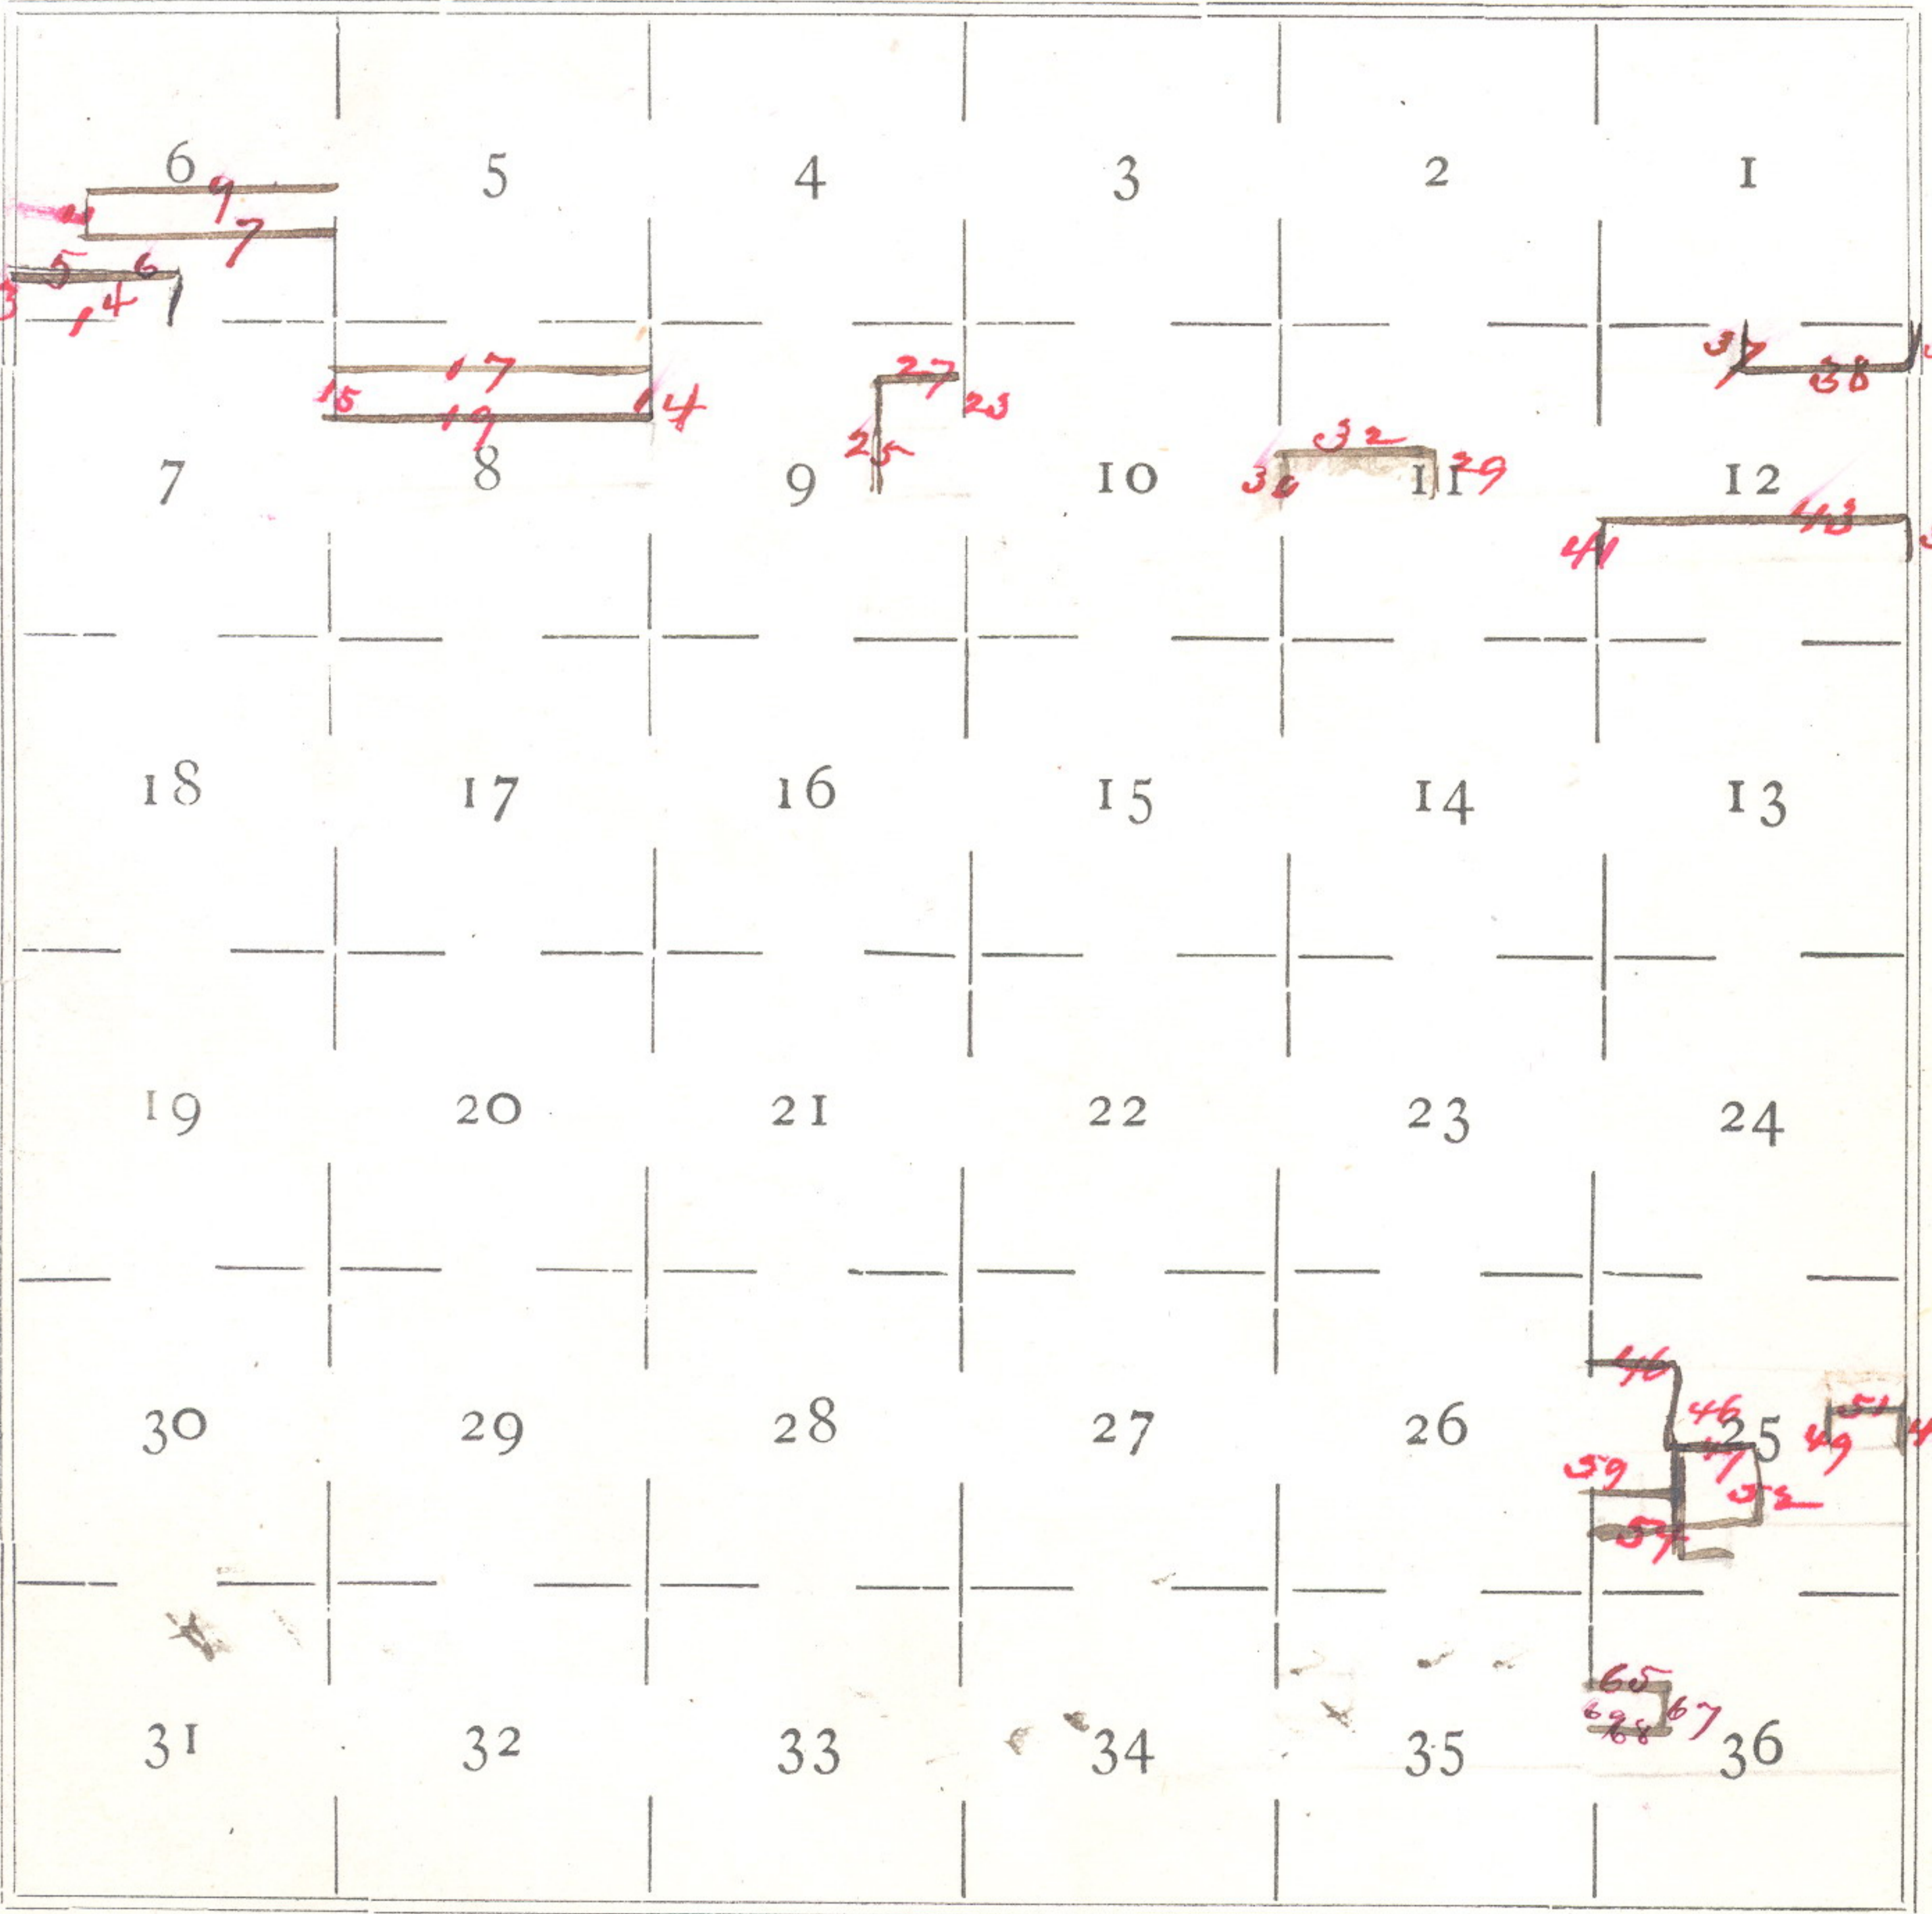

Meanders of _____ Pages _____ to _____

Meanders of _____ Pages _____ to _____

Attachment

1
221A

Subdivision of T. 2 North R. 33 E.
Willamette Meridian, Oregon.

See 6.

From the closing corner
to Ties 6 + 7. on West
Edy. of Sp.
which is a post 4 ins
square marked
C.C. T. 2 N N 33 E. on E.
T. 6 on N. + T 7 on S.
faces with 5 notches
on S. and 1 notch on
N. edges and mound
of stone around it.

Then I run

Out on true line
between Ties 6 + 7.

Var. 20° E

1650 Set post 3 ft long 3 ins
square with marked stone
12 ins in the ground

Allotment

Subdivision of T. 2 West R. 33 E.
Willamette Meridian, Oregon.

See C.

(8093-10 M.)

for $\frac{1}{32}$ Sec corner marked
 $\frac{1}{32}$ S. on N face, dug pits
18 x 18 x 12 ins E. & W of
post. $5\frac{1}{2}$ ft dirt and
raised a mound of
earth $1\frac{1}{2}$ ft high $3\frac{1}{2}$ ft
long over it.

36.50 Intersect the $\frac{1}{4}$ Sec corner
between Sec 6 & 7. which
is a balun 4 ins diam
marked $\frac{1}{4}$ S on N face
from which
A balun 4 ins diam bears
N. 40° E. 40 lbs dirt
marked $\frac{1}{4}$ S. B. I.
A balun 8 ins diam bears
S 10° W. 58 lbs dirt
marked $\frac{1}{4}$ S. B. I.

Allotment

33
223

Subdivision of T. 2 North R. 33 E.

Willamette Meridian, Oregon.

Tree 6.

Land brushy
Soil 1st rate &
Gravelly

From the closing corner to
Tree 6 + 7 on West side
of Township.

I run

North between Tree 1 + 6
on a true line

Var 19° 30' E.

1000

Set barath stand 9 + 8 + 7 ins
6 ins in the ground for $\frac{1}{32}$
Set corner marked $\frac{1}{32}$ on
W. face; dug pits 18 + 18
+ 12 ins N. + S of stand 5 $\frac{1}{2}$
ft dirt and raised a
mound of earth 1 $\frac{1}{2}$ ft. high
3 $\frac{1}{2}$ ft base over it

4

Allotment

Subdiv of T. 2 North R. 33 East

Willamette Meridian, Oregon.

Sec 6.

(8093-10 M.)

From $\frac{1}{16}$ Sec corner 20 chs
W of $\frac{1}{4}$ Sec corner between
Secs. 6 & 7.

I run

North on true line in Sec 6.

Var $19^{\circ}30' E$

1000

Set stone $10 \times 8 \times 6$ ins
6 ins in the ground for $\frac{1}{32}$
Sec corner marked $\frac{1}{32}$ on
W face and raised a
curved of stone over it
It's impracticable

Land gravelly

225

Subdivisions of T. 2 North R. 33 E.

Willamette Meridian, Oregon.

Sec 6.

From $\frac{1}{32}$ Sec corner 20 chs N.
and 10 chs N. of $\frac{1}{4}$ Sec corner
between Secs. 6 & 7.

From
West on random line
in Sec 6.

Var 20° E.

16.50

Intersect the West side of
the 3 lks. South of $\frac{1}{32}$ Sec
corner

thence I run

S. $89^{\circ} 54'$ E. on true line
in Sec 6.

9.00

Leave Grandfield
cross fence

16.50

The $\frac{1}{32}$ Sec corner

Land gravelly
Soil 100 rods

60
Allotment

Subdivision of T. 2 North R. 33 E.

Willamette Meridian, Oregon.

See 6.

(8093-10 M.)

From the $\frac{1}{32}$ Sec corner 20 ch
W. + 10 ch N. of $\frac{1}{4}$ Sec corner
between Secs 6 + 7.

I run

East on true line in Sec
6. Var $19^{\circ} E$

10.50

Foot of bluff, and ascend

20.00

Set stone $12 \times 10 \times 8$ ins 8 ins

in the ground for $\frac{1}{32}$ Sec
corner marked $\frac{1}{32}$ on N.

face and raised around
of stone over it.

Fits impracticable

Land gravelly on bottom

Rocky on bluff

7.
227
Allotment

Subdivision of T. 2 North R. 33 East
Willamette Meridian, Oregon.

Sec 6.

From the $\frac{1}{16}$ Sec corner 20 chains
N. of the corner to Secs. 5.
6-7 & 8. which is a
churned stake & pits 18 x 18 x 12
ins N & S. of stake $5\frac{1}{2}$ ft dirt
& mound of earth over it.

In N. pit a stake 2 ins square
marked $\frac{1}{16}$ S. on W. face
Iron

West on true line in Sec. 6.
Var. $19^{\circ} 50' E.$

1.50

Gulch corner S.

15.00

" " " " -50

20.00

Set Casakh stake 9 x 8 x 7 ins
6 ins in the ground for $\frac{1}{16}$ Sec
corner marked $\frac{1}{16}$ on N face
dug pits 18 x 18 x 12 ins E & W
of stake $5\frac{1}{2}$ ft dirt and
raised mound of earth $1\frac{1}{2}$ ft
high $3\frac{1}{2}$ ft base over it

8
228
Allotment

Subdivision of T. 2 North R. 33 East
Willamette Meridian, Oregon.

Sec 6.

(8093-10 M.)

2500 Terminal

4000 Set barath stone 12 x 8 x 7 in

8 ins in the ground for 1/16

See corner marked 1/16 on N.

face dug pits 18 x 18 x 12 ins

E & W. of stone 5 1/2 ft dia

and raised a mound of earth

1 1/2 ft high 3 1/2 ft bar over it

6000 Set a barath stone 12 x 8 x 6

ins 8 ins in the ground for

1/16 See corner marked 1/16 on

N-face. ~~dug pits 18 x 18 x 12~~

~~ins E & W. of stone 5 1/2 ft dia~~

and raised a mound of stone

1 1/2 ft high 3 1/2 ft bar

over it.

Pits impracticable

Land broken and barren

Allotment

9

220

Subdivision of T. 2 North R. 33 East
Willamette Meridian, Oregon.

Sec 6.

From the $\frac{1}{4}$ Sec corner bet.
Secs. 5 & 6. which is a
charred stake, and pits 18 + 18 +
12 ins N + S of stake $5\frac{1}{2}$ ft dirt
& mound of earth over it
In N. pit a stake 2 ins square
marked $\frac{1}{4}$ S on W. face

I run

West on true line in the
center of sec 6.

Var 20° E

2000 Deposited charred stake 12 ins
in the ground for $\frac{1}{16}$ Sec corner
Dug pits 18 + 18 + 12 ins E + W.
of stake $5\frac{1}{2}$ ft dirt and
raised a mound of earth
 $1\frac{1}{2}$ ft high $3\frac{1}{2}$ ft base over it
In E pit drove a stake
2 ft long 2 ins square 12 ins
in the ground marked $\frac{1}{16}$ S.
on N. face

Allotment

Subdivision of T. 2 North R. 33. E.

Willamette Meridian, Oregon.

Sec 6.

(8093-10 M.)

4000 Intersect the $\frac{1}{4}$ Sec corner
which is a charred stake
12 ins in the ground with
pits 18 x 18 x 12 ins E. & W. of cor
5 $\frac{1}{2}$ ft dirt and mound of
earth 1 $\frac{1}{2}$ ft high 3 $\frac{1}{2}$ ft
low over it. In E. pit a
stake 2 ins square marked
 $\frac{1}{4}$ Sec N. face

6000 Set basalt stone 11 x 8 x 7 ins
7 ins in the ground for $\frac{1}{16}$
Sec corner marked $\frac{1}{16}$ in N.
face. and raised a mound
of stone along side
Pits impracticable
Land rolling & barren
Soil ashy

Attachment

Subdivision of T. 2 North R. 33 East

Willamette Meridian, Oregon.

Sec 6.

From the $\frac{1}{4}$ Sec corner
20 chains S. and 69 chs
W. of $\frac{1}{4}$ Sec corner between
Secs. 5 + 6.

From

North on random line
in Sec 6

Var. 20° E.

2000 Intersect 11 chs East of
 $\frac{1}{4}$ Sec. corner
60 chs W. of $\frac{1}{4}$ Sec corner bet
Secs 5 + 6.

Thence from

South 19' East on true
line in Sec 6.

Var 20° East

225 Gulch corner N.W.

950 Road " N.W.

~~1850~~ Summit " " "

12

Allocation

233

Subdivision of T. 2 North R. 33 East

Willamette Meridian, Oregon.

Sec 6.

(8093-10 M.)

20.00 To the $\frac{1}{16}$ Sec corner 60 ch
 W. and 20 ch. S. of $\frac{1}{4}$
 Sec corner between Secs 5 & 6.

Land rolling & barrow
 Soil ash & barrow

Allotment

13

233

Subdividing of T. 2 North R. 33 East

Willamette Meridian, Oregon.

See 8.

From the $\frac{1}{4}$ See corner bet
Sees 8 & 9. which is a
charred stake & pits 18 x 18 x 12
ins N & S. of stake $5\frac{1}{2}$ ft dia
mound of earth $1\frac{1}{2}$ ft high
 $3\frac{1}{2}$ ft base over it.

In N. pit a stake 2 ins square
marked $\frac{1}{4}$ S. on N. face

I run

North on true line between
Sees. 8 & 9.

Var $20^{\circ} 15'$ E

500 Road corner E. & W

750 Dry Ditch corner W.

1000 Set stone 10 x 9 x 5 ins 6 ins
in the ground for $\frac{1}{16}$ and $\frac{1}{32}$
See corner marked $\frac{1}{16}$ on N.
and $\frac{1}{32}$ on W. face. dug pits
18 x 18 x 12 ins N & S of stone
 $5\frac{1}{2}$ ft dia. and raised
a mound of earth $1\frac{1}{2}$ ft

Attachment


Willamette Meridian, Oregon.

Tree 8

(8093-10 M.)

high 3 1/2 ft base over it
 1528 Rail Road course N. 85° W.
 2000 Outer timber
 3000 Set stave 11 + 9 + 7 in
 7 in in the ground for
 1/16 In curve marked 1/16
 on W. face.

from which

A balu 24 in diam bore
 N. 30° W 54 lbs dist
 marked 1/16 S. B. J.

+ raised mound of stave
 over it.

Land bottom bench
 Bottom rock
 Grass, brush &
 Balu timber

Subdivision of T. 2 North R. 33 East
Willamette Meridian, Oregon.

Sec 8.

From the $\frac{1}{4}$ Sec corner bet.
Secs. 7 & 8 which is a
charred stake & pits 18×18
 $\times 12$ ins N & S of stake $5\frac{1}{2}$ ft
dia & mound of earth $1\frac{1}{2}$ ft
high $3\frac{1}{2}$ ft base over it.

In N pit. a stake 2 ins square
marked $\frac{1}{4}$ S. on W. face

I run

North on true line between
Secs. 7 & 8.

Var 20° East

10.00 Set post 3 ft long 3 ins

square 24 ins in the ground

with marked stone
for $\frac{1}{16}$ Sec corner marked $\frac{1}{16}$

S. on W. face dug pits $18 \times 18 \times$

12 ins N & S of post $5\frac{1}{2}$ ft dia

raised mound of earth $1\frac{1}{2}$

ft high $3\frac{1}{2}$ ft base

around post.

16

236

Allotment

Subdivision T. 2 North R. 33 East

Willamette Meridian, Oregon.

See 8.

(8093-10 M.)

2000 Rail Road course $N 85^{\circ} W$ 2200 Fence course $E. + W$

3000 Set post 3 ft long 3 ins square
 24 ins in the ground with
 marked stumps, for $\frac{1}{16}$ Sec. in
 marked $\frac{1}{16}$ T. in N. face
 dug pits 18 + 18 + 12 ins N.
 + S. of post 5 $\frac{1}{2}$ ft deep and
 raised mound of earth 1 $\frac{1}{2}$
 ft high 3 $\frac{1}{2}$ ft base
 around post.

Land mostly level

Soil 1st rate +

partly cultivated

Low brush N. of R.R.

begin here
Monday

Allotment

237
17

Subdivided of T. 2 North R. 33 East

Willamette Meridian, Oregon.

Sec 8.

From the $\frac{1}{16}$ Sec corner
30 chs. N. of $\frac{1}{4}$ Sec corner
bet. Secs. 7 & 8.

From
S. 89° 53. 0. on random line
in Sec. 8.

Var. 20° East

Setting temporary corner
at every 20 - 40 + 60 chains and
79.60 Intersect the N. & S line
50 chs S. of $\frac{1}{16}$ Sec corner
30 chains N. of $\frac{1}{4}$ Sec corner
bet. Secs. 8 & 9.

Thence I run
S. 89° 46' W. on true line
in Sec. 8.

Var 21° E

1990 Set basalt stone 10 + 9 + 7 ins
6 ins in the ground for $\frac{1}{16}$
Sec corner marked $\frac{1}{16}$ on N face

Allotment

Subdivision of T. 2 North R. 33 East

Willamette Meridian, Oregon.

See 8.

(8093-10 M.)

and raised a mound of
stone over it. from which
a balw 36 ins dia base W. 39 lbs
dial marked $\frac{1}{16}$ S. S.
River 100 lbs North runs N. through
back and timber

39.80 Set basalt stone 9 x 8 x 7 ins
6 ins in the ground for $\frac{1}{16}$
See corner marked $\frac{1}{16}$ on N.
face. dug pits 18 x 18 x 12 ins
E. & W. of stone 5 $\frac{1}{2}$ ft. dia.

and raised a mound of earth
1 $\frac{1}{2}$ ft high 3 $\frac{1}{2}$ ft. dia over it

59.70 Set basalt stone 10 x 8 x 8
6 ins in the ground for $\frac{1}{16}$
See corner marked $\frac{1}{16}$ on
N. face; and raised a

mound of stone over it
Pits impracticable

65.00 Fence corner N.E.

79.60 To the $\frac{1}{16}$ See corner
30 chs N. of $\frac{1}{4}$ See cor.
between Seis 7 & 8.

Allotment

19

Subdiv of T. 2 North R. 33 East ²³⁹

Willamette Meridian, Oregon.

Sec 8.

Land level

Timber & Brush

Soil 1st rate

From the $\frac{1}{16}$ Sec. corner 10
chains N. of $\frac{1}{4}$ Sec corner
between Secs. 7 & 8.

I run

East on random line
through Sec 8.

Var 21° East

Setting temporary corner at
every 20 - 40 & 60 chs. and at
79.60 intersect the N & S line 40

ch S. of $\frac{1}{16}$ Sec corner 10 chs.
N of $\frac{1}{4}$ Sec corner bet Secs 8 & 9

Thence I run

S. $89^{\circ} 43'$ W. on true line
through Sec. 7.

Var. $20^{\circ} 30'$ East

Allotment

Subdivision of T. 2 North R. 33 East

Willamette Meridian, Oregon.

See 8

(8093-10 M.)

19.90 Set basalt stake $9 \times 8 \times 7$ in
6 ins in the ground for $\frac{1}{16}$
See corner marked $\frac{1}{16}$ in
N face dug pits $18 \times 18 \times 12$
ins E. & W. of stake $5\frac{1}{2}$ ft dirt
and raised a mound of
earth $1\frac{1}{2}$ ft high $3\frac{1}{2}$ ft
base over it.

21.00 Road corner S.W. cor.

39.80 Set basalt stake $12 \times 12 \times 7$
ins 8 ins in ground for
 $\frac{1}{16}$ See corner marked $\frac{1}{16}$
on N face. dug pits
 $18 \times 18 \times 12$ ins E. & W. of
stake $5\frac{1}{2}$ ft dirt and
raised mound of earth
 $1\frac{1}{2}$ ft high $3\frac{1}{2}$ ft base
over it.

Attachment

20

Subdivision of T. 2 North R. 33 East

Willamette Meridian, Oregon.

See 8.

- 5580 Road course N 88° W.
- 59.70 Set post 3 ft long 4 ins square 24 ins in the ground with marked stone for $\frac{1}{16}$ Sec corner marked $\frac{1}{16}$ S. on N face dug pits 18 x 18 x 12 ins E & W of post 5 $\frac{1}{2}$ ft dirt. and raised a mound of earth 1 $\frac{1}{2}$ ft high 3 $\frac{1}{2}$ ft base around it.
- 79.60 To the $\frac{1}{16}$ Sec corner 10 chs N. of $\frac{1}{4}$ Sec. corner between Secs. 7 & 8

Land along the line level
Soil mostly ashy
Some thrown brush
But little grass.

Attachment

243

Subdivisions of T. 2 North R. 33 East
Willamette Meridian, Oregon.

Sec 9

From the $\frac{1}{16}$ Sec corner 20 ch
North of $\frac{1}{4}$ Sec corner bet.
Secs 9 + 10 which is
a post 3 ft long 3 ins square
firmly set in the ground
marked $\frac{1}{16}$ Sec on N. face with
pits 18 + 18 + 12 ins N + S
of post 5 $\frac{1}{2}$ ft dia and
mound of earth 1 $\frac{1}{2}$ ft high
3 $\frac{1}{2}$ ft bare over it.

Thence I run
North on true line bet
Secs. 9 + 10
Var 20' E.

Through Grain

1000 Set barrell stake 9 + 8 + 7 ins
6 ins in the ground for $\frac{1}{32}$
Sec corner marked $\frac{1}{32}$ on N.
face; dug pits 18 + 18 + 12
ins N + S of stake 5 $\frac{1}{2}$ ft
dia. and raised a mound

24 244

Attainment

Subdiv. of T. 2 North R. 33 E.

Willamette Meridian, Oregon.

See 9

(8093-10 M.)

of earth $1\frac{1}{2}$ ft. high
 $3\frac{1}{2}$ ft. base across it.
Crown in draw and
Garden

Land rolling
Soil 1st rate
Cultivated

Allotment

215

25

Subdiv of T. 2 North R. 33 East

Willamette Meridian, Oregon.

See 9

From $\frac{1}{16}$ See corner, ^{20 chs} West
 of $\frac{1}{4}$ See between Sees
 9 + 10 which is a
 basalt stone 12 + 8 + 8 ins
 8 ins in the ground
 marked $\frac{1}{16}$ on N face
 and a mound of stone
 and earth $1\frac{1}{4}$ ft high $3\frac{1}{2}$
 ft high over it.
 I run

North on true line in See 9
 Var 21° E.

540 Spring branch of the wide
 course N. W.

17.60 Rail Road course $N 85^{\circ} W$

2000 Set post 3 ft long 3 ins
 square with marked stone
 12 ins in the ground for
 $\frac{1}{16}$ & $\frac{1}{32}$ See corner marked
 $\frac{1}{16}$ S. on S.E. face and

26

Attachment

Subdiv of T. 2 North R. 33 E.

Willamette-Meridian, Oregon.

Sec 9


(8093-10 M.)

1/32 S. on NE. face
dug pits 18 + 18 + 12 ins
N. S. of pits 5 1/2 ft deep
and raised a mound of
earth 1 1/2 ft high 3 1/2 ft
base over it

Var 20° - 30° E

29.80 True course E. + W

30.00 Set basal stone 10 + 8
+ 7 ins 6 ins in the
ground for 1/32 Sec corner
marked 1/32 on W. face

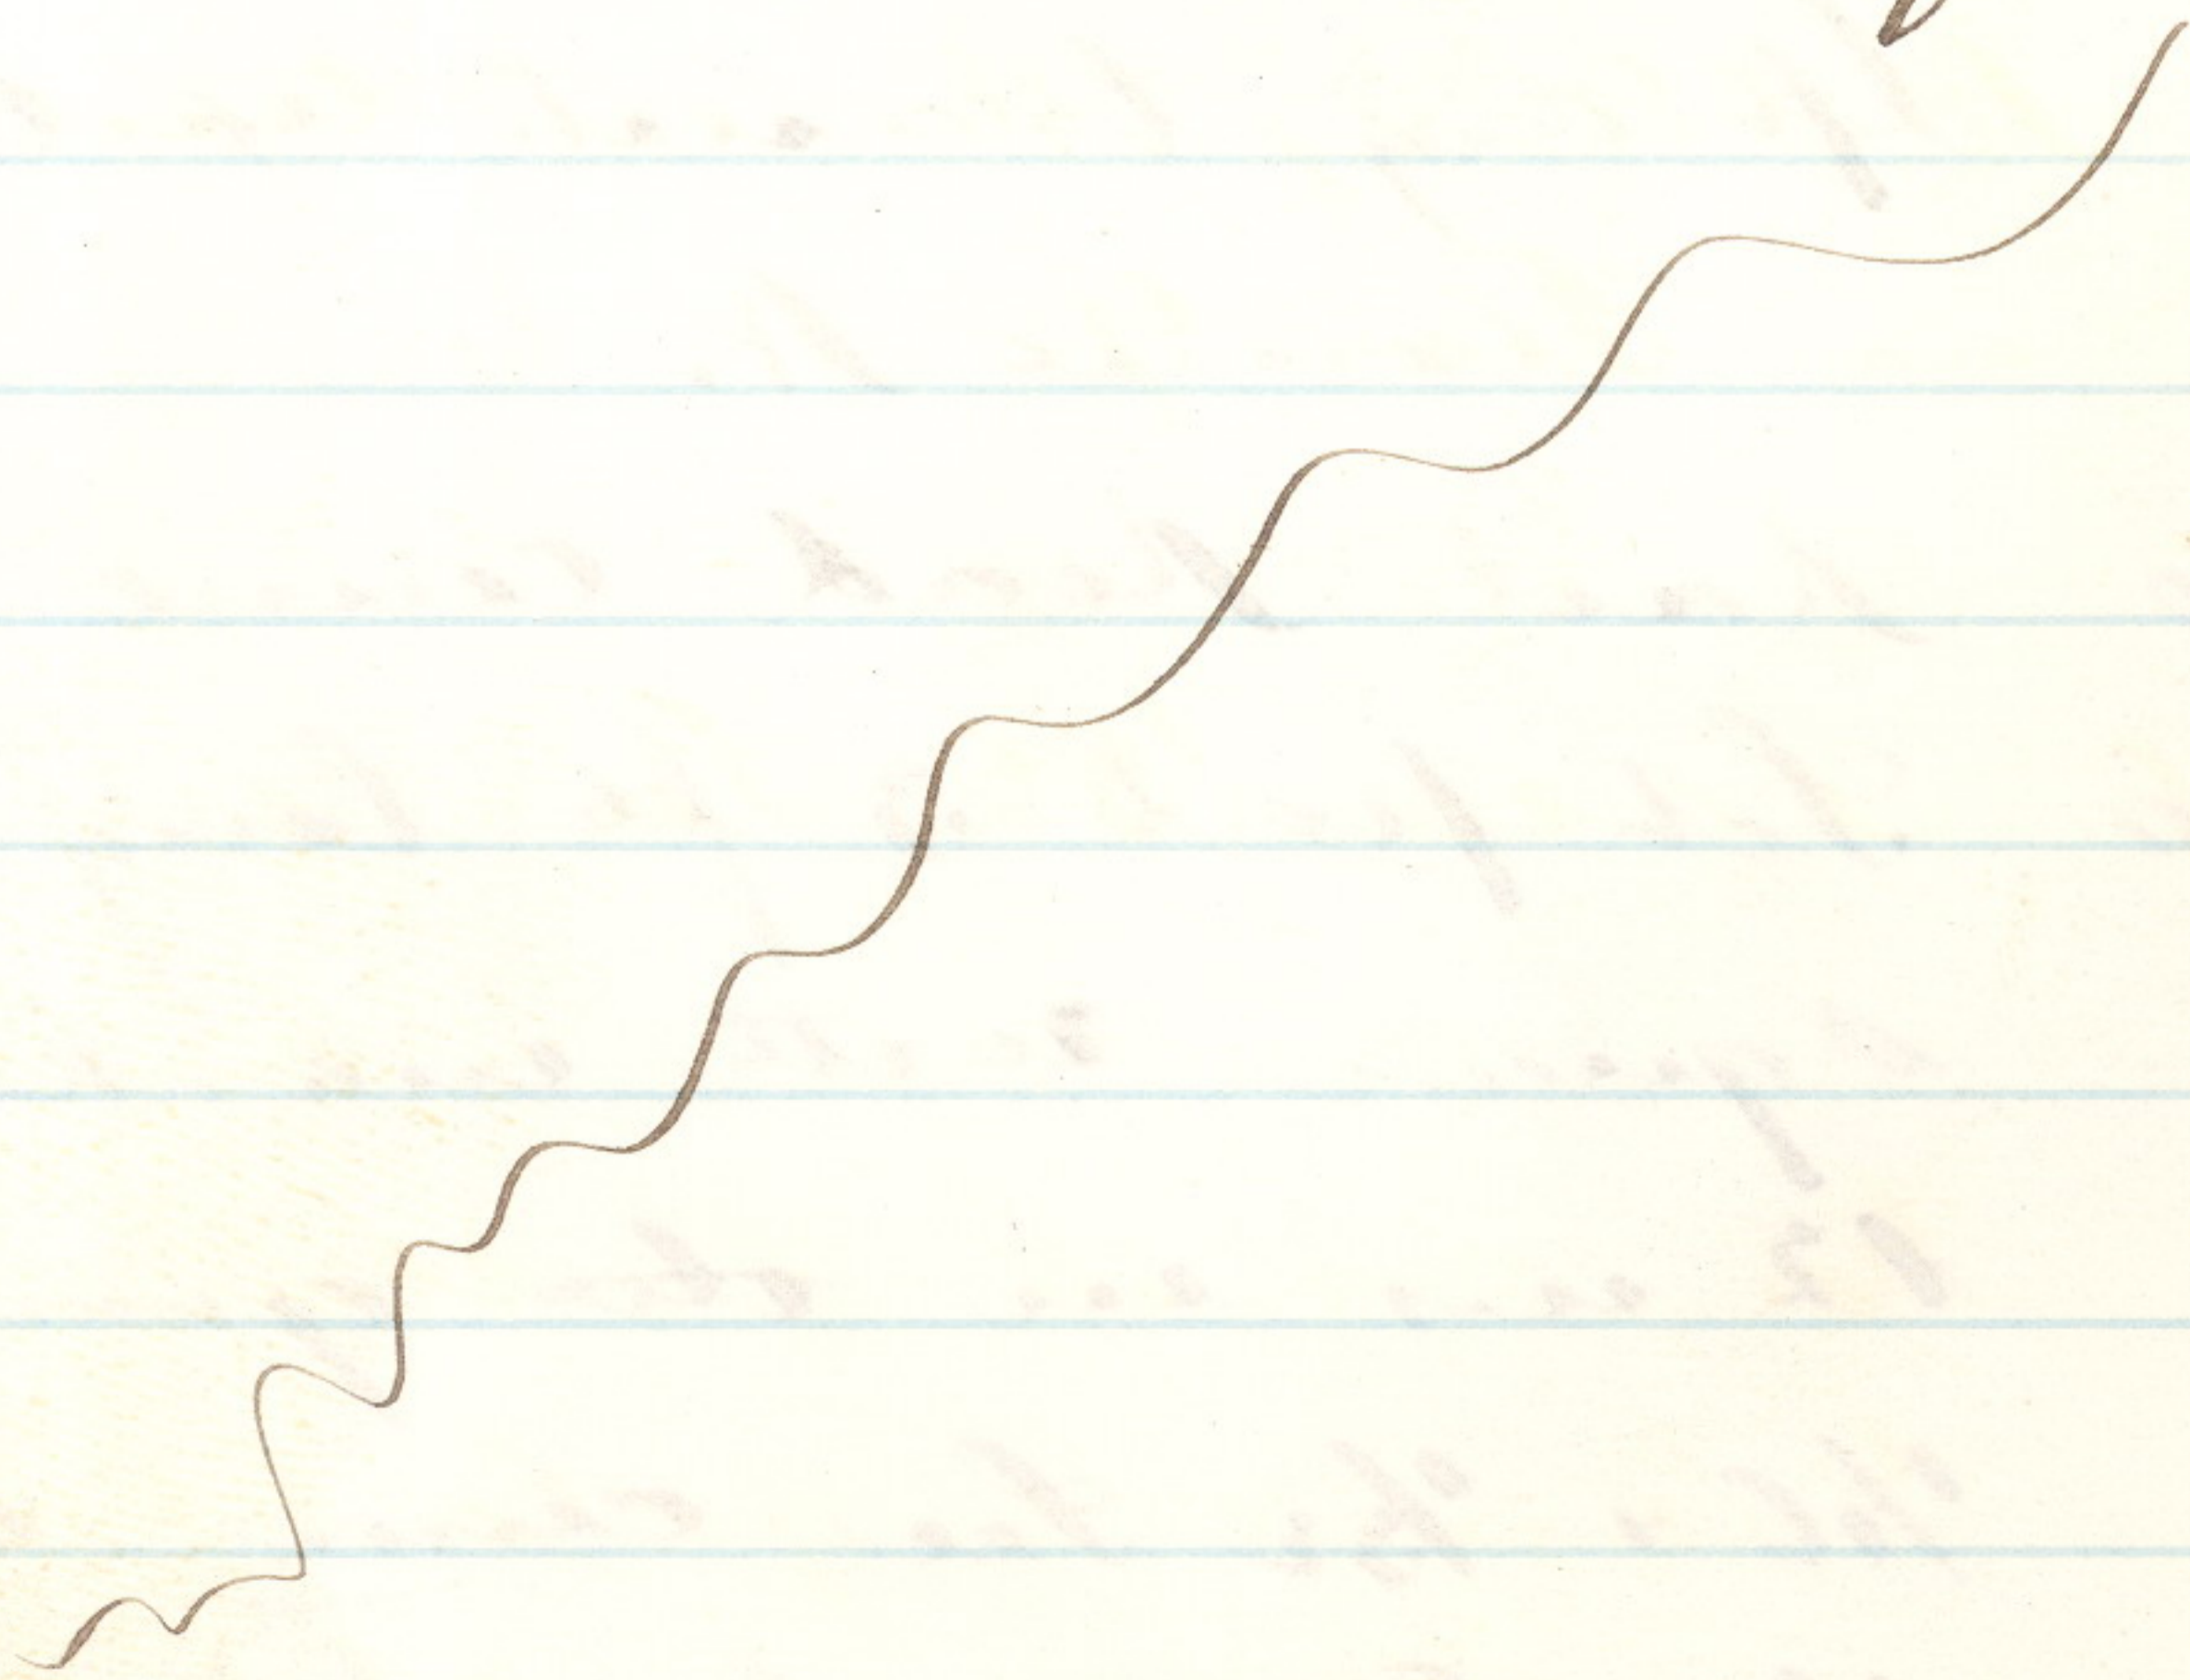

Allotment

247

17
27

Subdivers of T. 2 North R. 33 East

Willamette Meridian, Oregon.

Sec 9

and raised a mound of
stone over it

Pits impracticable

Thence down

S. $89^{\circ} 54'$ E on random line
in Sec 9.

Var 20° East

1996 Intersected 10 lbs North
of $\frac{1}{32}$ Section corner between
Secs. 9 & 10

Thence I run

N. $89^{\circ} 37'$ W. on true line
in Sec 9.

1996 To the $\frac{1}{32}$ Sec. corner

Land rich bottom

Grows vegetables

Some dense Thorn thickets

Subdivision of T. 2 North R. 33 East

Willamette Meridian, Oregon.

Sec 11

From the $\frac{1}{4}$ Sec corner in
the centre of Sec 11 which
is a post 3 ins square marked
 $\frac{1}{4}$ S. on N. face

from which

A baler 12 ins diam brs S. 49° W.

77 ins the dirt marked $\frac{1}{4}$ S. B. S.

A cherry 4 ins diam bears N. 45° E

18 lbs dirt marked $\frac{1}{4}$ S. B. S.

Iron

North on true line in Sec

11 var 26° 15' E.

700 Rail Road course N. 85° W

1000 Set post 3 ft long 3 ins square

with marked stone 12 ins in

the ground for $\frac{1}{32}$ Sec corner

marked $\frac{1}{32}$ S. on W. face

dug pits 18 x 18 x 12 ins N & S.

of post 5 $\frac{1}{2}$ ft dirt and raised

a mound of earth 1 $\frac{1}{2}$ ft. high

3 $\frac{1}{2}$ ft base around post

Subdivisions of T. 2 North R. 33 East

Willamette Meridian, Oregon.

See 11

(8093-10 M.)

Land rolling
Soil 1st sub

From the $\frac{1}{4}$ Sec corner between
Secs. 10 & 11 which is a
barack stone $19 \times 8 \times 7$ in
6 in in the ground marked
 $\frac{1}{4}$ in N face with pits 18
 $\times 18 \times 12$ in N & S of stone $5\frac{1}{2}$
ft dirt and mound of earth
 $4\frac{1}{2}$ ft high $3\frac{1}{2}$ ft base
over it.

I run

North on true line between
Secs. 10 & 11

var 20° E.

Through Grass

Subdivision of T. 2 North R. 33 East

251

Willamette Meridian, Oregon.

See 11

1000 Set post 3 ft long 3 ins square
 24 ins in the ground for $\frac{1}{32}$.
 See corner marked $\frac{1}{32}$ S. on W.
 face dug pits 18 x 18 x 12 ins
 N. S. of post 5 $\frac{1}{2}$ ft deep.
 and raised around of earth
 1 $\frac{1}{2}$ ft high 3 $\frac{1}{2}$ ft base around
 post.

Granfield rolling
 & rock.

July 12th 1889

Subdivision of T. 2 North R. 33 East
 Willamette Meridian, Oregon.

Sec 11.

(8093-10 M.)

From the $\frac{1}{32}$ Sec corner 10
 chains N. of $\frac{1}{4}$ Sec corner
 between Secs. 10 & 11

I run
 East on random line in
 Sec 11.

Var 20° East

Setting temporary corners.

at 20. chains and at

39.80 Intersect the $\frac{1}{32}$ Sec. corner
 10 chains N. of $\frac{1}{4}$ Sec corner
 in center of Sec 11 at point
 Thence I run

West on true line in Sec
 11.

Var $20^{\circ} 15'$ East

4.00 Road course N. 80° W

1990 Set barometer 10 x 9 x 8 ins
 of iron in the ground for $\frac{1}{32}$
 Sec corner. marked $\frac{1}{32}$ on

Subdivision of T. 2 North R. 33 East 253

Willamette Meridian, Oregon.

Sec 11.

W. face and raised mound
of stone over it.

Pits unpracticable

- 35.90 R. R. corner N 85° W
38.00 Fence corner N & S.
39.80 To the $\frac{1}{32}$ Sec corner 10 ch.
N. of $\frac{1}{4}$ Sec corner bet. Ties
10 & 11.

Land river bottom

Soil 1st rate gravelly

Grows grass and
some brush.

Allotment

35

Subdivision of T. 2 North R. 33 East

255

Willamette Meridian, Oregon.

See 12.

From the corner to See 12.
1-6-7 & 12 on East bdy
of Township which is
a Basalt stone 12 x 8 x 7 ins
8 ins in the ground marked
with 5 notches on S. & 1 notch
on N edge pits 18 x 18 x 12 ins
in each see 5 1/2 ft dirt &
mound of earth 2 ft high
4 1/2 ft base over it.

I run
Tenth on true line between
See 7 & 12

Var 19° 30' East

1000 Set basalt stone 9 x 8 x 7 ins
6 ins in the ground for 1/32
See corner marked 1/32 on N.
face; dug pits 18 x 18 x 12
ins N.E. of stone 5 1/2 ft
dirt.

36

Allotment

Subdivision of T. 2 North R. 33 E

Willamette Meridian, Oregon.

Sec 12.

(8093-10 M.)

and raised a mound of
earth $1\frac{1}{2}$ ft high $3\frac{1}{2}$ ft
base over it.

Land rolling
Soil arby & barren

Allotment

257 / 37

Subdivision of T. 2 North R. 33 East

Willamette Meridian, Oregon.

See 12

From the $\frac{1}{4}$ See corner bet.

Sees 1 & 2. which is a charred stake with pits 18 + 18 + 12 ins E & W. of stake 5 $\frac{1}{4}$ ft dist & mound of earth 1 $\frac{1}{4}$ ft high 3 $\frac{1}{4}$ ft base over it.

In O pit a stake 2 ins square firmly set in the ground marked $\frac{1}{4}$ S on N face.

From

South on true line in See 12.

Van 20" East

- 9.00 Descend bank about 30 ft
- 14.00 Set basalt stake 10 + 8 x 7 ins 6 ins in the ground for $\frac{1}{32}$ See corner marked $\frac{1}{32}$ on W. face.

Allotment

Subdivided of T. 2 North R. 33 East

Willamette Meridian, Oregon.

Sec 12.

(8093-10 M.)

and raised a mound of
stone over it.

Pits impracticable

Land rolling

Soil not rich

Good grass

From $\frac{1}{32}$ Sec corner 10 chs.
S. of $\frac{1}{4}$ Sec corner between
Secs 1 and 12.

I run

N 89° 51' East on random
line in Sec 12.

Var. 20° E

Setting temporary corner
at 20 chains and at

4000 Intersect the N & S line
at $\frac{1}{32}$ Sec corner. 10 chs.

S. of corner to Secs 1-6-7 & 12.

Thence I run

Allotment

259/39

Subdiv³ of T. 2 North R. 33 E

Willamette Meridian, Oregon.

Sec 12

S 89° 51' W on true line in
Sec 12. Var 19° 30' E.

2000 Set post 3 ft long 3 ins. sq.
with marked stone 12 ins in
the ground for $\frac{1}{32}$ Sec corner
marked $\frac{1}{32}$ S. on N face; dug
pits 18 x 18 x 12 ins E. & W of post
5 1/2 ft dia and raised a mound
of earth 1 1/2 ft high 3 1/2 ft low
over it.

3300 Gulch course S. - 50

3800 Descend bank - 30

4000 To $\frac{1}{32}$ Sec corner 10 ch S
of $\frac{1}{4}$ Sec corner bet. Secs 1 & 12

Land mostly level

Soil 1st rate. Cultivated

From the $\frac{1}{16}$ Sec corner 20 ch
N. of the corner to Secs 7 12 & 3 x
18 which is a charred stake with
pits 18 x 18 x 12 ins N + S of Stake
5 1/2 ft dia & mound of earth

Attachment

Subdivision of T. 2 North R. 33 E.

Willamette Meridian, Oregon.

Sec 12

(8093-10 M.)

1 1/2 ft. high 3 1/2 ft base over it
 In N. pit stake 2 ins square
 firmly set in the ground
 marked 1/16 S on N. face
 Join North on true line between
 Secs. 7 and 12
 Var 19° 15' E.

250

Fence corner E. + W

800

Road " S. W

1000

Deposited a marked stone

12 ins in the ground for
1/32 Sec
corners. dug pits 18 x 18

+ 12 ins N x S of corners

5 1/2 ft dirt and raised a
mound of earth 1 1/2 ft. high
3 1/2 ft base over it. In N.

pit drove a stake, 2 ins sq.

2 ft long 12 ins in the

ground marked 1/32 S on N face

Land along bluff

Soil is rate

Growing Grain

Allotment

261

Subdivers of T. 2 North R. 33 E.

Willamette Meridian, Oregon.

From the $\frac{1}{16}$ Sec^{com}, 20 ch₃ N.
 of corner to Secs 11-12
 13 and 14 which is a
 Charred stake 12
 ins in the ground
 with pits
 18 x 18 x 12 ins in each sec
 5 $\frac{1}{2}$ ft dirt mound of
 earth 1 $\frac{1}{2}$ ft high 3 $\frac{1}{2}$ ft base
 over it In N. side stake 2 ins square
 firmly set in ground marked $\frac{1}{16}$ Sec
 on W. face
 I own

North between Secs 11 & 12
 Var 21" E.

1000 Set basal stake 14 x 9 x 7 ins
 9 ins in the ground for $\frac{1}{32}$
 Sec corner marked $\frac{1}{32}$ on
 W. face, dug pits 18 x 18
 x 12 ins N & S of
 stake 5 $\frac{1}{2}$ ft dirt
 mound

42

262

Attachment

Subdivision of T. 2 North R. 33 E.

Willamette Meridian, Oregon.

Sec 12

(8093-10 M.)

and raised a mound
of earth $1\frac{1}{2}$ ft high $3\frac{1}{2}$
ft low over it
Land nearly level
Soil 2d rate
Plum thicket most of this line

Allotment +

43

263

Subdivisions of T. 2 North R. 33 East
Willamette Meridian, Oregon.

See 12

From the $\frac{1}{32}$ See corner 30 ch
N. of the corner to Sees 11 + 12
13 and 14.

I run

S 89° 57' E. on random line
in See 12.

Var 21° E.

Setting temporary corners at
20 - 40 + 60 chains and at
79.80 I intersect the N + S line
at $\frac{1}{32}$ See corner 10 ch
N. of corner to Sees. 7 - 12
13 and 18. on East ldy of Sp.

Thence I run

N. 89° 57' W on true line
in See 12.

Var 20° East

14.00 Bluff

-30

16.50 R.R. course S. 85° W

19.95 A cedar tree ^{5 in diam} in place
which I marked $\frac{1}{32}$ S on N.

44

203

Attachment

Subdivison of T. 2 North R. 33 East

Willamette Meridian, Oregon.

See 12

(8093-10 M.)

face for $\frac{1}{32}$ See corner
 from which
 a Stake 6 ins diam bore West
 10. lbs dirt marked $\frac{1}{32}$ S. B. S.
 a Stake 6. ins diam bore $S 45^{\circ} E$
 10 lbs dirt, marked $\frac{1}{32}$ S. B. S.

- 25.00 Rail Road corner N.W. corner
- 30.00 Bluff + 50.
- 39.90 Deposited charred stake 12
 ins in the ground for $\frac{1}{32}$
 See corner dug pits $18 \times 18 \times 12$
 ins E. & W. of stake $5\frac{1}{2}$ ft
 dirt and raised a mound
 of earth $1\frac{1}{2}$ ft high $3\frac{1}{2}$ ft
 low over it. In N. pit
 drove a stake 2 ft long 2.
 ins square 12 ins in the
 ground marked $\frac{1}{32}$ S. on
 N. face.

Allotment

45

265

Subdiv. of T. 2 North R. 33 East

Willamette Meridian, Oregon.

See 12

45.00 Descend Bluff

59.85 Set base at stem 10 + 8 + 7 in
6 in in the ground for $\frac{1}{32}$ - 100
See corner marked $\frac{1}{32}$ on N.
face and raised corner of
stem over it

It's impracticable

65.00 Ascend bluff

79.80. To the $\frac{1}{32}$ See corner 10 elu + 75
N. of corner to Seis 11-12-
13 and 14

Land broken over
Bluff & brush.
Soil 120 yds.

46.

Attachments

Subdivisions of T. 2 North R. 33 East
Willamette Meridian, Oregon.

Sec 25.

(8093-10 M.)

To survey Sec 25 there being a dispute about the line through center & N $\frac{1}{2}$ being surveyed, I began at $\frac{1}{16}$ Sec corner 20 ch. S. of the N.W. corner, which is a charred stake 12 ins in the ground pits 18 x 18 x 12 ins N & S of corner 5 $\frac{1}{2}$ ft. dirt and mound of earth over it. In N pit a stake 2 ins square marked $\frac{1}{16}$ S. on W face.

Thence from East at 19.97 found East mound with pits 18 x 18 x 12 ins E and W. of corner 5 $\frac{1}{2}$ ft dirt in E. pit a stake 2 ins square marked $\frac{1}{16}$ S. on N. face

Attachment

47

267

Subdivision of T. 2 North R. 33 East
 Willamette Meridian, Oregon.

Sec 25

Thence South 20.00 chs
 found pits 18 x 18 x 12 ins
 E & W. of a mound of earth
 5 1/2 ft dist. from corner
 In E pits a stake 2 ins
 square firmly set in ground
 marked 1/6 S. on N. face
 Thence East 29 chs found
 1/4 Sec corner at center of
 sec also pits 18 x 18 x 12
 ins & in E pits a stake
 marked 1/4 on N. face
 and at 19.90 chs further
 East I found 1/6 Sec corner
 I deemed said examination
 sufficient to determine
 the fact that the N 1/4 of
 Sec 25 had been allotted
 into 40 new tracts and all
 corners set as specified in
 former return of survey.

488 268

Subdivision of T. 2 North R. 33 East

Willamette Meridian, Oregon.

See 25

(8093-10 M.)

From the $\frac{1}{4}$ See corner
 between Sees 25 + 30
 on East boundary of the
 which is a basalt stone
 $10 \times 9 \times 7$ ins & ins in the
 ground marked $\frac{1}{4}$ on N. face
 pits $18 \times 18 \times 12$ ins N. & S. of
 cor $5\frac{1}{2}$ ft dirt & mound
 of earth $1\frac{1}{2}$ ft high $3\frac{1}{2}$
 ft base covered.

Iron

North on true line between
 Ranges 33 and 34 E.
 Var 20° E.

10.00 Set stone $10 \times 9 \times 7$ ins
 6 ins in the ground for
 $\frac{1}{32}$ See. corner, marked $\frac{1}{32}$
 on N. face; dug pits
 $18 \times 18 \times 12$ ins. N. & S. of
 stone $5\frac{1}{2}$ ft dirt and mound
 mound of earth $1\frac{1}{2}$ ft high

Subdivision of T. 2 North R. 33 East
Willamette Meridian, Oregon.

Sec 25

3 1/2 ft base over it.

Land rolling

Soil into & Grass

From the 1/6 Sec corner 20 ch
West of 1/4 Sec corner betw.
Secs 25 + 30 on E ldy. of
Sp. which is a charnel stake
12 ins in ground, pits 18 x 18
x 12 ins E. & W. of cor. 5 1/4 ft
dist & mound of earth 1 1/2
ft high 3 1/2 ft. base over it.

In E pit stake 2 ins square
marked

1/6 S. on N. face

I run

North on true line in

Sec 25

Var 20' E.

1000 Set stone 9 + 8 + 7 ins

6 ins in the ground

Allotment

Subdivision of T. 2 North R. 33 E.

Willamette Meridian, Oregon.

See 25-

(8093-10 M.)

for $\frac{1}{32}$ Sec corner was set
 $\frac{1}{32}$ on W. face dug pits
 18 x 18 x 12 ins N & S of stone
 $5\frac{1}{2}$ ft deep and raised mound
 of earth $1\frac{1}{2}$ ft high $3\frac{1}{2}$ ft
 low over it.

Land rolling
 Soil no rate
 Good grass

Willamette

271

Subdiv. of T. 2 North R. 33 E.
Willamette Meridian, Oregon.

See 25

From the $\frac{1}{32}$ See corner 20 chs
N. & 10 chs N. of $\frac{1}{4}$ See corner
bet. Sees 25 & 30 on E. ldy of
Township

Thence I run
East on random line in
See 25

Var 20° E.

1990 Intersect 10 chs North of
 $\frac{1}{32}$ ^{see} corner on E. ldy of
Township.

Thence I run
N 89° 43' W. on true line
in See 25

1990 To $\frac{1}{32}$ See corner

Land rolling Soil red into
good grass

Allotment

Subdividing of T. 2 North R. 33 E.
Willamette Meridian, Oregon.

See 28-

(8093-10 M.)

From the $\frac{1}{4}$ See corner in
the Center of See 25
which is a charred stake
12 ins in the ground with
pits 18 x 18 x 12 ins E & W of
cor. $5\frac{1}{2}$ ft dist & mound of
earth $1\frac{1}{2}$ ft high $3\frac{1}{2}$ ft base
round. In E pit a stake
2 ins square marked $\frac{1}{16}$ S.
on W. face

Thence I run
Sence on true line in See
25.

Var 19° E

20.00

See stone 19 x 8 x 7 ins 6 ins
in the ground for $\frac{1}{16}$ See Cor.
marked $\frac{1}{16}$ on W. face
near the Pendleton and
Lagrange Wagon Road
dug pits 18 x 18 x 12 ins

Allotment

273

53

Subdivision of T. 2 North R. 33 East
Willamette Meridian, Oregon.

See 25

N + S of stone $5\frac{1}{2}$ ft. dist
& raised a mound of earth
 $1\frac{1}{2}$ ft high $3\frac{1}{2}$ ft. base circ.

Low up mountain near
Pendleton & La Grande Way
Road

Soil 1st rate
Grass good.

Allotment

Subdivision of T. 2 North R. 33 East
 Willamette Meridian, Oregon.

Sec 25

(8093-10 M.)

From the $\frac{1}{16}$ Sec corner 20 ch
 S. of $\frac{1}{4}$ Sec corner between
 Secs 25 & 26. which is
 a charred stake 12 ins in
 the ground and pits 18 x 18
 x 12 ins N. & S. of corner 5 $\frac{1}{2}$
 ft dirt & mound of earth 1 $\frac{1}{2}$
 ft high 3 $\frac{1}{2}$ ft bare over it
 In N. pit a stake 2 ins
 square marked $\frac{1}{16}$ S. on N. face
 Iron

East on random line
 in Sec 25

Var 19° E

Setting temporary corner at
 10-20 x 30 chains and at
 3995 intersect the N & S line
 at the $\frac{1}{16}$ Sec corner 20 ch
 S of $\frac{1}{4}$ Sec corner in center
 of Sec 25

Allotment

275

Subdivision of T. 2 North R. 33 East

Willamette Meridian, Oregon.

See 25

Thence I run

West on true line in See 25

Var. 19° E

999 Set stone 10 x 8 x 7 ins 6 ins in the ground for 1/64 See corner marked 1/64 on N. face; and raised a mound of stone over it

It is impracticable

1998 Set stone 11 x 8 x 7 ins 8 ins in the ground for 1/64 & 1/16 Section corner marked 1/16 on N & 1/64 on the S. face; dug pits 18 x 18 x 12 ins E. & W. of stone 5 1/2 ft dist and raised a mound of earth 1 1/2 ft high 3 1/2 ft base over it

2997 Set stone 12 x 10 x 5 ins 8 ins in the ground for 1/64 See corner marked 1/64 on N face

56

296

Aluminum

Subdivision of T. 2 North R. 33 East

Willamette Meridian, Oregon.

Jan 25

(8093-10 M.)

Dug pits 18 x 18 x 12 in
E & W of stone 5 1/2 ft dirt
and raised a mound of
earth 1 1/2 ft high 3 1/2 ft
in width.

3995 To the 1/6 Sec corner on
West ldy.

Land rolling

N.W. face of Mch.

Soil red silt & rocky

Good grass

Allotment

57
277

Subdiv of T. 2 North R. 33 E.

Willamette Meridian, Oregon.

See 25

From the $\frac{1}{16}$ See corner
20 chs E. of the $\frac{1}{4}$ See corner
between Sees 25 + 26. which
is a charred stake 12 ins
in the ground with pits
18 x 18 x 12 ins E. + W. of stake
5 $\frac{1}{2}$ ft dirt mound of earth
1 $\frac{1}{2}$ ft high 3 $\frac{1}{2}$ ft base on
it In E pit a stake 2 ins
square firmly set in the
ground marked $\frac{1}{16}$ S on N
face
I run.

Fourth on true line in
See 25

Var 19" East

10.00 Set stone 10 x 9 x 7 ins 6 ins
in the ground for $\frac{1}{64}$ + $\frac{1}{32}$ See
corner marked $\frac{1}{32}$ on S face
and $\frac{1}{64}$ on N. face

58

273

Attachment

Subdiv of T. 2 North R. 33 East

Willamette Meridian, Oregon.

Sec 25

(8093-10 M.)

Dug pits 18 + 18 + 12 ins
N + S. of stave 5 1/2 ft dirt
raised a mound of earth
1 1/2 ft high 3 1/2 ft base
over it.

Land over a hill
Soil rocky
Some grass.

Allotment

59

Subdivisions of T. 2 North R. 33 E.

279

Willamette Meridian, Oregon.

Sec 25

From the ~~corner~~ ~~of~~ ~~Secs~~ ~~25~~ ~~&~~ ~~26~~ set
 Secs. 25 + 26. which is a
 charred stake 12 ins in the
 ground with pits 18 + 18 x 12
 ins N + S of stake 5 1/2 ft dirt
 + mound of earth 1 1/2 ft high
 3 1/2 ft bare round it. In N pit
 a stake 2 ins square firmly
 set in the ground marked 1/4
 S on W. face

I run

South on true line between
 Secs 25 + 26.

Var. 19° E

1000 Set stake 12 + 7 + 6 ins
 8 ins in the ground for 1/6 +
 Sec corner marked 1/64 on W.
 face, dug pits 18 + 18 x 12
 ins N + S of stake 5 1/2 ft
 dirt and raised a mound

Allotment

280
 Subdivision of T. 2 North R. 33 East

Willamette Meridian, Oregon.

See 25

(8093-10 M.)

of earth 1 1/2 ft high 3 1/2
 ft base over it.

Line over hill

Soil mostly rocky

Some grass

From 1/4 See corner 20 ch
 E. & 10 ch S. of 1/4 See cor-
 ner. See 25 & 26.

I run

West on random line

in See 25

Var 19° E

Setting temporary corner at

10 chains & at

1994 Intersect the W. bdy of
 See 25 at 1/32
 1/64 See corner

Then run

Allocation

61

Subdivision of T. 2 North R. 33 East

281

Willamette Meridian, Oregon.

Sec 25

Card on true line in
Section 25

Var. 18° 30' E.

997 Set stake 9 x 8 x 7 ins brass
in the ground for $\frac{1}{32}$ Sec
corners marked $\frac{1}{32}$ on N & $\frac{1}{64}$
on S face and raised a
mound of stone over it
Pits unpracticable

1994 To the $\frac{1}{32}$ Sec corner

Laid over a hill
Soil mostly rocky
Some grass

Allotment

282

Subdiv of T. 2 North R. 33 E

Willamette Meridian, Oregon.

Sec 25

(8093-10 M.)

From the 1/6 Sec corner
20 chs E. of 1/6 Sec corner +
20 chs N. of corner to Secs
25 + 26 - 35 + 36.

I ran

South on true line in
Sec 25.

Var 19° East

1990

Set stone 12 + 9 + 7 ins 8
ins in the ground for 1/64
Sec corner marked 1/64 on
W. face and raised a mound
of stone over it

Pits unpracticable

Land in 10 acre lot
on N.W. face of Mt.
mostly rocky, well balanced
Soil 1st rate
Grass

Subdiv of T. 2 North R. 33 E. 283

Willamette Meridian, Oregon.

See 25

Thence Iron

End on true line in See
25

Var 19° East

Descend to

1000 Set stone 12 + 9 + 7 ins
8 ins in the ground for $\frac{1}{64}$
See corner marked $\frac{1}{64}$ on N.
face dug pits 18 x 18 x 12 ins
E & W of stone 5 $\frac{1}{2}$ ft dirt
& raised a mound of earth
1 $\frac{1}{2}$ ft high 3 $\frac{1}{2}$ ft base around

Land on NW face of that
mostly rocky & alluvial

Soil 1st rate

Grass

Allotment

65
285

Subdiv of T. 2 North R. 33 East
Willamette Meridian, Oregon.

S. 36

From the $\frac{1}{16}$ Sec corner 20
chains S of the corner to
Secs 25-26-35+36 which
is a charred stake 12 ins
in the ground with pins 18x18
12 ins N+S of stake $5\frac{1}{2}$ ft
dirt & mound of earth $1\frac{1}{2}$ ft
high $3\frac{1}{2}$ ft base over it.

In N pit a stake 2 ins square
firmly set in the ground
marked $\frac{1}{16}$ S on W. face

I ran

East on true line in Sec 36.

Var $19\frac{1}{4}^{\circ}$ E

17.50 Gulch course N.W.

Dry bed of creek

2000 Set stone 10x12x8 ins

8 ins in the ground for $\frac{1}{32}$
Sec corner marked $\frac{1}{32}$ on N.
face dry pits 18x18x12

66

Allotment

Subdiv of T. 2 North R. 33 E.
Willamette Meridian, Oregon.

Sec 36.

(8093-10 M.)

E. & W. of stave $5\frac{1}{2}$ ft dist
raised a mound of earth
 $1\frac{1}{2}$ ft high $3\frac{1}{2}$ ft base
over it.

Good mouth of canyon
Soil set into
Good grass

Allotment

67
287

Subdiv of T. 2 North R. 33 E.

Willamette Meridian, Oregon.

Sec 36

From the $\frac{1}{32}$ Sec corner 20. Chas
S. & 20. chs E. of the corner
to Secs 25 & 26 - 35 & 36.

I run

South on true line in Sec 36

Var 19° E

Descend

10.00 Set Stake 15 x 8 x 6 ins

10 ins in the ground for
 $\frac{1}{32}$ Sec corner marked $\frac{1}{32}$
on W face, raised a
mound of stone over it

Pile unfracturable

Land north of Canyon

Soil not rate

Grass Good

Allotment

250
 T. 2 North R. 33 East

Willamette Meridian, Oregon.

See 36.

(8093-10 M.)

From the $\frac{1}{16}$ Sec corner
 20 chs S. of the corner to
 Sec 25-26-35+36.

I run

South on true line between
 Secs 35+36.

var $19^{\circ} 15' E$

Ascend

10.09

Set stake 9+8+7 ins
 6 ins in the ground for $\frac{1}{32}$
 Sec corner marked $\frac{1}{32}$ on N
 face. dug pits 18 x 1.8 x 12
 ins N+ S. of stake 5 $\frac{1}{2}$ ft
 dirt & raised mound of earth
 1 $\frac{1}{2}$ ft high 3 $\frac{1}{2}$ ft base
 over it

Land now in my name
 Soil not water
 Grass good

Allotment

289

69

Subdivision of T. 2 North R. 33 East

Willamette Meridian, Oregon.

See 36

From the $\frac{1}{32}$ See corner 20
chains N. + 20 chains E. of
the $\frac{1}{4}$ See corner between
35 + 36.

I run
West on random line in
See 36.

Var $20^{\circ} 30' E.$

2000 I intersect the N + S line
5 lbs South of $\frac{1}{32}$ See corner
between Sees. 35 + 36.

Thence I run
S. $89^{\circ} 58' E.$ on true line
in See 36. Var $20^{\circ} E.$

Along side hill to

1925 Gatch corner N.W.

2004 To $\frac{1}{32}$ See corner

Land monumenting

Soil test pits

Green wood

July 2nd 1889

290

allotment

Subdiv. of T. 2 North R. 33 E.

Willamette Meridian, Oregon.

(8093-10 M.)

My instructions calling for
 allotments in the S $\frac{1}{2}$ of Sec
 1. of this township, which was
 represented as having already
 been allotted under Contract
 with Currier and Kaland.
 I proceeded to examine
 said section and found
 that 40 acre tracts had
 been surveyed and corners
 established as set forth
 in the field notes of the
 former survey.

Attachment

Subdiv of T. 2 North R. 33 E. 291

Willamette Meridian, Oregon.

General Description

These lands are situated along the Umatilla River & foot hills of Blue Mountain. Brushy and broken along the River and rolling on hills.

Soil mostly 1st rate partly cultivated by Indians.

72

Attachment

292

Subdiv of T. 2 North R. 33 E.

Willamette Meridian, Oregon.

(8093-10 M.)

In accordance with
requirements of the
manual of surveys I
have carefully tested the
adjustment of my instru-
ment by taking the lati-
tude daily weather per-
mitting and in all cases
the instrument was found
to be in correct
adjustment

James P. Currier
U.S. Deputy Surveyor

FINAL OATHS FOR SURVEYS.

List of the names of the individuals employed by James P. Currier, U. S. Deputy Surveyor, to assist in running, measuring and marking the lines and corners described in the foregoing field notes of the survey of the subdivisional and allotment lines of T. 2. N. R. 33. E. Willamette Meridian, Oregon, showing the respective capacities in which they acted:

- , Compassman.
- , Chainman.
- , Chainman.
- J. R. Laramore, Chainman.
- J. L. Brown, Chainman.
- C. M. Stone, Axeman.
- R. E. Long, Axeman.
- , Flagman.

FINAL OATHS OF ASSISTANTS.

We hereby certify that we assisted James P. Currier, U. S. Deputy Surveyor, in surveying all those parts or portions of the subdivisional and allotment lines of T. 2. N. R. 33. E. Willamette Meridian, Oregon, as are represented in the foregoing field notes as having been surveyed by him and under his direction; and that said survey has been in all respects, to the best of our knowledge and belief, well and faithfully surveyed, and the corner monuments established, according to the instructions furnished by the U. S. Surveyor General of Oregon.

- , Compassman.
- J. R. Laramore, Chainman.
- J. L. Brown, Chainman.
- , Chainman.
- , Chainman.
- C. M. Stone, Axeman.
- R. E. Long, Axeman.
- , Flagman.

Subscribed and sworn to before me, this 2nd day of July 1887
Wm. L. General
 [SEAL.] Notary Public

FINAL OATH OF DEPUTY SURVEYOR.

I, James P. Plummer
United States Deputy Surveyor, do solemnly swear that in pursuance of

instructions received from Douglas H. Taylor

U. S. Surveyor General for Oregon, bearing date of the 19th

day of March 1889, I have well, faithfully and truly, in my own proper person, and in strict conformity with the instructions furnished by the U. S. Surveyor General for Oregon, the Surveying Manual, and the laws of the United States, surveying all those

parts or portions of the Allotment & subdivis-

ional lines of T. 2 N. R. 33 E

Willamette Meridian, in the State of Oregon, as are represented in the foregoing field notes as having been surveyed by me and under my directions; and I do further solemnly swear that all the corners of said survey have been established and perpetuated in strict accordance with the Surveying Manual, printed instructions, the special written instructions of the U. S. Surveyor General for Oregon, and in the specific manner described in the field notes, and that the foregoing are the *true* field notes of such survey, and should any fraud be detected I will suffer the penalty of perjury under the provisions of an Act of Congress approved August 8, 1846.

James P. Plummer

U. S. Deputy Surveyor.

Subscribed and sworn to before me, this 2nd

day of July 1889

Thos Fitz Gerald

Notary Public

207
Office U. S. Surveyor General,

Portland, Oregon, August 31st 1889

foregoing
The following Field Notes of the Survey of the

Subdivisions & Allotments

Lines of Township 2 North

Range 33 E. Will. Mer. Co.

executed by James P. Currier U.S.
Dept. Surveyor

under his Contract No. 537, dated

March 5 1889, having been critically examined, the

necessary corrections and explanations made, the said Field Notes

and the survey they describe, are hereby approved.

Douglas W. Taylor -

Surveyor General.