

FIELD NOTES

Of the survey of the Exterior L

Lines of T^s. 2 N. R^s. 32 & 33 E., T^s. 4 N. R^s. 34 & 35

E. & T^s. 3 N. R^s. 33. 34. 35 & 36 E., Willamette Meridian, Oregon,

as surveyed by Jas. P. Currier & Jas. E. Nolan

U. S. Deputy Surveyors, under ^{their} his Contract No. Special

dated May 4th, 1887.

Survey commenced, July 27th, 1887.

Survey completed, Sept 10th, 1887.

NAMES AND DUTIES OF ASSISTANTS.

L. J. Wooley, Compassman.

Frank Belshaw, Chainman.

Guy Davis, Chainman.

W. H. Medley, Chainman.

J. S. Medley, Chainman.

Barney Coomer, Axman.

J. R. Gadley, Axman.

, Flagman.

PRELIMINARY OATHS OF ASSISTANTS.

We, *J. S. Medley, W. H. Medley, Frank Belshaw & Guy Davis*

do solemnly swear that we will faithfully execute the duties of Chain Carriers; that we will level the chain over even and uneven ground, and plumb the tally pins, either by sticking or dropping the same; that we will report the true distance to all notable objects, and the true length of all lines that we will assist in measuring, to the best of our skill and ability, and in accordance with the instructions given us in the survey

of the *Exterior Lines of T. 2 N. R. 32 & 33 E. T. 4 N. R. 34 & 35 E. lines of T. 3 N. R. 33. 34. 35 & 36 East.* Willamette Meridian, Oregon.

J. S. Medley, Chainman.
W. H. Medley, Chainman.
Frank Belshaw, Chainman.
Guy Davis, Chainman.

Subscribed and sworn to before me this *14th* day of *June*, 188*7*



James P. Currin, U.S. Deputy Surveyor.


We, *B. B. Cronner* and *H. Beach*, do solemnly

swear that we will well and truly perform the duties of Axmen in the establishment of corners and other duties, according to instructions given us, and to the best of our skill and ability, in the survey of the

Exterior Lines of T. 2 N. R. 32 & 33 E. T. 4 N. R. 34 & 35 E. T. 3 N. R. 33. 34. 35 & 36 E. Willamette Meridian, Oregon.

B. B. Cronner, Axman.
H. Beach, Axman.

Subscribed and sworn to before me this *14th* day of *June*, 188*7*

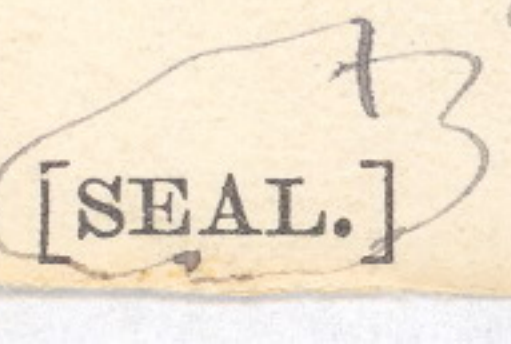

James P. Currin, U.S. Deputy Surveyor.

531

Extremes of T. 2 North R. 32 East

Willamette Meridian, Oregon.

(8093-10 M.)

- 61.00 Wagon Road Course, NW,
- 62.05 Walla Walla Branch, RR, Course NE, NW
- 6480 Dry bed Wild Horse Creek,
- 6485 Intersect M. R. bely *

Land rough & hilly - Soil 2nd rate - Timber & under brush 3. chs.

*

July 27-1887

The S. E. part of this Township is rolling - The N. & west - Hilly Soil 2nd rate except an McKay creek which is gravelly 4th rate - There is scattering cottonwood & Thorn on McKay creek - Poor grass on the rest.

*

At this point I took an observation on Polaris in accordance with instructions contained in the Manual and tested my compass on line thus established and found it to be correct.

on the bank of Wild Horse

531A

~~XXXX~~
Creek and set a stone 12 x 10 x 8 ins
diameter
ins. marked U. R. M. C. on the
S. face for meander corner
to sec. 1 & 6. dug a pit 3 ft.
square 1 ft deep 8 lbs north
of stone and raised mound
of earth 2 ft high, 4 1/2 ft
base over it.

80. 60 To Township corner to
Townships 2 & 3. North
Ranges. 32 & 33 East.

Enteriors of T. 3 North R. 33 East
 Willamette Meridian, Oregon.

West on random on S. bdy T. 3 N. R.
 33 E. Var 20° E

I set temporary $1/2$ mile & mile
 Cor at each 40,000 & 80,000 Chs
 And find the T. line to be 5 miles
 4555 Chs. and the falling to be
 2 Chs. ^{S.} of the Cor to Tpo 273
 N. Rs. 32 & 33 E.

Thence Iron South $89^{\circ}46'$ E. on
 true line on S. bdy of sec. 31
 Var 20° E.

~~32,62~~
 32,62 Intersect U. R. bdy. Set a basalt
 stone, $12 \times 8 \times 7$ ins. 8 ins in the ground
 for meander Cor to fractional Secs
 31 & 6, marked U. R. M. C. Dug a
 pit 3 ft sq. and 1 ft deep 8 lbs of
 of Cor and raised a mound of earth
 2 ft high $1 1/2$ base alongside

31,50 Wild Horse Creek, S.W.

33,50 Walla Walla branch of R.R.

35,50 Set a basalt stone $10 \times 8 \times 7$ ins 6 ins

FINAL OATHS FOR SURVEYS.

A list of the names of the individuals employed by Gas. P. Currier & Gas. E. Poland, U. S. Deputy Surveyor, to assist in running, measuring, and marking the lines and corners described in the foregoing field notes of the survey of the Exterior lines of T. 2 N. R. 32 & 33 E. lines of T. 4 N. R. 34 & 35 E. & T. 3 N. R. 33, 34, 35 & 36 E. Willamette Meridian, Oregon, showing the respective capacities in which they acted:

- L. J. Woolley, Compassman.
- Frank Belshaw, Chainman.
- Guy Davis, Chainman.
- H. J. Medley, Chainman.
- J. S. Medley, Chainman.
- Barny Crommer, Axman.
- J. R. Hadley, Axman.
- _____, Flagman.

FINAL OATHS OF ASSISTANTS.

We hereby certify that we assisted Gas. P. Currier & Gas. E. Poland, U. S. Deputy Surveyor, in surveying all those parts or portions of the Exterior lines of T. 2 N. R. 32 & 33 E. T. 4 N. R. 34 & 35 E. & T. 3 N. R. 33, 34, 35 & 36 E. Willamette Meridian, Oregon, as represented in the foregoing field notes as having been surveyed by him and under his direction; and that said survey has been in all respects, to the best of our knowledge and belief, well and faithfully surveyed, and the corner monuments established, according to the instructions furnished by the U. S. Surveyor General of Oregon.

- L. J. Woolley, Compassman.
- J. S. Medley, Chainman.
- H. J. Medley, Chainman.
- Frank Belshaw, Chainman.
- Guy Davis, Chainman.
- B. B. Crommer, Axman.
- J. R. Hadley, Axman.
- _____, Flagman.

Subscribed and sworn to before me this 30th day of

Sept, 1887

[SEAL.]

James P. Currier
U. S. Surveyor

FINAL OATH OF DEPUTY SURVEYOR.

I, James P. Leurrin & James E. Roland, United States
 Deputy Surveyor, do solemnly swear that in pursuance of instructions
 received from Douglas H. Taylor, U. S.
 Surveyor General for Oregon, bearing date of the 13th
 day of May, 1887^{vol}, I have well, faithfully,
 and truly, in my own proper person, and in strict conformity with the
 instructions furnished by the U. S. Surveyor General for Oregon, the
 Surveying Manual, and the laws of the United States, surveying all
 those parts or portions of the Exterior Lines of T. 2 N. R. 32 & 33

& T. 4 N. R. 34 & 35 E. & T. 3 N. R. 33. 34. 35 & 36 E.

Willamette Meridian, in the State of Oregon, as are represented in the
 foregoing field notes as having been surveyed by me and under my
 directions; and I do further solemnly swear that all the corners of said
 survey have been established and perpetuated in strict accordance with
 the Surveying Manual, printed instructions, the special written instruc-
 tions of the U. S. Surveyor General for Oregon, and in the specific man-
 ner described in the field notes, and that the foregoing are the *true* field
 notes of such survey, and should any fraud be detected I will suffer the
 penalty of perjury under the provisions of an act of Congress approved
 August 8, 1846.

James P. Leurrin James E. Roland
 U. S. Deputy Surveyor.

Subscribed and sworn to before me this Fifteenth
 day of February, 1888

Alfred Woodcock
 Notary Public
 for Oregon

Office of U. S. Surveyor General,

Portland, Oregon, June 19th, 1888.The ^{foregoing} following Field Notes of the Survey of the

Easterline lines of T. 2 N Rqs

32 + 33 E. T. 4 N Rqs 34 + 35. E

and T. 3 N. Rqs 33 34 35 + 36 East

Will May Or.

executed by James T. Currier and James E. Nolan

Special Joint U. S. Dept. Surveyors-
under his Contract No. _____, dated May4th, 1887, having been critically examined,
the necessary corrections and explanations made, the
said Field Notes and the survey they describe, are
hereby approved.

Douglas W. Taylor

Surveyor General.