

FIELD NOTES

281

Of the survey of the Meander

Lines of The Wild Horse Creek in T. 2 N.

<sup>33</sup> R. 32 E. 1. 3 N. R. 33 34 35 36 E, Willamette Meridian, Oregon,

as surveyed by James P. Currier

U. S. Deputy Surveyor, under his Contract No. Special

dated May 4th, 1887

Survey commenced, Sept 10th, 1887

Survey completed, Sept 17th, 1887

NAMES AND DUTIES OF ASSISTANTS.

....., Compassman.

J. S. Medley....., Chainman.

W. H. Medley....., Chainman.

....., Chainman.

....., Chainman.

Frank Hoons....., Axman.

....., Axman.

....., Flagman.

PRELIMINARY OATHS OF ASSISTANTS.

We,

282

J. S. Medley & W. H. Medley

do solemnly swear that we will faithfully execute the duties of Chain Carriers; that we will level the chain over even and uneven ground, and plumb the tally pins, either by sticking or dropping the same; that we will report the true distance to all notable objects, and the true length of all lines that we will assist in measuring, to the best of our skill and ability, and in accordance with the instructions given us in the survey

of the Meander Lines of The Wild Horse Creek. lines of

Willamette Meridian, Oregon.

J. S. Medley, Chainman.  
W. H. Medley, Chainman.  
[Signature], Chainman.  
[Signature], Chainman.

Subscribed and sworn to before me this

10th

day of

Sept.

, 1887

[SEAL.]

James P. Currin  
U.S. Deputy Surveyor

We,

J. Frank Koons and

do solemnly swear that we will well and truly perform the duties of Axmen in the establishment of corners and other duties, according to instructions given us, and to the best of our skill and ability, in the survey of the

Meander of The Wild Horse Creek. Willamette Meridian, Oregon.

J. Frank Koons, Axman.

, Axman.

Subscribed and sworn to before me this

10th


day of

Sept.

, 1887

[SEAL.]

James P. Currin  
U.S. Deputy Surveyor

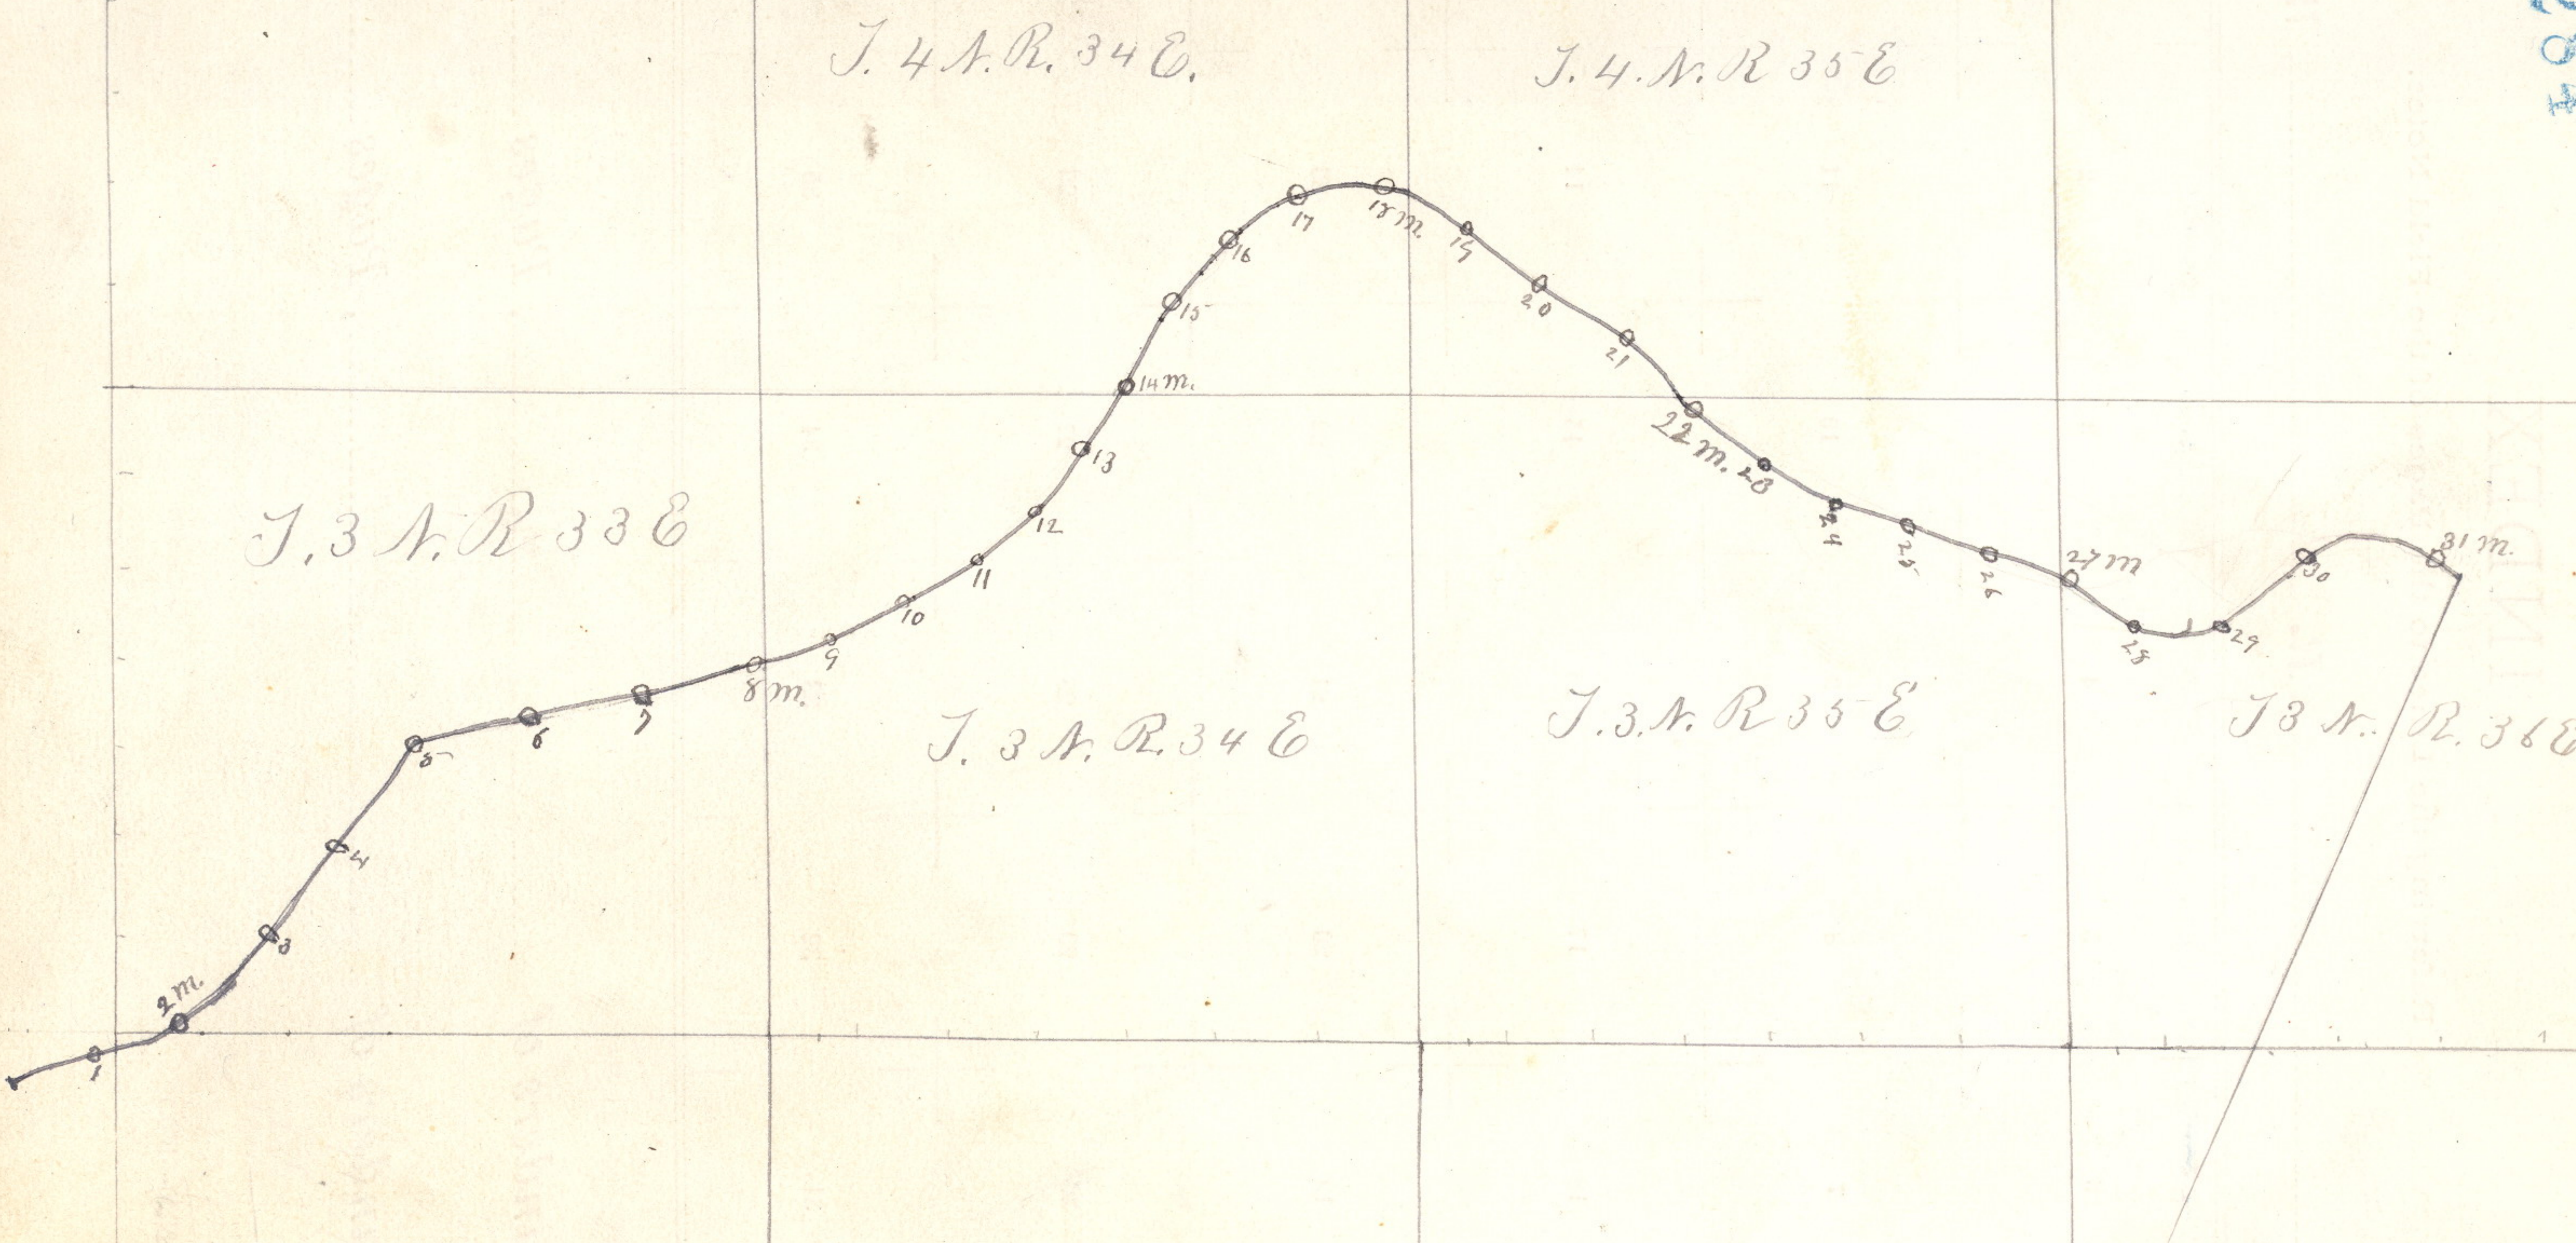

Meander of T. Wild

R. Horse 293

Willamette Meridian, Oregon.

pit 18 x 18 x 12 ins N.E. S + W of cor.  
5 1/2 ft. dist - Raised a mound  
of earth 2 ft. high 4 1/2 ft. base  
along side

Land Level Bottom  
Soil black loam 1st class  
dense willow & Thorn brush  
80.00 chs

Thence on 2nd Mile.

Var. 20° E

N 53 1/4° E 2.10 chs.

N 29 1/4° E 9.50 "

N 61 1/4° E 19.50 "

N 89° E .75 " to Meander

Cor. to Secs 1 & 6 of Tps 2 N. R.

32 & 33 E. Thence in Sec 6

Tp 2 N. R. 33 E.

N 68 1/2° E 8.10 Set a basalt stone

14 x 10 x 8 ins 9 ins in the ground

for 1/2 mile stone marked 1/2 M

on S.W. & N.E. on S.E. faces

Meander of T. Wild R. Horse

Willamette Meridian, Oregon.

(8093-10 M.)

Dug pits 18x18x12 ins N.E. & S.W.  
of cor. 5 1/2 ft - dist. raised with  
mound 1 1/2 ft - high 3 1/2 ft - base at any side  
S 42 1/2 E 2.80 ch

N 77 E 11.00 "

N 65 E 4.20 "

N 5 1/2 E 8.00 "

N 23 3/4 E 5.60 .. To meander cor  
at top line bet T. 2 & 3 & R. 33 &

Thence in Sec. 31 T. 3 N. R. 33 E.

N 4 1/2 E 7.90 ch. set a basalt-

stone 18x14x8 ins 12 ins in the gr-  
ound for 2nd Mill Cor. Mod

2 M. on S.W. & U. R. on S.E. faces

Dug pits 18x18x12 ins N.E. & S.W.  
of cor. 5 1/2 ft - dist - raised with  
mound 2 ft - high 4 1/2 ft - base along  
side

Land level bottom,

Soil black loam 1st rate

Dense willow & Thorn brush 80.00 ch

A list of the names of the individuals employed by \_\_\_\_\_

360  
James P. Currier, U. S. Deputy Surveyor, to assist in running, measuring, and marking the lines and corners described in the foregoing field notes of the survey of the Meander lines of The Wild Horse Creek Willamette Meridian, Oregon, showing the respective capacities in which they acted:

\_\_\_\_\_, Compassman.  
J. S. Medley, Chainman.  
W. H. Medley, Chainman.  
\_\_\_\_\_, Chainman.  
\_\_\_\_\_, Chainman.  
Frank Hoons, Axman.  
\_\_\_\_\_, Axman.  
\_\_\_\_\_, Flagman.


**FINAL OATHS OF ASSISTANTS.**

We hereby certify that we assisted James P. Currier, U. S. Deputy Surveyor, in surveying all those parts or portions of the Meander lines of The Wild Horse Creek Willamette Meridian, Oregon, as represented in the foregoing field notes as having been surveyed by him and under his direction; and that said survey has been in all respects, to the best of our knowledge and belief, well and faithfully surveyed, and the corner monuments established, according to the instructions furnished by the U. S. Surveyor General of Oregon.

\_\_\_\_\_, Compassman.  
J. S. Medley, Chainman.  
W. H. Medley, Chainman.  
\_\_\_\_\_, Chainman.  
\_\_\_\_\_, Chainman.  
Frank Hoons, Axman.  
\_\_\_\_\_, Axman.  
\_\_\_\_\_, Flagman.

Subscribed and sworn to before me this 17<sup>th</sup> day of

Sept., 1887  
James P. Currier, U. S. Deputy Surveyor

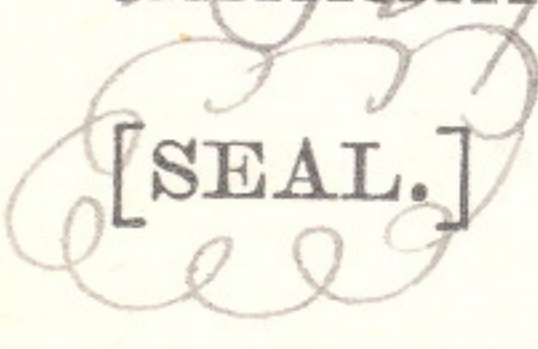

## FINAL OATH OF DEPUTY SURVEYOR.

I, James P. Currier, United States  
 Deputy Surveyor, do solemnly swear that in pursuance of instructions  
 received from Douglas H. Taylor, U. S.  
 Surveyor General for Oregon, bearing date of the 13<sup>th</sup>  
 day of May, 1887, I have well, faithfully,  
 and truly, in my own proper person, and in strict conformity with the  
 instructions furnished by the U. S. Surveyor General for Oregon, the  
 Surveying Manual, and the laws of the United States, surveying all  
 those parts or portions of The meander  
of the Wild Horse Creek  
 Willamette Meridian, in the State of Oregon, as are represented in the  
 foregoing field notes as having been surveyed by me and under my  
 directions; and I do further solemnly swear that all the corners of said  
 survey have been established and perpetuated in strict accordance with  
 the Surveying Manual, printed instructions, the special written instruc-  
 tions of the U. S. Surveyor General for Oregon, and in the specific man-  
 ner described in the field notes, and that the foregoing are the *true* field  
 notes of such survey, and should any fraud be detected I will suffer the  
 penalty of perjury under the provisions of an act of Congress approved  
 August 8, 1846.

James P. Currier

U. S. Deputy Surveyor.

Subscribed and sworn to before me this Fifteenth  
 day of February, 1888.

Alvord  
Notary Public  
for Oregon

## Office of U. S. Surveyor General,

Portland, Oregon, June 28, 1888.

The following <sup>foregoing</sup> Field Notes of the Survey of theMeander lines of the  
Wild Horse Creek.executed by James J. Currier U.S.  
Joint Special U.S. Dept Surveyors  
under his Contract No. —, dated May  
4<sup>th</sup>, 1887, having been critically examined,the necessary corrections and explanations made, the  
said Field Notes and the survey they describe, are  
hereby approved.Douglas W. Taylor  
Surveyor General.