
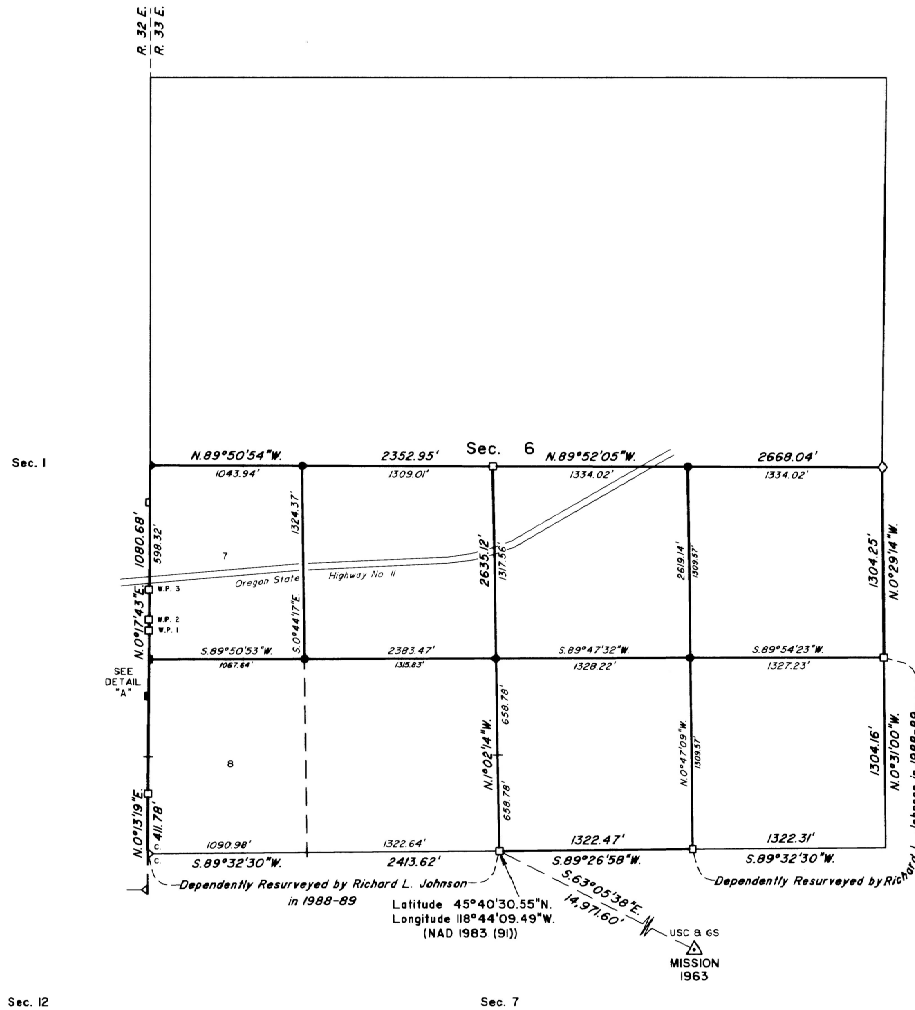


# TOWNSHIP 2 NORTH, RANGE 33 EAST, OF THE WILLAMETTE MERIDIAN, OREGON

## DEPENDENT RESURVEY AND SUBDIVISION OF SECTION 6

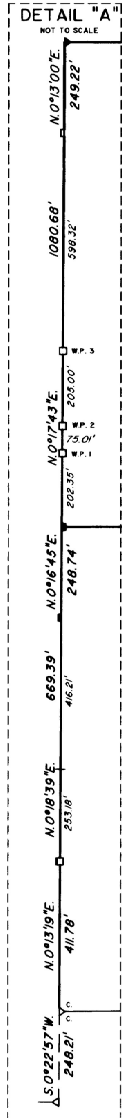

A history of surveys is contained in the field notes.

This plot represents a dependent resurvey of a portion of the west boundary and subdivision lines, and subdivision-of-section lines of section 6, T. 2 N., R. 33 E., Willamette Meridian, Oregon, designed to restore the corners in their true original locations according to the best available evidence, and the subdivision of section 6.

Measured distances and directions have been adjusted by Codastral Measurement Management for Windows (WinCMM), computer software that incorporates a least squares adjustment routine. The adjusted bearings and distances are reported to the nearest second and 0.01 foot.

The lottings and areas are as shown on the plot approved June 14, 1890.

The survey was executed by Bryan S. Seibold, Cadastral Surveyor, beginning October 7, 2002, and completed June 29, 2004, pursuant to Special Instructions dated May 10, 2002, under Group Number 2017, Oregon.

There is no timber in the area.

The tie to the geodetic control station is reported as mean bearing and sea level distance.

### LEGEND

- ◊ Original corner previously remonumented
- ◆ Original corner remonumented this survey
- ◻ Corner previously restored, established or reestablished.
- Corner previously established or reestablished; remonumented this survey
- Corner established or reestablished this survey

UNITED STATES DEPARTMENT OF THE INTERIOR  
BUREAU OF LAND MANAGEMENT

Portland, Oregon September 7, 2004

This plot is strictly conformable to the approved field notes, and the survey, having been correctly executed in accordance with the requirements of law and the regulations of this Bureau, is hereby accepted.

For the Director

Chief Cadastral Surveyor of Oregon

