4255

Township No. 2 North Range No. 34 East Willamette Meridian Or.

U I R
1 5

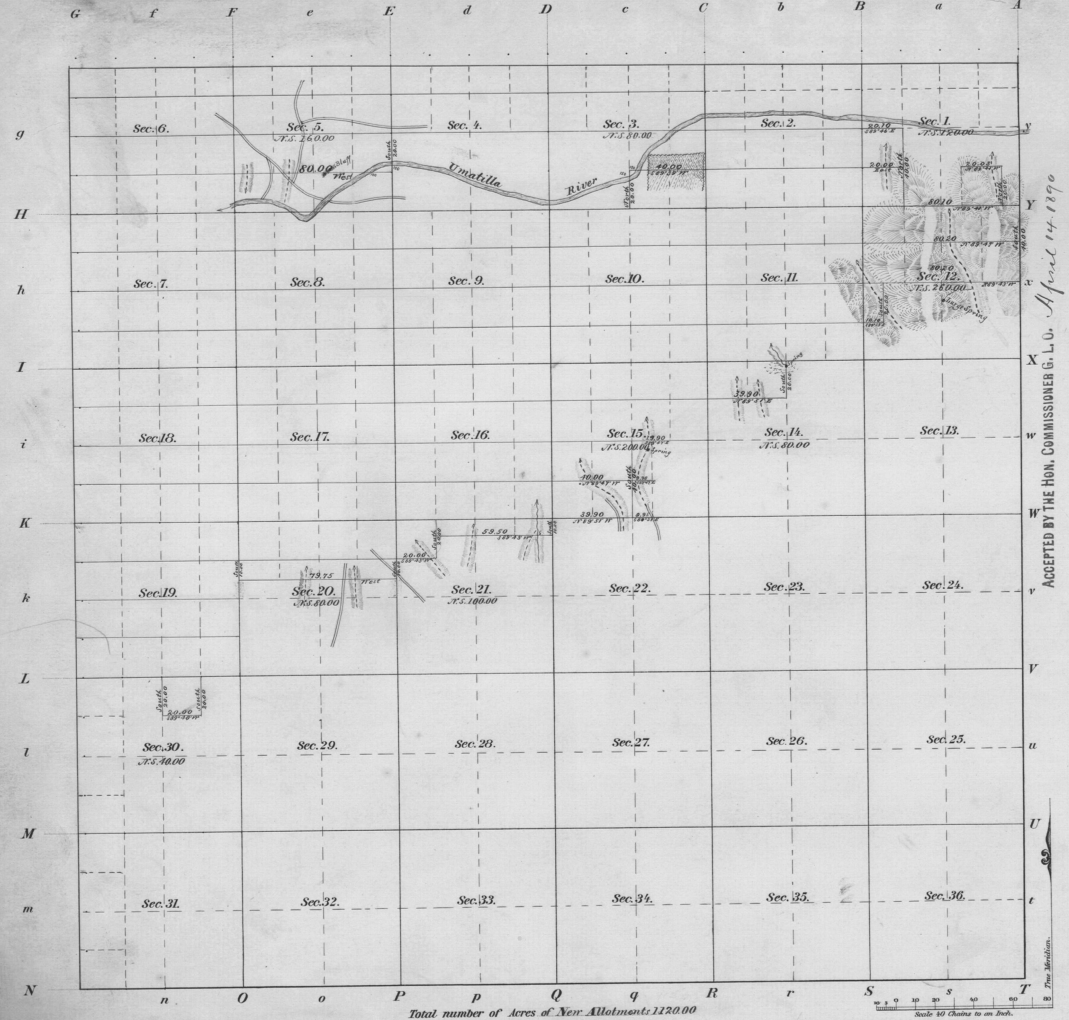

ACCEPTED BY THE HON. COMMISSIONER G. L. O. April 14 1890

Willamette Meridian.

Total number of Acres of New Allotments 1120.00

Meanders of								
Posts	Courses	Ch.'Lk.s	Posts	Courses	Ch.'Lk.s	Posts	Courses	Ch.'Lk.s

Surveys Designated	By Whom Surveyed	Date of Contract	No.	Amount of Surveys M	Ch.	Lk.s	When Surveyed	Mean Declination
Township lines and Sub-Subdivisions	James P. Currin.	March 5th 1889	537	0	40	00	July 14th to 17th 1889	19°00' to 22°00' E.
	James P. Currin.	March 5th 1889	537	12	79	61	July 14th & 17th 1889	19°00' to 22°00' E.

The above Map of Township No. 2 North of Range No. 34 East of the Willamette Meridian, Oregon, is strictly conformable to the field notes of the survey thereof on file in this Office, which have been examined and approved.

Surveyor Generals Office, Portland, Oregon. Sept. 14th 1889

Douglas W. Taylor
Sur. Gen.