

# FIELD NOTES

Of the survey of the Subdivisional Plotment

Lines of T. 2 N. R. 35 E.

----- Willamette Meridian,

Oregon, as surveyed by James P. Plummer

U. S. Deputy Surveyor, under his Contract No. 537

dated March 5 1889

Survey commenced, June 12<sup>th</sup> 1889

Survey completed, June 13<sup>th</sup> 1889

## NAMES AND DUTIES OF ASSISTANTS,

-----, Compassman.

-----, Chainman.

-----, Chainman.

J. R. Laramore, Chainman.

L. L. Brown, Chainman.

W. M. Stone, Axeman.

R. E. Long, Axeman.

-----, Flagman.

416

# PRELIMINARY OATHS OF ASSISTANTS.

We, J. R. Saramore & T. L. Brown

do solemnly swear that we will faithfully execute the duties of Chain Carriers, that we will level the chain over even and uneven ground, and plumb the tally pins, either by sticking or dropping the same; that we will report the true distance to all notable objects, and the true length of all lines that we will assist in measuring, to the best of our skill and ability, and in accordance with the instructions given us in

the survey of the subdivisional & Allotment lines of T. 2 N. R. 35 E. Willamette Meridian, Oregon.

J. R. Saramore, Chainman.  
T. L. Brown, Chainman.  
\_\_\_\_\_, Chainman.  
\_\_\_\_\_, Chainman.

Subscribed and sworn to before me, this 12th day of June 1889  
[SEAL.] Thos FitzGerald  
Notary Public

We, E. M. Stone and R. E. Long, do solemnly swear that we will well and truly perform the duties of Axemen in the establishment of corners and other duties, according to instructions given us, and to the best of our skill and ability, in the survey of the Allotment & Subdivisional lines of T. 2 N. R. 35 E. Willamette Meridian, Oregon.  
E. M. Stone, Axeman.  
R. E. Long, Axeman.

Subscribed and sworn to before me, this 12th day of June 1889  
[SEAL.] Thos FitzGerald  
Notary Public




Allotment

Subdivision of T. 2 North R. 35 East 421

Willamette Meridian, Oregon.

Sec 2.

From the  $\frac{1}{4}$  Sec corner  
on South side of Sec 35  
T. 2 N R. 35 E.  
which is a Basalt  
stone 10 x 12 x 5 ins 8 ins  
in the ground marked  
 $\frac{1}{4}$  on N. face and  
removed of stone over it.

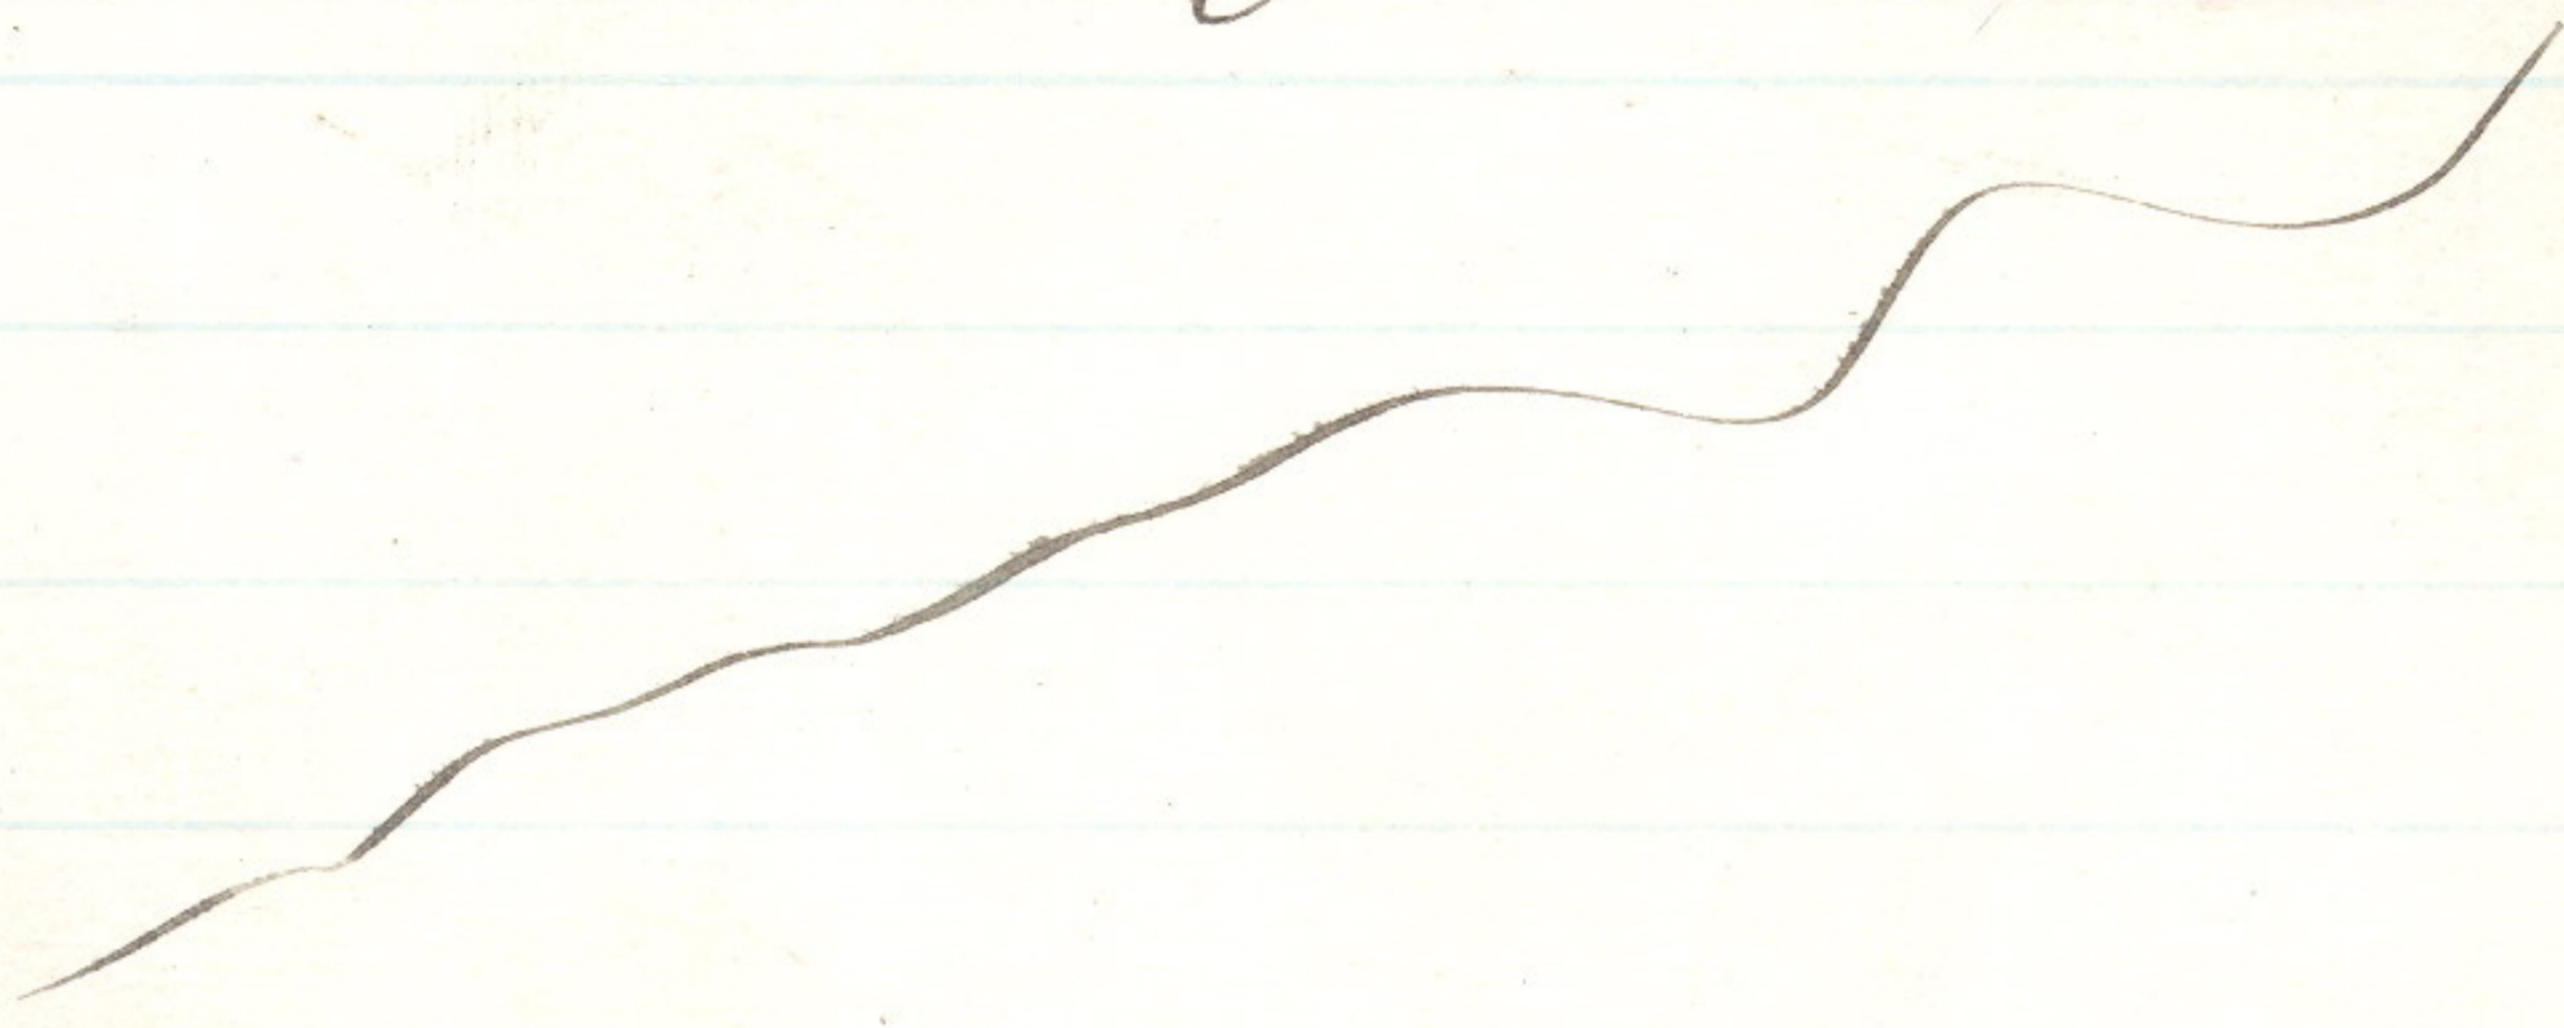

From

South on true line in Sec  
2. in T. 2 N R. 35 E.  
Var 19° E.

3.37 Set stone 14 x 10 x 4 ins 10 ins  
in the ground for  $\frac{1}{64}$  Sec  
corner marked  $\frac{1}{64}$  on N. face  
and raised a mound of  
stone

2

422

Willamette

Subdivisions of T. 2 North R. 35 East

Willamette Meridian, Oregon.

See 2.

(8093-10 M.)

over it.

Pits unpractical

Land slopes to North

Soil not rate

Grass and sunflowers

Allotment

3

423

Subdiv of T. 2 North R. 35 E.

Willamette Meridian, Oregon.

See 2.

From the  $\frac{1}{16}$  Sec corner 20  
 chains N. of the  $\frac{1}{4}$  Sec  
 corner on S. bdy of Sec 35  
 which is a post 3 ins square  
 firmly set in the ground  
 marked  $\frac{1}{16}$  S on N face &  
 pits 18 + 18 + 12 ins E & W of  
 post  $5\frac{1}{2}$  ft dia and mound  
 of earth  $1\frac{1}{2}$  ft high  $3\frac{1}{2}$  ft  
 base around post

Iron

South on true line on Sec  
 2<sup>d</sup> T. 2 N R 35 E.  
 Var  $20^{\circ}$  East

3.20

Set post 4 ft long 3 ins  
 square 24 ins in the ground  
 with charred stake for  $\frac{1}{64}$   
 $\frac{1}{32}$  Sec corner marked  $\frac{1}{64}$  S  
 on E and  $\frac{1}{32}$  S on N face  
 dug pits 18 + 18 + 12 ins

6  
426  
Allotment

Subdivision of T. 2 North R. 35 E.  
Willamette Meridian, Oregon.

Sec 3

(8093-10 M.)

From the closing corner  
to Secs 2 & 3 on North edge  
of Township which is  
a part of an square  
firmly set in the ground  
marked

T. 2 N R 35 E. C.C. on S.  
S 2 on E. & S 3 on  
W. faces with 2 notches  
on E. and 4 notches on  
W. edge and mound of  
stone around post

From

S 89° 50' W on random  
line on N. edge of Sec 3.  
Var 20° E

Setting temporary corners  
at 20 chains and at

4010 Intersect the E & W.  
line at 1/4 Sec cor

allotment

7  
42

Subdiv of T. 2 North R. 35 E.

Willamette Meridian, Oregon.

Sec 3

on S. bdy of Sec 34  
T 3 N R 35 E.  
which is a

basalt stone 12 x 10 + 10 ins  
8 ins in the ground marked  
1/4 on N face and mound  
of stone over it

Thence I run

N 89° 50' E on a true line  
on the N. bdy of Sec 3

15.20 Rail road course S. 80° W <sup>Var 20° E</sup>

17.50 Wagon road

20.00 Set stone 14 x 10 + 8 ins

9 ins in the ground for 1/6  
Sec. corner marked 1/6 on N.  
face dug pits 18 x 18 x 12 in  
E & W of stone 5 1/2 ft. dist.  
and raised a mound of  
earth 1 1/2 ft high 3 1/2 ft  
base over it.

23.70 Ascend bluff



8

# Allotment

428

Subdiv of T. 2 North R. 35 E

Willamette Meridian, Oregon.

Sec 3.

(8093-10 M.)

4000

To closing corner to Secs  
2 and 3 on N. bdy of  
Sp.

Land rough rocky river  
bottom. - Balun & fine timber

From the 1/4 Sec corner on S.  
bdy of T 34 S 3 N R 35 E  
I run

South on true line in  
Sec 3. Var 20 E.

11.20

Rail Road course N.E.

13.00

Set basalt stone 10 x 8 x 6 ins

7 ins in the ground for  
1/16 Sec corner marked 1/16  
on W. face & raised a  
mound of stone over it.

Pits unpracticable

Land brushy on River  
bottom.

490

### FINAL OATHS FOR SURVEYS.

List of the names of the individuals employed by James P. Currier, U. S. Deputy Surveyor, to assist in running, measuring and marking the lines and corners described in the foregoing field notes of the survey of the subdivisional and allotment lines of T. 2 N. R. 35 E. Willamette Meridian, Oregon, showing the respective capacities in which they acted:

- ....., **Compassman.**
- J. R. Saramore, **Chainman.**
- J. L. Brown, **Chainman.**
- ....., **Chainman.**
- ....., **Chainman.**
- C. M. Stone, **Axeman.**
- R. E. Long, **Axeman.**
- ....., **Flagman.**

### FINAL OATHS OF ASSISTANTS.

We hereby certify that we assisted James P. Currier, U. S. Deputy Surveyor, in surveying all those parts or portions of the subdivisional and allotment lines of T. 2 N. R. 35 E. Willamette Meridian, Oregon, as are represented in the foregoing field notes as having been surveyed by him and under his direction; and that said survey has been in all respects, to the best of our knowledge and belief, well and faithfully surveyed, and the corner monuments established, according to the instructions furnished by the U. S. Surveyor General of Oregon.

- ....., **Compassman.**
- J. R. Saramore, **Chainman.**
- J. L. Brown, **Chainman.**
- ....., **Chainman.**
- ....., **Chainman.**
- C. M. Stone, **Axeman.**
- R. E. Long, **Axeman.**
- ....., **Flagman.**

Subscribed and sworn to before me, this 2nd day of

July 1889  
Thos. Fitzherald  
 Notary Public

[SEAL.]

FINAL OATH OF DEPUTY SURVEYOR.

I, James P. Currier  
United States Deputy Surveyor, do solemnly swear that in pursuance of

instructions received from Douglas M. Taylor

U. S. Surveyor General for Oregon, bearing date of the 19th

day of March 1889, I have well, faithfully and truly, in my own proper person, and in strict conformity with the instructions furnished by the U. S. Surveyor General for Oregon, the Surveying Manual, and the laws of the United States, surveying all those

parts or portions of Subdivisional Settlement  
Lines of T. 2 N. R. 35 E.

Willamette Meridian, in the State of Oregon, as are represented in the foregoing field notes as having been surveyed by me and under my directions; and I do further solemnly swear that all the corners of said survey have been established and perpetuated in strict accordance with the Surveying Manual, printed instructions, the special written instructions of the U. S. Surveyor General for Oregon, and in the specific manner described in the field notes, and that the foregoing are the true field notes of such survey, and should any fraud be detected I will suffer the penalty of perjury under the provisions of an Act of Congress approved August 8, 1846.

James P. Currier  
U. S. Deputy Surveyor.

Subscribed and sworn to before me, this 2nd

day of July 1889

Thos FitzGerald  
Notary Public

Office U. S. Surveyor General,

Portland, Oregon, *September 14<sup>th</sup> 1889*

The following <sup>*following*</sup> Field Notes of the Survey of the

*Subdivision and allotment*

*lines of Township 2 North*

*Range 35 E. Will Mer Oreg.*

executed by

*James J. Cassin U.S.*  
*Deputy Surveyor*

under his Contract No.

*537*

, dated

*March*

*5<sup>th</sup>*

*1889*, having been critically examined, the

necessary corrections and explanations made, the said Field Notes

and the survey they describe, are hereby approved.

*Douglas W. Taylor*

Surveyor General.