

# FIELD NOTES

Of the survey of the Subdivisional Plotment

Lines of T. 2 N. R. 35 E.

----- Willamette Meridian,

Oregon, as surveyed by James P. Plummer

U. S. Deputy Surveyor, under his Contract No. 537

dated March 5 1889

Survey commenced, June 12<sup>th</sup> 1889

Survey completed, June 13<sup>th</sup> 1889

## NAMES AND DUTIES OF ASSISTANTS,

-----, Compassman.

-----, Chainman.

-----, Chainman.

J. R. Laramore, Chainman.

L. L. Brown, Chainman.

W. M. Stone, Axeman.

R. E. Long, Axeman.

-----, Flagman.

416

# PRELIMINARY OATHS OF ASSISTANTS.

We, J. R. Saramore & T. L. Brown

do solemnly swear that we will faithfully execute the duties of Chain Carriers, that we will level the chain over even and uneven ground, and plumb the tally pins, either by sticking or dropping the same; that we will report the true distance to all notable objects, and the true length of all lines that we will assist in measuring, to the best of our skill and ability, and in accordance with the instructions given us in

the survey of the subdivisional & Allotment lines of T. 2 N. R. 35 E. Willamette Meridian, Oregon.

J. R. Saramore, Chainman.  
T. L. Brown, Chainman.  
\_\_\_\_\_, Chainman.  
\_\_\_\_\_, Chainman.

Subscribed and sworn to before me, this 12th day of June 1889  
[SEAL.] Thos FitzGerald  
Notary Public

We, E. M. Stone and R. E. Long, do solemnly swear that we will well and truly perform the duties of Axemen in the establishment of corners and other duties, according to instructions given us, and to the best of our skill and ability, in the survey of the Allotment & Subdivisional lines of T. 2 N. R. 35 E. Willamette Meridian, Oregon.  
E. M. Stone, Axeman.  
R. E. Long, Axeman.

Subscribed and sworn to before me, this 12th day of June 1889  
[SEAL.] Thos FitzGerald  
Notary Public




Allotment

Subdivision of T. 2 North R. 35 East 421

Willamette Meridian, Oregon.

Sec 2.

From the  $\frac{1}{4}$  Sec corner  
on South side of Sec 35  
T. 2 N R. 35 E.  
which is a Basalt  
stone 10 x 12 x 5 ins 8 ins  
in the ground marked  
 $\frac{1}{4}$  on N. face and  
removed of stone over it.

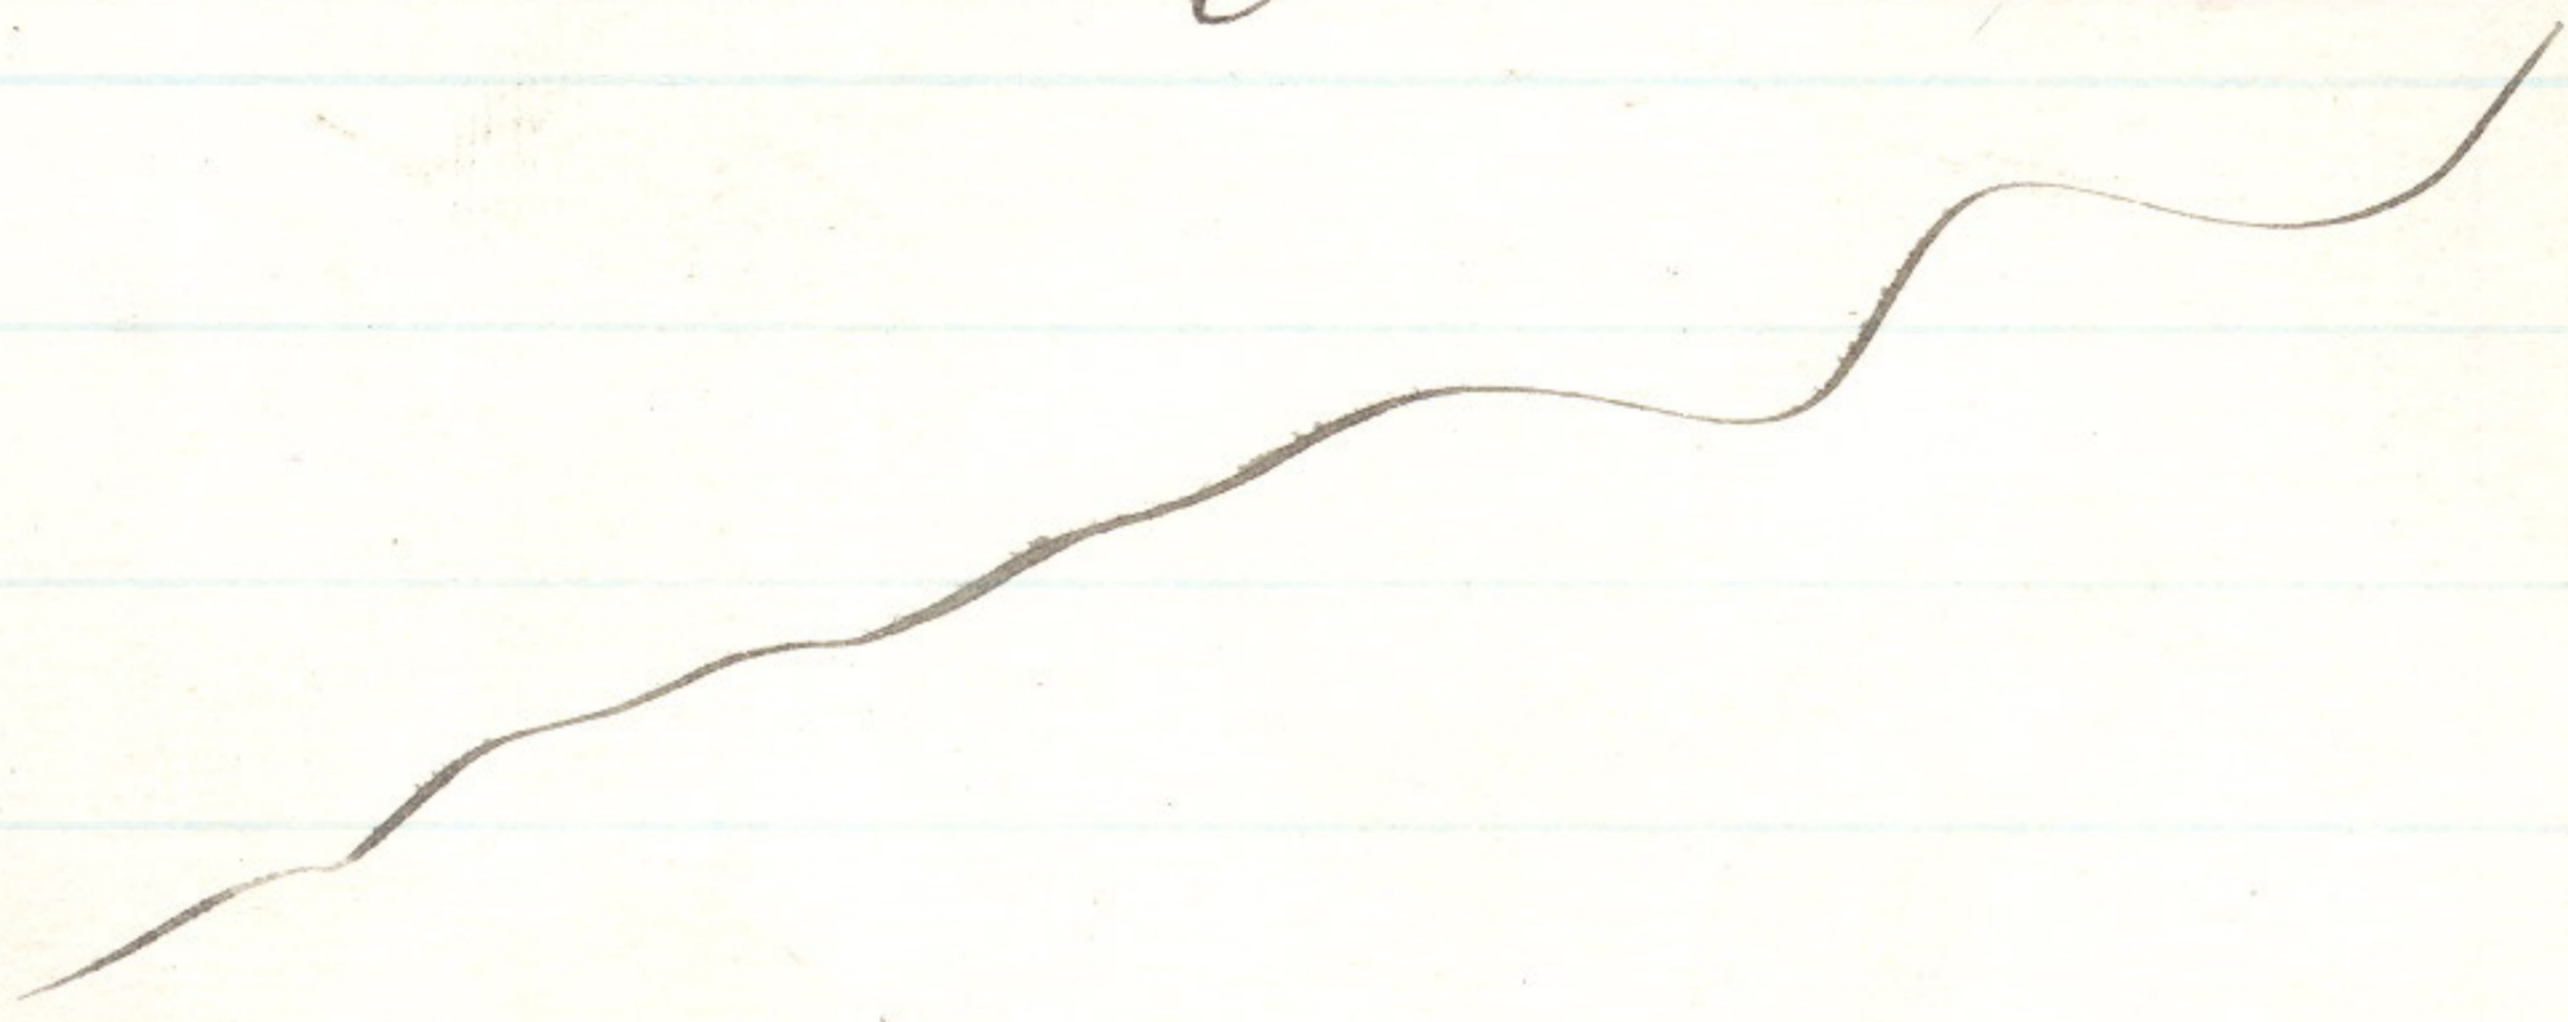

From

South on true line in Sec  
2. in T. 2 N R. 35 E.  
Var 19° E.

3.37 Set stone 14 x 10 x 4 ins 10 ins  
in the ground for  $\frac{1}{64}$  Sec  
corner marked  $\frac{1}{64}$  on N. face  
and raised a mound of  
stone

2

422

Willamette

Subdivisions of T. 2 North R. 35 East

Willamette Meridian, Oregon.

See 2.

(8093-10 M.)

over it.

Pits unpractical

Land slopes to North

Soil not rate

Grass and sunflowers

Allotment

3

423

Subdiv of T. 2 North R. 35 E.

Willamette Meridian, Oregon.

See 2.

From the  $\frac{1}{16}$  Sec corner 20  
 chains N. of the  $\frac{1}{4}$  Sec  
 corner on S. bdy of Sec 35  
 which is a post 3 ins square  
 firmly set in the ground  
 marked  $\frac{1}{16}$  S on N face &  
 pits 18 + 18 + 12 ins E & W of  
 post  $5\frac{1}{2}$  ft dia and mound  
 of earth  $1\frac{1}{2}$  ft high  $3\frac{1}{2}$  ft  
 base around post

Iron

South on true line on Sec  
 2<sup>d</sup> T. 2 N R 35 E.  
 Var  $20^{\circ}$  East

3.20

Set post 4 ft long 3 ins  
 square 24 ins in the ground  
 with charred stake for  $\frac{1}{64}$   
 $\frac{1}{32}$  Sec corner marked  $\frac{1}{64}$  S  
 on E and  $\frac{1}{32}$  S on N face  
 dug pits 18 + 18 + 12 ins

Subdivision of T. 2 North R. 35 E.

Willamette Meridian, Oregon.

Sec 2.

(8093-10 M.)

N. & S. of post  $5\frac{1}{2}$  ft dist  
and raised a mound of  
earth  $1\frac{1}{2}$  ft high  $3\frac{1}{2}$  ft  
base over it.

1320 Set stone  $10 \times 9 \times 6$  ins  
6 ins in the ground for  
 $\frac{1}{32}$  Sec corner marked  $\frac{1}{32}$  in  
W. face dug pits  $18 \times 18$  in  
in N. & S. of stone  $5\frac{1}{2}$  ft dist  
and raised a mound of  
earth  $1\frac{1}{2}$  ft high  $3\frac{1}{2}$  ft  
base over it.

Land slopes to North

Soil red

Grass and sunflowers

Allotment

5

425

Subdivision of T. 2 North R. 35 E.

Willamette Meridian, Oregon.

Sec 2

From the  $\frac{1}{32}$  Sec corner  
13.20 ch S. of the  $\frac{1}{16}$  Sec  
cor. 20 ch N. of the  $\frac{1}{4}$  Sec  
corner on the S. ldy. of Sec 35  
T. 2 N. R. 35 E.

I run

S 89° 50' W on true line

Parallel with N. ldy of T. 2  
Var 20° E.

250 Gulch corner N.

19.50

2000 Intersect Sec line bet. Secs 2

& 3. T. 2 N. R. 35 E. Set post  
post 3 ft long 3 ins square

24 ins on the ground for  $\frac{1}{16}$  Sec  
cor. marked  $\frac{1}{16}$  E.  
on N. face; dug pits 18 x 18 x

12 ins E. & W of post  $5\frac{1}{2}$  ft  
dise and raised a mound  
of earth  $1\frac{1}{2}$  ft high  $3\frac{1}{2}$  ft base  
over it

Land slopes to North Soil good



6  
426  
Allotment

Subdivision of T. 2 North R. 35 E.  
Willamette Meridian, Oregon.

Sec 3

(8093-10 M.)

From the closing corner  
to Secs 2 & 3 on North edge  
of Township which is  
a part of an square  
firmly set in the ground  
marked

T. 2 N R 35 E. C.C. on S.  
S 2 on E. & S 3 on  
W. faces with 2 notches  
on E. and 4 notches on  
W. edge and surrounded of  
stone around post

From

S 89° 50' W on random  
line on N. edge of Sec 3.  
Var 20° E

Setting temporary corners  
at 20 chains and at

4010 Intersect the E & W.  
line at 1/4 Sec cor

allotment

7  
42

Subdiv of T. 2 North R. 35 E.

Willamette Meridian, Oregon.

Sec 3

on S. bdy of Sec 34  
T 3 N R 35 E.  
which is a

basalt stone 12 x 10 + 10 ins  
8 ins in the ground marked  
1/4 on N face and mound  
of stone over it

Thence I run

N 89° 50' E on a true line  
on the N. bdy of Sec 3

15.20 Rail road course S. 80° W <sup>Var 20° E</sup>

17.50 Wagon road

20.00 Set stone 14 x 10 + 8 ins

9 ins in the ground for 1/6  
Sec. corner marked 1/6 on N.  
face dug pits 18 x 18 x 12 in  
E & W of stone 5 1/2 ft. dist.  
and raised a mound of  
earth 1 1/2 ft high 3 1/2 ft  
base over it.

23.70 Ascend bluff

8

# Allotment

428

Subdiv of T. 2 North R. 35 E

Willamette Meridian, Oregon.

Sec 3.

(8093-10 M.)

4000

To closing corner to Secs  
2 and 3 on N. bdy of  
Sp.

Land rough rocky river  
bottom. - Balun & fine timber

From the 1/4 Sec corner on S.  
bdy of T 34 S 3 N R 35 E  
I run

South on true line in  
Sec 3. Var 20 E.

11.20

Rail Road course N. E.

13.00

Set basalt stone 10 x 8 x 6 ins

7 ins in the ground for  
1/16 Sec corner marked 1/16  
on W. face & raised a  
mound of stone over it.

Pits unpracticable

Land brushy on River  
bottom.

Allotment

9

429

Section of T. 2 North R. 35 E.

Willamette Meridian, Oregon.

Sec 3

From the  $\frac{1}{6}$  Sec corner  
13.00 chains S. of  $\frac{1}{4}$  Sec  
corner on South boundary  
of Sec 34 T. 2 N R 35 E.

I run  
East on random line  
in Sec 3.

Var  $19^{\circ}$  E

Set temporary corner at  
20 ch and at

40.10 Intersect the  $\frac{1}{6}$  Sec cor  
13<sup>20</sup> chains S. of C. corner  
to Secs 2 & 3 T. 2 N R 35 E

Thence I run

West on true line in

Sec 3. Var  $20^{\circ}$  E

10500 Struck in Gulch corner N

## Allotment

480

Subdivision of T. 2 North R. 35 East

Willamette Meridian, Oregon.

Sec 3

(8093-10 M.)

2005

Set stone 12 + 8 + 7 ins  
 8 ins in the ground for  
 1/6 Sec corner, marked  
 1/6 on N face, dug pits  
 18 + 18 + 12 ins E + W of  
 stone 5 1/2 ft dia. and  
 raised a mound of earth  
 1 1/2 ft high 3 1/2 ft base  
 over it

3000

Brink of bluff corner  
 S 70° W. - 100

3400

Foot of bluff

4010

To the 1/6 Sec corner in  
 Sec 3.

Land rolling & broken  
 Grass and rocks

allotment

13

431

Subdiv. of T. 2 North R. 35 E.

Willamette Meridian, Oregon.

Sec 4

From the  $\frac{1}{4}$  Sec corner bet  
Secs. 4 and 5 which is  
a stone  $12 \times 12 \times 14$  ins 9 ins  
in the ground marked  $\frac{1}{4}$  on  
W. face;

from which

A balun 10 ins diam bears  
 $N 10^{\circ} E. 33$  lbs dist marked  $\frac{1}{4}$   
I. B. I.

A balun 14 ins diam brs  $S 20^{\circ} W.$   
96. lbs dist marked  $\frac{1}{4}$  I. B. I.

I run

South on true line between  
Secs 4 + 5.

Var  $21^{\circ} E$

- 3.50 Foot of bluff
- 9.00 Top of " 7.50
- 10.00 Set a basalt stone  $14 \times 8 \times 7$  ins  
10 ins in the ground for  $\frac{1}{16}$ .  
Sec corner marked  $\frac{1}{16}$  on W.  
face. and

432  
 Subdivision T. 2 North R. 35 E.  
 Willamette Meridian, Oregon.

## Sec 4

(8093-10 M.)

dug pits 18 x 18 x 12 ins N. & S.  
 of stone 5 1/2 ft deep and  
 raised a mound of earth  
 1 1/2 ft high 3 1/2 ft base  
 over it.

2000 Set a basalt stone 10 x 8 x 7  
 ins 6 ins in the ground for  
 1/16. See corner marked 1/16 on  
 W. face, dug pits 18 x 18 x 12  
 ins N. & S. of stone, 5 1/2 ft  
 deep and raised a mound  
 of earth 1 1/2 ft high 3 1/2 ft  
 base alongside

3000 Set basalt stone 14 x 9 x 8 ins  
 10 ins in the ground for 1/16.  
 See corner marked 1/16 on  
 W. face, dug pits 18 x 18 x 12  
 ins N. & S. of stone 5 1/2 ft deep  
 & raised a mound of earth  
 1 1/2 ft high 3 1/2 ft base  
 over it.

Altogether

15

433

Subdiv. of T. 2 North R. 35 East

Willamette Meridian, Oregon.

See 4.

Land after leaving bluff  
rolling

Sub to roots

Grass and weeds

From  $\frac{1}{16}$  Sec corner 10 ch  
N. of corner to Secs 4 + 5 - 8  
+ 9.

I run

Out on true line in See 4.

Var 22° E

Ascend

500 Summit of hill

1850 Feet of hill

2000 Head of draw

Set post 4 ft long 3 ins

square with marked stem

12 ins in the ground

escaper  $\frac{1}{16}$  Sec corner

$\frac{1}{16}$



V6

Allotment

Subdivision of T. 2 North R. 35 East

Willamette Meridian, Oregon.

See 4

(8093-10 M.)

marked 7/16 on N face  
dug pits 18 x 18 x 12 in  
E & W of stand 5 1/2 ft dia  
and raised a mound of  
earth 6 1/2 ft high 3 1/2 ft  
base diam.

Land rolling.

Soil 1st rate.

Grass and weeds

Allotment

4357

Subdivision of T. 2 North R. 35 East

Willamette Meridian, Oregon.

Sec 4

From the  $\frac{1}{16}$  Sec corner 30 ch  
S. and 20 ch East of  $\frac{1}{4}$   
Sec corner bet Secs 4 & 5  
I run

North on true line in  
Sec 4.

Var  $22^{\circ} 30' E$ .

Along side hill sloping North  
2000 Set post 4 ft long 3 ins  
square with marked stone  
12 ins in the ground for  $\frac{1}{32}$   $\frac{1}{16}$   
Sec corner marked  $\frac{1}{32}$  E on  $\frac{1}{16}$   
and  $\frac{1}{16}$  S on  $\frac{1}{16}$  face  
face, dug pits 18 x 18 x 12 ins  
N & S of post  $5\frac{1}{2}$  ft deep and  
raised a mound of earth  
 $1\frac{1}{2}$  ft high  $3\frac{1}{2}$  ft base  
over it.

2500 Gulch corner N  $10^{\circ} E$ .

Stone thicket

3000 Set basalt stone 10 x 8 x 7 ins

18

436

Allotment

Subdivision T. 2 North R. 35 East

Willamette Meridian, Oregon.

See 4

(8093-10 M.)

7 ins in the ground for  
1/32 sec corner marked  
1/32 on N face, and  
raised a mound of stones  
over it.

Pits unpracticable  
Line down a Gulch  
Soil mixed 1st rate & rocky  
Thorn & service brush  
in Gulch

Attachment

19  
437

Subdivision of T. 2 North R. 35 E.

Willamette Meridian, Oregon.

Sec 4

From the  $\frac{1}{4}$  Sec corner bet.  
Secs 4 + 5 the line to the  
centre of sec. 4 being  
over the breaks of a heavy  
bluff.

I began at  $\frac{1}{32}$  or  $\frac{1}{16}$  Sec  
corner 10 chs S. + 20 chs E.  
of the  $\frac{1}{4}$  Sec corner between  
Secs 4 + 5

Thence I run  
East on true line in Sec.  
4

Var 21° E

- 1.50 Thrown Gulech corner N - 50
- 10.00 Summit " N. + 100
- 18.50 Gulech " N - 75
- 20.00 Set a post 3 ft long 3 ins sq.  
with crosshairs stone  
+ 2 ins in the ground for  $\frac{1}{32}$   
+  $\frac{1}{16}$  Sec corner marked  $\frac{1}{32}$  S on  
W. face and  $\frac{1}{16}$  on E face

20  
438  
Allotment

Subdivision of T. 2 North R. 35 East

Willamette Meridian, Oregon.

Sec 4

(8093-10 M.)

dig pits 18 + 18 + 12 ins  
E. & W of pits 5 1/2 ft deep  
and raised around of  
earth 8 1/2 ft high 3 1/2 ft  
base around pits

Land rolling

Soil 1st rate

Grass and Straw

Collinson

439<sup>71</sup>

Subdiv of T. 2 Nord R. 35 East  
Willamette Meridian, Oregon.

10

See 4.

From the <sup>and 1/6</sup> 1/32<sup>nd</sup> Sec corner 10  
chains S. of 1/4 Sec corner  
in the Centre of See 4  
I run

North on true line in  
See 4.

Var 22° East

Along the West slope  
Descend

1000 Set post 3 ft long 3 ins sq.  
24 ins in the ground for  
1/4 Sec corner marked 1/4 in  
E. face, dug pits 18 x 18 x 12  
ins N. & S. of post 5 1/2 ft dia  
and raised a mound of  
earth 1 1/2 ft high 3 1/2 ft  
base around post.

Land rolling

Soil 1st rate

Good grass

22

# Allotment

410

Subdivision of T. 2 North R. 35 E

Willamette Meridian, Oregon.

11

## Sec 4

(8093-10 M.)

From the  $\frac{1}{4}$  Sec corner  
in the Centre of Sec 4  
I run

Ord on true line in  
Sec 4.

Var  $19^{\circ}30'$  E.

550

Gulch corner N. & brushy

600

Fence corner N & S

1000

Set a post 3 ft long 3 ins  
square 24 ins in the ground  
for  $\frac{1}{16}$  Sec corner marked  $\frac{1}{16}$ S  
in the N. face. dug pits  
18 x 18 x 12 ins E & W of  
post 5  $\frac{1}{2}$  ft dirt and raised  
a mound of earth 1  $\frac{1}{2}$  ft  
high 3  $\frac{1}{2}$  ft base around  
post.

Land rolling

Soil test rate

Grass & brush

A Statement

23  
441

Subdivision of T. 2 North R. 35 East  
Willamette Meridian, Oregon.

72

Sec 4

From the  $\frac{1}{16}$  Sec corner 10 ch  
East of  $\frac{1}{4}$  Sec corner in  
center of Sec. 4.

Thence I run  
North on land line in  
Sec 4.

Var  $19^{\circ}$  E.

Through Grain field  
to perpendicular  $E. \frac{1}{2}$

350  
500

Set post 3 ft. long 3 ins sq.  
24 ins in the ground for  $\frac{1}{16}$   
Sec corner marked  $\frac{1}{16}$ . I on  
W face, dug pits  $18 \times 18 \times 12$   
ins E & W of post  $5\frac{1}{2}$  ft  
dirt, and raised a mound  
of earth  $1\frac{1}{2}$  ft high  $3\frac{1}{2}$  ft  
low around post

Land level  
Soil not rut  
Grain grow



24  
442

Attachment

Subdivision of T. 2 North R. 35 E

Willamette Meridian, Oregon.

Sec 4

(8093-10 M.)

From the  $\frac{1}{16}$  Sec corner  
10 chs O. & 5 chains N  
of  $\frac{1}{4}$  Sec cor in the Centre  
of Sec 4.

I now  
Cast on true line in  
Sec 4.

Var 18" East

Through Grain.

1750 Leave Grainfield

1900 Descend bluff + 30

2000 Set post 3 ft long 3 ins sq.  
24 ins in the ground for  $\frac{1}{16}$

Sec corner marked  $\frac{1}{16}$  Sec N.  
face. from which

A Thorn 5 ins diam br N 45°

N. 12 lbs dist marked  $\frac{1}{16}$  S. B. T.

A balun 8 ins diam br N 40°

E. 20 lbs dist. marked  $\frac{1}{16}$  S. B. T.

Land Hoolling

of Soil & rate

Grain & Grass & little timber

A Statement

4435

Subdivision of T. 2 North R. 35 East  
Willamette Meridian, Oregon.

See 4.

From the  $\frac{1}{16}$  Sec corner  
5 chs N. & 30 chs  
East of  $\frac{1}{4}$  Sec corner in the  
Center of Sec 4.

I run

Points on true line in Sec.  
4. Var 20' E.

.65 Bluff. + 80

1200 Fence corner E. & W

Gulch N.E. of line about  
3.50 chain Parallel

1500 Set post 4 ft long 5 ins square  
with marked Stone 12 ins in  
the ground for  $\frac{1}{16}$  Sec corner  
marked  $\frac{1}{16}$  S on W. face  
dug pits 18 x 18 x 12 ins N. & S.  
of post 5 1/2 ft dia. and  
raised mound of earth 1/2  
ft. high 3 1/2 ft base around  
post.

Land rolling Soil 1<sup>st</sup> rate  
Good grass

26

Attachment

444  
Subdivision of T. 2 North R. 35 East

Willamette Meridian, Oregon.

See 4

(8093-10 M.)

Thence Iron

West on a random line  
in See 4.

Var 21° East

across rolling ground sloping  
abruptly to North

30.15 Intersect the line 19<sup>th</sup>  
N of  $\frac{1}{16}$  Sec corner 10 ch S  
of  $\frac{1}{4}$  Sec corner in the center  
of See 4.

Thence Iron

N 89° 49' E on true line in  
See 4.

Var 22° E

1.75 Ledger of rock corner N & S 5

30.05 To the  $\frac{1}{16}$  Sec corner

Low rolling face of Mt.  
Soil 1<sup>st</sup> rate Grain & grass  
Brush in gulches

Allotment

29

Subdivision of T. 2 North R. 35 East  
Willamette Meridian, Oregon.

Sec 5

From the  $\frac{1}{4}$  Sec corner  
between Secs 4 + 5

I run  
West on true line in  
Sec 5.

Var  $21^{\circ}$  E

2000 Set stone 10 + 8 + 6 ins  
6 ins in the ground for  
 $\frac{1}{16}$  Sec corner; marked  $\frac{1}{16}$  on  
N. face. on edge of Ditch  
and raised mound of stone  
over it.

File impracticable

Land level

Soil 1st rate

Grass

30 450

Allotment

Subdivision of T. 2 North R. 35 East

Willamette Meridian, Oregon.

448

447

(8093-10 M.)

Sec 5

From the  $\frac{1}{16}$  Sec corner  
20 chains N. of  $\frac{1}{4}$  Sec  
corner between Secs 4 + 5

I run

South on true line in  
Sec 5. Var 20" E.

50

Ditch course W.

1000

Field course S.W.

1500

Fence course E + W

2000

Set stakes 12 + 10 + 8 ins  
8 ins in the ground in  
Pasture for  $\frac{1}{16}$  Sec corner  
marked  $\frac{1}{16}$  on N. face  
and raised a mound of  
stone over it

Its unpracticable

Land rolling

Soil 2nd rate

Grass good

31  
451  
Allotment

Subdiv. of T. 2 North R. 35 East

Willamette Meridian, Oregon.

See 5.

From the  $\frac{1}{16}$  Sec corner 20 ch  
W. and 20 ch S of  $\frac{1}{4}$  Sec  
corner between Secs 4 + 5

I run

East on random line in  
Sec 5

Var 19° E

2000 Intersect the N-S line at  
 $\frac{1}{16}$  Sec corner between Secs  
4 + 5

Then I run

West on true line in Sec.  
5 Var 20° E

1500 Gulch N.W. main Canyon

2000 To the  $\frac{1}{16}$  Sec corner

Line down wide Gulch  
Soil rocky and not  
sown - Grass and  
Grain in field

452

Attachment  
 Subdivision of T. 2 North R. 35 East  
 Willamette Meridian, Oregon.

Sec. 5

(8093-10 M.)

From  $\frac{1}{16}$  Sec corner 20 chs

West of  $\frac{1}{4}$  Sec corner

Secs 4 + 5

From

West on true line in

Sec 5 Var  $21^{\circ}$  E.

600 Feet of bluff

850 Top of Bluff + 175

2000 Set stone 16 x 9 x 6 ins

12 ins in the ground

for  $\frac{1}{4}$  Sec corner, marked

$\frac{1}{4}$  on N face; dug pits

18 x 18 x 12 ins E & W of stone

5 1/2 ft. dirt and raised a

mound of earth 1 1/2 ft. high

3 1/2 ft base around.

Land rolling

Soil 1<sup>st</sup> & 2<sup>d</sup> into rocky

Good grass

June 12 1889

Allotment

453

Subdiv of T. 2 North R. 35 E.

Willamette Meridian, Oregon.

Sec 5

From the 1/4 Sec corner  
in the Centre of Sec 5  
From  
South on true line in  
Sec 5

Var 21° East

1000 Set stone 18 x 11 x 5 ins 14  
ins in the ground for 1/32 Sec  
corner marked 1/32 on N face  
dug pits 18 x 18 x 12 in N  
& S of stone 5 1/2 ft deep and  
raised in mound of earth  
1 1/2 ft high 3 1/2 ft base  
over it.

Land rolling

Soil 2d rate

Good grass



34

454

A lot to be cut

Subdiv of T. 2 North R. 35 East

Willamette Meridian, Oregon.

Sec 5

(8093-10 M.)

From the  $\frac{1}{4}$  Sec corner in  
Center of Sec 5  
I run

West on random line  
in Sec 5.

20.00 Set temporary  $\frac{1}{16}$  Sec corner

39.80 I intersect the N. S. line  
at  $\frac{1}{4}$  Sec. corner between  
Secs 5 & 6.

which is a stone 9x8  
+ 7 ins 6 ins in the ground  
marked  $\frac{1}{4}$  on N. face  
with pits 18+16+12 ins  
N. S. of stone  $5\frac{1}{2}$  ft. dist  
& mound of earth  $1\frac{1}{2}$  ft  
high  $3\frac{1}{2}$  ft low over it.



Allotment

35  
455

Subdivision of T. 2 North R. 35 East

Willamette Meridian, Oregon.

Sec 5

Thence I run

East on true line in Sec 5

Var 21° E.

1990 Set stone 12 + 8 + 7 ins  
8 ins in the ground for  
1/6 Sec corner marked 1/6  
on N. face; dug pits 18 x 18.  
x 12 ins E & W of stone 5 1/2 ft  
dirt. and raised a mound  
of earth 1 1/2 ft high 3 1/2 ft  
base over it

39.80 To the 1/4 Sec corner in Center  
of Sec. 5

Land rolling

Soil 1st & 2d rate

Good grass

Allotment

Subdiv of T. 2 North R. 35 E.

Willamette Meridian, Oregon.

See 5

(8093-10 M.)

From the 1/4 See corner  
between Sees 5 + 6.

I run

North on true line bet.  
Sees 5 + 6.

Var 21° E

1700

Begin to Descend

1925

Foot of descent

-100

2900

Foot post 3 ft long 3 ins  
square 24 ins in the ground  
for 1/16 See corner marked  
1/16 S in N. face

-100

from which

A cedar 36 ins diam on N.

17 lbs dist marked 1/16 S. B. S.

an Alder - ins diam bears

S. 80° E 54 lbs dist marked

1/16 S. B. S.

Land slopes to N. - rich  
to top of bluff grass  
& grain.

Allotment

39

450

Subdivision of T. 2 North R. 35 E.

Willamette Meridian, Oregon.

Sec 5

From the  $\frac{1}{16}$  Sec, corner 19.90 chs  
E. of  $\frac{1}{4}$  Sec corner bet  
Sec 5 + 6

I run  
North on true line in  
Sec 5.

Var  $20.9^{\circ}$  E.

16.50 Road course E + W  
Graded

17.50 Spring branch 10 lbs wide  
course N.E.

18.50 Rail Road course S. 80 W

20.00 Set stone 15 + 8 + 6 ins 20  
ins in the ground for  $\frac{1}{16}$   
Sec corner marked  $\frac{1}{16}$  on  
W. face.

from which  
a pine 20 ins diam bears  
N. 45 E 50 lbs. and  
marked  $\frac{1}{16}$  T.B.D.

40

107 400

Collection

Subdivision of T. 2 North R. 35 E.

Willamette Meridian, Oregon.

Sec 5.

(8093-10 M.)

A find 30 in draw bears  
S 35° W 70 lbs dirt  
marked 1/6 T. B. D.

Land <sup>rough</sup> brushy, the N. 10  
chain

Timber & brush on bottom  
Grass and grain on  
foot hills

West of here being so  
brushy

I did not run  
the same

Allotment

41  
461

Subdivision of T. 2 North R. 35 E

Willamette Meridian, Oregon.

24

See 5

From the corner to See's 5-6  
7 and 8. which is a post  
4 ins square firmly set in  
ground marked  
S. 2 N S 5 on N.E.  
N 35 E. S. 8 on S.E.  
S 7 on S.W. & S 6 on N.W. faces  
with 5 notches on S and E edges  
with pits 18 + 18 + 12 ins in each  
See 5 1/2 ft dirt & mound of  
earth 2 ft high 4 1/2 ft base  
around post.

Iron

North on random line  
between See's 5 + 6.

Var 20° 30' E.

Setting temporary 1/32 See cor  
at 2000 chains and at  
4000 Intersect line at 1/4  
See corner between See's  
5 + 6.

42  
462

Allotment

Subdivision of T. 2 North R. 35 E.  
Willamette Meridian, Oregon.

Sec 5

(8093-10 M.)

Thence I run  
South on true line betw  
Secs 5 & 6.

Var 20' E

ascend to

2000

Set a post 3 ft long 3 ins  
square 24 ins in the ground  
for  $\frac{1}{32}$  Sec corner  
marked  $\frac{1}{32}$  S. on W. face  
dug pits 18 x 18 x 12 ins  
N. E. of post 5 1/2 ft. dist. and  
raised a mound of earth  
1 1/2 ft high 3 1/2 ft base around  
post.

4000

To the corner to Secs. 5-6  
7 and 8

Land west slope

Grass sunflower and  
some brush.

Allotment

43  
463

Subdivision of T. 2 North R. 35 E.

Willamette Meridian, Oregon.

25

Sec 5

From  $\frac{1}{16}$  Sec. corner 20 ch  
E of  $\frac{1}{4}$  Sec corner between Secs  
5 & 6.

I run

South on true line in Sec 5

Var  $21^{\circ}$  E

Ascend

400 Fence course E. & W

1000 Set post 4 ft long 3 ins sq.  
with large cone 24 ins in  
the ground for  $\frac{1}{32}$  Sec corner  
marked  $\frac{1}{32}$  S. on W. face  
dry pits 18 + 18 + 12 ins N & S  
of post  $5\frac{1}{2}$  ft. dia, raised  
a mound of earth  $1\frac{1}{2}$  ft  
high  $3\frac{1}{2}$  ft base around  
post

Land rolling

Soil out into

Grass & Sunflowers



44

464

Allotment

Subdivision of T. 2 North R. 35 E.

Willamette Meridian, Oregon.

26

Sec 5

(8093-10 M.)

~~From the  $\frac{1}{32}$  Sec corner 20 ch  
E. and 10 ch S of  $\frac{1}{4}$  Sec  
corner between Sec 5 & 6~~

From

East on random line in  
Sec 5

Var. 18° E.

2000

Intersect at point 40 ch  
N. of  $\frac{1}{32}$  Sec corner 10 ch  
S. of  $\frac{1}{4}$  Sec cor in center  
of Sec 5.

Thence from

N. 88° 51' W on true line  
in Sec 5

1000

Summit corner N.

2000

To the  $\frac{1}{32}$  Sec corner

Grassy slope to North  
~~sunflower~~

Allotment

43

465

Subdivision of T. 2 North R. 33 E

Willamette Meridian, Oregon.

Sec 5

From the  $\frac{1}{32}$  Sec corner 20 ch  
E. and 10 ch S. of  $\frac{1}{4}$  Sec  
corner bet. Secs 5 + 6.

Iron

South on true line on Sec 5

1090 Set a post 3 ft long 3 in  
square 24 in in the ground  
for  $\frac{1}{16}$  Sec corner; marked  $\frac{1}{16}$   
S. on W face dry pits 18 + 18  
+ 12 in N + S of post  $3\frac{1}{2}$  ft  
diam and raised a mound  
of earth  $10\frac{1}{2}$  ft high  $3\frac{1}{2}$  ft  
diam around post

Grassy slope to North  
Sunflowers

46

466

Attachment

Subd. of T. 2 North R. 35 E.

Willamette Meridian, Oregon.

Sec 5.

(8093-10 M.)

From the  $\frac{1}{16}$  Sec corner 20  
chs N of the corner to Secs  
5-6-7 and 8

From

East on random line in  
sec. 5

Var  $21^{\circ}$  E

Setting temporary corner at  
10 chs and at

1990 Intersect the line at  $\frac{1}{16}$   
Sec corner in Sec 5

Thence I run

West on true line Var  $21^{\circ}$  E

995 Set post 3 ins square 3 ft. long  
with charred stake 12 ins in  
the ground for  $\frac{1}{32}$  Sec corner  
marked  $\frac{1}{32}$  I on S. face, day pin  
18 + 18 + 12 ins E & W. of post  
 $5\frac{1}{2}$  ft dirt, raised mound of  
earth  $1\frac{1}{2}$  ft. high  $3\frac{1}{2}$  ft  
low around post.

1500 Summed course N

Allotment

47  
487

Subdividing of T. 2 North R. 35 E.

Willamette Meridian, Oregon.

Sec. 5

1990 To the 1/6 Sec corner between  
Secs. 5 & 6.

Land rolling & mountainous  
Good grass and soil  
1st rate

Some scattering brush

48

468

Allotment

Subdivision of T. 2 North R. 35 E.

Willamette Meridian, Oregon.

See 5

(8093-10 M.)

From the corner to See's

5-6-7+8

From

N. 89° 42' E. on true line  
between Sees 5+8

Var 21' E

1000

See stake 9+8 + 7 in line  
in the ground for  $\frac{1}{32}$  See  
corner marked  $\frac{1}{32}$  on N.  
face. and raised a mound  
of stone over it

Pits impracticable

Dive over brow to June  
west of MountainSoil ~~to~~ rate

Good grass

Allotment

47

Subdiv of T. 2 North R. 35 E. 0

Willamette Meridian, Oregon.

Sec 6

From the  $\frac{1}{4}$  Sec corner  
between Secs. 5 and 6.

Iron

West on true line in Sec 6  
Var  $21^{\circ}$  East

1200 Wire fence course N.

1240 Gulch course N.

1300 Rail fence course N

2099 Set post 3 ft long 3 ins square  
with marked stone 12 ins  
in ground for  $\frac{1}{16}$  Sec corner  
marked  $\frac{1}{16}$  S on N. face; dug  
pits 18 x 18 x 12 ins E. & W. of  
post  $5\frac{1}{2}$  ft dia and raised  
a mound of earth  $1\frac{1}{2}$  ft  
high  $3\frac{1}{2}$  ft base around  
post.

200 chs N. of this corner is a  
fence N.W.  
Land rolling  
Soil 1st rate Good grass

Allotment

Subdiv of T. 2 North R. 35 East

Willamette Meridian, Oregon.

See 6

(8093-10 M.)

From  $\frac{1}{16}$  Sec corner 29 ch  
N. of  $\frac{1}{4}$  Sec corner between  
See 5 + 6.

Iron

North on true line in  
See 6. Var 20° E

1250 Bluff corner E + W +100

1450 Rail Road corner S. 80° W

1850 Spring branch 10 lbs wide  
corner W.

2000 Set post 3 ft long 3 ins square.

24 ins in the ground for  $\frac{1}{16}$

Sec corner marked  $\frac{1}{16}$  S on  
S face. from which

a balun 36 ins diam bears

S 30° W 4 lbs dist marked  $\frac{1}{16}$  S.B.S. <sup>SBT</sup>

a balun 8 ins diam bears N. 20°

E 18 lbs dist marked  $\frac{1}{16}$  S.B.S.

Land rolling to the bluff  
rich bottom & gravelly from  
Bluff N. Grass & grain on  
hill Timber & brush on bottom

51  
Allotment

Subdivision of T. 2 North R. 35 East 471  
Willamette Meridian, Oregon.

See 6.

From the corner to Secs 5-6  
7+8.

From

N. 89° 37' West on random line  
between Secs 6 and 7.

Var 21° E

Setting temporary corner at  
20 chs and at

4000 Intersect the  $\frac{1}{4}$  Sec corner  
between Secs 6 & 7.

which is a stone 16 x 10 x 8  
ins 10 ins in the ground

marked  $\frac{1}{4}$  on N. face  
with pits 18 x 18 x 0.2 ins

E & W of stone 5  $\frac{1}{2}$  ft dia  
and mound of earth 1  $\frac{1}{2}$  ft  
high 3  $\frac{1}{2}$  ft base over it.



52

472

Allotment

Subdivision of T. 2 North R. 35 E

Willamette Meridian, Oregon.

Sec 6.

(8093-10 M.)

650  
2000

Found Iron  
 S. 89° 37' E on true line  
 between Secs 6 & 7 <sup>Var 23° E.</sup>  
 Summit corner N  
 Set Stone 9 x 8 x 7 ins 6 in  
 in the ground for  $\frac{1}{6}$  &  $\frac{1}{32}$   
 Sec corner, marked  $\frac{1}{6}$  on S. &  
 $\frac{1}{32}$  on N. face; dug pits 18 x  
 18 x 12 ins E & W of stone  $5\frac{1}{2}$   
 ft dist. and raised a  
 mound of earth  $1\frac{1}{2}$  ft high  
 $3\frac{1}{4}$  ft base over it.  
 The corner to Secs 5-6-7  
 & 8.

4000

Land unimproved  
 Soil rich on West side  
 of summit. Bal set into  
 Grass

Subdivisions of T. 2 North R. 35 E

Willamette Meridian, Oregon.

See 6

From 1/6 See corner 20 chs  
W of corner to Sees 5-6-7+8  
Draw

North on true line in  
See 6.

Var 22° E

Descend to

1000 Deposited a charred stake  
12 ins in the ground dug pits  
18+18+12 ins N. S. of cor. 5 1/2  
ft dia, and raised a mound  
of earth 1/2 ft high 3 1/2 ft  
low over it See N. pit  
Draw stake 2 ins square  
2 ft long 12 ins in the  
ground marked 1/2 S on S.  
face.

Land brow of Mountain  
to N. Soil 1st rate  
Grass & sunflowers

July 13 1899

5.4

Allotment

Subdiv. of T. 2 North R. 35 E.

Willamette Meridian, Oregon.

Sec 6.

(8093-10 M.)

From the  $\frac{1}{4}$  Sec corner  
between Secs 6 & 7.

I run  
North on true line in  
Sec 6.

Var  $23^{\circ}$  E

10.00 Set stake 16 + 12 + 8 in  
12 in in the ground for  
 $\frac{1}{32}$  Sec corner marked  $\frac{1}{32}$  on  
I fall and raised a  
mound of stone over it  
Pits impracticable

Land brow of Mountains  
to North

Soil 1st rate

Grass and sunflower

Allotment

515  
475

Subdiv of T. 2 North R. 35 E  
Willamette Meridian, Oregon.

Sec 7.

From the  $\frac{1}{4}$  Sec corner bet  
Secs. 6 & 7.

Iron

South on true line in  
Sec. 7.

Var  $23^{\circ}$  E

1000 Gulch corner N.W

2000 Iron stake  $10 \times 8 \times 5$  ins 6 ins  
in the ground for  $\frac{1}{16}$  &  $\frac{1}{32}$  Sec  
corner marked  $\frac{1}{16}$  on N. and  
 $\frac{1}{32}$  on S face dug pits  $18 \times 18$   
 $\times 12$  ins E & W of stake  $5\frac{1}{2}$   
ft dia, and raised a mound  
of earth  $1\frac{1}{2}$  ft high  $3\frac{1}{2}$  ft  
base over it.

2575 Road corner S.W.

3000 Iron stake  $12 \times 9 \times 6$  ins 8 ins  
in the ground for  $\frac{1}{32}$  Sec corner  
marked  $\frac{1}{32}$  on N. face and  
raised a mound of stone

## Allotment

Subdivision of T. 2 North R. 35 E.

Willamette Meridian, Oregon.

See 7.

(8093-10 M.)

over it

It is impracticable to  
 Land rough and steep  
 Soil 1st rate & rocky  
 Grass and scattering  
 brush

From the 1/32 Sec corner 30 ch  
 South of 1/4 Sec corner between  
 Sec 6 & 7.

From

West on true line in  
 Sec 7.

Var 23° E

1300 Road corner NE.

1600 Summit corner NE

2000 Set stone 10 x 8 x 6 in

6 in in the ground for 1/32  
 Sec corner; marked 1/32  
 on N face

allotment

57  
477

Subdivision of T. 2 North R. 35 East  
Willamette Meridian, Oregon.

See 7.

dry pits 18 + 18 x 12 ins  
E & W of stone. 5 1/2 ft. dirt  
and raised a mound of  
earth 1 1/2 ft high 3 1/2 ft base  
over it.

Land rough & steep  
Soil not rate  
Grass & brush

From the 1/32 See corner 30 ch  
I. 20 ch W of 1/4 See corner  
between Secs. 6 and 7  
in the center of See 7.

Thence from

North in true line in See 7  
Var 23° E.

940 Ravine corner W

1000 Set stone 15 + 10 + 8 ins 10 ins  
in the ground for 1/32 See  
corner marked 1/32 on W  
face

58

478

Allotment

Subdiv. of T. 2 North R. 35 East

Willamette Meridian, Oregon.

See 7.

(8093-10 M.)

and varied a mound of  
stone over it

Pis impracticable

Thence I run

East on random line

in See 7.

Var 23° E

20.10 Intersect the N + S line  
8 chs N. of  $\frac{1}{16} + \frac{1}{32}$  See corner  
20 chs S. of  $\frac{1}{4}$  See corner  
bet. Sees 6 + 7

Thence I run

N 89° 46' W. on true line

in See 7. Var 22° O

20.10 To the  $\frac{1}{32}$  See corner

Land unimproved

Soil rocky and 1<sup>st</sup> rate

Grass


Allotment

59  
479

Subdiv. of T. 2 North R. 35 E.

Willamette Meridian, Oregon.

From the  $\frac{1}{4}$  Sec corner between  
Secs 7 and 8. which is a  
basalt stone  $26 \times 8 \times 8$  ins  
20 ins in the ground marked  
 $\frac{1}{4}$  on W face and mound  
of stone over it

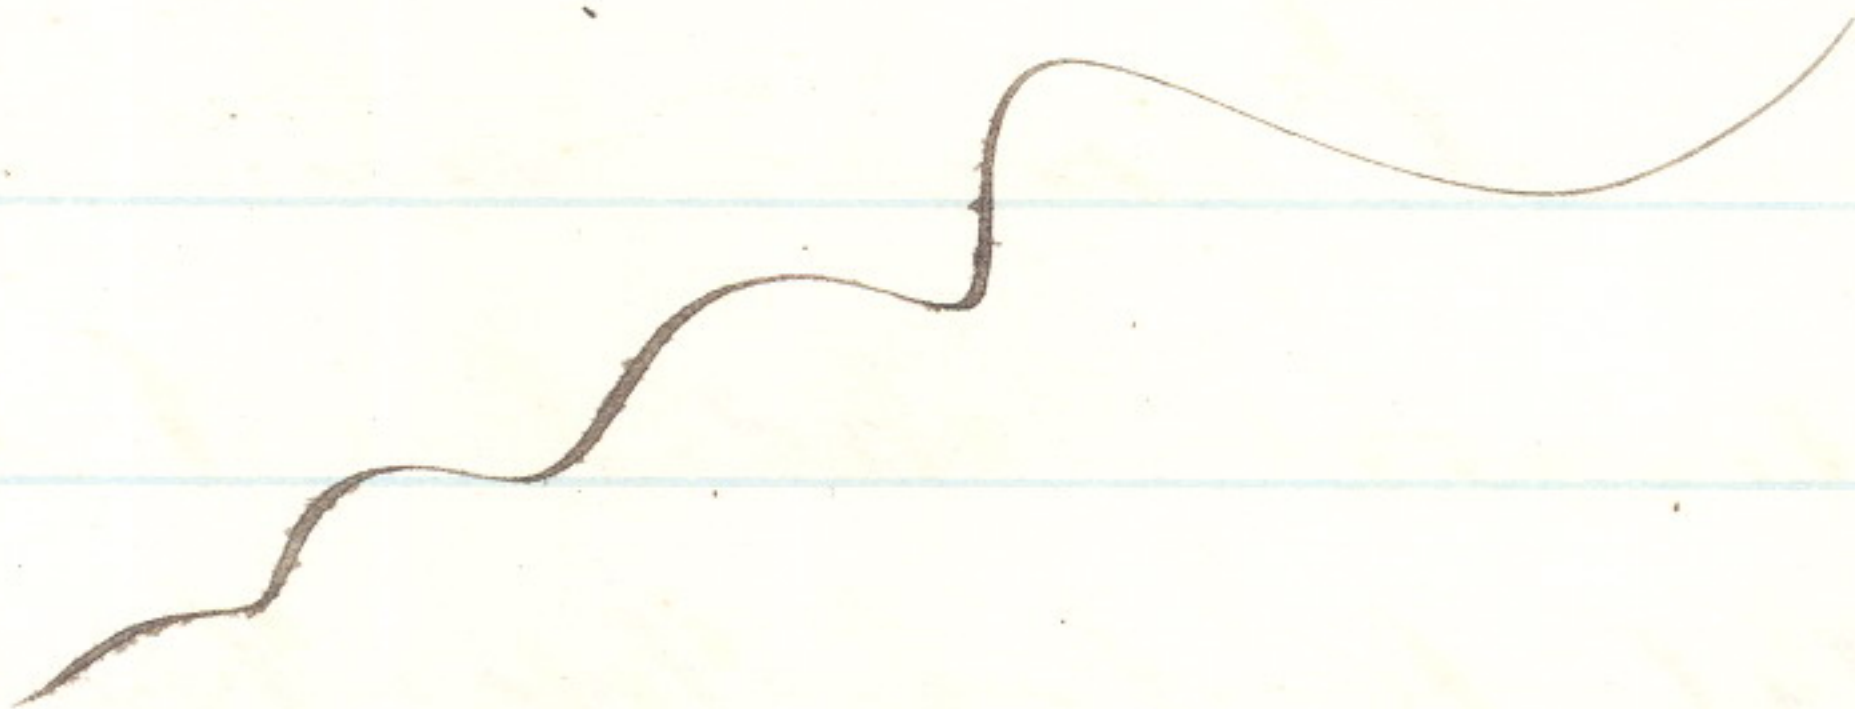

Stone from

North on a random line  
between Secs 7 & 8

Var 19" East

Setting temporary corners at  
every 10 & 20 chains and at

4000 Intersect the corner to Secs  
5-6-7 and 8.

Stone from



60

480

Allotment

Subdivisions of T. 2 North R. 35 E

Willamette Meridian, Oregon.

Sec 7.

(8093-10 M.)

South on true line between  
Secs 7 and 8

Var 21° E

875

Road corner NE & SW

2000

Set stone 15 + 10 + 7 ins 10  
ins in the ground for  $\frac{1}{16}$  +  $\frac{1}{32}$   
Sec corner marked  $\frac{1}{16}$  on N. &  
 $\frac{1}{32}$  on S. face, and raised  
a mound of stone over it  
Pits impracticable

2500

Summit

3000

Set basalt stone 16 + 10 + 8 ins  
10 ins in the ground for  $\frac{1}{32}$   
Sec corner, marked  $\frac{1}{32}$  on N. face  
and raised mound of stone  
over it.

Pits impracticable

4000

To the  $\frac{1}{4}$  Sec corner bet. Secs  
7 and 8

Land mostly rocky.  
the soil is not rate on parts  
Grass & Sunflowers

Attainment

481

61

Subdivisions of T. 2 North R. 35 E

Willamette Meridian, Oregon.

Sec 7.

From the  $\frac{1}{16}$  Sec corner 20 ch  
S. of  $\frac{1}{4}$  Sec corner bet. Secs  
6 + 7.

From  
East on random line in  
Sec 7.

Var 22° E.

Setting temporary corner at  
20 chains and at

40.00 Intersect N. + S line at  $\frac{1}{16}$   
Sec corner between <sup>Secs</sup> 7 + 8.

Thence I run

West on true line in Sec 7.

Var 19° E.

20.00 Set baroll stand 12 + 9 + 7 ins  
8 ins in the ground for  $\frac{1}{16}$  +  
 $\frac{1}{32}$  Sec corner, marked  $\frac{1}{16}$  on  
on N. and  $\frac{1}{32}$  on S face  
dug pits 18 + 18 + 12 ins E + W  
of stone 5  $\frac{1}{2}$  ft dist

62

489

allotment

Subdivision of T. 2 North R. 35 E.

Willamette Meridian, Oregon.

Feb 7.

(8093 10 M.)

and raised a mound of earth 1 1/2 ft high 3 1/2 ft base covered.

40.00

To the 1st Feb survey

Land rolling  
Soil 1st & 2d rate  
Good grass

Allotment

63

483

Subdivision of T. 2 North R. 35 East

Willamette Meridian, Oregon.

Sec 7.

From the  $\frac{1}{32}$  Sec corner  
30 chs S. of  $\frac{1}{4}$  Sec corner  
between Secs 6 & 7.

From  
East on random line  
to Sec 7.

Var.  $22^{\circ}$  East

Setting temporary corner at  
20 chs and at

4.0.00 Intersect N & S line at  
 $\frac{1}{32}$  Sec corner 10 chs N. of  
 $\frac{1}{4}$  <sup>Sec.</sup> corner bet. Secs 7 & 8

Thence from

West on true line in Sec 7.

Var  $19^{\circ}$  E.

2000 Set stone  $14 \times 10 \times 7$  ins  
10 ins in the ground for  
 $\frac{1}{32}$  Sec corner marked  $\frac{1}{32}$   
on N face, and raised  
a mound of stone round

64

484

Allotment

Subdiv of T. 2 North R. 35 E

Willamette Meridian, Oregon.

Sec 7.

(8093-10 M.)

4000 It is impracticable  
 To the  $\frac{1}{32}$  Sec corner 30 ch  
 South of  $\frac{1}{4}$  Sec corner bet.  
 Sec. 6 & 7.

Land rolling

Soil test rate

Grass & sunflower

June 13<sup>th</sup> 1889

66

486

of T.

R.

Willamette Meridian, Oregon.

(8093-10 M.)

## General Description

New lands are on South side of Umatilla River and are rolling and somewhat broken. Sloping to North. Soil generally 1<sup>st</sup> rate rocky in places.

Good brush grass sand brush and fine timber

Attachment

Subdivision of T. 2 North R. 3 E. Cont. 487  
Willamette Meridian, Oregon.

In accordance with the requirements of the Manual of surveys I have carefully tested the adjustment of my instrument by taking the Latitude daily weather permitting during the progress of the surveys represented by the foregoing field notes and in all cases the instrument was found in correct adjustment

James P. Currier  
U.S. Deputy Surveyor

490

### FINAL OATHS FOR SURVEYS.

A list of the names of the individuals employed by James P. Currier, U. S. Deputy Surveyor, to assist in running, measuring and marking the lines and corners described in the foregoing field notes of the survey of the subdivisional and allotment lines of T. 2 N. R. 35 E. Willamette Meridian, Oregon, showing the respective capacities in which they acted:

- ....., **Compassman.**
- J. R. Saramore, **Chainman.**
- J. L. Brown, **Chainman.**
- ....., **Chainman.**
- ....., **Chainman.**
- C. M. Stone, **Axeman.**
- R. E. Long, **Axeman.**
- ....., **Flagman.**

### FINAL OATHS OF ASSISTANTS.

We hereby certify that we assisted James P. Currier, U. S. Deputy Surveyor, in surveying all those parts or portions of the subdivisional and allotment lines of T. 2 N. R. 35 E. Willamette Meridian, Oregon, as are represented in the foregoing field notes as having been surveyed by him and under his direction; and that said survey has been in all respects, to the best of our knowledge and belief, well and faithfully surveyed, and the corner monuments established, according to the instructions furnished by the U. S. Surveyor General of Oregon.

- ....., **Compassman.**
- J. R. Saramore, **Chainman.**
- J. L. Brown, **Chainman.**
- ....., **Chainman.**
- ....., **Chainman.**
- C. M. Stone, **Axeman.**
- R. E. Long, **Axeman.**
- ....., **Flagman.**

Subscribed and sworn to before me, this 2nd day of

July 1889  
Thos. Fitzherald  
 Notary Public

[SEAL.]



FINAL OATH OF DEPUTY SURVEYOR.

I, James P. Currier  
United States Deputy Surveyor, do solemnly swear that in pursuance of

instructions received from Douglas M. Taylor

U. S. Surveyor General for Oregon, bearing date of the 19th

day of March 1889, I have well, faithfully and truly, in my own proper person, and in strict conformity with the instructions furnished by the U. S. Surveyor General for Oregon, the Surveying Manual, and the laws of the United States, surveying all those

parts or portions of Subdivisional Settlement  
Lines of T. 2 N. R. 35 E.

Willamette Meridian, in the State of Oregon, as are represented in the foregoing field notes as having been surveyed by me and under my directions; and I do further solemnly swear that all the corners of said survey have been established and perpetuated in strict accordance with the Surveying Manual, printed instructions, the special written instructions of the U. S. Surveyor General for Oregon, and in the specific manner described in the field notes, and that the foregoing are the true field notes of such survey, and should any fraud be detected I will suffer the penalty of perjury under the provisions of an Act of Congress approved August 8, 1846.

James P. Currier  
U. S. Deputy Surveyor.

Subscribed and sworn to before me, this 2nd

day of July 1889

Geo FitzGerald  
Notary Public

Office U. S. Surveyor General,

Portland, Oregon, *September 14<sup>th</sup> 1889*

The following <sup>*following*</sup> Field Notes of the Survey of the

*Subdivision and Allotment*

*Lines of Township 2 North*

*Range 35 E. Willamette Oregon*

executed by *James J. Cassin U.S.*  
*Deputy Surveyor*

under his Contract No. *537*, dated *March*

*5<sup>th</sup>* 1889, having been critically examined, the

necessary corrections and explanations made, the said Field Notes

and the survey they describe, are hereby approved.

*Douglas W. Taylor*

Surveyor General.