

## FIELD NOTES

Of the survey of the

*Exteriors*Lines of *Tps. 1, 2, 100**R's 31, 33, 34 & 35, E. Tps. 2, 3, 4, 35* Willamette Meridian, Oregon,as surveyed by *James P. Currier and James E. Poland*  
*their special*

U. S. Deputy Surveyor, under his Contract No. \_\_\_\_\_

dated *May 4<sup>th</sup>*, 1887Survey commenced, *June 14<sup>th</sup>*, 1887Survey completed, *Aug 30<sup>th</sup>*, 1887

## NAMES AND DUTIES OF ASSISTANTS.

*L. J. Wooley* ..... , Compassman.  
*J. Medley* ..... , Chainman.  
*W. H. Medley* ..... , Chainman.  
*Guy Davis* ..... , Chainman.  
*Frank Selshard* ..... , Chainman.  
*J. P. Crowner* ..... , Axman.  
*J. A. Hadley* ..... , Axman.  
..... , Flagman.

PRELIMINARY OATHS OF ASSISTANTS.

36 We, J. S. Medley, W. H. Medley, Frank Behshaw  
and Guy Davis

do solemnly swear that we will faithfully execute the duties of Chain Carriers; that we will level the chain over even and uneven ground, and plumb the tally pins, either by sticking or dropping the same; that we will report the true distance to all notable objects, and the true length of all lines that we will assist in measuring, to the best of our skill and ability, and in accordance with the instructions given us in the survey

of the Exterior lines of Twp. 10, R. 32, 33 & 34 E. Twp. 21, R. 33 & 35 E. Twp. 1 lines of A. R. 32, 33, 34 & 35 E. Twp. 21, R. 32, 34 & 35 E. Willamette Meridian, Oregon.

J. S. Medley, Chainman.  
W. H. Medley, Chainman.  
Frank Behshaw, Chainman.  
Guy Davis, Chainman.

Subscribed and sworn to before me this 14th day of June, 1887

[SEAL.] James P. Currier  
U.S. Deputy Surveyor

We, B. B. Crowner and J. R. Haddley, do solemnly swear that we will well and truly perform the duties of Axmen in the establishment of corners and other duties, according to instructions given us, and to the best of our skill and ability, in the survey of the

Exterior lines, Twp. 10, R. 32, 33 & 34 E. Twp. 21, R. 33 & 35 E. Twp. 1 R. 32, 33, 34 & 35 E. Willamette Meridian, Oregon.

B. B. Crowner, Axman.  
J. R. Haddley, Axman.

Subscribed and sworn to before me this 14th day of June, 1887


[SEAL.] James P. Currier  
U.S. Deputy Surveyor

# INDEX

365

Referring the Lines to the Pages of the Field Notes.

T. *2 South* R. *33 East* Will. Mer.

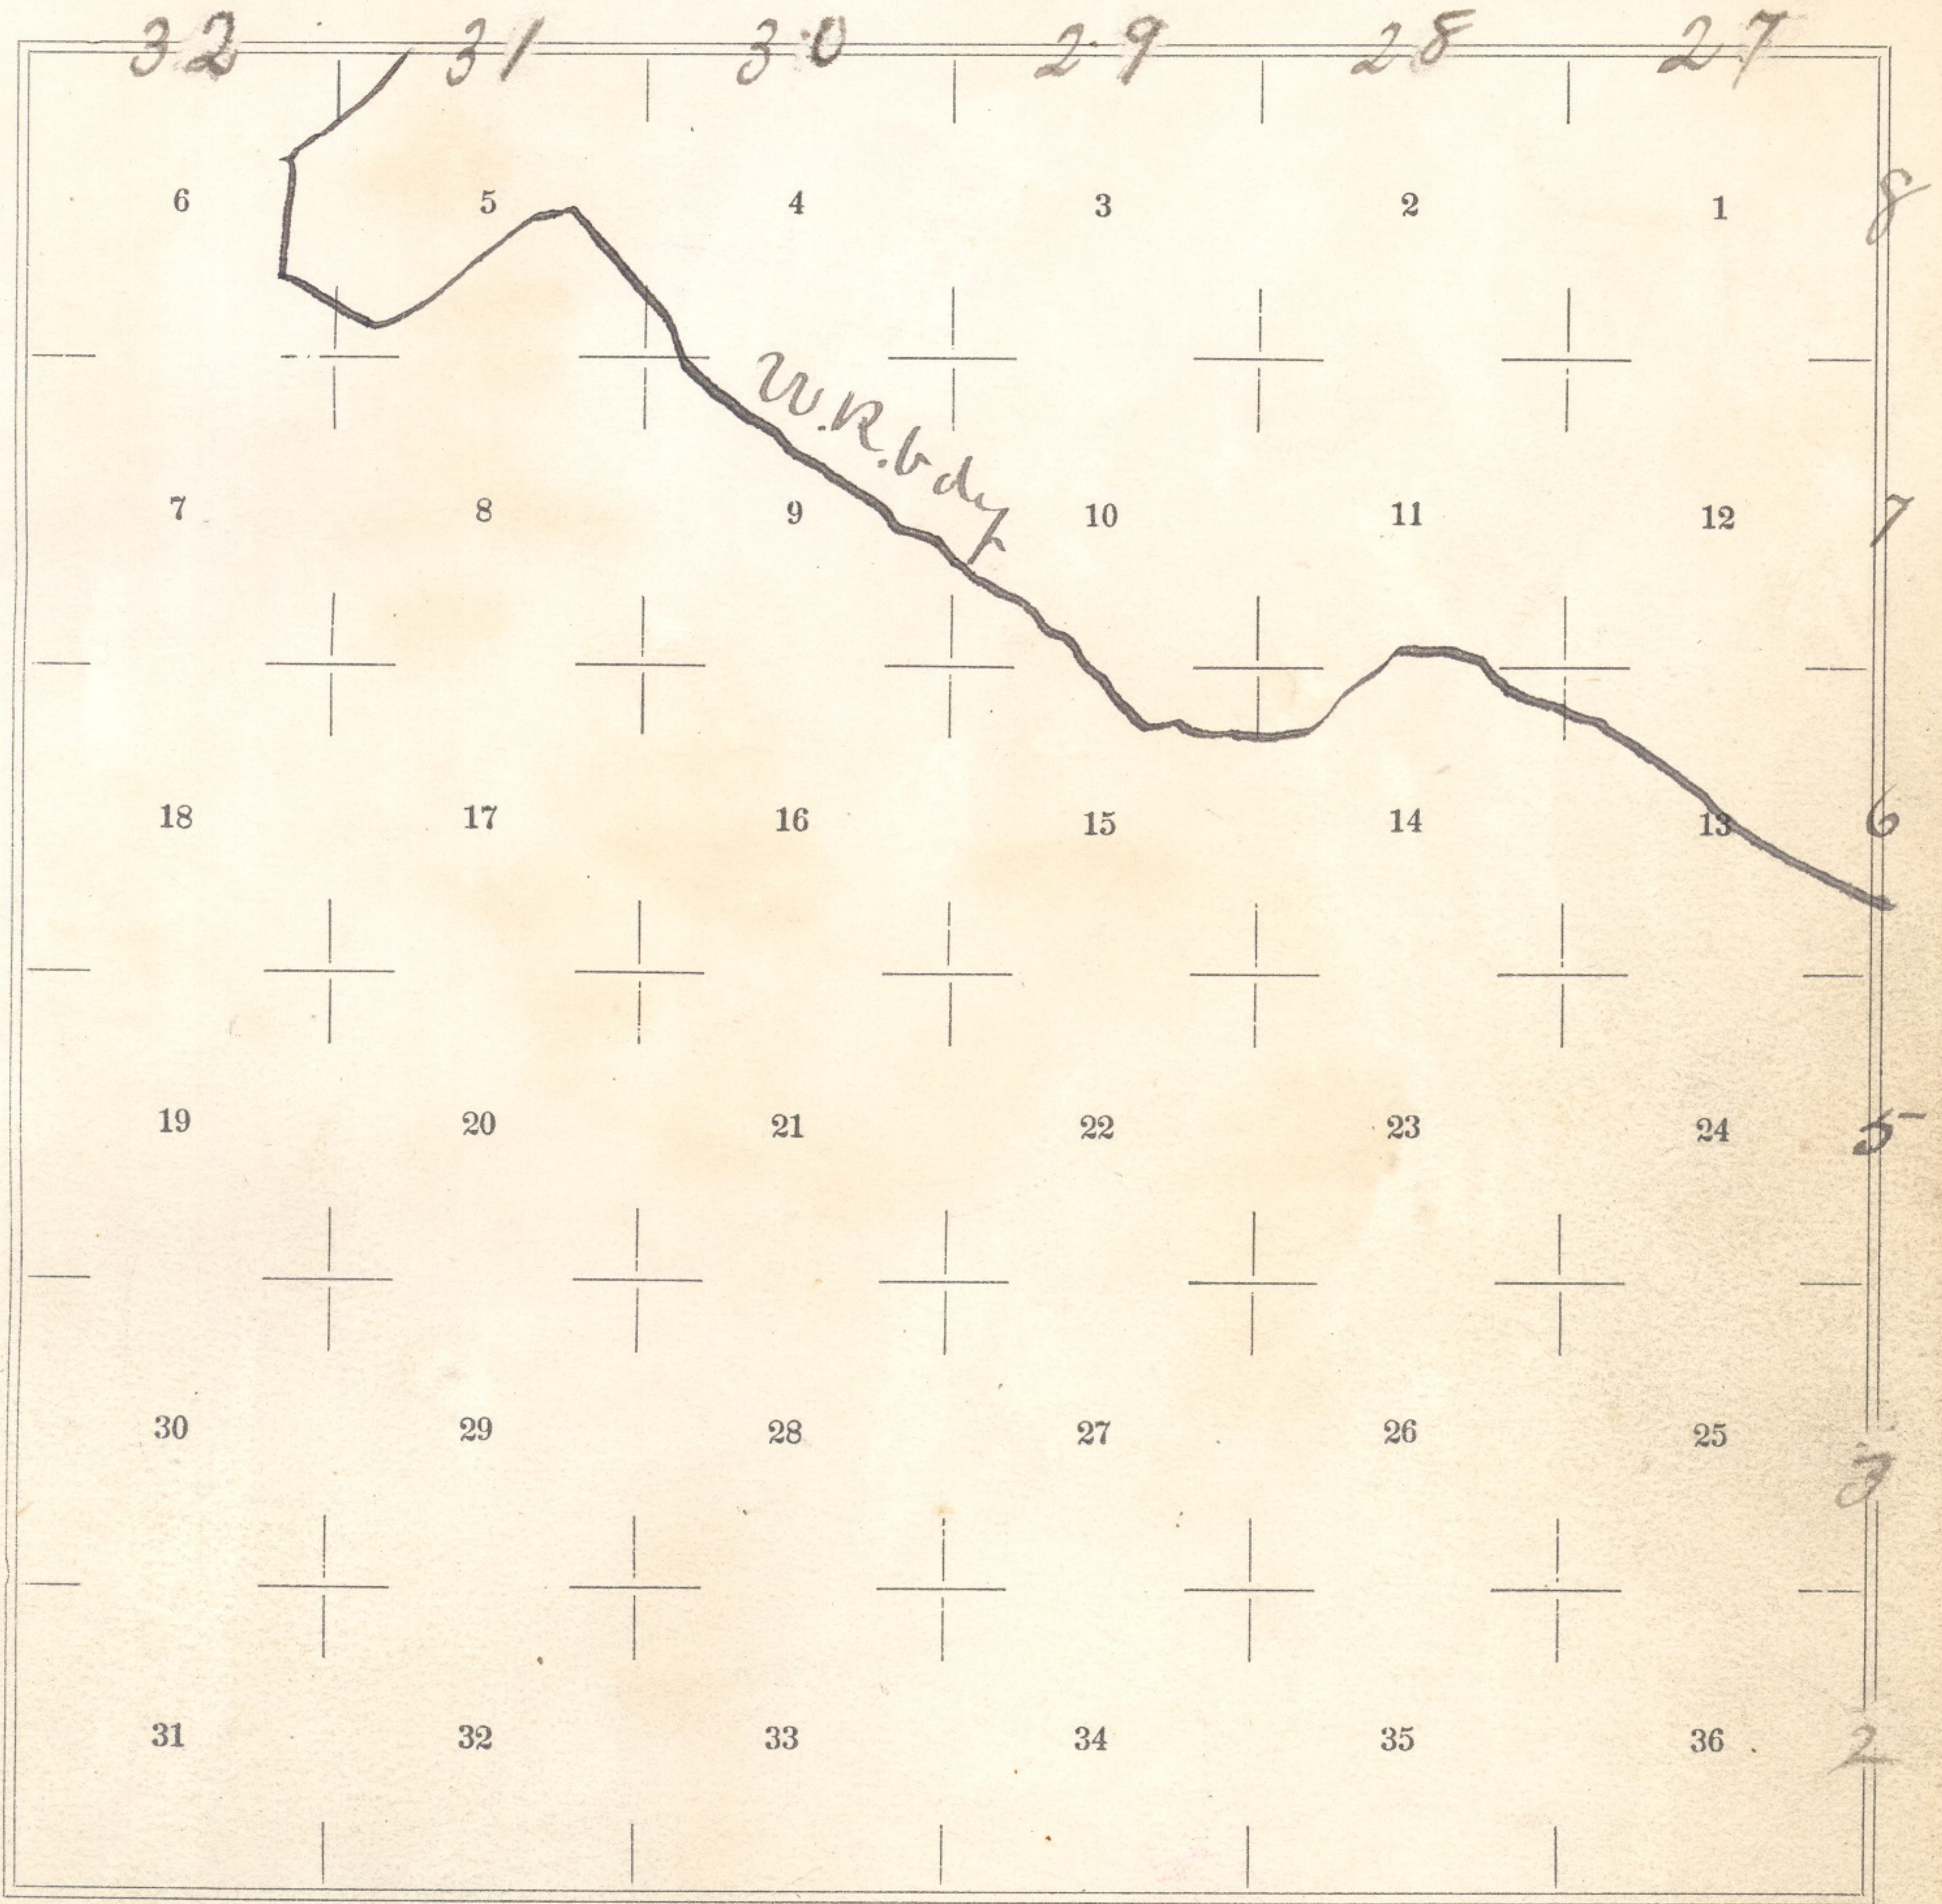

Meanders of \_\_\_\_\_, Pages \_\_\_\_\_ to \_\_\_\_\_

Meanders of \_\_\_\_\_, Pages \_\_\_\_\_ to \_\_\_\_\_

366 ~~367~~ ~~368~~ ~~369~~ ~~370~~

# INDEX

Referring the Lines to the Pages of the Field Notes.

T. 1 South R. 34 East Will. Mer.

40	6	5	4	3	2	1	23
38	7	8	9	10	11	12	22
37	18	17	16	15	14	13	20
36	19	20	21	22	23	24	19
35	30	29	28	27	26	25	18
34	31	32	33	34	35	36	17 31
	16	15	14	13	12	11	25

Sp. 1 S. R. 35 E

Meanders of \_\_\_\_\_ Pages \_\_\_\_\_ to \_\_\_\_\_

Meanders of \_\_\_\_\_ Pages \_\_\_\_\_ to \_\_\_\_\_

T28 35 E 6

2 372

Extremities of T. 2 South R. 33 East

Willamette Meridian, Oregon.

(8093-10 M.)

bet Secs. 31 + 36

Var 15° E

2.50 Leave timber, enter prairie

19.50 Wagon road course S. E

32.80 Intersected U. R. R. by 4.94 chs.

N. of 6 7/2 M. post. Set a basalt

stone 12 x 10 x 10 ins 8 ins in the ground

marked N. R. C. C. for closing cor

on Tp line. Raised a mound

of stone alongside pits impracticable

33.00 Enter dense underbrush

40.00 A spruce 8 ins in diam. whi-

ch I marked 1/4 S. W. N face for

1/4 Sec. cor. from which a spruce

8 ins in diam. to S 80° E 13

chs. dist. marked 1/4 S. B. T. A spruce

6 ins in diam. to S 85° W 19 chs.

dist. marked 1/4 S. B. T.

80.00 Set a basalt-stone 12 x 10 x 8 ins

Extensions of T. 2 South R. 33 East -  
Willamette Meridian, Oregon.

8 ins in the ground for cor to Sec.  
 25, 30, 31 + 36 marked 1 notch on  
 S + 5 on N. Edges From which  
 A Pine 12 ins in diam to N 20° E  
 133 lks dist. Marked T. 2 S R 34  
 E. S 30 B.T. A Fir 14 ins in diam  
 to S 52° E. 35 lks. dist - Wkd S 31 B.T.  
 A Pine 16 ins in diam to S 42° W 62  
 lks. dist. Wkd. R. 33 E. S 36 B.T. A  
 pine 20 ins in diam. to N 85° W. 96  
 lks. dist - Wkd S. 25° B.T.

Land Raising

Said 2nd rate

Timber. Pine Fir + Tamarack with  
 dense under brush + fallen timber  
 or of the same 49.50 cho

North lot - Secs. 25 + 30

Var. 23° 35' E

4.00 Wagon road Course S.W

4 374

Extrors of T. 2 Smith R. 33 East-  
Willamette Meridian, Oregon.

(8093-10 M.)

- 4000 Set a post-36x3x3 ins 2 ft-in  
The ground for 1/4 sec. cor. marked  
1/4 S. on N. face from which a pine  
16 ins in diam. ls. S 56° E 2 lks. dist-  
wtd. 1/4 S. B.T. C. Pine 20 ins in diam  
ls. N. 70° W. 32 lks. dist- wtd 1/4 S. B.T.
- 6850 Cannon + Wagon road - N - 600 - 65
- 6900 Head waters of Birch creek  
water in holes. Leave timber stand
- 8000 Set a basal-stone 12x10x6 ins,  
8 ins in The ground for cor W  
secs. 19, 24, 25 + 30 Marked 2 holes  
chs on S + 4 on N Edges +100 + 100  
Raised a mound of stone around it  
pts impracticable  
Land rolling + mountainous  
timber dense Pine, fir + Tamarack  
with underbrush 69.00 chs.  
Soil 3rd rate  
Mountainous 11.00 chs

Extiriors of T. 2 South R. 33 East-  
Willamette Meridian, Oregon.

chs.

North bet. Secs 19 & 24

Var 19° 20' E

8.00	Top of ridge Course S. W.	+500
18.00	Canon " " "	-300
30.00	Top of Ridge " W	+400
40.00	Set a basalt-stone 10x8x7 ins 7 ins in the ground for 1/4 Sec. cor marked 1/4 S on W face. From which a fir 20 ins in diam to N 25° E 42 chs dist - marked 1/4 S. B. D no other tree in limits raised a mound of stone alongside +900	
52.25	Canon Course S. W.	-600
68.00	Top of Ridge " "	+1000
80.00	Set a basalt-stone 12x9x7 ins 8 ins in the ground for cor. To Secs 13, 18, 19 & 24 marked 3 notches on N & S. Edges. Raised mound of stone alongside. Pits imprac- ticable	



376

Extensions of T. 2 South R. 33 East -  
Willamette Meridian, Oregon.

(8093-10 M.)

Land broken + mountainous 80.000  
Soil rocky with quite  
very little grass  
Scattering pine timber in Canons

North bet Secs 13 + 18  
Var  $\pm 2^{\circ} 30' E$

2117	Summit of divide between McKay + Birch creeks wagon Road course N.W.	+1000	+1000
3300	Ravine Course E	-100	-100
4000	Set a basalt-stone 9x8x7 ins 6 ins in the ground for 1/4 Sec. cor Marked 1/4 on W face Raised mound of stone alongside. Pits impracticable		
5100	Canon Course E	-175	-175
7200	" " "	-350	-350
8000	Set a basalt-stone 14x10x10 ins		

Extensions of T. 1 South R. 33 East  
Willamette Meridian, Oregon.

West-arc line bet- Secs. 5 & 32  
Var 22° E

24.75 Head of Canan Course A -100

36.00 Summit - +100

40.00 Set a basalt-stone 14x10x8 in 9 in  
in the ground for 1/4 Sec. Cor mtd  
1/4 an N. face. Raised end of stone  
along side P is impractical

50.00 Canan Course A -100

70.00 Summit of divide bet- McKay  
& Stewart - Creeks +300

Intersect-U. R. Rd 17.66 chs A 43°  
30' E. of 78th Mile Cor. and at  
17th A cor. which is a stone 10x  
10x10 in 7 in in the ground mtd U. R.  
A C. C. in a mound of stone

80.00 Set a basalt-stone 16x12x8 in 11  
in in the ground for cor. To sec. 5  
& 31 & 32. Mtd 5' north on E + 4 in  
N edge. Raised mound of stone  
along side P is impractical -50

# FINAL OATHS FOR SURVEYS.

A list of the names of the individuals employed by James P. Currier  
and James E. Holland, U. S. Deputy Surveyors, to assist in  
 running, measuring, and marking the lines and corners described in the  
 foregoing field notes of the survey of the Exterior lines of Tps. 1, 2,  
Rs. 32, 33, 34 E, Tps. 2, 1, R. lines of 33, 35 E, Tps. 1, 4, Rs. 32, 33, 34, 35 E  
Tps. 2, 1, Rs. 32, 34, 35 E Willamette Meridian, Oregon,  
 showing the respective capacities in which they acted:

- L. A. Wooley ..... , Compassman.
- J. J. Medley ..... , Chainman.
- W. H. Medley ..... , Chainman.
- Frank Belshaw ..... , Chainman.
- Guy Davis ..... , Chainman.
- B. B. Crowner ..... , Axman.
- J. R. Hadley ..... , Axman.
- ..... , Flagman.

## FINAL OATHS OF ASSISTANTS.

We hereby certify that we assisted James P. Currier and James  
E. Holland, U. S. Deputy Surveyors, in surveying  
 all those parts or portions of the Exterior lines of Tps. 1, 2, Rs. 32, 33, 34 E  
Tps. 2, 1, Rs. 33, 35 E, Tps. 1, 4, Rs. 32, 33, of 34, 35 E, Tps. 2, 1, Rs.  
3, 2, 34, 35 E Willamette Meridian, Oregon,  
 as represented in the foregoing field notes as having been surveyed by  
 him and under his direction; and that said survey has been in all respects,  
 to the best of our knowledge and belief, well and faithfully surveyed,  
 and the corner monuments established, according to the instructions  
 furnished by the U. S. Surveyor General of Oregon.

- L. A. Wooley ..... , Compassman.
- J. J. Medley ..... , Chainman.
- W. H. Medley ..... , Chainman.
- Frank Belshaw ..... , Chainman.
- Guy Davis ..... , Chainman.
- B. B. Crowner ..... , Axman.
- J. R. Hadley ..... , Axman.
- ..... , Flagman.

Subscribed and sworn to before me this 30<sup>th</sup> day of

September, 1887.

[SEAL.]

James P. Currier  
 U. S. Deputy Surveyor.

## FINAL OATH OF DEPUTY SURVEYOR.

We, James P. Currier and James E. Poland, United States  
Deputy Surveyor, do solemnly swear that in pursuance of instructions  
received from Douglas H. Taylor, U. S.

Surveyor General for Oregon, bearing date of the 13<sup>th</sup>

day of May, 1887, I have well, faithfully,  
and truly, in my own proper person, and in strict conformity with the  
instructions furnished by the U. S. Surveyor General for Oregon, the  
Surveying Manual, and the laws of the United States, surveying all

those parts or portions of Exterior lines of Twp. 10, R. 32, 33 & 34 E, Twp.

2 N, R. 33 & 35 E, Twp. 1 N, R. 32, 33, 34 & 35 E, Twp. 2 N, R. 32, 34 & 35 E

Willamette Meridian, in the State of Oregon, as are represented in the  
foregoing field notes as having been surveyed by me and under my  
directions; and I do further solemnly swear that all the corners of said  
survey have been established and perpetuated in strict accordance with  
the Surveying Manual, printed instructions, the special written instruc-  
tions of the U. S. Surveyor General for Oregon, and in the specific man-  
ner described in the field notes, and that the foregoing are the *true* field  
notes of such survey, and should any fraud be detected I will suffer the  
penalty of perjury under the provisions of an act of Congress approved  
August 8, 1846.

James P. Currier James E. Poland  
U. S. Deputy Surveyors

Subscribed and sworn to before me this Fifteenth  
day of February, 1888

W. Woodcock  
Notary Public  
for Oregon

## Office of U. S. Surveyor General,

Portland, Oregon, June - 11<sup>th</sup>/<sub>4</sub>, 1888.*foregoing*

The following Field Notes of the Survey of the

Eastern lines of T. 1 S. Rgs 32.

34. E. T. 2 S. Rgs 33 and 35

T. 1 N. Rgs 32-33-34 and 35 East

T. 2 N. Rgs 32-34 and 35 East

Will. Mel. Or.

executed by James J. Currier and James E. Noel

Special Joint U. S. Dept. Surveyors

under his Contract No. —, dated May

4<sup>th</sup>, 1887, having been critically examined,

the necessary corrections and explanations made, the

said Field Notes and the survey they describe, are

hereby approved.

Douglas W. Taylor

Surveyor General.