

Bk 280

FIELD NOTES

Of the survey of the Estevan

Lines of Townships 3.4+5 S. Rg 38 1/2 T 34 E.

Town 3 S. R. 33 E of, Willamette Meridian,
and part of 1st Standard Parallel South

U. S. Deputy Surveyor, under his Contract No. 451

dated June 28 ~~28~~ 12th, 1882

Survey commenced, October 12th, 1882

Survey completed, November 11th, 1882

NAMES AND DUTIES OF ASSISTANTS.

Rufus Snow, Compassman.

James Cuttidge, Chainman.

John Cuttidge, Chainman.


_____, Chainman.

_____, Chainman.

Joe Proodi, Axeman.

_____, Axeman.

_____, Flagman.

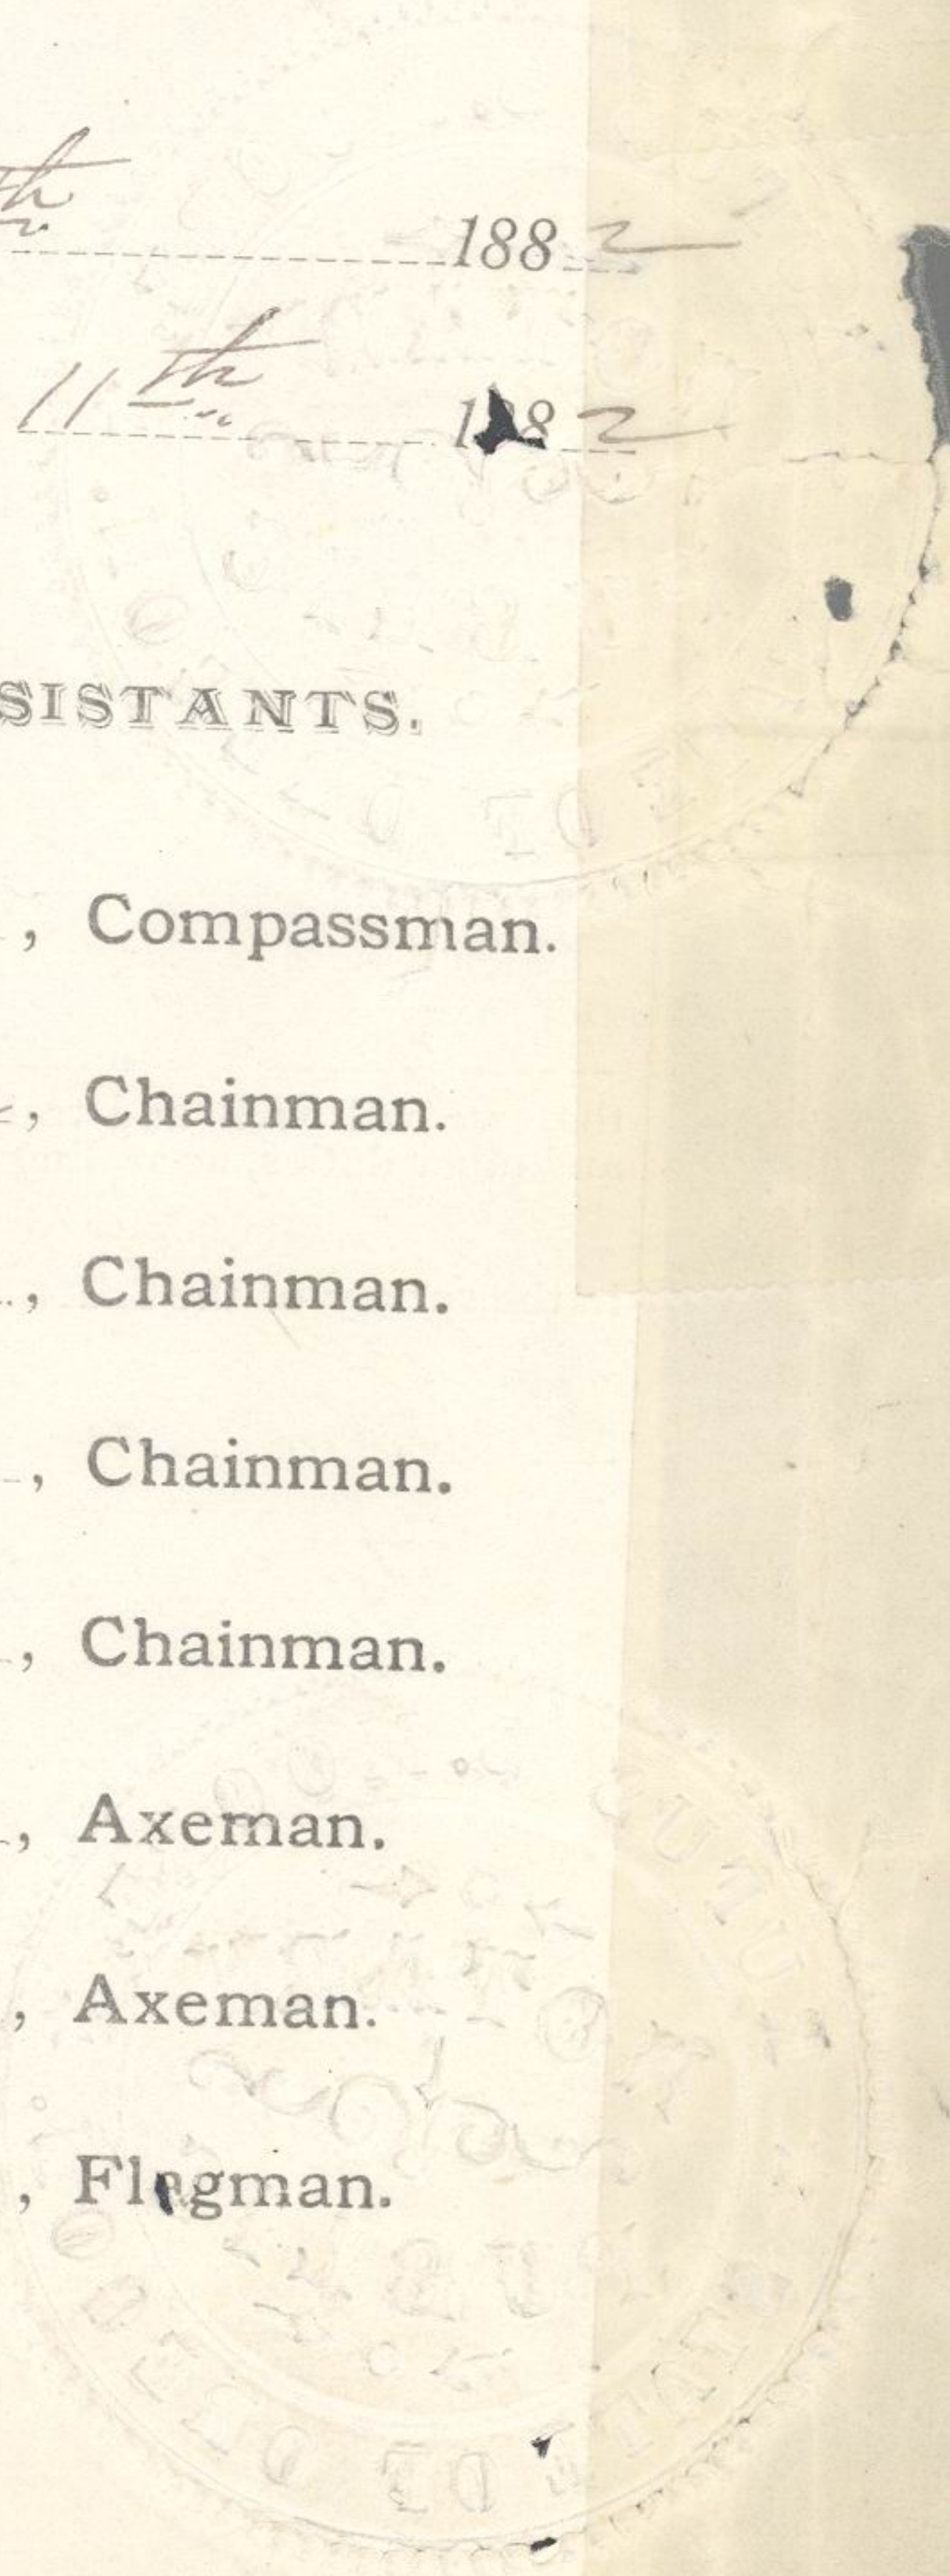

184

PRELIMINARY OATHS OF ASSISTANTS:

We, James Guttridge and
John Guttridge

do solemnly swear that we will faithfully execute the duties of Chain Carriers, that we will level the chain over even and uneven ground, and plumb the tally pins, either by sticking or dropping the same; that we will report the true distance to all notable objects, and the true length of all lines that we will assist in measuring, to the best of our skill and ability, and in accordance with the instructions given us in

the survey of the Exterior lines of Townships 3.4 + 5 South

R. 33 1/2 E + R. 34 E and T. 3. S R 33 E and part of 1st Standard
Parallel S. through R. 34. E Willamette Meridian, Oregon.

James Guttridge, Chainman.
John Guttridge, Chainman.
_____, Chainman.
_____, Chainman.

Subscribed and sworn to before me, this Fifteenth
day of August 1882

[SEAL.]

Rufus S. Moore
Notary Public

Joe Parodi and

_____, do solemnly swear that we will well and truly perform the duties of Axemen in the establishment of corners and other duties, according to instructions given us, and to the best of our skill and ability,

in the survey of the Exterior of Twp 3.4 + 5 S. Rg 34 E + 38 R 33 E +
Ts 3.4 + 5 S R 33 1/2 E
part of 1st Stand-par. through R 34 E Willamette Meridian, Oregon.

Joe Parodi, Axeman.
_____, Axeman.


Subscribed and sworn to before me, this Fifteenth
day of August 1882

[SEAL.]

Rufus S. Moore
Notary Public

Inches
referring the lines to page
in field notes

Diagram of T. 3 South R. 33 East

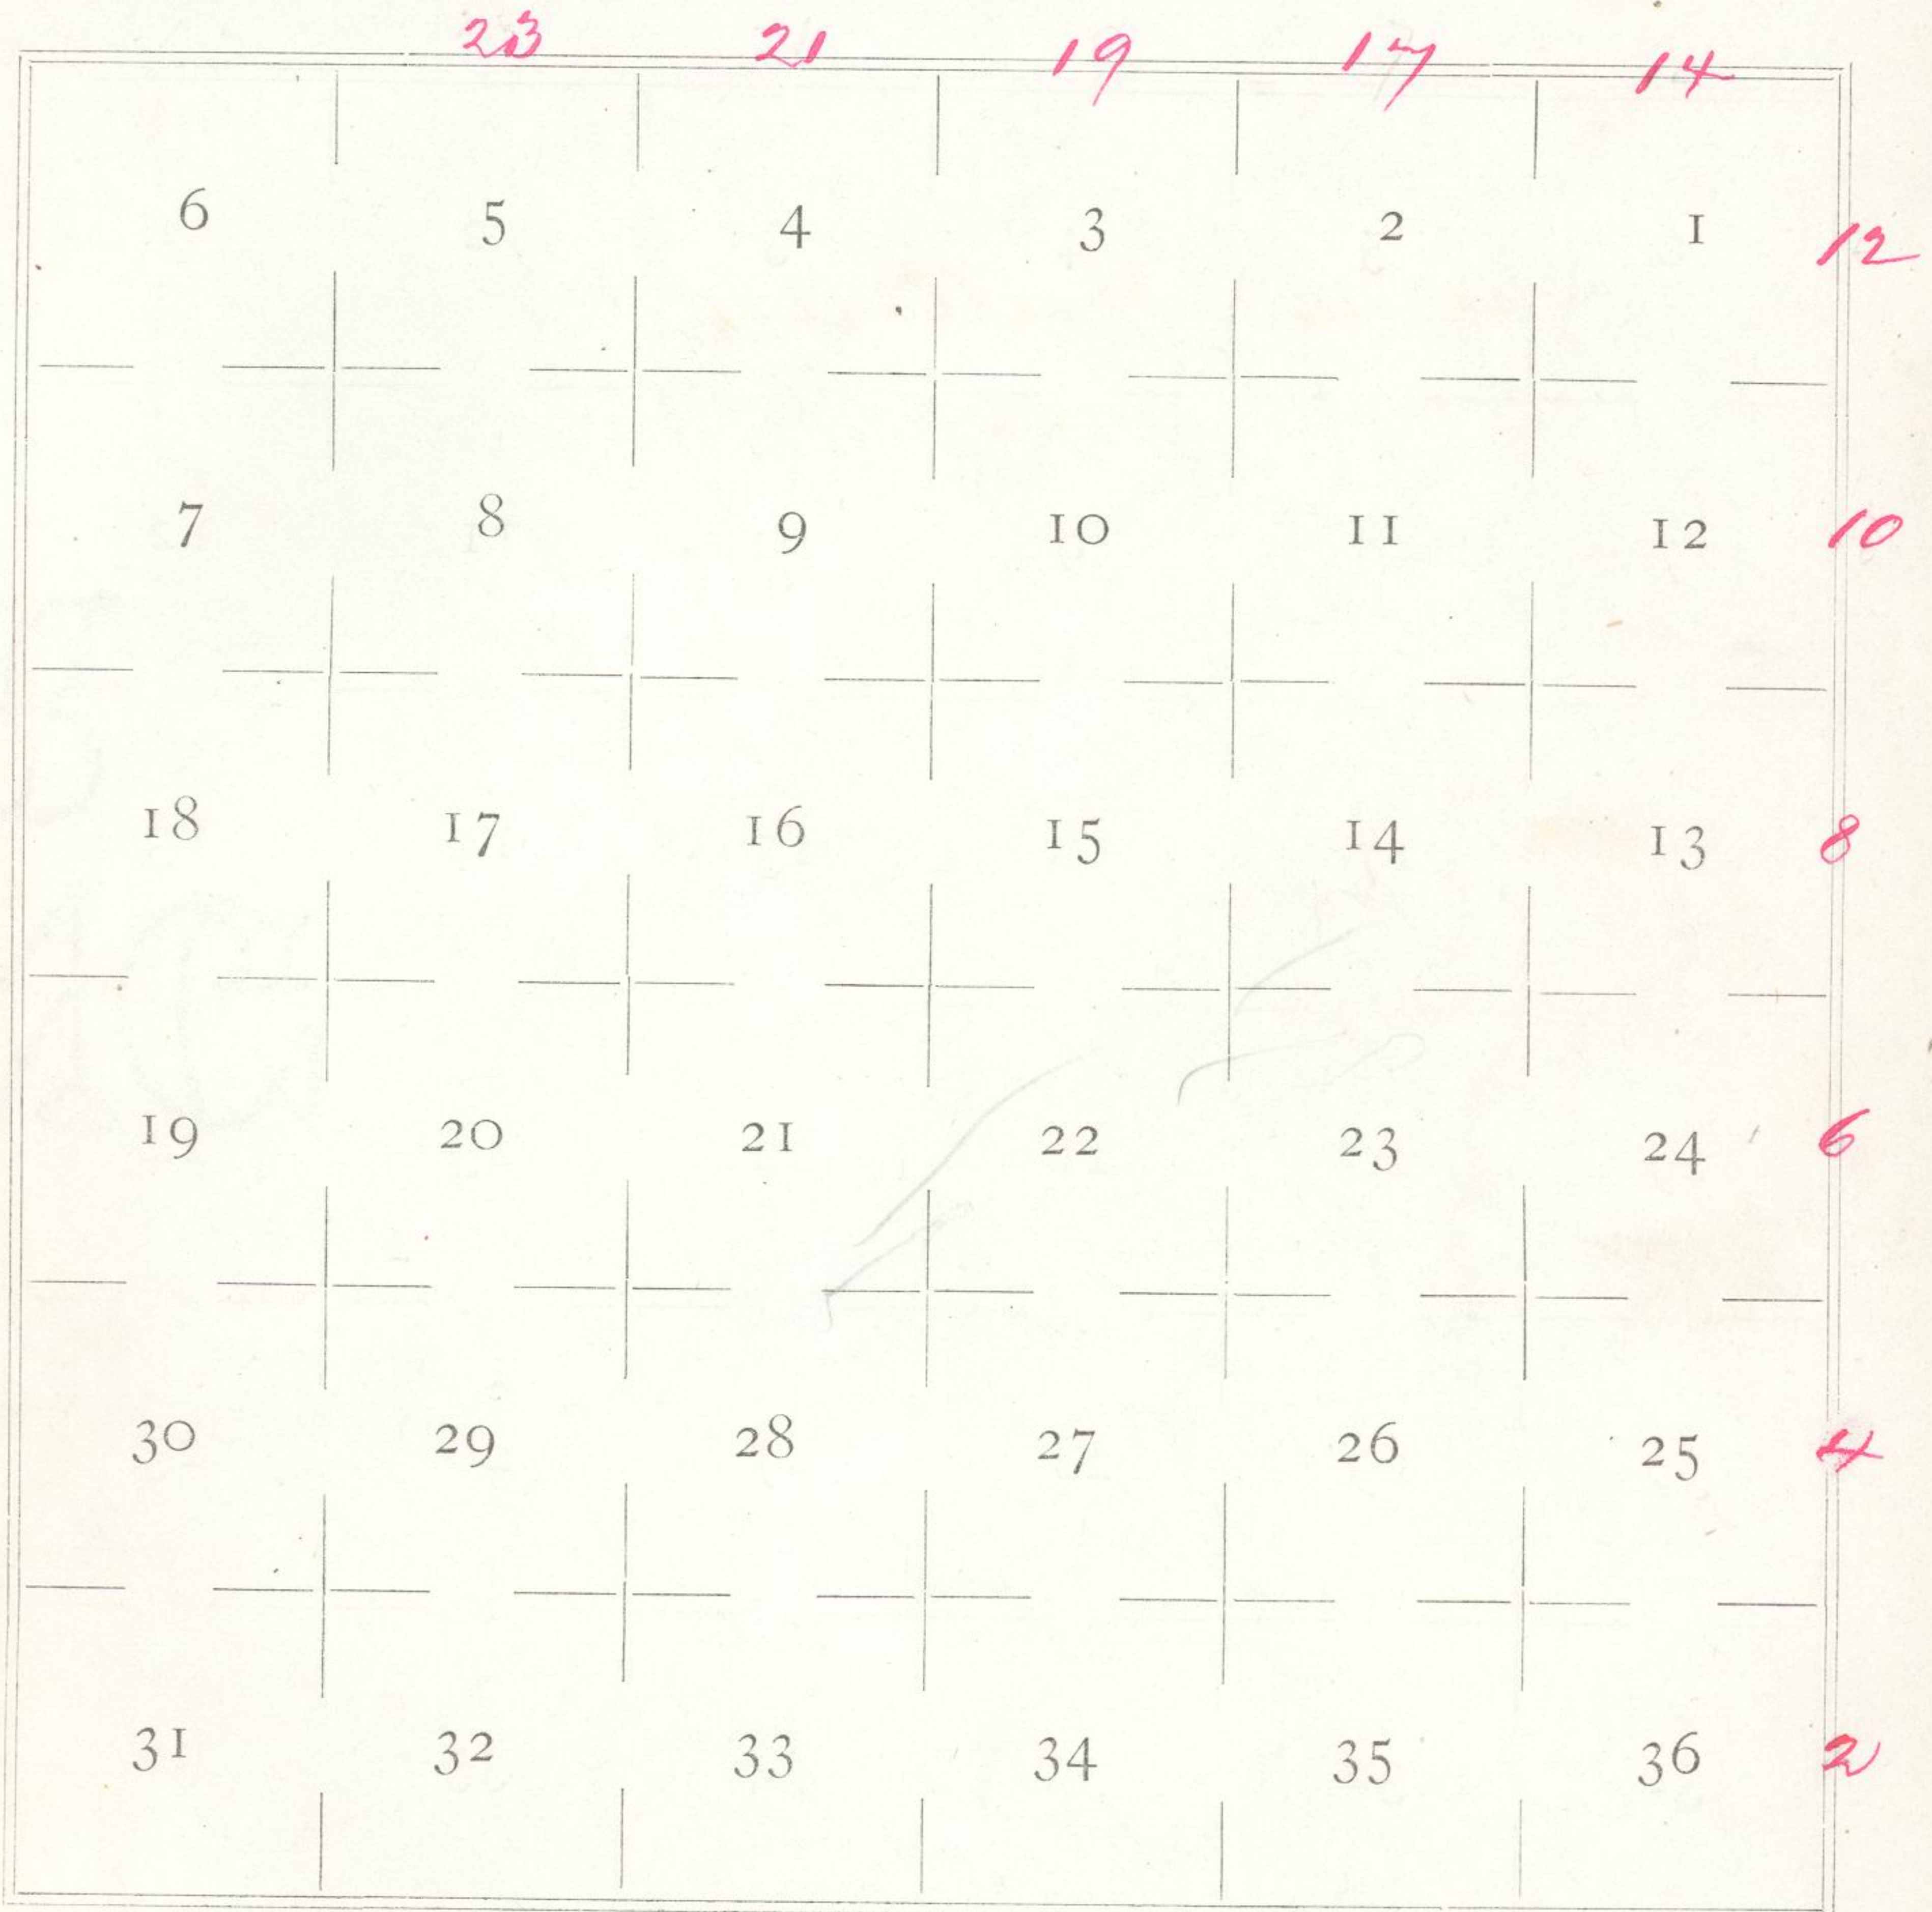

Outcrops of T. 3 South R. 33 East
Willamette Meridian, Oregon.

West on North boundary
of Sec 5

Var 18 1/2" East

Ascend hill from cranny

1700 Top of ridge bears N x S
500 ft above Sec cranny and
Descend

2085 Spring branch 2 lks wide
in Ravine course N 100 ft
deep and ascend

3750 Top of Ridge slopes N.E.
400 ft above branch

3900 Descend

4000 Set post 3 ft long 3 in square
24 in in ground for 1/4 Sec
cranny marked 1/4 Sec on N.
face from which
a pine 4 in diam bears S 64"
W 91 lks dist marked 1/4 S.B.S.
A pine 18 in diam bears N 42"
E 110 lks dist marked 1/4 S.B.S.

4734 Intersect East boundary

224

211

Continuation of T. 3 South R. 33 East
 Willamette Meridian, Oregon.

of Township 2 South R.
 32 East at a point 1503
 the North of corner to Town-
 ship 2 South Range 32 East
 which is a post 4 in square
 marked T. 2 S S 31 on N.E.
 R. 33 E S 6 on S.E.

T. 3 S S 1 on S.W. and
 S. 36 on N.W. face

I obliterated the marks on
 the N.E. and S.W. face; and
 changed See 6 to See 5
 with 6 notches on each
 edge

from which

a pine 24 in diam bears N.
 30° W 116 the dist marked
 S. 36 B.T.

a pine 24 in diam bears
 bears N 50° E 99 the dist.

The marks upon which
 I obliterated

Entering of T. 3 South R. 33 East

Willamette Meridian, Oregon.

A fir 10 in diam bears S 30° E 175 lbs dirt marked R 33 E S. 6 B. T. I change Sec 6 to Sec. 5

A pine 20 in diam bears S 47° W 213 lbs dirt the marks upon which I obliterated where I set a basalt stone 14 x 8 x 6 in 10 in in ground for closing corner to Township 3 South Range 33 East marked with 6 notches on N & S edges and C.C. on E face and raised mound of stone alongside, Pits impracticable in clump of willow brush on W. slope of ridge Land unmountainous Soil 2d & 3d rate

Scattering pine & fir timber Undergrowth of Willow & fir

FINAL OATHS FOR SURVEYS.

A list of the names of the individuals employed by _____
 Rufus S. Moore , U. S. Deputy Surveyor, to assist in
 running, measuring and marking the lines and corners described in the foregoing field
 notes of the survey of the *Exterior lines of Township's*
 3, 4 & 5 South Range ^{33 1/2} 34 East, and
 Twp. 3 South Range ³³ 33 E. Willamette Meridian, Oregon,
 showing the respective capacities in which they acted :

- _____, Compassman.
- James Guttridge* , Chainman.
- John Guttridge* , Chainman.
- _____, Chainman.
- _____, Chainman.
- Joe Parodi* , Axeman.
- _____, Axeman.
- _____, Flagman.

FINAL OATHS OF ASSISTANTS

We hereby certify that we assisted *Rufus S. Moore*
 _____, U. S. Deputy Surveyor, in surveying all
 those parts or portions of the *Exterior lines of Township's*
 3, 4 & 5 South Range ^{33 1/2} 34 of East and Twp.
 3 South Range ³³ 33 East Willamette Meridian, Oregon,
 as are represented in the foregoing field notes as having been surveyed by him and under
 his direction; and that said survey has been in all respects, to the best of our knowledge
 and belief, well and faithfully surveyed, and the corner monuments established, according
 to the instructions furnished by the U. S. Surveyor General of Oregon.

- _____, Compassman.
- James Guttridge* , Chainman.
- John Guttridge* , Chainman.
- _____, Chainman.
- _____, Chainman.
- Joe Parodi* , Axeman.
- _____, Axeman.
- _____, Flagman.

Subscribed and sworn to before me, this *Twenty First* day of
 November 188 *2*

[SEAL.]

Rufus S. Moore
 Notary Public

FINAL OATH OF DEPUTY SURVEYOR.

I, Rufus S. Moore

United States Deputy Surveyor, do solemnly swear that in pursuance of in-

structions received from

James C. Tolman

U. S. Surveyor General for Oregon, bearing date of the

Twelfth
~~Twenty Eighth~~day of June, 1882, I have well, faithfully and truly, in my own proper person, and in strict conformity with the instructions furnished by the U. S. Surveyor General for Oregon, the Surveying Manual, and the laws of the United States, surveying all thoseparts or portions of Exterior line of Twp. 3, 4, & 533 $\frac{1}{2}$ T
S. Range 34 E. and T. 3 S. R. 33 East of
Willamette Meridian, in the State of Oregon, as are represented in the foregoing Field Notes as having been surveyed by me and under my directions; and I do further solemnly swear that all the corners of said survey have been established and perpetuated in strict accordance with the Surveying Manual, printed instructions, the special written instructions of the U. S. Surveyor General for Oregon, and in the specific manner described in the field notes, and that the foregoing are the true field notes of such survey, and should any fraud be detected I will suffer the penalty of perjury under the provisions of an Act of Congress approved August 8, 1846.Rufus S. Moore

U. S. Deputy Surveyor.

Subscribed and sworn to before me, this

10th

day of

February1883Benford Robb
Notary Public

222

Office U. S. Surveyor General,

Portland, Oregon, *June 5,* 188*3*

The following Field Notes of the Survey of the

~~Exteriors of Twp. 3, 4, & 5 S. R. 34 E.~~
~~and Twp. 3 S. R. 33 E., Will.~~

Mer., Oregon

executed by *Refus S. Moore*

under his Contract No. *451*, dated *June*

12th, 188*2*, having been critically examined, the

necessary corrections and explanations made, the said field notes

and the survey they describe, are hereby approved.

James C. Salzman

Surveyor General.

