4185

Township No. 2 South of Range No. 33 East of the Willamette Meridian Oregon.

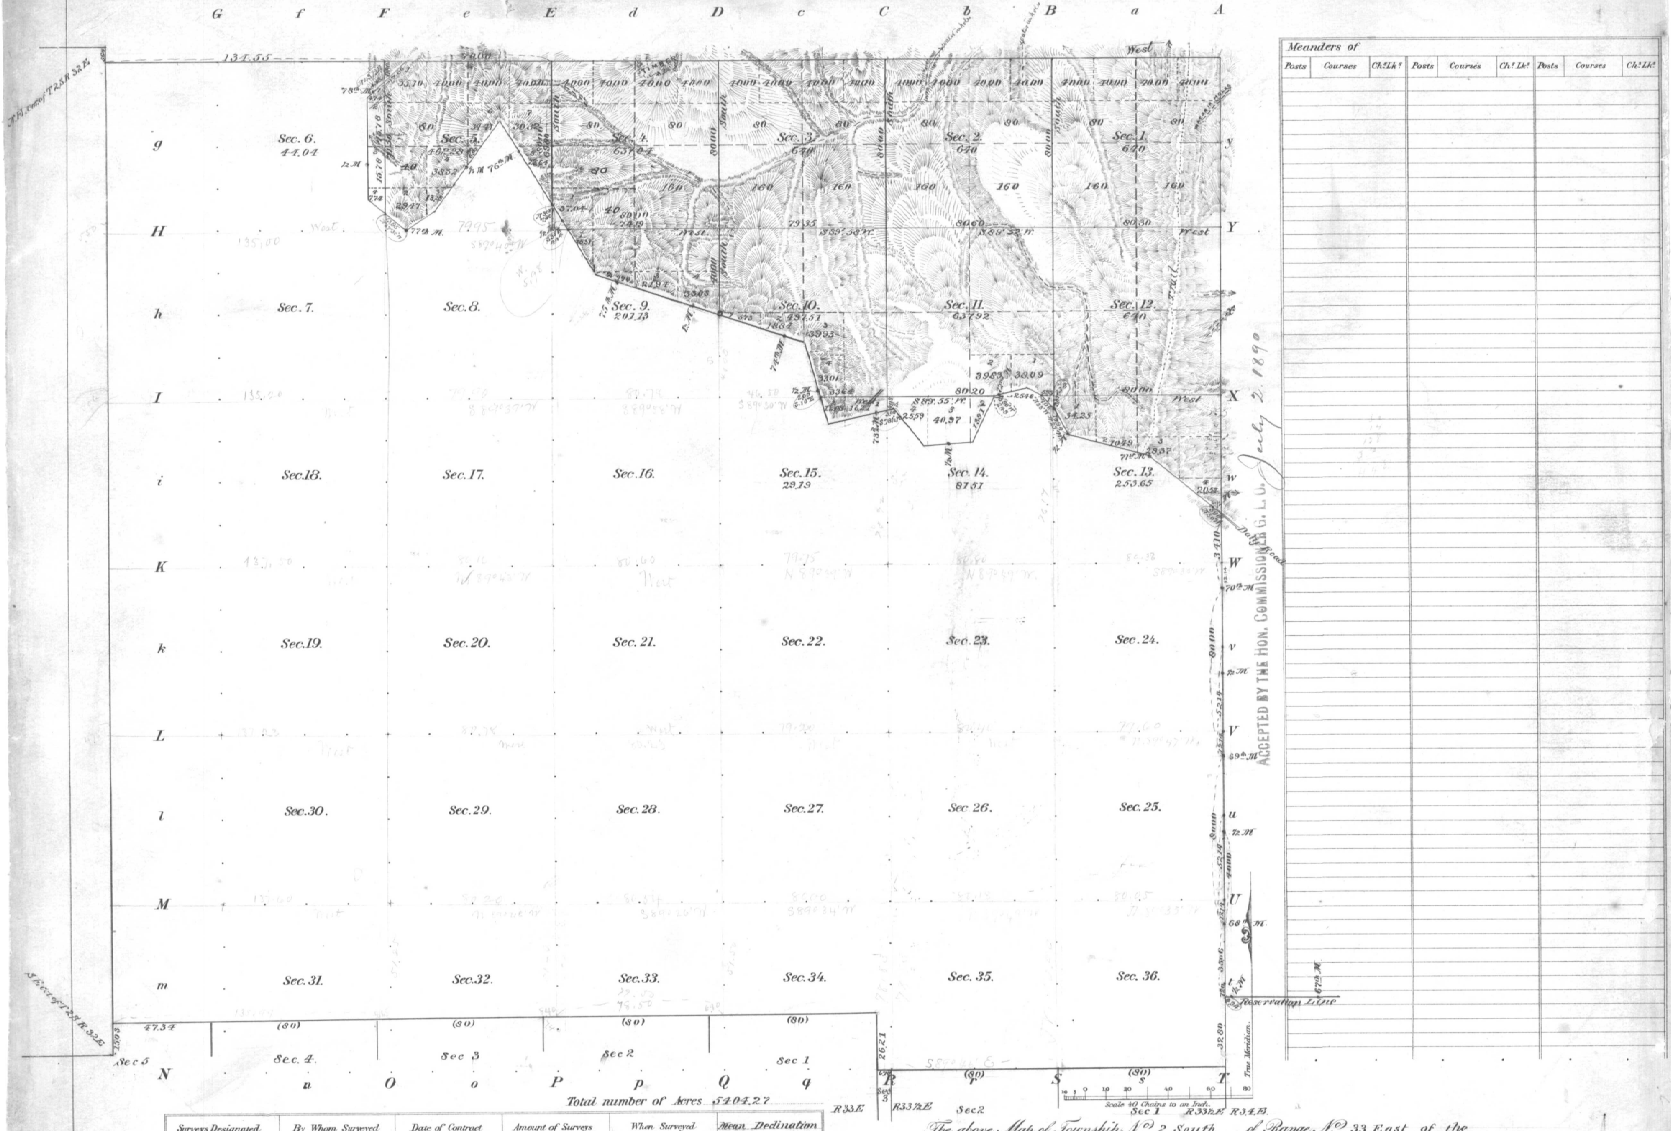

Total number of Acres 54042.27

Surveys Designated.	By Whom Surveyed.	Date of Contract	Amount of Surveys M. Ch.s Lk.s	Whom Surveyed.	Mean Declination.
Township lines	Currin and Piland	May 4th 1887			
Subdivisions	" " "	" " "	13 59 29	July 26th & 27th 1887	21° E
Connections	" " "	" " "	59 35		

The above Map of Township No. 2 South, of Range No. 33 East of the Willamette Meridian, Oregon. is strictly conformable to the field notes of the survey thereof on file in this Office, which have been examined and approved.

Surveyor Generals Office, Portland Oregon June 12. 1890

Douglas W. Taylor Sur. Gen.