

July 15 1874

304

Platted
C.S.

Field Notes of the Survey
of the Exterior Boundaries
and of the Subdivision Lines
of Township 3 South. of Range 36 East
of " 2 " " " 36 "
and of " 2 " " " 37 "
of the Willamette Meridian
in the State of Oregon.

by John A. Hurst Deputy Surveyor
under his contract No 201 bearing
date the 5th day of August 1873.

John

Casius S. S.

Index

Referring here to pages of field notes.

JSS-R366. Willamette Meridian

	20	19	18	17	16	15						
13	6	94	5	81	4	72	3	63	2	54	1	1
	94		93		80		71		62		53	
12	7	92	8	80	9	71	10	61	11	52	12	
	91		91		79		70		60		51	
11	18	90	17	78	16	69	15	59	14	50	13	
	89		88		77		68		59		49	
10	19	87	20	76	21	67	22	58	23	48	24	
	86		85		75		66		57		48	
10	30	84	29	75	28	65	27	56	26	47	25	
	83		82		74		65		55		46	
9	31	82	32	73	33	64	34	55	35	45	36	
	8		7		6		5		4		3	

Index

Referring the lines to the pages of the field notes

T2S. R37E. Willamett Meridian.

29

S.6

28

S.7

27

S.18

26

S.19

25

S.30

24

S.31

112

111

109

107

105

99

110

32

108

33

106

34


104

35

98

36

97

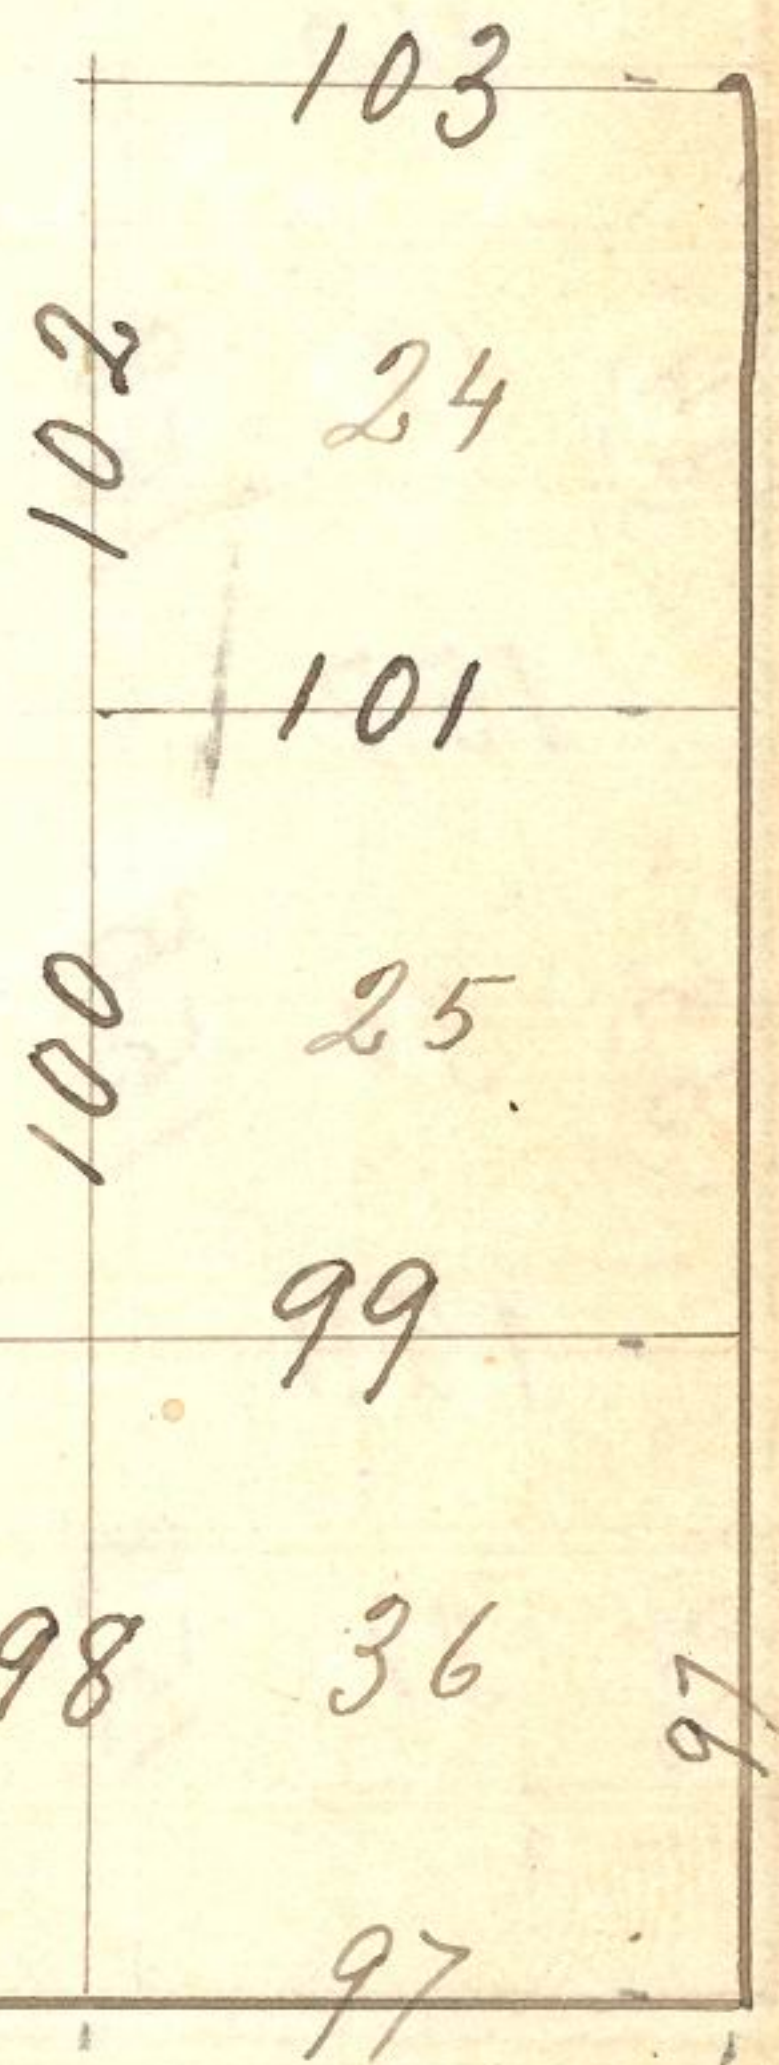

Index.

Referring the lines to the pages of the field notes

T.S. R 36 E. Willamette Meridian.

(42)	(41)	(40)	(40)	(39)	(38)
6	5	4	3	2	1
137	152	151	142	131	122
7	150	9	10	11	12
136	148	149	139	129	120
18	148	16	15	14	13
160	159	147	137	127	118
19	20	21	22	23	24
134	158	146	135	125	116
157	156	146	135	125	116
30	29	28	27	26	25
133	155	144	134	124	115
154	153	144	133	124	114
31	32	33	34	35	36
132	143	132	123	114	104

We Samuel Bacon and
 Caleb E. Cross do solemnly
 swear, that we will faithfully execute
 the duties of **Chain carrier**. That
 we will level the chain upon uneven
 ground, and plumb the tally pins,
 whether by sticking or dropping the same,
 that we will report the true distances to
 all notable objects, and the true length
 of all lines that we assist in meas-
 uring, to the best of our skill and
 ability.

Samuel Bacon
 Caleb E. Cross

Subscribed and sworn to
 before me 12th day of May 1874

W. W. Baker

Justice of the peace

I William Kee do solemnly
swear that I will well and
truly perform the duties of Appraiser
according to the instructions given
me, and to the best of my skill
and ability.

W^m Kee

Subscribed and Sworn
to before me ~~the~~ day of May 1874

W. W. Baker Justice of the Peace

Field Notes of the Survey
 of the Exterior boundaries of
 Township 3 South of Range 36 East
 Township 2 South of Range 36 East
 and Township 2 South of Range 37 East
 of the Willamette Meridian
 in the State of Oregon.

By John A. Harbort: Deputy Surveyor.
 under his Contract No. 201 bearing
 date the 5th day of August 1873.

East boundary of T 3 S. R 36 E.
 Willamette Meridian

Begin at South East cor of Sec 1

T 3 S. R 36 E. The witness trees all
 standing and agree with the description
 furnished me by the office. viz:

Pins 20 in dia S 8° E. 63 lks

Pins 10 in dia S 45° W. 104 lks

Pins 12 in dia N 20° W 39 lks.

North on East boundary of Sec 1

Var 21° - 00' East.

Willamette Meridian

323

Pine 20 in dia N 41 W 84 lks

Pine 18 in dia N 65 E 87 lks

No other near.

Pine continues on high ridge.

Land rolling, soil some 1st rate, but mostly poor and stony.

Pine tamarack and fir timber with small grassy openings.

May 15th 1874

North on West boundary of Sec 6.
Var 20° - 20' East

16.00		
1600	Descend hill	-50
4000	Set basalt stone 16x10x8, 12 in in ground, and make stone mound 2 ft high for 1/4 sec corner.	-210
6000	Stream 10 lks wide, runs N E E	-230
80.00	Set pine post, 5 ft long, 5 in square 2 ft in ground, for cor to townships 2 and 3 South, of Range 35 and 36 East.	+130
	Fir 15 in dia N 78 E. 19 lks	
	Fir 24 in dia N 79 W 29 lks	

West boundary of T 3 S. R 36 E. Willamette Mts.

Fir 24 in dia. S 30° W. 20 lbs

Pine 24 in dia. S 24° E 36 lbs.

Land mostly broken. Soil 2nd
and 3rd rate. Yellow and black
Pine. Tamarack fir and
spruce timber, with
some good grass.

West boundary of T2 S. R 36 E.

Begin at corner to townships 2 and 3
south of range 35 and 36 East.

Thence North on West boundary of Sec 31
to N or $18^{\circ}-30'$ East.

- | | | |
|-------|---|------|
| 28.00 | Stream 4 lks wide, runs S.E. | -60 |
| 40.00 | Set pine post 4 ft long, 3 in thick
2 ft in ground for $\frac{1}{4}$ sec cor
Pins 10 in dia, $N 18^{\circ} W$ 22 lks
Pins 15 in dia $S 70^{\circ} E$ 28 lks | +70 |
| 61.00 | Dry bed of stream, runs $S 60^{\circ} E$ | -20 |
| 70.00 | Dry bed of stream, runs $S 30^{\circ} E$ | +40 |
| 80.00 | Set basalt stones $15 \times 12 \times 8$ - 8 in in ground
and made stone mound, 2 ft high
for cor to Sec 30-31-25-36
Pins 20 in dia $N 53^{\circ} W$ 57 lks
Pins 36 in dia $N 55^{\circ} E$ 60 lks | +160 |

No other marks.

Land broken. Soil poor & stony.
Yellow and black pine, tamarack
and fir timber. Some good grass

Willamette Meridian.
 343

North on West boundary of Sec 30
 Var $22^{\circ}-00'$ East.

- 40.00 ^{40.00} Set pine post 4 ft long, 3 in thick +80
 2 ft in ground for 1/4 Sec cor.
 Pine 15 in dia N 32° W 31 lks
 Fir 8 in dia. S 43° E 12 lks
 69.50 ^{40.00} Summit of ridge, course East + West +170
 80.00 Set pine post 4 ft long, 4 in square -75
 2 ft in ground, for cor. to, sec 19-30-24-25
 Tamarack 6 in dia N 75° W 18 lks
 Fir 6 in dia. N 78° E, 12 lks
 Tamarack 6 in dia S 39° E, 27 lks
 Pine 6 in dia S 48° W 51 lks
 Land broken, soil 2nd to 3rd rate.
 Heavy growth of small black
 pine, tamarack and fir, with
 some open patches of
 fine grass.

344 boundary T 2 S. R 36 E
 West boundary of T 2 S. R 36 E

North on West boundary of sec 19
 Var $20^{\circ}-30'$ East.

40.00 Set pine post. 4ft long. 3 in thick - 210

2ft in ground. for 4 sec cor

Pine 10 in dia. S 42° E - 23 lks

Tamarack, 6 in dia. S 61° W. 16 lks

80.00 Set pine post. 4ft long. 4 in square - 280

2ft in ground. for cor to sec. 18-19-13-24.

Pine 6 in dia. S 72° W 59 lks

Pine 8 in dia N 78° W 42 lks

Pine 8 in dia N 7° E 60 lks

Fir 6 in dia S 64° E 123 lks

Lins run on side hill facing to N.E.

Soil 2nd to 3rd rate. Denser growth of

small black pine tamarack and fir.

with some spruce. near the creek.

North on West boundary of sec 18

Var $21^{\circ}-30'$ East

6.00 Stream 10 lks wide. run S 10° E. - level

Willamette Meridian.

345

40.00^{40.00} Set tamarack post, 4 ft long, 3 in thick +140
 2 ft in ground, for $\frac{1}{4}$ sec cor.

Pins 10 in dia. S32°W 15 lks

Pins 8 in dia. S62°E 36 lks

80.00^{80.00} Set pine post 4 ft long 4 in square +260
 on summit of high ridge, running
 from NN to S. 2 ft in ground
 for cor to Arc 57-18-12 and 13.

Fir 24 in dia. N30°W 9 lks

Pins 48 in dia. N53°E 20 lks

Pins 6 in dia. S7°E 40 lks

Fir 36 in dia S43°W 96 lks

Land broken. Soil poor.

Heavy growth, of small
 black pine, tamarack and fir,
 with small openings, containing
 fine grass.

June 13th 1874.

North on West boundary of Arc 7
 Var 21-20° East

40.00^{40.00} Set pine post, 4 ft long, 3 in thick -70

36

340 West boundary T.S. R 36 E

West boundary of T.S. R 36 E

2 ft in ground for 1/4 Arc cor

Pine 6 in dia S 62° W 12 lks

Pine 8 in dia. S 24° E 8 lks

63.50 Stream 8 lks wide. runs East ⁻⁸⁰ -80

80.00 Set basalt stone 18x12x8 - 8 in in ground ⁺¹⁹⁰ +190

and made stone mound, 2 ft high.

for cor to Arc 6-7-1 and 12.

Pine 20 in dia N 35° W 38 lks

Pine 18 in dia N 41° E 103 lks

Fir 20 in dia S 46° E 15 lks

No other near

South half of line nearly level.

North half of line broken.

Heavy growth of black pine
tamarack and fir on south sides

of creek. open pine and fir

timber on north side of creek

and good grass.

Willamette Meridian

North on West boundary of sec 6.

Var $21^{\circ} - 45'$ East

^{27.50} 27.50 Old road. Course East & West + 210

^{40.00} 40.00 Set pine post 4 ft long. 3 in thick + 100

2 ft in ground. for 1/4 sec cor

Pine 20 in dia N $68^{\circ} W$ 44 lks

Fir 24 in dia N $70^{\circ} E$ 48 lks

^{60.00} 60.00 brow of hill + level

^{80.00} 80.00 Set pine post 5 ft long. 5 in square - 300

2 ft in ground. for corner to

townships 1 and 2 South. of range

35 and 36 East

Fir 12 in dia N $64^{\circ} W$ 24 lks

Pine 8 in dia N $17^{\circ} W$ 21 lks

Pine 8 in dia N $23^{\circ} E$ 35 lks

Pine 10 in dia S $65^{\circ} E$ 14 lks

Land. high and rolling. Soil

1st to 3rd rate. dense growth

of small black pine tam-
arack fir and spruce.

Land rolling soil fine
to 3rd class, but little grass.

Dense growth of black pine
Tamarack fir and spruce.

July 15th 1874. Contains a large

amount of fine grazing and
This township contains a small
to large amount of fine timber
and grass land, and is farming

U.S. Surveyor General's Office
Eugene City Oregon

1874

The foregoing field notes of the survey of the
exterior lines of Tps 27 38 R 36 E and
T 28 S R 37 E Will Mer Oregon executed
by John A. Hurlburt under his
contract No 201 bearing date
August 5th 1873 having been
critically examined the necessary corrections

and explanations made the said field notes
and the surveys they describe are hereby approved
Su Gen