

Amended

FIELD NOTES

Of the survey of the Subdivisional

Lines of Township 1. South

Range 35 East Willamette Meridian,

Oregon, as surveyed by James J. Currier and

James O. Waland
U. S. Deputy Surveyor, ^{Chief and Special} under ~~his~~ Contract No. _____

dated May 7th 1887.

Survey commenced, June 29th 1887

Survey completed, July 3^d 1887

NAMES AND DUTIES OF ASSISTANTS.

-, Compassman.
- Frank Belshaw, Chainman.
- Guy Davis, Chainman.
-, Chainman.
-, Chainman.
- B. B. Crowder, Axeman.
-, Axeman.
-, Flagman.

6378

PRELIMINARY OATHS OF ASSISTANTS.

We, *Frank Belshaw & Guy Davis*

do solemnly swear that we will faithfully execute the duties of Chain Carriers; that we will level the chain over even and uneven ground, and plumb the tally pins, either by sticking or dropping the same; that we will report the true distance to all notable objects, and the true length of all lines that we will assist in measuring, to the best of our skill and ability, and in accordance with the instructions given us in

the survey of the *Subdivisional* lines of *T. South* *Range 35 East* Willamette Meridian, Oregon.

Frank Belshaw, Chainman.
Guy Davis, Chainman.
Guy Davis, Chainman.

Subscribed and sworn to before me, this *29th* day of *June* 18. *87*

[SEAL.] *James E. Holland*
U.S. Deputy Surveyor

We, *J. B. B. Crowner* and

do solemnly swear that we will well and truly perform the duties of Axemen in the establishment of corners and other duties, according to instructions given us, and to the best of our

skill and ability, in the survey of the *Subdivisional lines* of *T. 1 S. R. 35 East* Willamette Meridian, Oregon.

B. B. Crowner, Axeman.
B. B. Crowner, Axeman.

Subscribed and sworn to before me, this *29th* day of *June* 18. *87*

[SEAL.] *James E. Holland*
U.S. Deputy Surveyor

INDEX

Referring the Lines to the Pages of the Field Notes.

T. *1 South* R. *35 East* Will. Mer.

6	<i>18</i>	5	<i>6</i>	4	<i>1</i>	3	2	I
<i>21</i>		<i>20</i>		<i>8</i>		<i>3</i>		
7	<i>22</i>	8	<i>9</i>	9	<i>4</i>	10	11	12
<i>24</i>		<i>23</i>		<i>10</i>				
18	<i>25</i>	17	<i>12</i>	16		15	14	13
<i>28</i>		<i>27</i>		<i>13</i>				
19	<i>29</i>	20	<i>14</i>	21		22	23	24
<i>31</i>		<i>30</i>		<i>14</i>				
30	<i>32</i>	29	<i>17</i>	28		27	26	25
<i>34</i>		<i>33</i>						
31	<i>36</i>	32		33		34	35	36

Meanders of Pages to

Meanders of Pages to

Subdivisions of T. 1 South R. 35 East -
Willamette Meridian, Oregon.

South an True line bet - Secs. 31 + 32
Var. 19° 30' E

- 32,75 Summit of table land enter timber + 800
H006 Set a post ^{3 feet long} ~~36 x 36~~ ^{Square} 3 in, 24 ins in the
ground for 1/4 Sec. Cor. marked 1/4 S an
W face. From which a pine 36 ins
in diam. bears N 30° E dist; 35 lks.
marked 1/4 S. B.S. A pine 30 ins in diam.
bears S 45° W. dist. 45 lks. - marked 1/4 S. B.S.
- 85,84 Int. S. bdy of Township 9.00 chs
E of 1/4 Sec. Cor. Set a post ^{4 feet long} ~~48 x 48~~
^{Square 4 ins} in the ground for closing
Cor. to Secs. 31 + 32 Marked N/S.S.
32 an N.E. R. 35 E S 31 an N.W. T. 2 S
R. 35 E. S 6 an S. and C.C. are N. faces
and 5 notches are E + 1 on wedges.
From which a pine 10 ins in diam
bears N 30° E dist 54 lks. marked T. 1 S. R. 35
E. S 32. C.C. B.S. A pine 18 ins in diam.
bears N 85° W dist - 45 lks. marked T. 1 S. R.

357

Subdivisions of T. 1 South R. 3^d East

Willamette Meridian, Oregon.

(8093-10 M.)

~~cc.~~
 36th E. S 31st B. 2^d No other trees in
 limits raised a mound of stone
 along side +
 Land mountains & covered with
 timber 80-84 chs.
 Good pine & tamarack timber on
 lower land Soil 3rd rate

General description of township
 consist^{chiefly} of rolling land with small
 draws running to the Meacham creek
 on the east and McKay on the south
 and west - Secs. 29, 30, 31, 32 + part
 of sec. 19 are very rough - being cut
 up by McKay creek and draws
 running into it. There is pine fir
 tamarack & spruce timber over nea-
 rly the whole township but very sc-
 attering in places, and on the whole
 of little value - There is good grass

Subdivisions of T. / South R. 30 - East -
 Willamette Meridian, Oregon.

where timber and under brush is
 not too thick, water is very scarce
 late in the summer.

Soil in places 1st rate but
 is generally rocky - and will
 average about 2nd rate

July 3rd 1884

In accordance with the requirements of
 the manual of surveys we have carefully
~~adjusted~~ ^{tested} the adjustment of our inst-
 ruments by taking the latitude daily
 weather permitting during the progress
 of the surveys represented by the forego-
 ing field notes and in all cases
 they were found to be in correct
 adjustment.

James P. Currier

James E. Holman

U.S. Dep. Surveyors

361 Copy

FINAL OATHS FOR SURVEYS.

A list of the names of the individuals employed by James T. Currier and James O. Holand, U. S. Deputy Surveyor, to assist in running, measuring and marking the lines and corners described in the foregoing field notes of the survey of the Subdivision lines of Township 1 South Range 35 East Williamette Meridian, Oregon, showing the respective capacities in which they acted:

- Compassman.
Chainman.
Chainman.
Frank Belshaw, Chainman.
Guy Davis, Chainman.
B. B. Crowney, Axeman.
Axeman.
Flagman.

FINAL OATHS OF ASSISTANTS.

We hereby certify that we assisted James O. Holand and James T. Currier, U. S. Deputy Surveyor, in surveying all those parts or portions of the Twp 1 South Range 35 East of Williamette Meridian, Oregon.

as are represented in the foregoing field notes as having been surveyed by him and under his direction; and that said survey has been in all respects, to the best of our knowledge and belief, well and faithfully surveyed, and the corner monuments established, according to the instructions furnished by the U. S. Surveyor General of Oregon.

- Compassman.
Chainman.
Chainman.
Frank Belshaw, Chainman.
Guy Davis, Chainman.
B. B. Crowney, Axeman.
Axeman.
Flagman.

Subscribed and sworn to before me, this 15th day of

July 1887 James O. Holand U. S. Deputy Surveyor

FINAL OATH OF DEPUTY SURVEYOR.

We *James P. Currier and James E. Holman*
United States Deputy Surveyors do solemnly swear that in pursuance of

instructions received from *Douglas W. Taylor*

U. S. Surveyor General for Oregon, bearing date of *13th*

day of *May* 18*87*, I have well, faithfully and truly, in ^{my} own proper person, and in strict conformity with the instructions furnished by the U. S. Surveyor General for Oregon, the Surveying Manual, and the laws of the United States, surveying all those

parts or portions of *the Subdivisional lines of Township 1. South Range 35 East.*


^{amended} Willamette Meridian, in the State of Oregon, as are represented in the foregoing field notes as having been surveyed by me and under my directions; and I do further solemnly swear that all the corners of said survey have been established and perpetuated in strict accordance with the Surveying Manual, printed instructions, the special written instructions of the U. S. Surveyor General for Oregon, and in the specific manner described in the field notes, and that the foregoing are the true field notes of such survey, and should any fraud be detected I will suffer the penalty of perjury under the provisions of an Act of Congress approved August 8, 1846.

James P. Currier
James E. Holman
U. S. Deputy Surveyor. O

Subscribed and sworn to before me, this *6th*

day of *May* 18*90*

Heriman Berenshoer
Notary Public
for Oregon

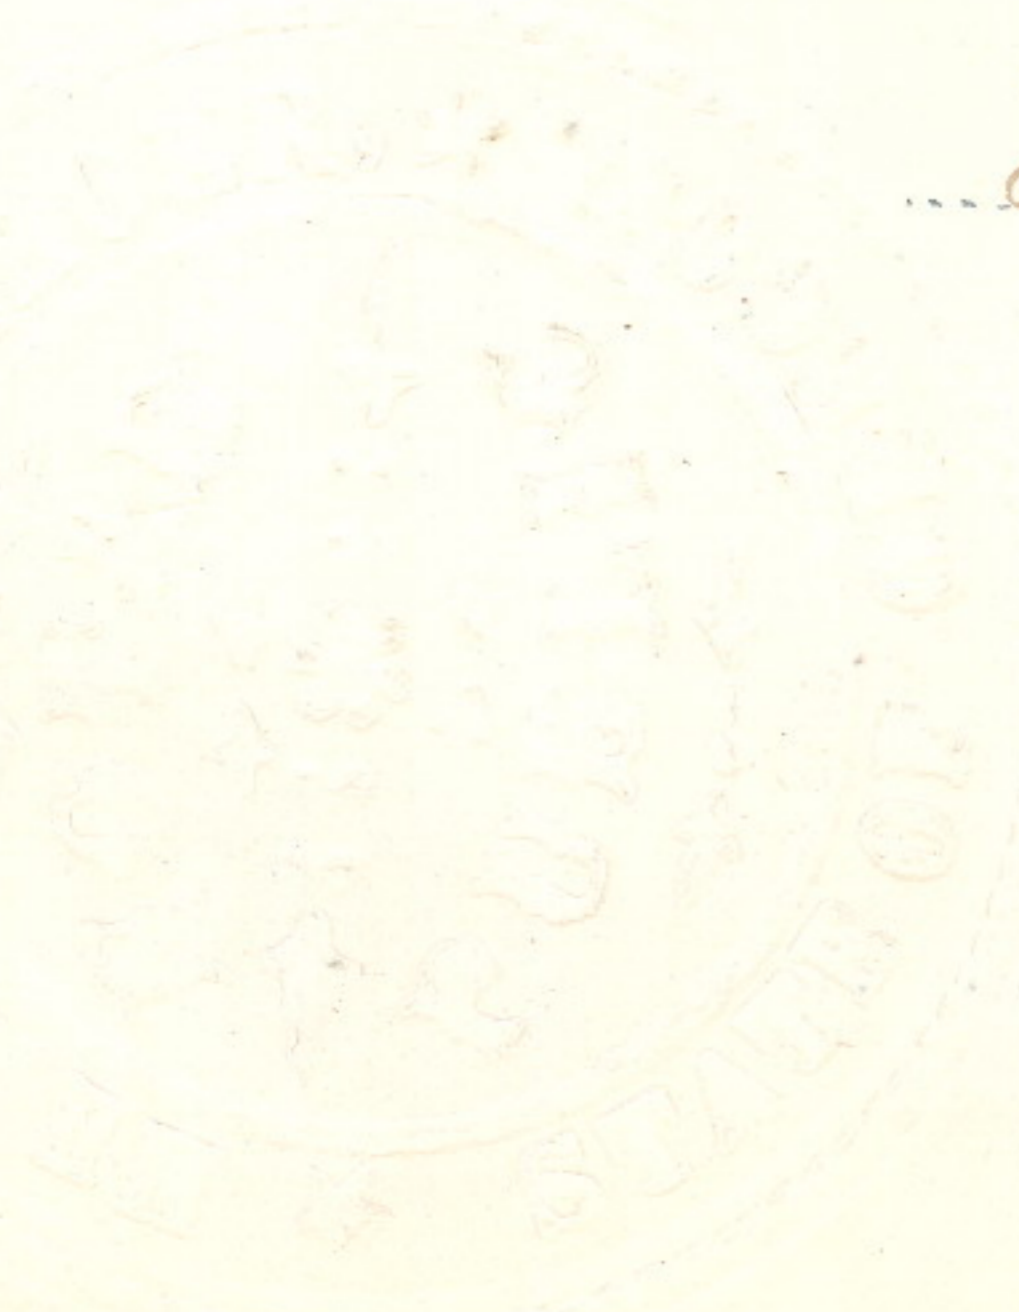

Office U. S. Surveyor General,

Portland, Oregon, *June - 4 - 1890*

The foregoing *amended* Field Notes of the Survey of the

Subdivisional lines of Township 1 South Range 35 East Will Mar Oregon

executed by *James P. Currier and James C. McLeod* U S Dept Surveyors under his contract No. *11111*, dated *May*

7th 18*87*, having been critically examined, the necessary corrections and explanations made, the said Field Notes and the survey they describe, are hereby approved.

Douglas W. Taylor
Surveyor General.

