

David Plummer D. 293 E.
Keel. FIELD NOTES

Of the survey of the Subdivisional
Lines of T. I. S. R. 35. E.

Willamette Meridian, Oregon,
as surveyed by Morris Buchanan
U. S. Deputy Surveyor, under his Contract No. 635

dated April 19., 1895



Survey commenced, June 28th, 1895

Survey completed, June 30th, 1895

NAMES AND DUTIES OF ASSISTANTS.

-----, Chainman.

Carl S. Nicklin, Chainman.

Guy D. Stryker, Chainman.

-----, Chainman.

Perry Van Arsdall, Axman.

-----, Axman.

-----, Flagman.

RECEIVED AND FILED.

this 30th day of Dec. 1895.

JOHN C. ARNOLD,
U. S. Surveyor General for Oregon.

234

PRELIMINARY OATHS OF ASSISTANTS.

We, Carl S. Nicklin and
Guy D. Stryker

do solemnly swear that we will faithfully execute the duties of Chain Carriers; that we will level the chain over even and uneven ground, and plumb the tally pins, either by sticking or dropping the same; that we will report the true distance to all notable objects, and the true length of all lines that we will assist in measuring, to the best of our skill and ability, and in accordance with the instructions given us in the survey of the

Subdivisional

lines of T. 1 South

R. 35 East

Willamette Meridian, Oregon.

Carl S. Nicklin, Chainman.

Guy D. Stryker, Chainman.

, Chainman

, Chainman.

Subscribed and sworn to before me this

Twenty eighth

day of

June

1895

[SEAL.]

Marinus Bughaman

U. S. Dept. Survey

We, J. Perry Van Arsdall and

do solemnly swear that we will well and truly perform the duties of Axmen in the establishment of corners and other duties, according to instructions given us, and to the best of our skill and ability, in the survey of the

Subdivision of T. 1 S.

R. 35 E.

Willamette Meridian, Oregon.

, Axman.

Perry Van Arsdall, Axman.

Subscribed and sworn to before me this

Twenty eighth

day of

June

1895

[SEAL.]

Marinus Bughaman

U. S. Dept. Surveyor


Page 15, 29 as to setting C.C. on U.S. R line
E. Bdry of sec 32 out of line with W. Bdry

225

INDEX

Referring the Lines to the Pages of the Field Notes.

T. 1 South R, 35 East Will. Mer.

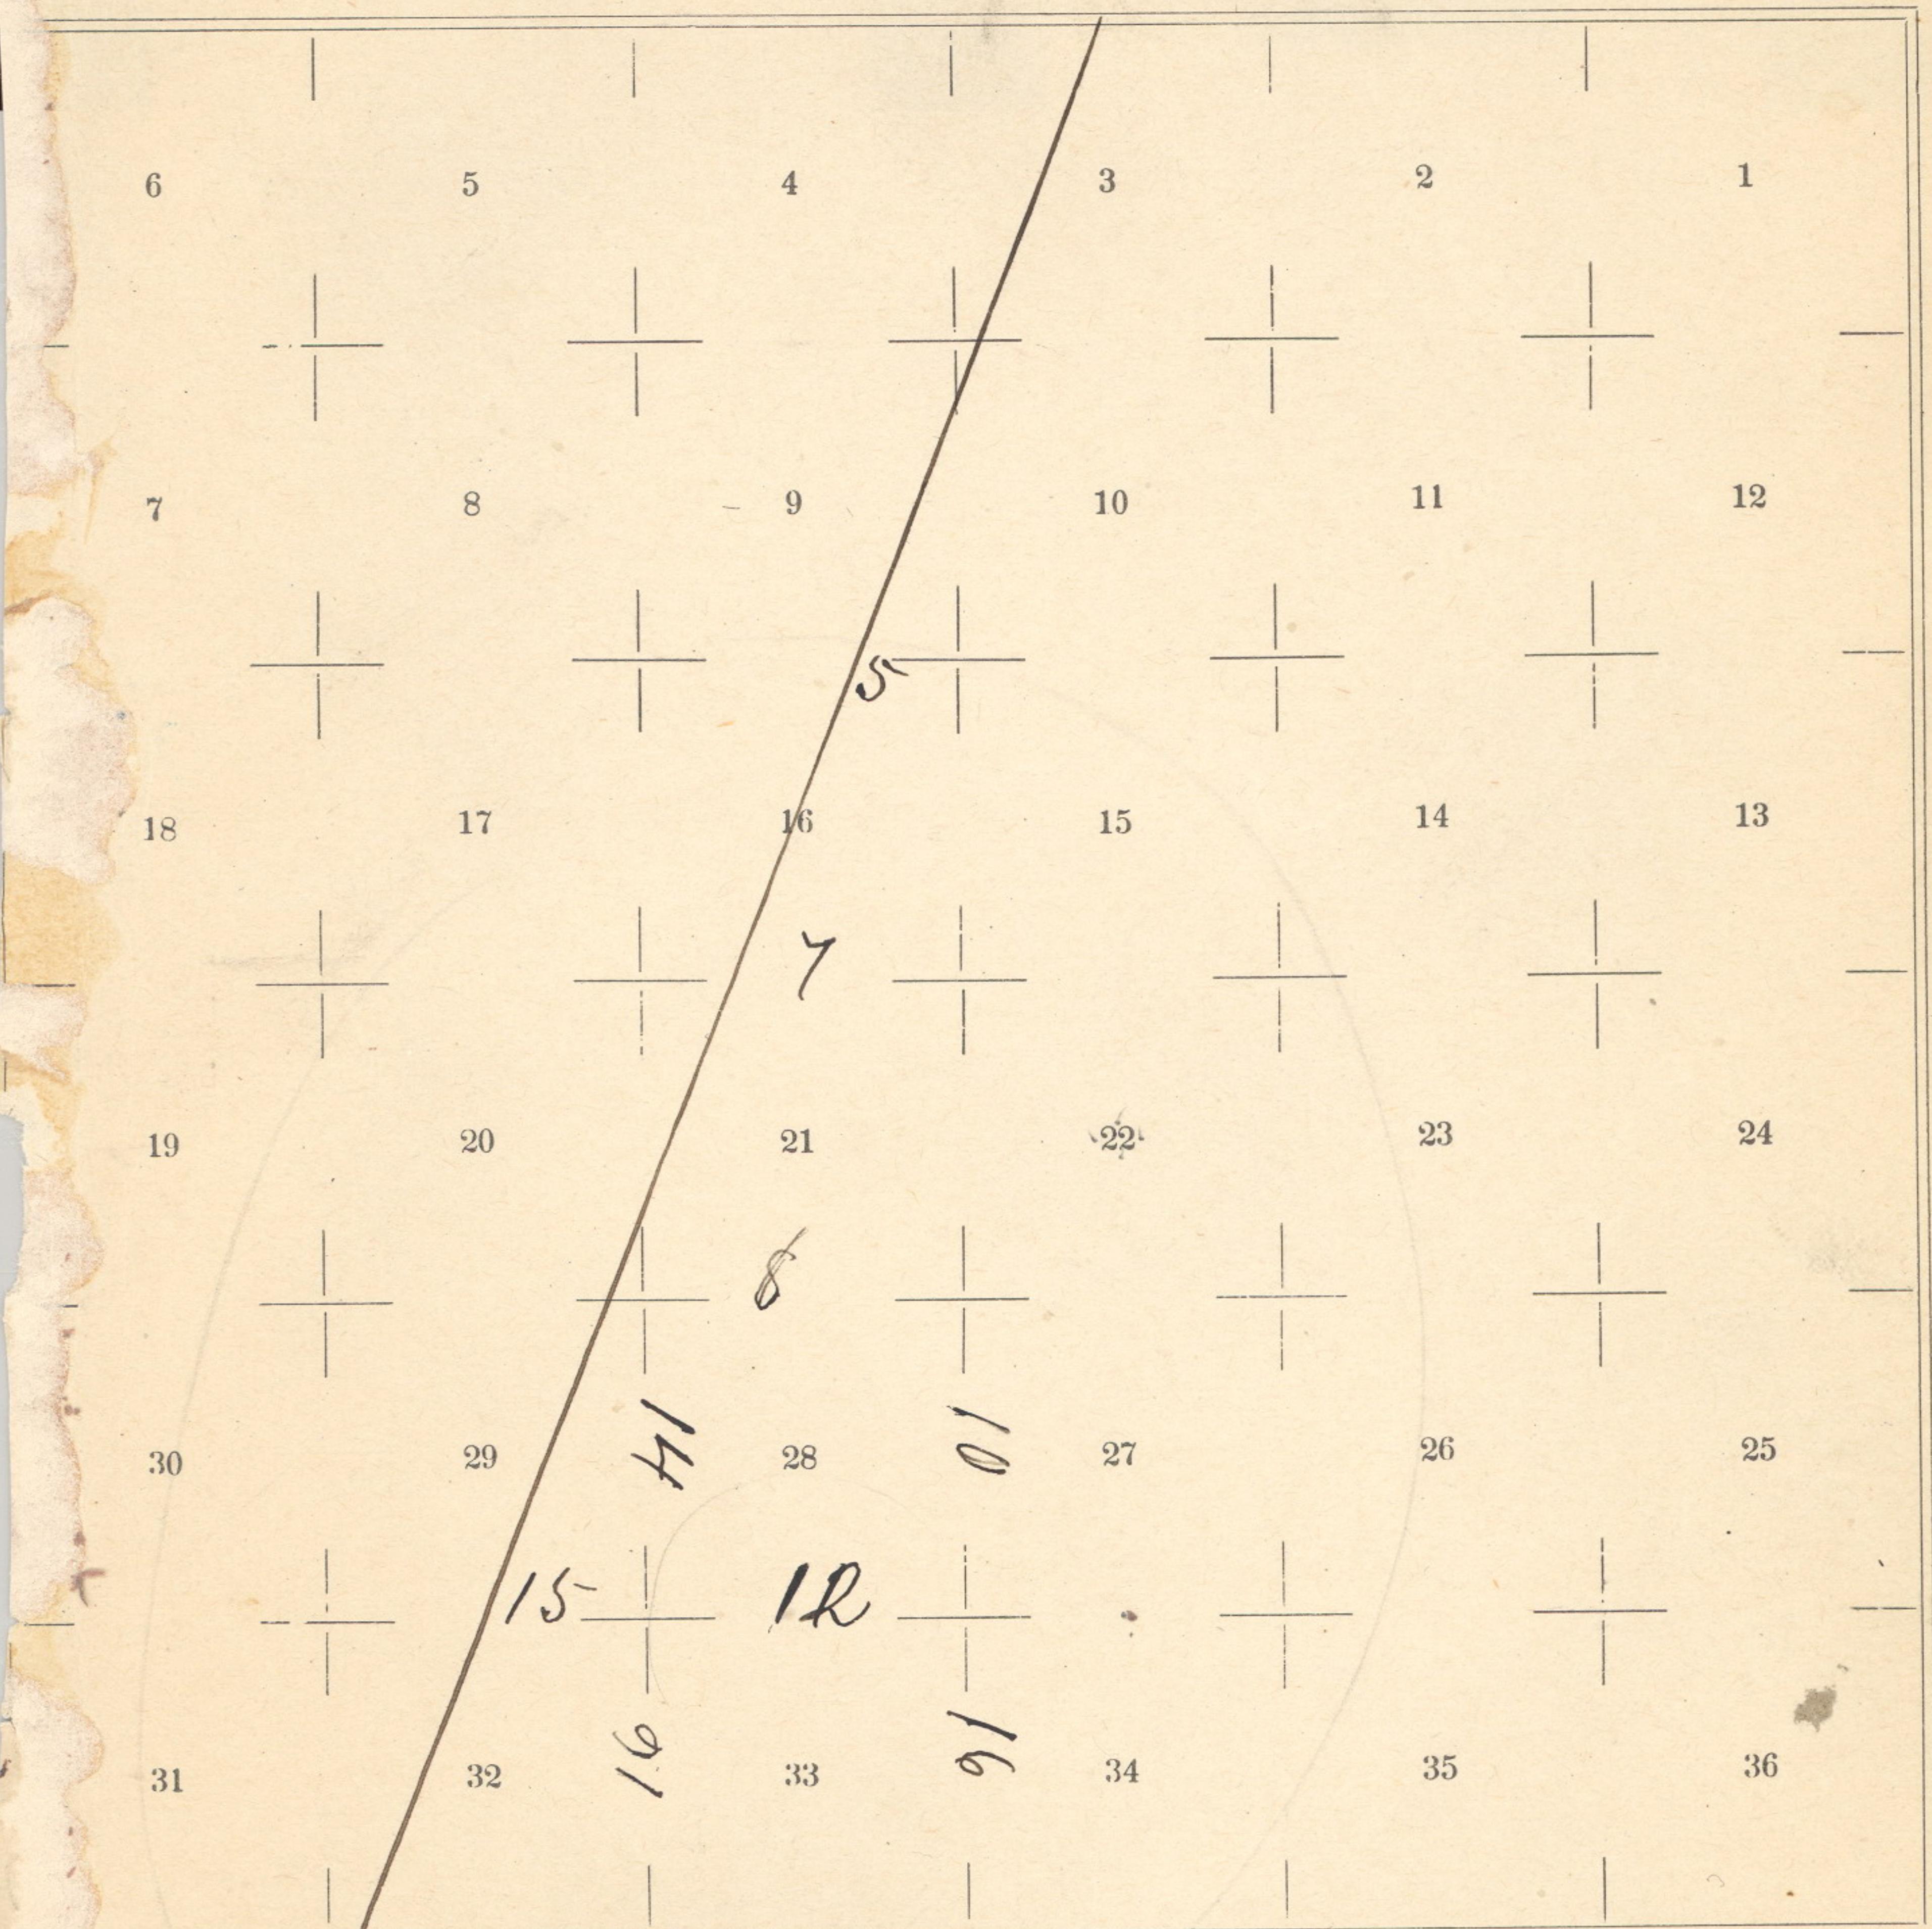

Linden

Meanders of _____ Pages _____ to _____

Meanders of _____ Pages _____ to _____

There being no officer, other than myself, authorized to administer an oath, I administer the required preliminary oath.

M. Buchanan
U.S. Dept. Surveyor

Subdivisions of T. 18. R. 35-E. Continued

of secs. 29 and 32, marked C. C.
on E. face, and raise a mound
of stone, 2 ft. at base, $1\frac{1}{2}$ ft. high,
E. of cor. Pits impracticable.

Land - mountainous:

Soil - sandy loam - 4 $\frac{1}{2}$ in. rate:
no timber:

Mountainous lands: 21.17 chs.

- From cor. of secs. 28, 29, 32 and 33
thence I run
S. on a true line bet. secs. 32 and 33:
ascend steep N. point: no timber
17.50 top of steep ascent. along rocky
ridge; E. of summit.
40.00 set a basalt stone $21 \times 15 \times 6$, ^{in.}_{on} rock,
in mound of stone, marked $\frac{1}{4}$
on W. face and raised a mound
of stone, 2 ft. at base, $1\frac{1}{2}$ ft. high, W
of cor. Pits impracticable.
42.00 Summit of ridge on rock cliff-
descend along W. side.
75.03 Intersect S. Bd. of township
28 chs. W. of Cor. of secs. 4 and 5,
~~described on page 8 of Extra~~
~~or as run by me in this contract.~~

Subdivisions of T. 1 S. R. 35 E. - Concluded

Chs. At point of intersection I set basalt stone $2\frac{1}{2} \times 16 \times 6$ ins. 17 ins. in the ground for closing cor. of sec. 32 and ^{face} 33, marked C. C. on N. with 4 notches on E. and 2 on W. Edges, and raise a mound of stone, 2 ft. base, $1\frac{1}{2}$ ft. high N. of cor. Pits impracticable.

Land, mountainous.

Soil, loam 3rd rate.

Timber, only a few trees of scrubby pine and fir.

Mountainous lands, 75.03 Chs.

June 30th 1895.

~~Latitude taken daily.~~

General Description.
This fractional township is very mountainous, and very precipitous in the south part. The soil is sandy and unproductive. It is chiefly valuable for its young timber and for grazing purposes.

Mainius Buchanan
U. S. Dept. Surveyor.

There being no officer, other than myself, available without great inconvenience, delay and expense, I administer the required final oath.

M. Buchanan
U. S. Dept. Surveyor.

FINAL OATHS FOR SURVEYS.

A list of the names of the individuals employed by *Marius Buchanan*, U. S. Deputy Surveyor, to assist in running measuring, and marking the lines and corners described in the foregoing field notes of the survey of the *Subdivisional* lines of *R. 35 East* Willamette Meridian, Oregon, showing the respective capacities in which they acted:

Carl S. Nicklin, Compassman.
Guy D. Stryker, Chainman.
Guy D. Stryker, Chainman.
Perry Vanarsdall, Axeman.
Perry Vanarsdall, Axeman.
Perry Vanarsdall, Flagman.

FINAL OATHS OF ASSISTANTS.

We hereby certify that we assisted *Marius Buchanan*, U. S. Deputy Surveyor, in surveying all those parts or portions of the *Subdivisional* of *R. 35 East* Willamette Meridian, Oregon, as are represented in the foregoing field notes as having been surveyed by him and under his direction; and that said survey has been in all respects, to the best of our knowledge and belief, well and faithfully surveyed, and the corner monuments established according to the instructions furnished by the U. S. Surveyor General of Oregon:

Carl S. Nicklin, Compassman.
Guy D. Stryker, Chainman.
Guy D. Stryker, Chainman.
Perry Vanarsdall, Axeman.
Perry Vanarsdall, Axeman.
Perry Vanarsdall, Flagman.

Subscribed and sworn to before me, this *thirtieth* day of *June*, 1895

Marius Buchanan
U.S. Dept. Surveyor

[SEAL.]

FINAL OATH OF DEPUTY SURVEYOR.

I, Marius Buchanan, United States Deputy Surveyor, do solemnly swear that in pursuance of instructions received from John C. Arnold, U. S.

Surveyor General for Oregon, bearing date of the eighth

day of May, 1895, I have well, faithfully, and truly, in my own proper person, and in strict conformity with the instructions furnished by the U. S. Surveyor General for Oregon, the Surveying Manual, and the laws of the United States, surveying all

those parts or portions of Subdivisions of
T. 18. R. 35 E.

Willamette Meridian, in the State of Oregon, as are represented in the foregoing field notes as having been surveyed by me and under my directions; and I do further solemnly swear that all the corners of said survey have been established and perpetuated in strict accordance with the Surveying Manual, printed instructions, the special written instructions of the U. S. Surveyor General for Oregon, and in the specific manner described in the field notes, and that the foregoing are the *true* field notes of such survey, and should any fraud be detected I will suffer the penalty of perjury under the provisions of an act of Congress approved August 8, 1846.

Marius Buchanan
U. S. Deputy Surveyor.

Subscribed and sworn to before me this twenty eighth
day of December, 1895

John C. Arnold,
U. S. Surveyor General,
for Oregon,

Office of U. S. Surveyor General,

Portland, Oregon, November 28, 1896.

The following Field Notes of the Survey of the

Subdivisional lines of

Township 1 South Range 35^E.

Weil. Mts. Oregon

executed by Maurice Buchanan
as Deputy Surveyor
under his Contract No. 635, dated April

19th, 1895, having been critically examined,
the necessary corrections and explanations made, the said Field
Notes and the survey they describe, are hereby approved.

Robert A. Habershaw

Surveyor General.