

Washington transcript, made L.A.M.

Field Notes of the Exterior
Lines of Townships No. 1 & 2 N.
Range No. 31. East of the Will-
amette Meridian, Oregon - ex-
ecuted by Josiah A. Burnett
deputy Surveyor, under his con-
tract No. 92, dated September
12th 1860.

Commenced October 16th 1860

Completed Nov. 20th 1860.

Rec^d Nov-19th 1860

Copied


+

Index Diagram

R. 31. E.

T. 2. N

T. 4. N

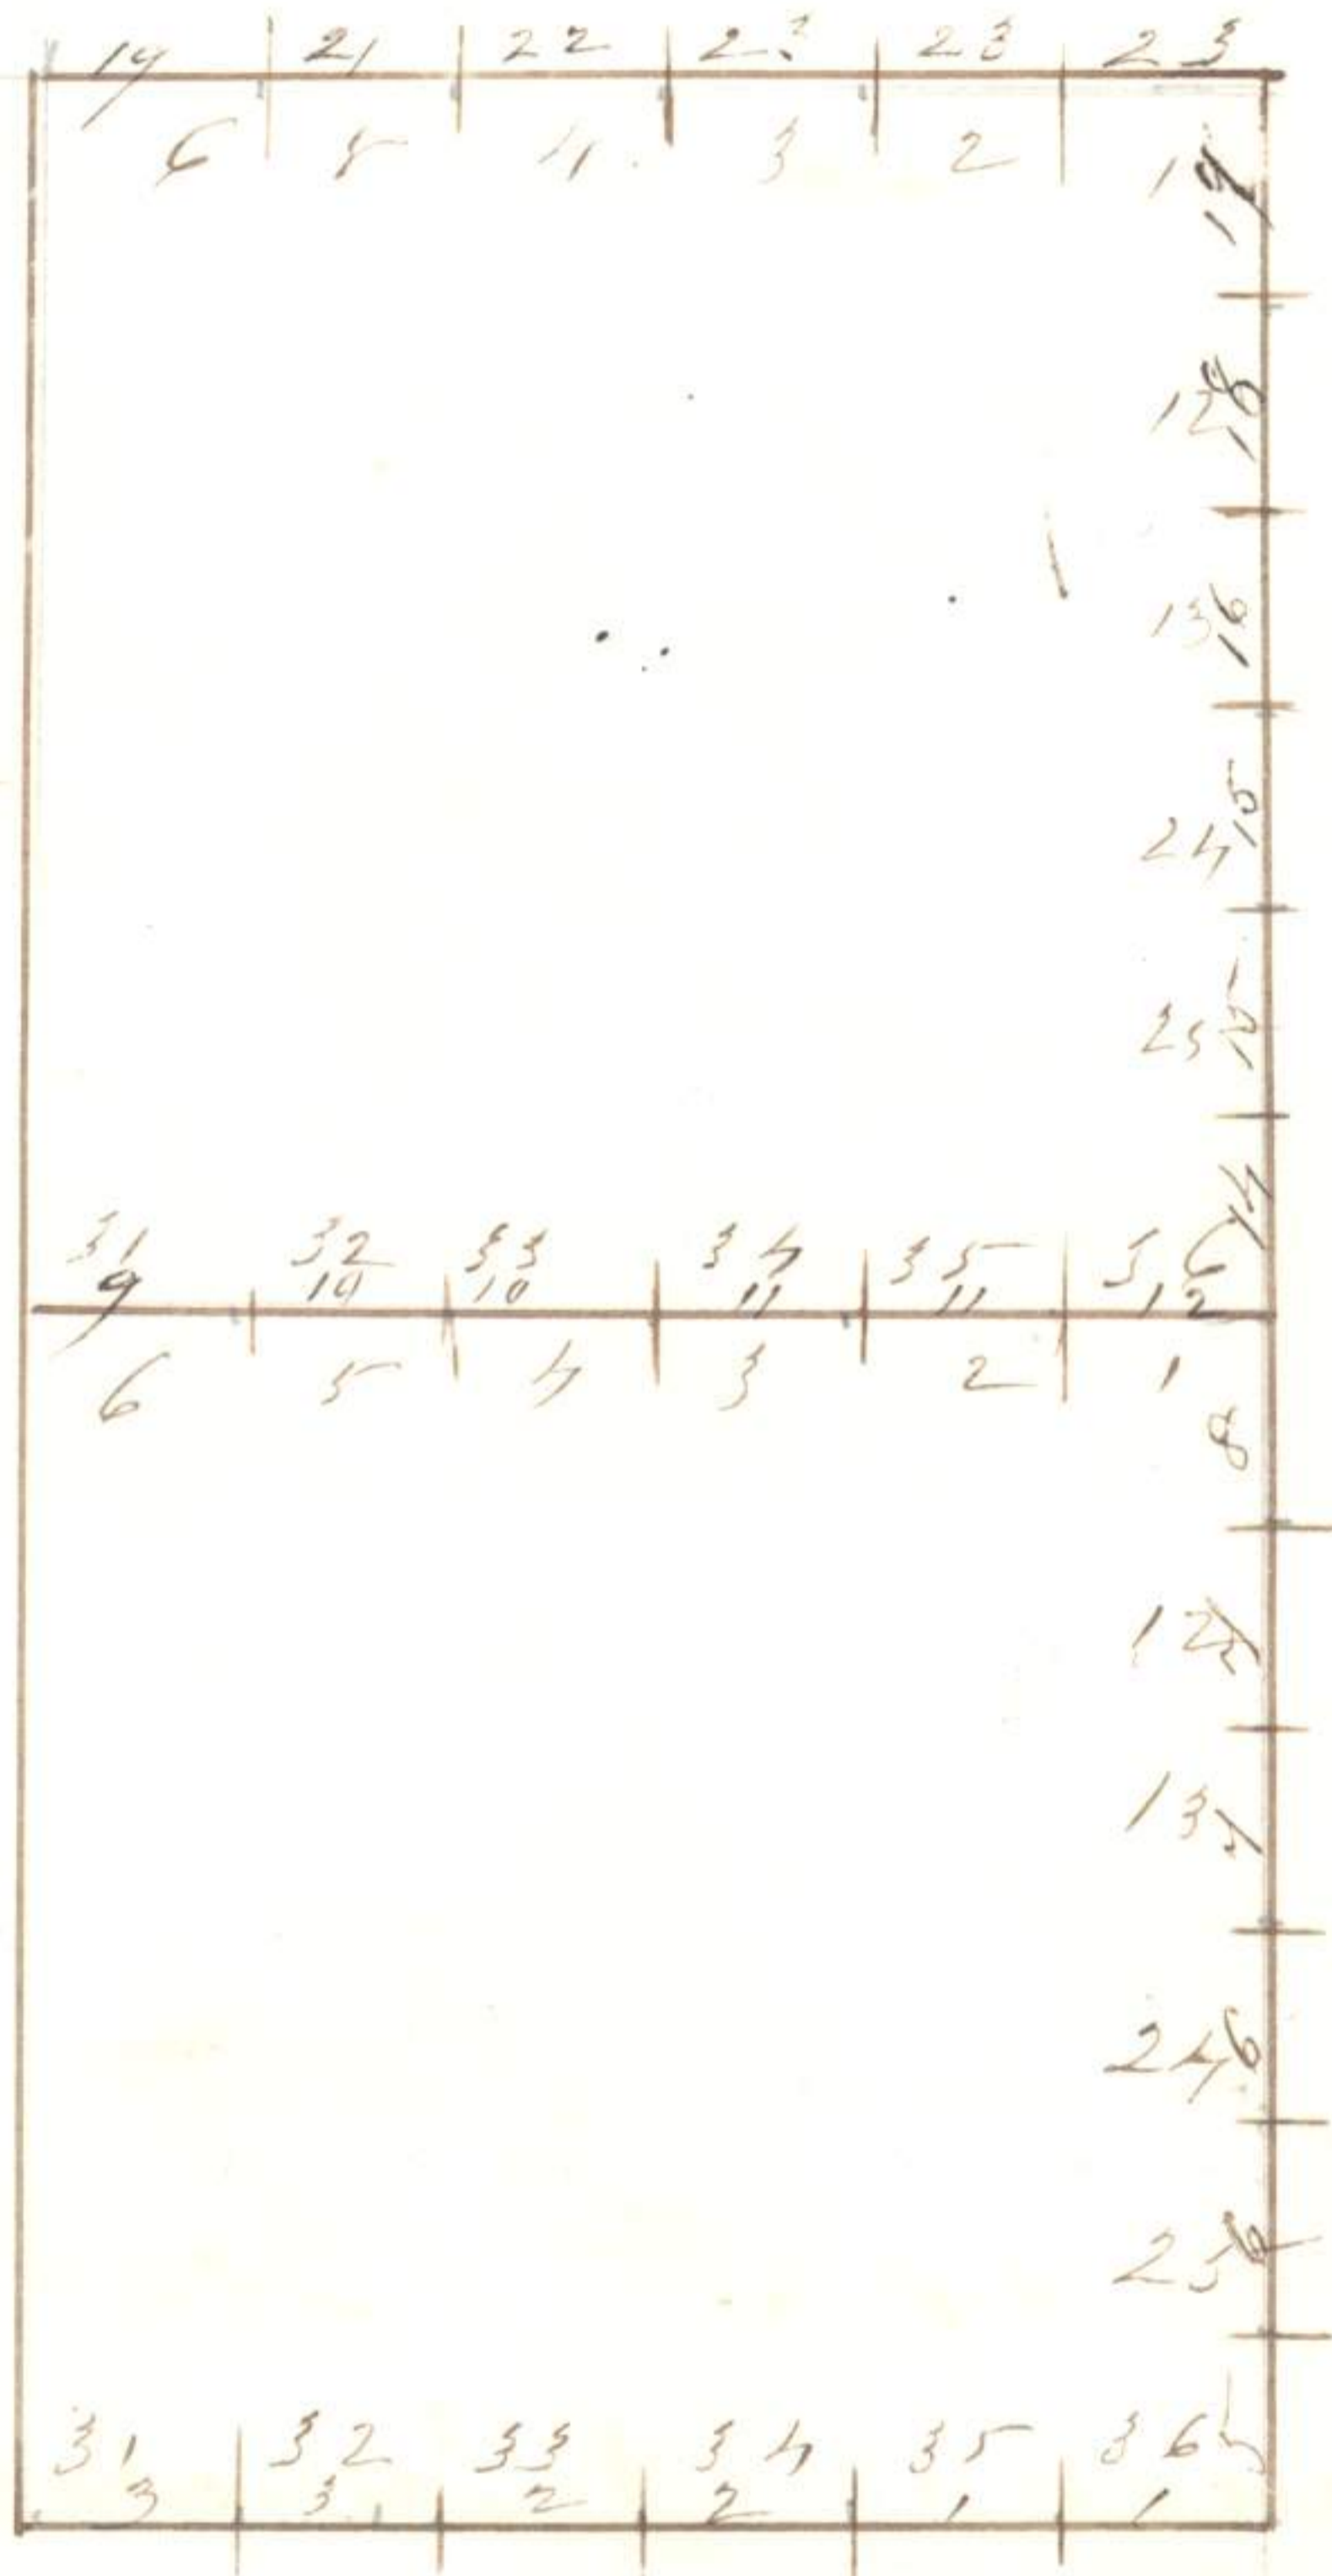

We Walter Poulding, Thomas H

Bell, Davis Divers & Patrick Call-
-ihan, do solemnly swear that we
will faithfully execute the duties
of chain carriers, that we will level
the chain upon uneven ground
and plumb the tally pins, whether
by sticking or dropping the same,
that we will report the true distance
to all notable objects, and the true
length, of all lines that we assist
in measuring to the best of our
skills and ability

Walter Poulding Chairman
Thomas H Bell Chairman

Daves, Divers Chairman

Patrick ^{his} Callihan Chairman
(Mark)

Subscribed & Sworn to before me by
the above named persons this
22^d day of September 1860
J. B. Hodgdon J. P.
of Masco Co Oregon

We Wm Smith & Thomas White do
solemnly swear that we will
well and truly perform the duties
of Axemen according to instruc-
-tions given, ~~us~~ and to the
best of ~~our~~ skill and ability
William L. Smith Axeman
Thomas White Axeman
Subscribed & sworn to before me
by the above named persons
this 22^d day of September 1860
S. B. Hodgdon, J. P.,

Return Range 31432 E T 2 N

North on the East boundary of
Sec. 1

Variation 20° 00' E

40.00 Set a post for 1/4 sec cor drove cha-
=rra stake and raised mound
with trench as per instructions

80.00 To a point for corner to Township
243 North. Range 31432 East
drove charra stake and raised
mound with trench as per int-
=ructions

Land rolling grass hills 2^d rate
soil.

Oct. 19th 1800.

West on a random line along
the ~~North~~ boundaries of Secs. ^{1, 2, 3,} ~~4, 5, 6,~~
~~7, 8, 9, 10~~

Variation 195' E

Set temporary half mile and mile
posts at every 40 and 80 chains and
at 6 miles 2 chains and 60 links To

A list of the names of the individuals employed to assist in running measuring or marking the lines and corners described in the foregoing field notes of Townships T₁₀N and 2 North of the Base line of Range T₃₁E east of the Willamette meridian showing the respective capacities in which they acted,

Patrick Callahan, Chairman

Walter Paulding " "

Thomas Whit's Eyeman

M. C. C. Murphy, Compassman

We hereby certify that we assisted Josiah, A. Burnett
deputy surveyor in surveying the exterior lines ²⁶⁷
of Township No 142 North of the base line of
Range No 31 East of the Willamette meridian

and the survey of the Base line along the
south boundary of Township No 1 North of
Range No 31 East of the Willamette meridian
and that said exterior and survey of the base
line has been in all respects to the best of our
knowledge and belief, well and faithfully sur-
veyed and the boundary monuments planted
according to the instructions furnished by
the surveyor General,

M. O. Murphy

Patrick ^{his} Ballahan

Walter Poulding

Thomas White Osaman

Subscribed & sworn to by the above persons before
me a Justice of the Peace, of the County of
Wasco, State of Oregon, this 30 day of October
1860—

G. B. Hodgdon
Justice of the Peace

I Josiah A. Burnett deputy
 Surveyor do solemnly swear
 that in pursuance of a contract
 with W. W. Chapman Surveyor
 of the public lands of the
 United States, in the State of Oregon
 bearing date the 12th day of Septem-
 -ber 1860, and in strict conformity
 to the laws of the United States,
 and the instructions furnished
 by the said Surveyor General, I have fai-
 -thfully surveyed the exterior boundaries
 of Townships No 1 and 2 North of the base
 line of Range No 31 East of the Willamette
 Meridian in the State aforesaid and do further sol-
 -emly swear that the foregoing are the true and
 original field notes of such survey

J. A. Burnett

Asst. Surveyor

Subscribed and sworn to before
 me at Eugene City Nov 21. 1860

W. W. Chapman Surveyor

270

Surveyor General's Office

Eugene City, Dec 5th 1860.

The foregoing field notes of the survey of the remeasurement of the Base Line through Range No 31 East and the Exterior Lines of Townships No. 1 & 2 North of Range No. 31 East of the Willamette Meridian, Oregon, executed by J. A. Barnett under his contract of the 12th day of September 1860. having been critically examined the necessary corrections and explanations made, the said field notes and the surveys they describe are hereby approved.

A. W. Chapman
Sur. Gen. of Oregon.