Township No. 3 North Range No. 33 East Willamette Meridian Oregon

4164

G f F e E d D c C b B a A

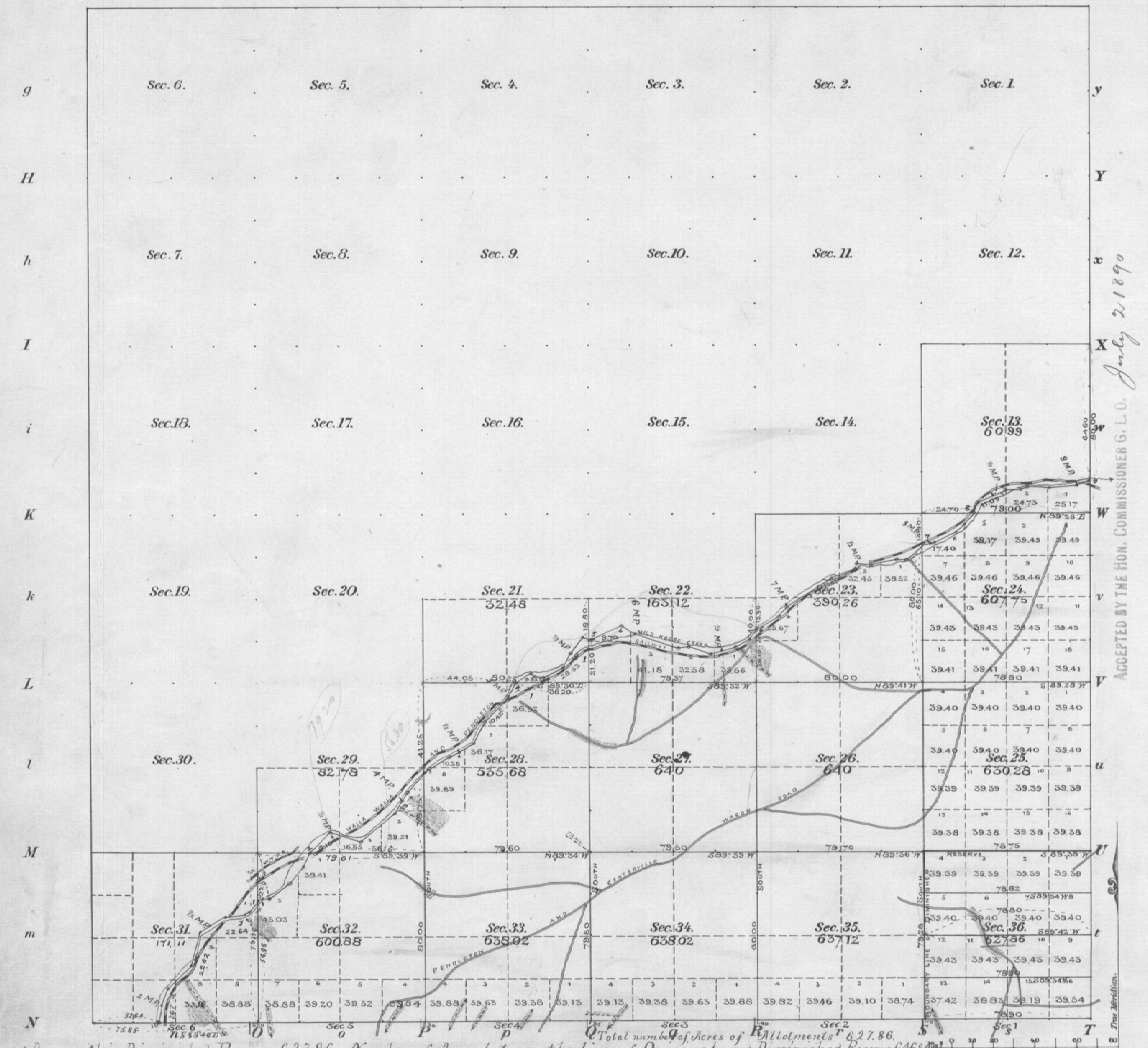

ACCEPTED BY THE HON. COMMISSIONER G. L. O. July 2, 1890

Meanders of								
Posts	Courses	Ch^s Lk^s	Posts	Courses	Ch^s Lk^s	Posts	Courses	Ch^s Lk^s

Number of Acres within Diminished Reserve 627.86. Number of Acres between the lines of Orig^l and Diminished Reserve 646.84

Total number of Acres of Allotments 627.86

Total number of Acres 7096.35

Surveys Designated.	By Whom Surveyed	Date of Contract	Amount of Surveys M.	Ch^s	Lk^s	When Surveyed	Mean Declination.
Township lines	Curran & Noland	May 4th 1887					
Subdivisions	" " "	" " "	23	21	23	Aug 15 and 16. 1887	18° 22' 30" E.
Connections	" " "	" " "	9	76			

The above Map of Township No. 3 North, of Range No. 33 East Willamette Meridian, Oregon, is strictly conformable to the field notes of the survey thereof on file in this Office, which have been examined and approved.

Surveyor Generals Office, Portland Oregon. June 14. 1890

Douglas W. Taylor Sur. Gen.