

FIELD NOTES

Of the survey of the *Subdivisional*

Lines of *Township 3 North*

*Range 234 East* Willamette Meridian, Oregon,

as surveyed by *Jos. P. Currier and Jos. Roland*

U. S. Deputy Surveyor, under his Contract No. \_\_\_\_\_

dated *May 4<sup>th</sup>*, 1887

Survey commenced, *Aug 18<sup>th</sup>*, 1887

Survey completed, *Aug 20<sup>th</sup>*, 1887

NAMES AND DUTIES OF ASSISTANTS.

*L. F. Wooley*, Compassman.

*J. D. Medley*, Chainman.

*H. H. Medley*, Chainman.

*Frank Belshaw*, Chainman.

*Guy Davis*, Chainman.

*B. B. Cramer*, Axman.


*Frank Roontz*, Axman.

\_\_\_\_\_, Flagman.

# INDEX

Referring the Lines to the Pages of the Field Notes.

T. 3 North R. 34 East Will. Mer.

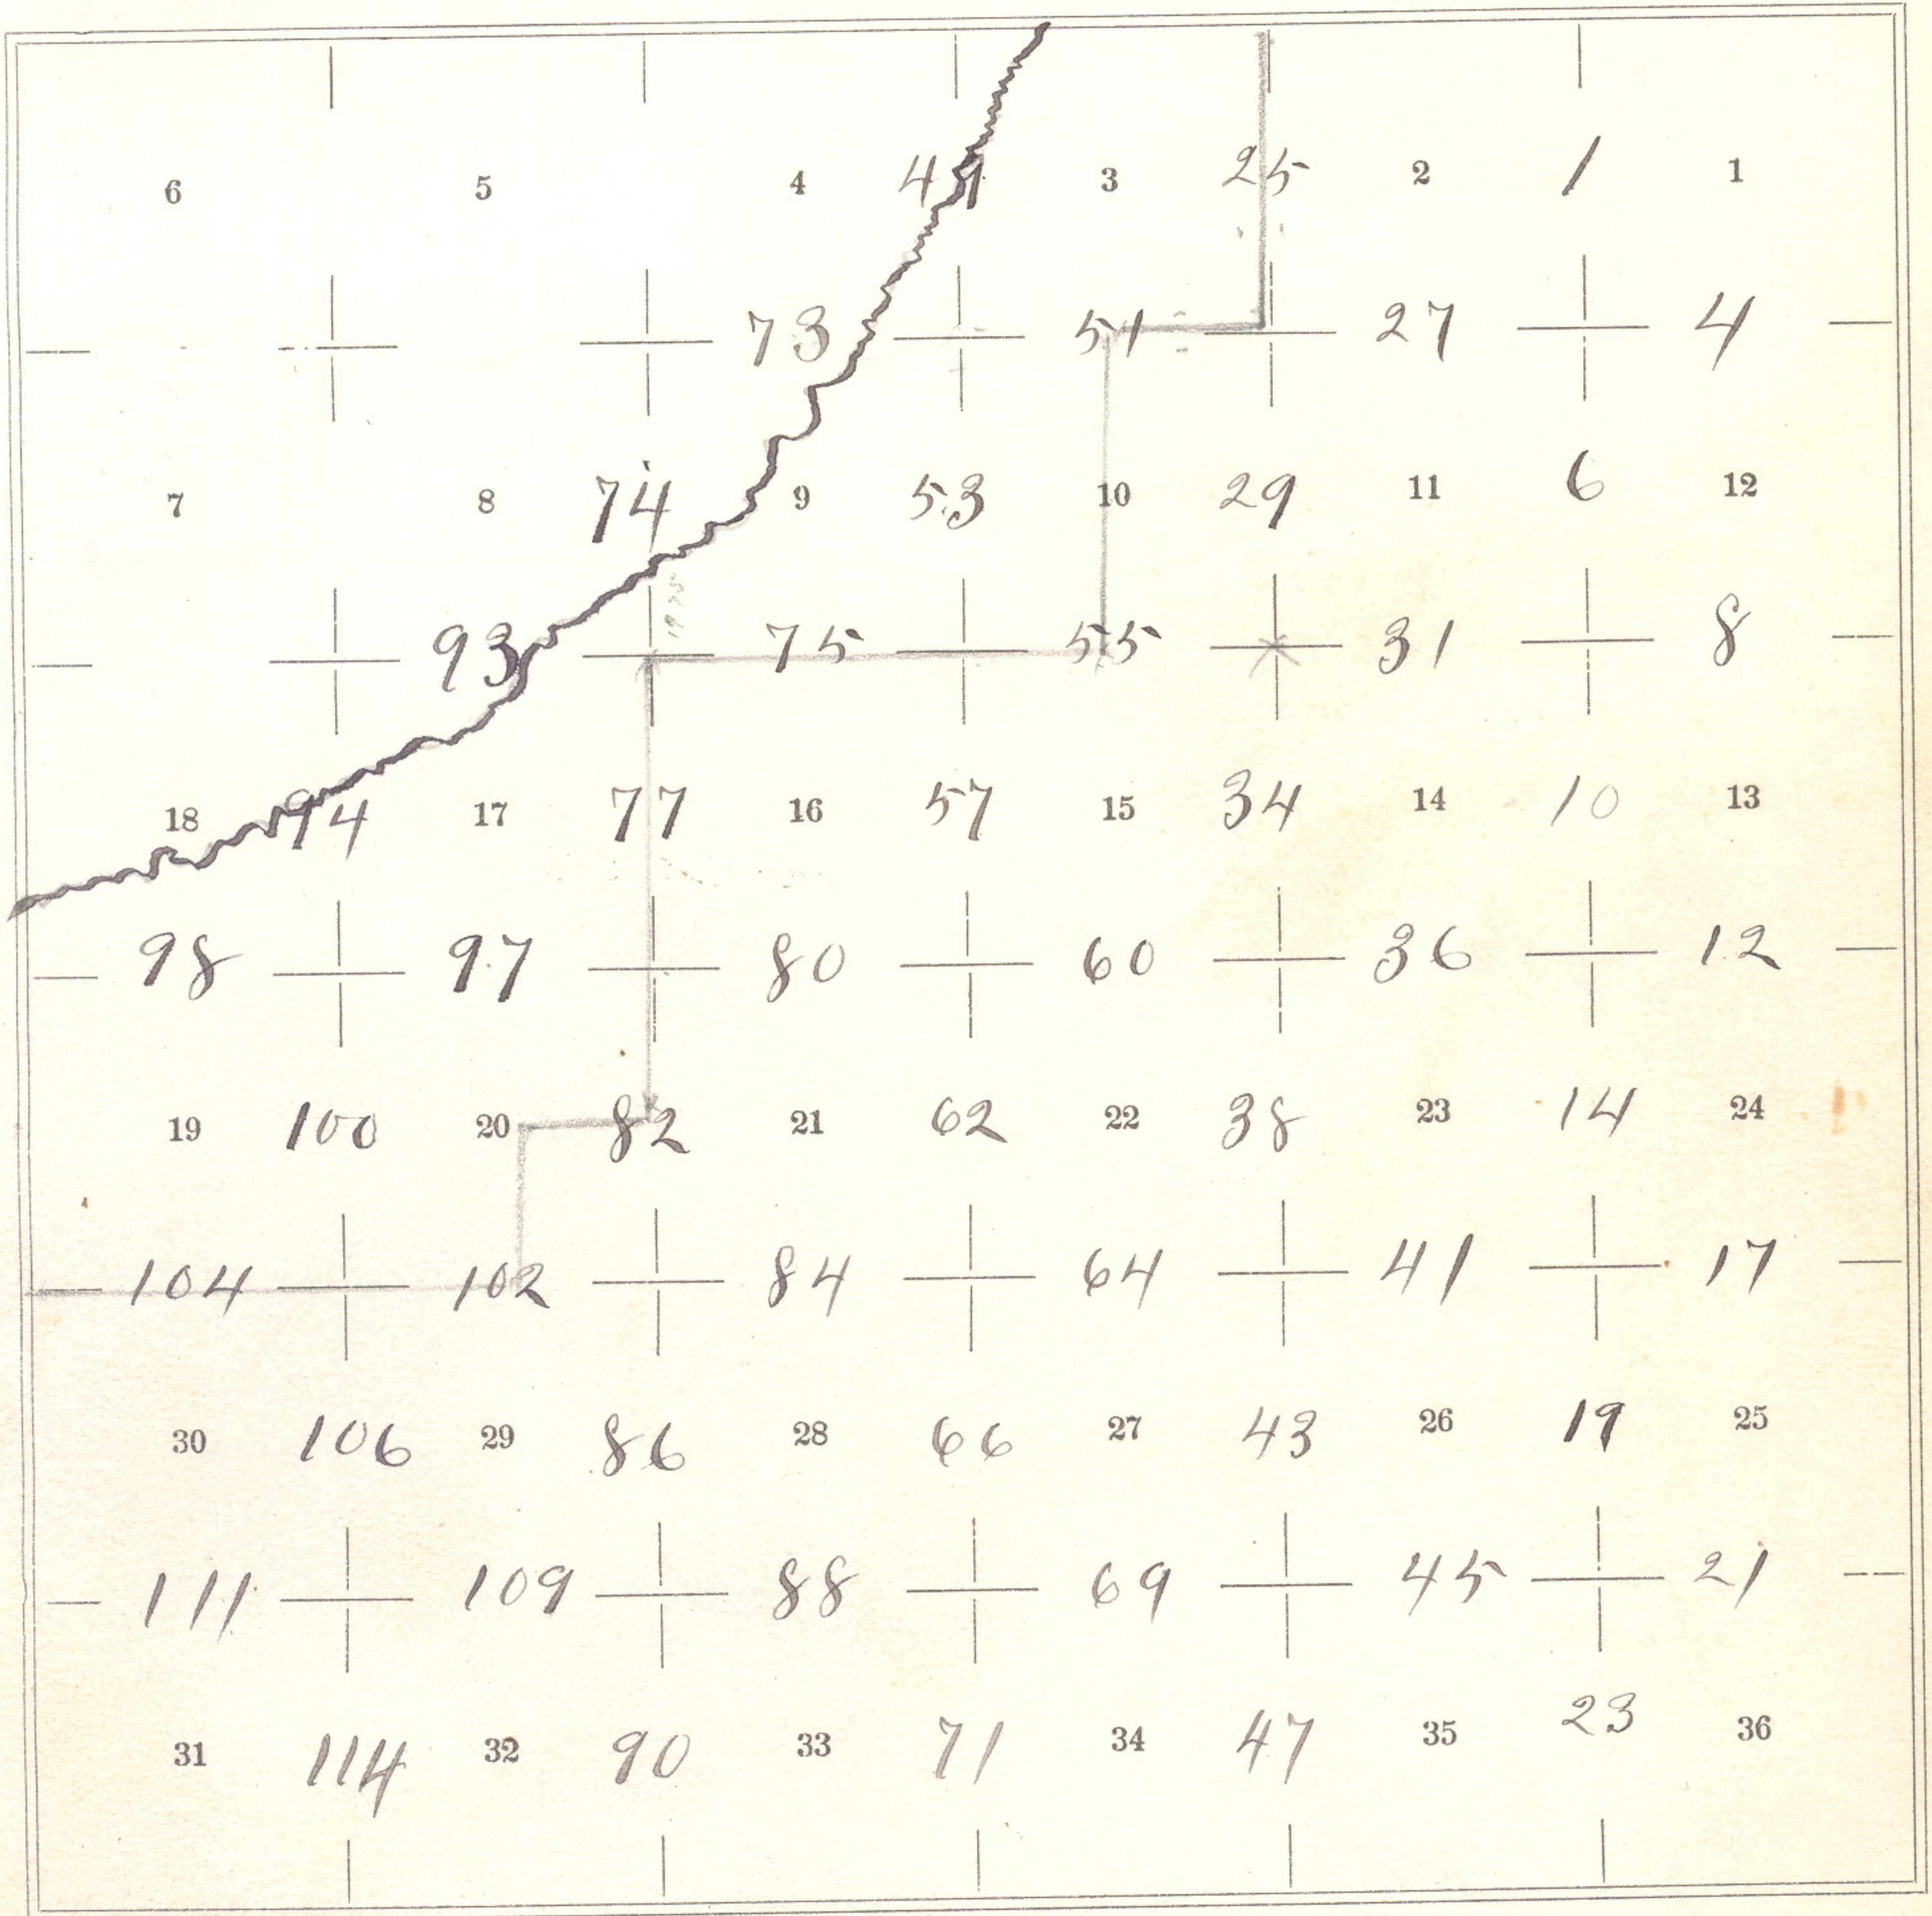

Meanders of \_\_\_\_\_, Pages \_\_\_\_\_ to \_\_\_\_\_

Meanders of \_\_\_\_\_, Pages \_\_\_\_\_ to \_\_\_\_\_

219

Subdivisions of T. 3 North R. 34 East  
 Willamette Meridian, Oregon.

(11-01-1900)

And in S. pit above stake 2 ft.  
 long, 3 ins square 12 ins in  
 the ground marked  $\frac{1}{16}$  Sec on  
 West face.

7940 Cor. to secs. 26, 27, 34 and 35  
 Land rolling Soil generally  
 1st rate  
 Partly cultivated

South bet secs 3 and 4  
 East

commencing at what is claimed  
 to be cor to secs 3, 4, 33 and 34  
 which is stone 8 x 10 x 10 buried  
 in the ground by old settlers  
 living in this vicinity, old  
 post having disappeared.

4000. not finding old cor. I set  
 post 3 ft. long, 3 ins square  
 24 ins in the ground for  
 $\frac{1}{4}$  Sec. cor. dug pits 18 x 18 x 12 ins

# FINAL OATHS FOR SURVEYS.

A list of the names of the individuals employed by James P. Currier  
 294 and Jas. Toland, U. S. Deputy Surveyor, to assist in  
 running, measuring, and marking the lines and corners described in the  
 foregoing field notes of the survey of the  
Subdivisional lines of Township 3 North  
Range 34 East Willamette Meridian, Oregon,  
 showing the respective capacities in which they acted:

- L. F. Wooley....., Compassman.
- J. S. Medley....., Chainman.
- W. H. Medley....., Chainman.
- Frank Belshaw....., Chainman.
- Guy Davis....., Chainman.
- B. B. Cremer....., Axman.
- Frank Hooy....., Axman.
- ....., Flagman.

## FINAL OATHS OF ASSISTANTS.

We hereby certify that we assisted James P. Currier  
and Jas. E. Toland, U. S. Deputy Surveyor, in surveying  
 all those parts or portions of the  
Subdivisional lines of Township 3 North  
Range 34 East Willamette Meridian, Oregon,  
 as represented in the foregoing field notes as having been surveyed by  
 him and under his direction; and that said survey has been in all respects,  
 to the best of our knowledge and belief, well and faithfully surveyed,  
 and the corner monuments established, according to the instructions  
 furnished by the U. S. Surveyor General of Oregon.

- L. F. Wooley....., Compassman.
- J. S. Medley....., Chainman.
- W. H. Medley....., Chainman.
- Frank Belshaw....., Chainman.
- Guy Davis....., Chainman.
- B. B. Cremer....., Axman.
- Frank Hooy....., Axman.
- ....., Flagman.

Subscribed and sworn to before me this 20<sup>th</sup> day of  
August, 1887

[SEAL.] James E. Toland  
U. S. Dept. Surveyor

## FINAL OATH OF DEPUTY SURVEYOR.

Mr. Jas. P. Currier and Jas. Noland, United States  
Deputy Surveyor, do solemnly swear that in pursuance of instructions  
received from Douglas W. Taylor, U. S.  
Surveyor General for Oregon, bearing date of the 13<sup>th</sup>

day of May, 1887, I have well, faithfully,  
and truly, in <sup>our</sup>my own proper person, and in strict conformity with the  
instructions furnished by the U. S. Surveyor General for Oregon, the  
Surveying Manual, and the laws of the United States, surveying all  
those parts or portions of Township 2 North

Range 2 1/4 East  
Willamette Meridian, in the State of Oregon, as are represented in the  
foregoing field notes as having been surveyed by me and under <sup>our</sup>my  
directions; and <sup>we</sup>I do further solemnly swear that all the corners of said  
survey have been established and perpetuated in strict accordance with  
the Surveying Manual, printed instructions, the special written instruc-  
tions of the U. S. Surveyor General for Oregon, and in the specific man-  
ner described in the field notes, and that the foregoing are the *true* field  
notes of such survey, and should any fraud be detected <sup>we</sup>I will suffer the  
penalty of perjury under the provisions of an act of Congress approved  
August 8, 1846.

Jas. E. Noland &  
James P. Currier U. S. Deputy Surveyor. 5

Subscribed and sworn to before me this Fifteenth  
day of February, 1887

A. Woodcock  
Notary Public  
for Oregon

## Office of U. S. Surveyor General,

Portland, Oregon, August 8<sup>th</sup>, 1888.

The <sup>foregoing</sup> following Field Notes of the Survey of the

Subdivisional lines of  
Township 3 North Range  
34 East Will. Mer. Oregon

executed by James P. Currier and James E. McLa  
Special Joint U. S. Dept. Surveyors  
under ~~his~~ Contract No. ———, dated May

4<sup>th</sup>, 1887, having been critically examined,  
the necessary corrections and explanations made, the  
said Field Notes and the survey they describe, are  
hereby approved.

Douglas W. Taylor —  
Surveyor General.