

FIELD NOTES

Of the survey of the

Sub-Subdivisional

Lines of

Township 3 North

Range 34 East

Willamette Meridian,

Oregon, as surveyed by

Jas P Currier & Jas E Moland

U. S. Deputy Surveyor, under his Contract No. _____

dated

May 4th 1887

Survey commenced,

Oct 4th 1887

Survey completed,

Oct 13th 1887

NAMES AND DUTIES OF ASSISTANTS,

L. F. Wooley	, Compassman.
E. G. Perry	, Chainman.
Guy Davis	, Chainman.
J. R. Hadley	, Chainman.
O. C. Raper	, Chainman.
C. Hoars	, Axeman.
J. W. Herndon	, Axeman.
	, Flagman.

PRELIMINARY OATHS OF ASSISTANTS.

We, E. G. Perry, Guy Davis
J. R. Hadley and C. S. Kaper

do solemnly swear that we will faithfully execute the duties of Chain Carriers, that we will level the chain over even and uneven ground, and plumb the tally pins, either by sticking or dropping the same; that we will report the true distance to all notable objects, and the true length of all lines that we will assist in measuring, to the best of our skill and ability, and in accordance with the instructions given us in


the survey of the Sub-Subdivisional

lines of T. 3 North
Range 34 East Willamette Meridian, Oregon.

- E. G. Perry, Chainman.
- Guy Davis, Chainman.
- J. R. Hadley, Chainman.
- C. S. Kaper, Chainman.

Subscribed and sworn to before me, this Fourth

day of October 1887

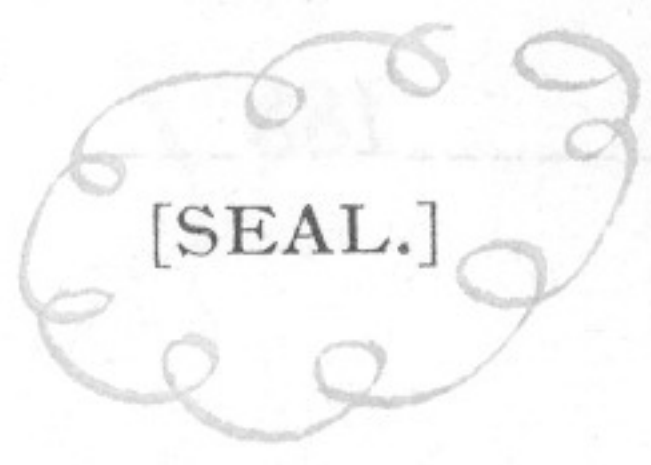

James E. Toland
U. S. Dept. Surveyors

We, E. G. Moses and J. W. Herndon

do solemnly swear that we will well and truly perform the duties of Axemen in the establishment of corners and other duties, according to instructions given us, and to the best of our skill and ability, in the survey of the

Sub-Subdivisional lines
of T. 3 N. R. 34 East Willamette Meridian, Oregon.

- E. G. Moses, Axeman.
- J. W. Herndon, Axeman.

Subscribed and sworn to before me, this Fourth

day of October 1887



James E. Toland
U. S. Dept. Surveyors

INDEX

Referring the Lines to the Pages of the Field Notes.

T. *30 North* R. *34 East* Will. Mer.

					70	34
6	5	4	3		2 68	1 32
					66	30
					64	28
7	8	9	10	<i>96</i>	11 62	12 26
					60	24
					94	58
18	17	16	15	<i>92</i>	14 56	13 20
					90	18
					88	16
19	20	21	22	<i>86</i>	23 50	24 14
					84	12
					82	10
30	29	28	27	<i>80</i>	26 44	25 8
					78	6
					76	4
31	32	33	34	<i>74</i>	35 38	36 2
					72	1

D. R. Bay

Meanders of _____ Pages _____ to _____

Meanders of _____ Pages _____ to _____

Sub-Subdivision of T. 3 North R. 34 East 321

Willamette Meridian, Oregon.

Survey commenced Oct 4th 1887

East on random through S^h of sec 36 T. 3 N. R. 34 East Va. 21° East

Commencing at $\frac{1}{4}$ sec. cor. 20 chains S of $\frac{1}{4}$ sec. cor. between 35th and 36th For temporary $\frac{1}{4}$ sec. cor. at 20, 40, and 60. chains and at

7975 Intersect E. bdy 33 lks. N. of $\frac{1}{4}$ sec. cor. Thence N 89° 46' West on true line

450 Gulch course S - 50

1994 Set basalt stone 14x10x6 ins 9 ins in the ground for $\frac{1}{4}$ sec. cor. marked $\frac{1}{4}$ on N. face. and raised mound of earth and stone 2 ft. high, 3 $\frac{1}{2}$ ft. base. around it

2155 Gulch course S. - 50

3988 Deposited charred stake 12 ins in the ground for $\frac{1}{4}$ sec. cor. dug pits 18x18x12 ins E. and W. of stake

Sub-Subdivision of T. 3 North R. 34 East

Willamette Meridian, Oregon.

(8093-10 M.)

5 1/2 ft. dia. raised mound of earth
1 1/2 ft. high. 3 1/2 ft. base over it
And in center drove stake 2 ft long
2 ins. square, 12 ins. in the ground
marked 1/6 S on N face

5982

Set basalt stone 36 x 20 x 8 ins
firmly in the ground for 1/6
sec. cor. marked 1/6 S on N face
And raised mound of earth
stone 2 ft. high 4 1/2 ft base over
it

7975

To point of beginning
Land rolling
Soil 2nd rate rocky
Good Grass.

East on random through center
of sec. 36

On 20 1/2 East
commencing at 1/4 sec. cor. bet
secs 35 and 36.

Sub-Subdivision of T. 3 North R. 34 East

Willamette Meridian, Oregon.

- 7960 For temporary ~~mark~~ ^{corn} at 20, 40 and 60 chains. And at Intersection of 42 lks. N of 1/4 sec. cor. Thence N. 89° 42' West on true line
- 1990 Deposited charred stake 12 ins in the ground for 1/6 sec. cor. dug pits 18 x 18 x 12 ins E. and W. of stake 5 1/2 ft diam, raised mound of earth 1 1/2 ft high 3 1/2 ft base over it and in E. pit drove stake 2 ft long 2 ins square 12 ins in the ground marked 1/6 South N face
- 2490 Gulch course S. -20
- 3980 Deposited charred stake 12 ins in the ground for 1/4 sec cor dug pits 18 x 18 x 12 ins E. and W. of stake 5 1/2 ft diam, raised mound of earth 1 1/2 ft high 3 1/2 ft base over it and in E. pit drove stake 2 ft long 2 ins square 12 ins in the ground

Sub-Subdivision of T. 3 North R. 34 East

Willamette Meridian, Oregon.

(8093-10 M.)

- 4482 marked $\frac{1}{4}$ S. on N. face
Gulch course S. -20
- 5970 Deposited Charred stake 12 ins in
the ground for $\frac{1}{16}$ sec. cor. dug pits
18 x 18 x 12 ins End N. of stake 5 ft
diam raised mound of earth $\frac{1}{2}$ ft
high $3\frac{1}{2}$ ft base over it in
E. pit drove stake 2 ft long.
2 ins square 12 ins in the ground
marked $\frac{1}{16}$ S. on N. face
- 7960 To point of Commencement
Land rolling Soil 1st rate
Not Cultivated

East on random through
 $\frac{1}{16}$ of sec 36
 Va $20\frac{3}{4}^{\circ}$ East
 Commencing at $\frac{1}{16}$ sec. cor. 20
 chains S of N. W. cor. of sec 36
 For temporary ~~...~~ cor.
 at 20, 40 and 60 chains End at

Sub-Division of T. 3 North R. 34 East

Willamette Meridian, Oregon.

7960 Intersect Q. body. 60 lks N of $\frac{1}{16}$ sec. cor. Thence $N 89^{\circ} 34'$ West on true line

1990 Deposited charred stake 12 ins in the ground for $\frac{1}{16}$ sec cor. dug pits $18 \times 18 \times 12$ ins Q. and H. of stake $5\frac{1}{2}$ ft. diam. raised mound of earth $1\frac{1}{2}$ ft high $3\frac{1}{2}$ ft base over it and in Q. pit drove stake 2 ft long 2 ins square 12 ins in the ground marked $\frac{1}{16}$ S. on N. face,

3980 Deposited charred stake 12 ins in the ground for $\frac{1}{16}$ sec. cor. dug pits $18 \times 18 \times 12$ ins Q. and H. of stake $5\frac{1}{2}$ ft. diam. raised mound of earth $1\frac{1}{2}$ ft high $3\frac{1}{2}$ ft base over it and in Q. pit drove stake 2 ft. long 2 ins square 12 ins in the ground marked $\frac{1}{16}$ S. on N. face

4200 Inter Indians field N. and S.

5180 gave same " "

Sub-Subdivisions of T. 3 North R. 34 East
Willamette Meridian, Oregon.

(8093-10 M.)

5976 Deposited charred stakes 12 ins
in the ground for $\frac{1}{4}$ sec. cor.
dug pits 18 x 18 x 12 ins E. and W.
of stake 5 $\frac{1}{2}$ ft dist raised mound
of earth 1 $\frac{1}{2}$ ft high 3 $\frac{1}{2}$ ft base
over it and in E. pit drove
stake 2 ft long 2 ins square
12 ins in the ground marked
 $\frac{1}{4}$ S. or N. face

7968 To point of beginning
Land mostly level
Soil 1 $\frac{1}{2}$ rate

East on random through
S $\frac{1}{2}$ of sec. of sec. 25
W $20\frac{3}{4}^{\circ}$ East.

Commencing at $\frac{1}{4}$ sec. cor. 20 chains
N. of S. W. cor. of sec 25
S. of temporary $\frac{1}{4}$ sec. cor.
at 20.40 and 60 chains and at

7956 Intersect E. bdy. 60th N. of

Sub Subdivision of E. 3 North R. 34 East

Willamette Meridian, Oregon.

1/2 sec. cor. Thence N. 89° 34' W.
on true line

1989 Deposited charred stake 12 ins in
the ground for 1/2 sec. cor. dug pits
18 x 18 x 12 ins. End of stake 5 1/2 ft dia
raised mound of earth 1 1/2 ft high 3/4 ft
base over it and in Espiridove state
2 ft long. 2 ins square 12 ins in the
ground marked 1/2 S. on N. face

3978 Deposited charred stake 12 ins in
the ground for 1/2 sec. cor. dug pits
18 x 18 x 12 ins. End of stake 5 1/2 ft dia
raised mound of earth 1 1/2 ft high 3/4 ft base
over it and in Espiridove state 2 ft
long 2 ins square 12 ins in the
ground marked 1/2 S. on N. face

5967 Deposited charred stake 12 ins in
the ground for 1/2 sec. cor. dug pits
18 x 18 x 12 ins. End of stake 5 1/2 ft dia
raised mound of earth 1 1/2 ft high
3/4 ft base over it and in Espiridove.

J

328

Sub-Subdivision of T. 3 North R. 39 East

Willamette Meridian, Oregon.

(8093-10 M.)

Stake 2 ft long 2 ins square 12 ins in the ground marked $\frac{1}{16}$ S on N face

7956 To point of beginning
Land mostly level
partly cultivated

East on random through
Center of sec. 25.
Va. $20\frac{1}{2}^{\circ}$ East

Commencing at $\frac{1}{4}$ sec. cor. bet sec 25 and 26 Set temporary
course at 20.40 and 60 chain and at

7940 Intersect Q. by 70 lks N. of $\frac{1}{4}$ sec. cor. Thence N. $89^{\circ}30'$ West on true line

1985 Deposited charred stake 12 ins in the ground for $\frac{1}{16}$ sec. cor. dug pits 18 x 18 x 12 ins End N. of stake $5\frac{1}{2}$ ft dist raised mound of earth $1\frac{1}{2}$ ft high $8\frac{1}{2}$ ft base over iron in Q. bit drive

Sub Township T. 3 North R. 34 East

Willamette Meridian, Oregon.

- 3970 stake 2 ft long 2 ins square 12 ins in the ground marked $\frac{1}{4}$ S. on N. face
 Deposited charred stake 12 ins in the ground for $\frac{1}{4}$ sec. cor, dug pits 18x18x12 ins Q. and N. of stake 5 $\frac{1}{2}$ ft. dist. raised mound of earth 1 $\frac{1}{2}$ ft high 3 $\frac{1}{2}$ ft base over it and in Q. pit drove stake 2 ft long 2 ins square 12 ins in the ground marked $\frac{1}{4}$ S. on N. face
- 5955 Deposited charred stake 12 ins in the ground for $\frac{1}{6}$ sec. cor, dug pits 18x18x12 ins Q. and N. of stake 5 $\frac{1}{2}$ ft. dist. raised mound of earth 1 $\frac{1}{2}$ ft high 3 $\frac{1}{2}$ ft base over it and in Q. pit drove stake 2 ft long 2 ins square 12 ins in the ground marked $\frac{1}{6}$ S. on N. face
- 7940 To point of beginning
 Land level Soil 1st rate
 Partly Cultivated

Subdivisions of T. 3 North R. 34 East

Willamette Meridian, Oregon.

(8093-10 M.)

Coast on random through N¹/₂ of
see 25.

ra 20¹/₄° East

Commencing at ¹/₁₆ sec. cor. 20 chains
N. of ¹/₄ sec. cor. bet sees 25 and 26
Set temporary ~~...~~ cor.
at 20, 40 and 60 chains and at

1935 Intersect O. bay. 70 lbs N. of ¹/₁₆
sec. cor. Thence N. 89° 30' W.
on true line

1984 Deposited charred stake 12 ins in the
ground for ¹/₁₆ sec cor, dug pits
18x18x12 ins and N. of stake 5¹/₂
ft dist. raised mound of
earth 1¹/₂ ft high 3¹/₂ ft base
over it and in C. pit drove
stake 2 ft long 2 ins square
12 ins in the ground, marked
¹/₁₆ S, on N. face

3968 Deposited charred stake 12 ins
in the ground for ¹/₁₆ sec. cor.

Sub-Subdivision of T. 3 North R. 34 East

Willamette Meridian, Oregon.

dug pits 18 x 18 x 12 ins @ Quad N of stake 5 1/2 ft. diam. raised mound of earth 1 1/2 ft high 3 1/2 ft base over it @ Quad in E. pier drove stake 2 ft long 2 ins square 12 ins in the ground marked 1/6 S on N. face

5952

Deposited charred stake 12 ins in the ground for 1/6 sec cor. dug pits 18 x 18 x 12 ins @ Quad N. of stake 5 1/2 ft. diam raised mound of earth 1 1/2 ft high 3 1/2 ft base over it @ Quad in E. pier drove stake 2 ft long 2 ins square 12 ins in the ground marked 1/6 S on N. face

7935

Top point of beginning land level. Soil 1st rate Partly cultivated

Sub Subdivision of T. 3 North R. 34 East

Willamette Meridian, Oregon.

(8093-10 M.)

Coast on random through
S¹/₂ of sec 24

Va 2.0° East.

Commencing at ¹/₆ sec, cor. 20
chains N. of S. N. cor of sec 24
For temporary ~~in~~ cor.
at 20, 40 and 60 chains and at

1940 Intersect E by 70 lbs N of
¹/₆ sec, cor. Thence N. 89° 30' W,
on true line

1985 Deposited charred stake 12
ins in the ground for ¹/₆
sec, cor, dug pits 18 x 18 x 12
ins End W. of stake 5 1/2 ft
dist. raised mound of
earth 1 1/2 ft high 8 1/2 ft base
over it and in E side drove
stake 2 ft long 2 ins square
12 ins in the ground marked
¹/₆ S. on N. face

Sub-Subdivision of T. 3 North R. 34 East

Willamette Meridian, Oregon.

3970 Deposited charred stake 12 ins in the ground for $\frac{1}{16}$ sec. cor. dug pits 18 x 18 x 12 ins. Q. and H. of stake 5 1/2 ft dist raised mound of earth 1 1/2 ft high 3 1/2 ft base over it and in Q. pit drove stake 2 ft long 2 ins square 12 ins in the ground marked $\frac{1}{16}$ S. on N. face

5955 Deposited charred stake 12 ins in the ground for $\frac{1}{16}$ sec. cor. dug pits 18 x 18 x 12 ins. Q. and H. of stake 5 1/2 ft dist raised mound of earth 1 1/2 ft high 3 1/2 ft base over it and in Q. pit drove stake 2 ft long 2 ins square 12 ins in the ground marked $\frac{1}{16}$ S. on N. face

7940 To point of beginning
 Land pretty rolling
 Soil good
 Well adapted to cultivation

Sub-Subdivision of T. 3 North R. 34 East
Willamette Meridian, Oregon.

(8093-10 M.)

East on random through
Center of sec 24
Va 21° East

Commencing at 1/4 sec. cor. bet
secs 23 and 24
Set temporary ~~reference~~ ~~corners~~
at 20, 40 and 60 chains and at

1948 Intersect E. bdy 63 lks N of
1/4 sec. cor. Thence N 89° 33' W
on true line

1987 Deposited charred stake
12 ins in the ground for
1/6 sec. cor. dug pits 18x18x12
ins E. and W. of stake 5 1/2 ft
diam. raised mound of
earth 1 1/2 ft high 3 1/2 ft. base
over it and in E. pin drove
stake 2 ft long 2 ins square
12 ins in the ground
marked 1/6 S on N. face

2920 Hagow road N. and S.

Sub-Subdivision of T. 3 North R. 34 East.

Willamette Meridian, Oregon.

- 3974 Deposited charred stakes 12 ins
in the ground for $\frac{1}{4}$ sec. cor.
dug pits 18 x 18 x 12 ins Q. Red It.
of stake 5 $\frac{1}{2}$ ft. dia. raised
mound of earth 1 $\frac{1}{2}$ ft high
3 $\frac{1}{2}$ ft. base over it and in Q. pin
drove stake 2 ft long, 2 ins square
12 ins in the ground marked
 $\frac{1}{4}$ S. on N. face.
- 5961 Deposited charred stakes 12 ins
in the ground for $\frac{1}{16}$ sec. cor.
dug pits 18 x 18 x 12 ins Q. Red It.
of stake 5 $\frac{1}{2}$ ft. dia. raised mound
of earth 1 $\frac{1}{2}$ ft high 3 $\frac{1}{2}$ ft base
over it and in Q. pin drove stake
2 ft long 2 ins square 12 ins
in the ground marked
 $\frac{1}{16}$ S. on N. face
- 7948 To point of beginning
land mostly level
Soil 1st rate

Sub-Division of T. 3 North R. 3 & 4 North

Willamette Meridian, Oregon.

(8093-10 M.)

East on ran through $N\frac{1}{2}$ of sec 24

on 21° East

Commencing at $\frac{1}{4}$ sec. cor. 20 chains N of $\frac{1}{4}$ sec. cor. bet sec 23 and 24 Set temporary $\frac{1}{4}$ sec. cor. at 20, 40 and 60 chains and at

1952 Intersect E. by 70 kts. N. of $\frac{1}{4}$ sec cor. Thence $N 90^{\circ} 30'$ West on true line

1988 Deposited charred stake 12 ins in the ground for $\frac{1}{4}$ sec cor dug pits $18 \times 18 \times 12$ ins E and N of stake $5\frac{1}{2}$ ft dist raised mound of earth $1\frac{1}{2}$ ft. high $3\frac{1}{2}$ ft base over it and in E pine grove stake 2 ft long 2 ins square 12 ins in the ground marked $\frac{1}{4}$ S. on N. face

Sub-Subdivisions of T. 3 North R. 94 East
Willamette Meridian, Oregon.

3976 Deposited charred stake 12 ins. in
the ground for $\frac{1}{16}$ sec. cor.
dug pits 18 x 18 x 12 ins C. Q. Ad It.
of stake $5\frac{1}{2}$ ft. dist. raised mound
of earth $1\frac{1}{2}$ ft high $3\frac{1}{2}$ ft base
over it and in C. pit drove stake
2 ft long 2 ins square 12 ins
in the ground marked $\frac{1}{16}$ S
on N. face.

5964 Deposited charred stake 12 ins in
the ground for $\frac{1}{16}$ sec. cor. dug
pits 18 x 18 x 12 ins C. Q. Ad It. of
stake $5\frac{1}{2}$ ft. dist. raised mound
of earth $1\frac{1}{2}$ ft high $3\frac{1}{2}$ ft base
over it and in C. pit drove stake
2 ft long 2 ins square 12 ins in
the ground marked $\frac{1}{16}$ S on N. face

7952 To point of beginning
Sand level Soil 1st Grade
Cultivated

Oct-4-1887

78 338

Sub-Subdivision of T. 2 North R. 24 East

Willamette Meridian, Oregon.

(8093-10 M.)

East on random through
S^h of sec 13

Pa 21° East

Commencing at $\frac{1}{4}$ sec. cor. 20
chains N. of S. W. cor. of sec
13. Set temporary $\frac{1}{4}$ sec. cor.
at 20, 40 and 60 chains and at

1944

Intersect E. by 49 lbs N of
 $\frac{1}{4}$ sec cor Thence N 89° 39' W.
on true line

1875

Drill and leave field

1986

Deposited charred stake
12 ins in the ground for
 $\frac{1}{4}$ sec. cor. dug pits 18 x 18 x 12
ins E and W of stake 5 $\frac{1}{2}$ ft diam
raised mound of earth 1 $\frac{1}{2}$ ft
high 3 $\frac{1}{2}$ ft base over it and
in E. pit drove stake 2 ft long
2 ins square 12 ins in the ground
marked $\frac{1}{4}$ Sec N. face

Sub-Subdivisions of T. 3 North R. 34 East
Willamette Meridian, Oregon.

3972 Deposited charred stake 12 ins in
the ground for $\frac{1}{16}$ sec. cor. dug
pits 18x18x12 ins East and West
of stake $5\frac{1}{2}$ ft dist raised mound
of earth $1\frac{1}{2}$ ft high $3\frac{1}{2}$ ft base
over it and in \odot pit drove stake
2 ft long 2 ins square 12 ins
in the ground. marked
 $\frac{1}{16}$ S. on N. face

5955 Deposited charred stake 12 ins
in the ground for $\frac{1}{16}$ sec. cor.
dug pits 18x18x12 ins \odot and \odot
of stake $5\frac{1}{2}$ ft dist raised mound
of earth $1\frac{1}{2}$ ft high $3\frac{1}{2}$ ft base over it
and in \odot pit drove stake 2 ft.
long 2 ins square 12 ins in
the ground marked $\frac{1}{16}$ S.
on N. face.

7944 To point of beginning
sand rolling Soil good
Cultivated

28 340

Sub-Subdivisions of T. 2 North R. 34 East.

Willamette Meridian, Oregon.

(8093-10 M.)

East on random through
Center of sec of sec 13
Pa 20 1/2 East

Commencing at 1/4 sec. cor. bet
secs 13 and 14. Set temporary
in sec. cor. at 20.40 and 60 chains Pa at

1942 Intersect E. bdy. 42 lbs N. of 1/6
sec. cor. Thence N 89 42' West
on true line

1600 Spring branch 5 lbs wide runs N. W.

1775 Outer yard of dwelling

1980 Dwelling House of Mr. O. Dave

1985 point of 1/6 sec. cor. is under house

and set charred stake 12 ins in
the ground. 25 lbs due S of true
cor. for witness cor. dug pits
18 x 18 x 12 ins E. and N. of stake
5/8 ft dist raised mound of
earth 1 1/2 ft high. 3 1/2 ft base
over it and in E. side drove stake
2 ft long 2 ins square 12 ins in

Sub-Subdivision of T. 30 North R. 34 East
 Willamette Meridian, Oregon.

- in the ground marked $\frac{1}{6}$ S. W. C
 on N. face
- 2450 Barn and Hay-mow 50 ft wide
- 3971 Deposited charred stake 12 ins
 in the ground for $\frac{1}{4}$ sec. cor.
 dug pits 18 x 18 x 12 ins. $\frac{1}{2}$ in. of stake
 $5\frac{1}{2}$ ft. diam. raised mound of earth
 $1\frac{1}{2}$ ft high $3\frac{1}{2}$ ft base over it $\frac{1}{2}$ in
 $\frac{1}{2}$ in. drove stake 2 ft long 2 ins
 square 12 ins in the ground
 marked $\frac{1}{4}$ S. on N. face
- 5956 Deposited charred stake 12 ins in the
 ground for $\frac{1}{6}$ sec. cor. dug pits
 18 x 18 x 12 ins. $\frac{1}{2}$ in. of stake $5\frac{1}{2}$ ft.
 diam raised mound of earth $1\frac{1}{2}$ ft.
 high. $3\frac{1}{2}$ ft. base over it $\frac{1}{2}$ in
 $\frac{1}{2}$ in. drove stake 2 ft long 2 ins
 square 12 ins in the ground
 marked $\frac{1}{6}$ S. on N. face
- 7942 To point of beginning
 Land mostly level Soil good.

22

342

Sub-Division of T. 3 North R. 34 East

Willamette Meridian, Oregon.

(8093-10 M.)

East on random through
N^h of sec. 13

Pa 20° East

Beginning at $\frac{1}{4}$ sec. cor. 20 chains
N. of $\frac{1}{4}$ sec. cor. bet sec 13rd & 14th
Set temporary $\frac{1}{4}$ sec. cor.
at 20, 40th and 60 chainsrd and at

1944 Intersect Eddy. 35 lbs of $\frac{1}{4}$
sec. cor. Thence N 89° 45' West
on true line

1986 Deposited charred stake 12 ins
in the ground for $\frac{1}{4}$ sec. cor.
dug pits 18x18x12 ins End N.
of stake 5 $\frac{1}{2}$ ft dist raised
mound of earth 1 $\frac{1}{2}$ ft.
high 3 $\frac{1}{2}$ ft base over it
and in E. side drove stake
2 ft long 2 ins square 12 ins
in the ground marked
 $\frac{1}{4}$ S. on N. face

2800 Wagon road N and S.

Sub-Subdivision of T. 3 North R. 34 East

Willamette Meridian, Oregon.

3200 Spring branch 5 lbs N. W. corner

3972 Deposited charred stake 12 ins in the ground for 1/4 sec. cor. dug pits 18x18x12 ins E. and W. of stake 5 1/2 ft. dist. raised mound of earth 1 1/2 ft high 3 1/2 ft base over it and in E. pit drove stake 2 ft long 2 ins square 12 ins in the ground marked 1/4 S. N. face

5958 Deposited charred stake 12 ins in the ground for 1/4 sec. cor. dug pits 18x18x12 ins E. and W. of stake 5 1/2 ft. dist. raised mound of earth 1 1/2 ft high 3 1/2 ft base over it and in E. pit drove stake 2 ft long 2 ins square 12 ins in the ground marked 1/4 S. N. face

7944 To point of beginning.
Land level Soil 1st rate
Cultivated

24

344

Sub-Subdivision of T. 3 North R. 84 East

Willamette Meridian, Oregon.

(8093-10 M.)

East on random through
S^h of sec 12

Va 20° East

Beginning at $\frac{1}{4}$ sec. cor. 20 chains
N of S. W. cor of sec 12
Set temporary $\frac{1}{4}$ sec. cor.
at 20, 40 and 60 chains and at

7964 Intersect E. bdy 25 lbs N of
 $\frac{1}{4}$ sec. cor. Thence N. 29° 49' W.
on true line

1991 Deposited charred stakes 12 ins.
in the ground for $\frac{1}{4}$ sec. cor.
dug pits 18 x 18 x 12 ins E & N
of stake 5 $\frac{1}{2}$ ft dia raised
mound of earth 1 $\frac{1}{2}$ ft high
3 $\frac{1}{2}$ ft base over it and in
E. pit drove stake 2 ft
long 2 ins square 12 ins
in the ground marked
 $\frac{1}{4}$ S. on N. face

Sub-Subdivisions of T. 2 North R. 39 East
 Willamette Meridian, Oregon.

3982

Deposited charred stake 12 ins in
 the ground for $\frac{1}{16}$ sec. cor. dug pit
 18 x 18 x 12 ins Eastrd West of stake
 5 $\frac{1}{2}$ ft. dia. raised mound of earth
 1 $\frac{1}{2}$ ft high 3 $\frac{1}{2}$ ft base over it ^{and in}
 E. pit drove stake 2 ft long, 2 ins square
 12 ins in the ground marked $\frac{1}{16}$
 S on N. face.

5973

Set post 2 ft long, 3 ins square
 29 ins in the ground for $\frac{1}{16}$ sec.
 cor. marked $\frac{1}{16}$ S on N. face
 dug pits 18 x 18 x 12 ins E. rd W.
 of post 5 $\frac{1}{2}$ ft. dia. raised
 mound of earth 1 $\frac{1}{2}$ ft high
 3 $\frac{1}{2}$ ft base around post.

7964

To point of beginning
 and level soil 1st rate
 All Cultivated

Sub-Subdivision of T. 3 North R. 34 East
 Willamette Meridian, Oregon.

(8093-10 M.)

East on random through
 Center of sec 12
 Pa. $20\frac{1}{2}$ E

Commencing at $\frac{1}{4}$ sec cor
 bet sees. 11 and 12

Set temporary ~~at~~ cor.
 at 20.40 and 60 chains out at

1970 Intersect body 12 lbs. N. of
 $\frac{1}{4}$ sec cor. Thence $N. 89^{\circ} 55' W.$
 on true line

1992 Deposited charred stake
 12 ins in the ground for
 $\frac{1}{4}$ sec cor. dug pits $18 \times 18 \times 12$
 ins E. and W. of stake $5\frac{1}{2}$ ft
 dia. raised mound of earth
 $1\frac{1}{2}$ ft. high. $3\frac{1}{2}$ ft base over
 it and in E. side drove
 stake 2 ft long 2 ins
 square 12 ins in the ground
 marked $\frac{1}{4}$ S. on N. face

Sub-Subdivision of T. 3 North R. 94 East
 Willamette Meridian, Oregon.

- 3985 Deposited charred stake 12 ins
 in the ground for $\frac{1}{4}$ sec. cor.
 dug pits 18x18x12 ins End N.
 of stake $5\frac{1}{2}$ ft. dist. raised
 mound of earth $1\frac{1}{2}$ ft high
 $3\frac{1}{2}$ ft base over it End in E pit
 drove stake 2 ft long 2 ins
 square 12 ins in the ground
 marked $\frac{1}{4}$ S on N. face
- 5977 Sep basalt stone 24x10x10 ins
 18 ins in the ground for $\frac{1}{16}$
 sec cor marked $\frac{1}{16}$ on N face
 dug pits 18x18x12 ins End
 N of stone $5\frac{1}{2}$ ft. dist raised
 mound of earth $1\frac{1}{2}$ ft high
 $3\frac{1}{2}$ ft base over it
- 7970 To point of beginning
 Land slightly rolling
 Soil 1st rate
 All cultivated

Sub-Subdivision 3 North R. 34 East.

Willamette Meridian, Oregon.

(8093-10 M.)

East on random through
N^h of sec 12
Pa. 21° East.

Commencing at $\frac{1}{16}$ sec. cor.
20 chains N of $\frac{1}{4}$ sec cor between
11th and 12th lot temporary
cors at 20.40th and 60 chains
and at

1977 Intersect E bay at $\frac{1}{16}$ sec. cor.
Thence West on true line

1994 Deposited marked stake 12 ins
in the ground for $\frac{1}{16}$ sec cor.
dug pits 18x18x12 ins End
West of stake 5 $\frac{1}{2}$ ft dist
raised mound of earth
1 $\frac{1}{2}$ ft high 3 $\frac{1}{2}$ ft base over
it and in E side drove stake
2 ft long 2 ins square 12 ins
in the ground marked
 $\frac{1}{16}$ S on N. face

Subdivision of T. 2 North R. 34 East

Willamette Meridian, Oregon.

- 3988 Deposited charred stake 12
ins in the ground for $\frac{1}{16}$ sec
cor dig pits 18x18x12 ins
E. end N. of stake $5\frac{1}{2}$ ft. dist.
raised mound of earth $1\frac{1}{2}$
ft high $3\frac{1}{2}$ ft base over in
end in E pit drove stake
2 ft long 2 ins square
12 ins in the ground marked
 $\frac{1}{16}$ S. on N. face.
- 5982 Set post 0 ft long 3 ins square
24 ins in the ground for $\frac{1}{16}$ sec
cor. marked $\frac{1}{16}$ S. on N. face
dig pits 18x18x12 ins E. end N.
of stake $5\frac{1}{2}$ ft. dist. raised
mound of earth $1\frac{1}{2}$ ft high
 $3\frac{1}{2}$ ft base around post
- 7977 To point of beginning
Land mostly level
Soil var rate
all cultivated

Sub-Subdivision of T. 3 North R. 94 East

Willamette Meridian, Oregon.

(8098-10 M.)

East on ran. through S 1/2 of sec. 1
on 21° East

Commencing at 1/4 sec. cor. 20 chains N. of S. W. cor. of sec 1 Set temporary cor at 20.40 and 60 chains and at

7992 Intersect E. bdy 10 th S. of 1/4 sec. cor. Thence S 89° 56' W. on true line

1998 Deposited charred stake 12 ins in the ground for 1/4 sec. cor. dug pits 18x18x12 ins End of stake 5 1/2 ft dia raised mound of earth 1 1/2 ft high 3 1/2 ft base overlaid in spiral drove stake 2 ft long 2 ins square 12 ins in the ground marked 1/4 S on N. face

Sub-Subdivisions of T. 3 North R. 34 East
Willamette Meridian, Oregon.

3996

Deposited charred stake 12 ins
in the ground for $\frac{1}{16}$ sec. cor.
dug pits 18 x 18 x 12 ins Q. and H.
of stake 5 $\frac{1}{2}$ ft dist. raised mound
of earth 1 $\frac{1}{2}$ ft high 3 $\frac{1}{2}$ ft base
over it and in C. pit drove
stake 2 ft long 2 ins square
12 ins in the ground marked
 $\frac{1}{16}$ S on N. face

5994

Deposited charred stake 12 ins in
the ground for $\frac{1}{16}$ sec. cor. dug
pits 18 x 18 x 12 ins Q. and H. of
stake 5 $\frac{1}{2}$ ft dist. raised mound
of earth 1 $\frac{1}{2}$ ft high 3 $\frac{1}{2}$ ft base
over it and in C. pit drove
stake 2 ft long 2 ins square
12 ins in the ground
marked $\frac{1}{16}$ S on N. face

7992

To point of beginning
Land level Soil good
All cultivated

Sub-Subdivision of T. 3 North R. 34 East
 Willamette Meridian, Oregon.

(8093-10 M.)

Over on random through
 Center of sec 1

to a 21° East

Beginning at $\frac{1}{4}$ sec corner
 sec 1 and 2 Set temp $\frac{1}{4}$ sec
 corner, at 20.40 and 60 chains
 and at

1990 Intersect C. body at $\frac{1}{4}$ sec
 cor. Thence West on true
 line

1998 Deposited charred stake 12
 ins in the ground for $\frac{1}{6}$
 sec. cor. dug pits 18 x 18 x 12
 ins E. and N. of stake
 $5\frac{1}{2}$ ft. diam raised mound
 of earth 1 $\frac{1}{2}$ ft high $3\frac{1}{2}$ ft
 base over it and in C. per
 drove stake 2 ft long 2 ins
 square 12 ins in the ground
 marked $\frac{1}{6}$ S on N. face

Sub-Division of T. 3 North R. 34 East

Willamette Meridian, Oregon.

3995 Deposited charred stake 12 ins
 in the ground for $\frac{1}{4}$ sec cor.
 dug pits 18 x 18 x 12 ins Q. and H. of
 stake $5\frac{1}{2}$ ft dia. raised mound
 of earth $1\frac{1}{2}$ ft high $3\frac{1}{2}$ ft base
 over it and in Q. pit drove stake
 2 ft long 2 ins square 12 ins
 in the ground & marked
 $\frac{1}{4}$ S. on N. face

5992 Deposited charred stake 12 ins
 in the ground for $\frac{1}{6}$ sec cor. dug
 pits 18 x 18 x 12 ins Q. and H. of stake
 $5\frac{1}{2}$ ft dia. raised mound of earth
 $1\frac{1}{2}$ ft high $3\frac{1}{2}$ ft base over it
 and in Q. pit drove stake 2 ft
 long 2 ins square 12 ins
 in the ground marked
 $\frac{1}{6}$ S. on N. face

7990 Topoint of beginning
 Soil 1st rate sand level
 All cultivated

34
354

Sub-Subdivision of T. 3 North R. 34 East
Willamette Meridian, Oregon.

(8093-10 M.)

Case on random through
N¹/₂ face. 1

Pa 2 1/4° East

Beginning at 1/6 sec cor 20
chains N of 1/4 sec cor, between
Set temporary ^{1/4}/₁₆ sec cor,
at 20, 40 and 60 chains and at

1996 Intersect E bay 4th N of 1/6 sec
cor. Thence N. 89° 57' E. on
true line

50 Thence N and S and enter field

1999 Deposited charred stake 12 ins
in the ground for 1/6 sec cor,
dug pits 18 x 18 x 12 ins E. and W.
of stake 5 1/2 ft dist. raised
mound of earth 1 1/2 ft high
8 1/2 ft base over it and in E pit
drove stake 2 ft long 2 ins
square 12 ins in the ground
marked 1/6 S on N face

Sub Survey of T. 2 North R. 34 East

Willamette Meridian, Oregon.

3998 Deposited charred stake 12 ins in the ground for $\frac{1}{4}$ sec cor dug pits 18x18x12 ins E. and N. of stake $5\frac{1}{2}$ ft dia raised mound of earth $1\frac{1}{2}$ ft high $3\frac{1}{2}$ ft base over it And in E. side drove stake 2 ft long 2 ins square 12 ins in the ground marked $\frac{1}{4}$ S on N. face

5997 Deposited charred stake 12 ins in the ground for $\frac{1}{4}$ sec cor dug pits 18x18x12 ins E. and N. of stake $5\frac{1}{2}$ ft dia raised mound of earth $1\frac{1}{2}$ ft high $3\frac{1}{2}$ ft base over it And in E. side drove stake 2 ft long 2 ins square 12 ins in the ground marked $\frac{1}{4}$ S. on N. face

7996 To point of beginning
 Land slightly rolling
 No water. Soil 4th rate
 All cultivated. Good farming land
 Oct 5 - 1887

Sub-Subdivision of T. 3 North R. 34 East
Willamette Meridian, Oregon.

(8093-10 M.)

East on random through $\frac{1}{4}$ of sec 35
to 21° East

Commencing at $\frac{1}{4}$ sec. cor.
20.00 chains S. of $\frac{1}{4}$ sec. cor. bet.
secs 34 and 35

Set temporary $\frac{1}{4}$ sec. cor.
at 20.40 and 60 chains and at

7980

Intersect Q. bdy. 7 lks. N. of
 $\frac{1}{4}$ sec. cor. Thence N 89 $^{\circ}$ 57' W
on true line

1995

Deposited charred stake 12 ins
in the ground. for $\frac{1}{4}$ sec. cor.
dug pits 18 x 18 x 12 ins Q. and N.
of stake $5\frac{1}{2}$ ft. diam. raised
mound of earth $1\frac{1}{2}$ ft high
 $3\frac{1}{2}$ ft base over it and in Q. dir
drove stake 2 ft long 2 ins
square 12 ins. in the ground
marked $\frac{1}{4}$ Sec. on N. face.

Sub-Subdivision of T. 3 North R. 34 East
Willamette Meridian, Oregon.

3990 Deposited charred stake 12 ins in
the ground for $\frac{1}{4}$ sec. cor. dug pits
18 x 18 x 12 ins E. and W. of stake
5 $\frac{1}{2}$ ft. dist raised mound of
earth 1 $\frac{1}{2}$ ft. high 3 $\frac{1}{2}$ ft. base
over it. And in E. pin drove
stake 2 ft long 2 ins square
12 ins in the ground marked
 $\frac{1}{4}$ S. on N. face

5900 P. on E. side Enter Indian field

5985 Deposited charred stake 12 ins
in the ground for $\frac{1}{4}$ sec. cor.
dug pits 18 x 18 x 12 ins E. and W.
of stake 5 $\frac{1}{2}$ ft. dist raised mound
of earth 1 $\frac{1}{2}$ ft. high 3 $\frac{1}{2}$ ft. base
over it. And in E. pin drove stake
2 ft long 2 ins square 12 ins
in the ground marked $\frac{1}{4}$
S. on N. face

7980 To point of beginning
Land rolling. Soil good. Partly cultivated

Sub-Subdivisions of T. 3 North R. 34 East
Willamette Meridian, Oregon.

(8093-10 M.)

East on random through
center of sec 35
Va 2 1/4 East

Beginning at 1/4 sec. cor.
bet sec. 34 and 35

Set temporary ^{1/4 sec. cor.}
at 20, 40 and 60 chains and at
1000 Intersect Eddy 12 hrs S of
1/4 sec. cor. Thence S 95 1/2 W
on true line

2000 Deposited charred stake 12 ins
in the ground for 1/16 sec.
cor. dug pit 18 x 18 x 12 ins
E and W. of stake 5/8 ft dist
raised mound of earth 1 1/2 ft
high 3 1/2 ft base over it and in
E pin drove stake 2 ft long
2 ins square 12 ins in the
ground marked 1/16 S
on N. face

Sub-Subdivision of E. North R. 34 East

Willamette Meridian, Oregon.

(M 01-2000)

4000 Deposited charred stake 12 ins
in the ground for $\frac{1}{4}$ sec. cor.
dug pits 18x18x12 ins. End N. of
stake 5 ft. dist raised mound
of earth $1\frac{1}{2}$ ft high $3\frac{1}{2}$ ft base
over it. End in E. pit drove stake
2 ft long 2 ins square 12 ins
in the ground, marked
 $\frac{1}{4}$ S on N. face

6000 Deposited charred stake 12 ins
in the ground for
 $\frac{1}{6}$ sec. cor. dug pits 18x18x12
ins. End N. of stake 5 ft. dist
raised mound of earth $1\frac{1}{2}$ ft
high $3\frac{1}{2}$ ft base over it. End in
E. pit drove stake 2 ft long
2 ins square 12 ins in the
ground marked $\frac{1}{6}$ S on N. face

8000 To point of beginning.
Land gently rolling
Soil 1st rate

40

360

Sub-Subdivision of T. 3 North R. 34 East

Willamette Meridian, Oregon.

(8093-10 M.)

Esarow ran down through
N¹/₂ of sec. 35
Pa. 21° East

Beginning at ¹/₄ sec. cor. 20
chains N. of ¹/₄ sec. cor. bet
secs 34 and 35

Set temporary ¹/₄ sec. cor. at
20.40 and 60 chains and at

8020

Intersect E. bdy at ¹/₄ sec cor
Thence West on true line

2005-

Deposited charred stake 12 ins in
the ground for ¹/₄ Sec. cor.
an gypita 18 x 18 x 12 ins E. and N.
of stake 5 1/2 ft dia raised
mound of earth 1 1/2 ft high
3 1/2 ft base, over it and in
E. side drove stake 2 ft.
long 2 ins square 12 ins
in the ground marked
N.S. on N. face

Sub Division of T. 3 North R. 34 East
 Willamette Meridian, Oregon.

- 4010 Deposited charred stake 12 ins
 in the ground for $\frac{1}{16}$ sec. cor.
 dug pits 18x18x12 ins \odot Quadr.
 of stake $5\frac{1}{2}$ ft diam raised mound
 of earth $1\frac{1}{2}$ ft high $3\frac{1}{2}$ ft base
 over it Quadr. in \odot pit drove stake
 2 ft long 2 ins square 12 ins
 in the ground marked $\frac{1}{16}$
 Sou N face
- 6015 Deposited charred stake 12 ins
 in the ground for $\frac{1}{16}$ sec. cor.
 dug pits 18x18x12 ins \odot Quadr.
 of stake $5\frac{1}{2}$ ft diam raised
 mound of earth $1\frac{1}{2}$ ft high
 $3\frac{1}{2}$ ft base over it Quadr. in \odot pit
 drove stake 2 ft long 2 ins square
 12 ins in the ground marked
 $\frac{1}{16}$ Sou N face
- 8020 To point of beginning
 level Soil 1st rate
 Not Cultivated

42 362

Sub-Subdivision of T. 3 North R. 34 East

Willamette Meridian, Oregon.

(8093-10 M.)

Gas on random through
Prof sec. 26

Run 20° East

Beginning at $\frac{1}{16}$ sec. cor, 20
chains N of S.W. cor. of sec 26
Set temporary ~~marks~~ cor.
at 20, 40 and 60 chains and at

8040

Intersect E. bdy 12 lks S of
 $\frac{1}{16}$ sec. cor. Thence S. $89^{\circ} 55'$ W
on true line

2010

Deposited charred stake 12 ins
in the ground for $\frac{1}{16}$ sec. cor.
dug pits 18x18x12 ins E and W
of stake 5 1/2 ft dia raised
mound of earth 1 1/2 ft high
8 1/2 ft base over it and in E
paved road stake 2 ft long
2 ins square 12 ins in
the ground marked $\frac{1}{16}$ S on
N. face

Sub-Subdivision 3 North R. 34 East

Willamette Meridian, Oregon.

4020 Deposited charred stake 12 ins in the ground for $\frac{1}{16}$ sec. cor. dug pits 18x18x12 ins E and W. of stake $5\frac{1}{2}$ ft. dist raised mound of earth $1\frac{1}{2}$ ft high $3\frac{1}{2}$ ft base over it and in E pit drove stake 2 ft long 2 ins square 12 ins in the ground marked $\frac{1}{16}$ S on N. face

6030 Deposited charred stake 12 ins in the ground for $\frac{1}{16}$ sec. cor. dug pits 18x18x12 ins E and W. of stake $5\frac{1}{2}$ ft dist raised mound of earth $1\frac{1}{2}$ ft high. $3\frac{1}{2}$ ft base over it and in E pit drove stake 2 ft long 2 ins square 12 ins in the ground marked $\frac{1}{16}$ S on N. face

8040 To point of beginning Land rolling Soil found

Sub-Subdivisions of T. 3 North R. 34 East

Willamette Meridian, Oregon.

(8093-10 M.)

East on random through
Center of sec 26.
Va 20 1/2° East

Beginning at 1/4 sec. cor. bet
secs. 26 and 27.

For Temporary ~~reference~~
cors. at 20, 40 and 60 chains and at

8020

Intersect Coby 7 lks S. of
1/4 sec. cor. Thence S. 89° 31' W.
on true line

2005

Deposited charred stake 12 ins
in the ground for 1/4 sec. cor.
dug pits 18 x 18 x 12 ins E and W. of
stake 5/8 ft dia raised mound
of earth 1 1/2 ft high 3 1/2 ft base
over in and in C. pine drove stake
2 ft long 2 ins square 12 ins in
the ground marked 1/4 S. on N.
face

4010

Deposited charred stake
12 ins in the ground for 1/4 sec

Sub-Subdivision of T. 3 North R. 34 East

Willamette Meridian, Oregon.

Cor. dug pits 18x18x12 ins E. end of stake 5 1/2 ft dia raised mound of earth 1 1/2 ft high 3 1/2 ft base over in end in E. side drove stake 2 ft long 2 ins square 12 ins in the ground marked

1/4 S. on N. face

6015

Deposited charred stake in the ground for 1/6 Section dug pits 18x18x12 ins 12 ins E. end of stake 5 1/2 ft dia raised mound of earth 1 1/2 ft high 3 1/2 ft base over in end in E. side drove stake 2 ft long 2 ins square 12 ins in the ground marked 1/6 S. on N. face

8020

To point of beginning Land level Soil 1st rate Good Grass No water

Subdivisions of T. 3 North R. 34 East.

Willamette Meridian, Oregon.

(8093-10 M.)

East on random through
N¹/₂ of sec 26

Var. 20¹/₂° East

Beginning at ¹/₁₆ sec. cor. 20
chains N of ¹/₄ sec. cor. bet sec
26 and 27. Put temporary ~~line~~
corners at 20, 40 and 60 chains

and at

8030 Intersect E. by 12 lbs S. of
¹/₁₆ sec. cor. Thence S. 89° 55' W.
on true line

2007 Deposited charred stake 12 ins
in the ground for ¹/₁₆ sec.
cor. dug pit 18 x 18 x 12 ins
E. and W. of stake 5¹/₂ ft dia
raised mound of earth 1¹/₂ ft
high 3¹/₂ ft base over it
and in E. side drove stake
2 ft long 2 ins square
12 ins in the ground
marked ¹/₁₆ S. on N. face

Sub-Subdivision North R. 34 East

Willamette Meridian, Oregon.

- 4015 Deposited charred stake
12 ins in the ground for $\frac{1}{16}$
sec cor. dug pits 18x18x12 ins
E. and W. of stake 5 $\frac{1}{2}$ ft. dia
raised mound of earth 1 $\frac{1}{2}$ ft.
high 3 $\frac{1}{2}$ ft base over it and in
E. pit drove stake 2 ft long.
2 ins square 12 ins in the
ground marked $\frac{1}{16}$ S on N. face
- 6022 Deposited charred stake 12 ins
ins in the ground for $\frac{1}{16}$ sec cor.
dug pits 18x18x12 ins E. and W.
of stake 5 $\frac{1}{2}$ ft. dia raised mound
of earth 1 $\frac{1}{2}$ ft high 3 $\frac{1}{2}$ ft base over
it and in E. pit drove stake
2 ft long 2 ins square 12 ins in
the ground marked $\frac{1}{16}$ S on N. face
- 8030 To point of beginning
land level Soil 1st rate
Cultivated

48
368

Sub-Subdivision of T. 3 North R. 34 East

Willamette Meridian, Oregon.

(8093-10 M.)

East on random through
S $\frac{1}{2}$ of sec 23
Va 20 $\frac{1}{2}$ ° East

Commencing at $\frac{1}{16}$ sec. cor.
20 chs S. of $\frac{1}{4}$ Sec corner
bet. sec 22, 22 $\frac{1}{2}$ & 23

8020 For temporary $\frac{1}{16}$ sec. cor.
at 20.40⁰ and 60 chains N. and
Intersect E. bdy 10 chs S
of $\frac{1}{16}$ sec. cor.

2005 Thence S 89°56' N on true line
Opposite charred stake
12 ins in the ground
for $\frac{1}{16}$ sec. cor. dug pits
18x18x12 ins E. and N. stake
5 $\frac{1}{2}$ ft. diam. raised mound
of earth 1 $\frac{1}{2}$ ft high 3 $\frac{1}{2}$ ft
base over it and in E. pit
drove stake 2 ft long
2 ins square 12 ins in the
ground marked $\frac{1}{16}$ S on
N. face

Sub-Subdivisions of T. 3 North R. 34 East
Willamette Meridian, Oregon.

- 3750 Spring branch 5 kcs wide runs S. W.
- 4010 Deposited charred stake 12 ins
in the ground for $\frac{1}{16}$ sec. cor.
dug pits 18 x 18 x 12 ins E. and
W. of stake 5 $\frac{1}{2}$ ft. dist. raised
mound of earth 1 $\frac{1}{2}$ ft. high
3 $\frac{1}{2}$ ft. base over it 2^d in E.
pit drove stake 2 ft. long
2 ins. square 12 ins. in the
ground marked $\frac{1}{16}$ S. on N. face
- 4300 house. "Dwelling"
- 6015 Deposited charred stake 12 ins in the
ground for $\frac{1}{16}$ sec. cor. dug pits
18 x 18 x 12 ins E. and W. of stake 5 $\frac{1}{2}$ ft.
dist. raised mound of earth 1 $\frac{1}{2}$ ft. high
3 $\frac{1}{2}$ ft. base over it 2^d in E. pit drove stake
2 ft. long 2 ins. square 12 ins. in the ground
marked $\frac{1}{16}$ S. on N. face
- 8020 To point of beginning
Land mostly level Soil 1st rate
All cultivated

50

370

Subdivision of T. 3 North R. 34 East
Willamette Meridian, Oregon.

(8093-10 M.)

East on random through center
of sec 28.
Va 21° East.

Beginning at 1/4 sec. cor. bet.
secs. 22 and 28
Set temporary 1/4 sec. cor.
at 20.40 and 60 chains and at

8048 Intersect body at 1/4 sec. cor.
Thence West on true line

2012 Deposited charred stake 12 ins
in the ground for 1/4 sec. cor
dug pits 18 x 18 x 12 ins E. and W.
of stake 5 1/2 ft. diam. raised
mound of earth 1 1/2 ft high
3/4 ft base over in
and in E. pit drove stake
2 ft long 2 ins square 12 ins
in the ground marked 1/4
S. on N. face

3300 True bears N. and S.

Subdivisions of T. 3 North R. 34 East
Willamette Meridian, Oregon.

- 4024 Deposited charred stake 12 ins in the ground for $\frac{1}{4}$ sec. cor. dug pits 18x18x12 ins Q. and N. of stake 5 $\frac{1}{2}$ ft dist raised mound of earth 1 $\frac{1}{2}$ ft high 3 $\frac{1}{2}$ ft base over it Q. and in Q. picket stake 2 ft long 2 ins square 12 ins in the ground marked $\frac{1}{4}$ S. on N. face
- 6036 Deposited charred stake 12 ins in the ground for $\frac{1}{4}$ sec. cor. dug pits 18x18x12 ins Q. and N. of stake 5 $\frac{1}{2}$ ft ^{dist} raised mound of earth 1 $\frac{1}{2}$ ft high 3 $\frac{1}{2}$ ft base over it Q. and in Q. picket stake 2 ft long. 2 ins square 12 ins in the ground marked $\frac{1}{4}$ S. on N. face.
- 8048 To point of beginning land level Soil 1st rate All cultivated

52 372

Sub Subdivision T. 3 North R. 34 East

Willamette Meridian, Oregon.

(8093-10 M.)

East on random through
N^h of sec 23.

On 21° East
Commencing at $\frac{1}{16}$ sec. cor.
20 chains N of $\frac{1}{4}$ sec. cor. bet
secs 22 and 23.

Set temporary $\frac{1}{16}$ sec. cor.
at 20.40 and 60 chains and at
8060 Intersect Co. bdy 10 lbs S. of
 $\frac{1}{16}$ sec. cor. Thence S 89° 56' W
on trunclin

2015 Deposited Charred stake 12
ins in the ground for $\frac{1}{16}$
sec. cor. dug pits 18x18x12
ins Co. and W. of stake 15 $\frac{1}{2}$ ft
dist raised mound of earth
1 $\frac{1}{2}$ ft high 3 $\frac{1}{2}$ ft base over it
and in Co. pit drove stake
2 ft long five square 12 ins
in the ground marked
 $\frac{1}{16}$ S on N. face

373

Sub Subdivision 3 North R. 34 East

Willamette Meridian, Oregon.

- 4030 Deposited charred stake 12 ins in
the ground for $\frac{1}{4}$ sec. cor. dug
pits 18x18x12 ins $\frac{1}{4}$ in N. of stake
 $5\frac{1}{2}$ ft dist raised mound of earth
1 $\frac{1}{2}$ ft high $3\frac{1}{2}$ ft base over it
and in \odot pit drove stake
2 ft long 2 ins square 12 ins
in the ground marked
 $\frac{1}{4}$ S. on N. face
- 6045 Deposited charred stake 12 ins
in the ground for $\frac{1}{4}$ sec. cor. dug
pits 18x18x12 ins $\frac{1}{4}$ in N. of stake $5\frac{1}{2}$ ft
dist and raised mound of earth
1 $\frac{1}{2}$ ft high $3\frac{1}{2}$ ft base over it
and in \odot pit drove stake 2 ft
long 2 ins square 12 ins in
the ground marked $\frac{1}{4}$ S. on
N. face
- 8060 To point of beginning
land level soil 1 $\frac{1}{2}$ rate
partly cultivated
Oct-5-1887

Sub-Subdivisions of T. 3 North R. 34 East
 Willamette Meridian, Oregon.

(8093-10 M.)

East on random through
 Sk of sec 14

Pa 21° East

Commencing at $\frac{1}{4}$ sec. cor. 20 chains
 N. of S. W. cor. of sec 14

Set temporary $\frac{1}{4}$ sec. cor.

at 20.40 and 60 chains and at

8068 Intersect E. by at $\frac{1}{4}$ sec.
 cor. Thence West on true
 line

2017 Deposited charred stake
 12 ins in the ground for $\frac{1}{4}$ sec.
 cor. dug pits 18 x 18 x 12
 ins E. and N. of stake 5 1/2 ft
 dist raised mound of earth
 1 1/2 ft high 2 1/2 ft base
 over in and in E. pit
 drove stake 2 ft long 2 ins
 square 12 ins in the ground
 marked $\frac{1}{4}$ S. or N. face

Sub-Subdivision of T. 3 North R. 34 East 375
Willamette Meridian, Oregon.

4034

Deposited charred stake 12 ins in the ground for $\frac{1}{4}$ sec. cor. dug pits 18x18x12 ins End N. of stake $5\frac{1}{2}$ ft dist raised mound of earth $1\frac{1}{2}$ ft high $3\frac{1}{2}$ ft base over it in E. side drove stake 2 ft long 2 ins square 12 ins in the ground marked $\frac{1}{4}$ S on N. face

6051

Deposited charred stake 12 ins in the ground for $\frac{1}{4}$ sec. cor. dug pits 18x18x12 ins End N. of stake $5\frac{1}{2}$ ft dist raised mound of earth $1\frac{1}{2}$ ft high $3\frac{1}{2}$ ft base over it in E. side drove stake 2 ft long 2 ins square 12 ins in the ground marked $\frac{1}{4}$ S on N. face

8068

Dr. point of beginning
Land level Soil 1st rate
All cultivated

Sub-Subdivisions of T. 3 North R. 84 East.
 Willamette Meridian, Oregon.

(8093-10 M.)

East on random through
 Center of of size 14
 Ca 21° East
 Beginning at $\frac{1}{4}$ sec. cor. for
 sec. 14 & 15. Set temporary $\frac{1}{4}$ sec.
 cor. at 20.40 and 60 chains
 end at

8040 Intersect Ebdy. at $\frac{1}{4}$ sec. cor.
 Thence West on true line

2010 Deposited charred stake
 12 ins in the ground for
 $\frac{1}{4}$ sec. cor. dug pits 18x18x12
 ins E. & W. of stake $5\frac{1}{2}$ ft. dist.
 raised mound of earth $1\frac{1}{2}$
 ft high $3\frac{1}{2}$ ft base over it
 and in E. pit drove stake 2 ft.
 long 2 ins square 12 ins in
 the ground marked $\frac{1}{4}$ S
 on N. face

4020 Deposited charred stake 12 ins
 in the ground for $\frac{1}{4}$ sec. cor.

Sub-Subdivision of T. 2 North R. 34 East

Willamette Meridian, Oregon.

(R. 01-222)

dug pits $18 \times 18 \times 12$ ins @
 End H. of stake $5\frac{1}{2}$ ft dist
 raised mound of earth
 $1\frac{1}{2}$ ft high $3\frac{1}{2}$ ft base
 over it and in @ per drove
 stake 2 ft long 2 ins
 square 12 ins in the
 ground marked $\frac{1}{4}$ S.
 on N face

6030

Deposited charred stake
 12 ins in the ground for
 $\frac{1}{4}$ sec. cor. dug pits $18 \times 18 \times 12$
 ins @ End H. of stake $5\frac{1}{2}$
 ft dist raised mound
 of earth $1\frac{1}{2}$ ft high $3\frac{1}{2}$ ft
 base over it and in @ per
 drove stake 2 ft long 2 ins
 square 12 ins in the ground
 for $\frac{1}{4}$ S. on N face

8040

To point of beginning
 Land level Soil 1st rate

58

378

Sub-Subdivision of T. 3 North R. 34 East

Willamette Meridian, Oregon.

(8093-10 M.)

East on random through
N $\frac{1}{2}$ of sec. 14
Va 20° East

Beginning at $\frac{1}{4}$ Sec. cor. 20
chains N of 4000 cor. bet sees
14 and 15. Set temporary ~~line~~

8020

Cor. at 20, 40 and 60 chains and at
Intersect E. bdy. 7 $\frac{1}{2}$ N of S of
 $\frac{1}{4}$ sec. cor. Hence

2005

S 89° 57' from true line
Deposited charred stake
12 ins in the ground for
 $\frac{1}{4}$ sec. cor. dug pits 18x18x12
ins E and West of stake 5 $\frac{1}{2}$ ft
diam. raised mound of earth
1 $\frac{1}{2}$ ft high, 3 $\frac{1}{2}$ ft base, over
it and in E pit drove stake
2 ft long, 2 ins square, 12 ins
in the ground, marked
 $\frac{1}{4}$ S on N. face

Sub-Subdivision of T. 3 North R. 34 East

Willamette Meridian, Oregon.

4010 Deposited charred stake 12 ins
 in the ground for $\frac{1}{16}$ sec. cor. dug
 pits 18x18x12 ins E. end of
 stake 5 $\frac{1}{2}$ ft. dist. raised
 mound of earth 1 $\frac{1}{2}$ ft high
 3 $\frac{1}{2}$ ft base over it and in E.
 pit drove stake 2 ft long
 long 2 ins square 12 ins
 in the ground marked
 $\frac{1}{16}$ S. on N. face

6015 Deposited charred stake 12 ins
 in the ground for $\frac{1}{16}$ Sec cor.
 dug pits 18x18x12 ins E. end of
 of stake 5 $\frac{1}{2}$ ft. dist. raised
 mound of earth 1 $\frac{1}{2}$ ft high
 3 $\frac{1}{2}$ ft base over it and in E. pit
 drove stake 2 ft long 2 ins
 square 12 ins in the ground
 marked $\frac{1}{16}$ S. on N. face

8020 To point of beginning
 Quad level Soil 1st rate

Sub-Subdivision T. 30 North R. 3 4 East

Willamette Meridian, Oregon.

(8093-10 M.)

East on random through
S^h of sec. 11

to a 20' Corner

Beginning at $\frac{1}{4}$ sec. cor.
20 chains N. of S. W. cor of
sec 11. Set temporary
corner at 2040 and 60 chains
and at

8000 Intersect E. bdy 14 N. of
of $\frac{1}{4}$ sec cor. thence
N. 89° 54' W. on true line

2000 Deposited charred stake 12
ins in the ground for $\frac{1}{4}$
sec. cor. dig pits 18x18x12 ins
E. and W. of stake 5 $\frac{1}{2}$ ft diam
raised mound of earth
1 $\frac{1}{2}$ ft high 3 $\frac{1}{2}$ ft base over
it and in E. pit drove stake
2 ft long 2 ins square 12 ins
in the ground marked
 $\frac{1}{4}$ S. on N. face ~~over it~~

Sub-Subdivision of T. 3 North R. 34 East
Willamette Meridian, Oregon.

3850

Fence & field Nnd S.

4000

Deposited charred stake 12 ins in the ground for $\frac{1}{6}$ sec. cor. dug pits 18 x 18 x 12 ins End H. of stake $5\frac{1}{2}$ ft dist. raised mound of earth $1\frac{1}{2}$ ft high $3\frac{1}{2}$ ft base over it and in E. piv. drove stake 2 ft long. 2 ins square 12 ins in the ground marked $\frac{1}{6}$ S. on N. face

6000

Deposited charred stake 12 ins in the ground for $\frac{1}{6}$ sec. cor. dug pits 18 x 18 x 12 ins End H. of stake $5\frac{1}{2}$ ft dist. raised mound of earth $1\frac{1}{2}$ ft high $3\frac{1}{2}$ ft base over it and in E. piv drove stake 2 ft long. 2 ins square 12 ins in the ground marked $\frac{1}{6}$ S. on N. face

6050

Gilch N. H.

- 100

8000

To point of beginning
Land level mostly
Soil 1st rate

Sub-Divisions of T. 3 North R. 34 East
Willamette Meridian, Oregon.

(8093-10 M.)

- East on random through
Center of sec 11
Fa 20° East
Beginning at $\frac{1}{4}$ sec. cor. bet
secs 10 and 11
Set temporary ~~mark~~ sec. cor.
at 20, 40 and 60 chains and at
1967 Intersect E. bdy 7th St.
of $\frac{1}{4}$ sec. cor. thence
N. 89° 54' W. on true line
1992 Deposited charred stake 12 ins
in the ground for $\frac{1}{16}$ sec.
cor. dig pits 18 x 18 x 12 ins
E. and W. of stake 5 $\frac{1}{2}$ ft. dist
raised mound of earth 1 $\frac{1}{2}$
ft. high 3 $\frac{1}{2}$ ft. base over
it and in E. pit drove stake
2 ft. long 2 ins square 12 ins
in the ground, marked
1/16 S. on N. face
3800 Fence bears N. and S.

Sub-Division of T. 3 North R. 34 East
 Willamette Meridian, Oregon.

- 3984 Deposited charred stake 12 ins in
 the ground for $\frac{1}{4}$ sec. cor.
 dug pits 18 x 18 x 12 ins E. and W.
 of stake 5 $\frac{1}{2}$ ft. dist raised
 mound of earth 1 $\frac{1}{2}$ ft high
 3 $\frac{1}{2}$ ft base over in ^{ad in} E.
 pair drove stake 2 ft long
 2 ins square 12 ins in the ground
 marked $\frac{1}{4}$ S. on N. face
- 5976 Deposited charred stake 12 ins in
 the ground for $\frac{1}{6}$ sec. cor.
 dug pits 18 x 18 x 12 ins E. and W.
 of stake 5 $\frac{1}{2}$ ft. dist raised
 mound of earth 1 $\frac{1}{2}$ ft high
 3 $\frac{1}{2}$ ft base over in ^{ad in} E.
 pair drove stake 2 ft long
 2 ins square 12 ins in the
 ground marked $\frac{1}{6}$ S. on N.
 face
- 7967 To point of beginning
 land level Soil food

64 384

Sub-Subdivision T. 30 North R. 34 East

Willamette Meridian, Oregon.

(8093-10 M.)

East on random through
N^h. of sec. 71

1934 East

Beginning at $\frac{1}{4}$ sec. cor 20
chains N. of $\frac{1}{4}$ sec. cor. bet sec
10th & 11th Set temporary ~~line~~ ^{line} cor.
at 20, 40th & 60th chains. End at

7966 Intersect Q. body 14 lks N. of
 $\frac{1}{4}$ sec. cor. Thence N. $89^{\circ} 54'$ West
on true line

1400 Swelling of a Mr. Pierce bears
S 10 lks

1989 Deposited charred stake 12 ins
in the ground for $\frac{1}{4}$ sec. cor.
dug pits 18 x 18 x 12 ins. E. End N.
of stake 5 $\frac{1}{2}$ ft. dist. raised
mound of earth 1 $\frac{1}{2}$ ft high
8 $\frac{1}{2}$ ft base over it End in
Espir drove stake 2 ft long
2 ins square 12 ins in the ground
marked $\frac{1}{4}$ S. on N. face

Subdivisions of T. 3 North R. 34 East
Willamette Meridian, Oregon.

- 3978 Deposited charred stake 12 ins
in the ground for $\frac{1}{16}$ sec. cor.
dug pit 18x18x12 ins E. end of
stake. $5\frac{1}{2}$ ft dia raised mound
of earth $1\frac{1}{2}$ ft high $3\frac{1}{2}$ ft base
over it and in E. side of
stake 2 ft long 2 ins square
12 ins in the ground marked
 $\frac{1}{16}$ S. on N. face
- 5967 Deposited charred stake 12 ins
in the ground for $\frac{1}{16}$ sec. cor.
dug pit 18x18x12 ins E. end of
stake $5\frac{1}{2}$ ft dia raised
mound of earth $1\frac{1}{2}$ ft high
 $3\frac{1}{2}$ ft base over it and in E.
side of stake 2 ft long
2 ins square 12 ins in the
ground marked $\frac{1}{16}$ S. on N. face
- 7956 To point of beginning
of level Soil 1st class
Partly Cultivated

66

386

Sub-Subdivision of T. 3 North R. 34 East

Willamette Meridian, Oregon.

(8003-10 M.)

Go on random through
 1/4 of sec 2
 Pa 20° East

Beginning at 1/4 sec. cor. 20
 chains N. of S. N. Cor. of sec.
 2 Set temporary 1/4 sec. cor.
 at 20.40 and 60 chains and at

7955 Intersect E. bdy. 12 lbs
 N. of 1/4 sec. cor. Thence
 N 89° 55' West on true line

1989 Deposited charred stake 12 ins
 in the ground for 1/4 sec. cor.
 dug pits 18 x 18 x 12 ins & and H.
 of stake 5 1/2 ft dia raised
 mound of earth 1 1/2 ft high
 3 1/2 ft base over it and in E. p. v.
 drove stake 2 ft long 2 ins
 square 12 ins in the ground
 marked 1/4 S on N face

3978 Deposited charred stake
 12 ins in the ground

Subdivision of T. 30 North R. 34 East

Willamette Meridian, Oregon.

for 1/6 Sec. cor. dug pits 18x18x12
ins E. and N. of stake 5/4 ft
dist. raised mound of
earth 1 1/2 ft high 3 1/2 ft
base over it and in E. pit
drove stake 2 ft long
2 ins square 12 ins in the ground
and marked 1/6 S. or N. face

5967 Deposited chared stake 12 ins in
the ground for 1/6 Sec.
cor dug pits 18x18x12 ins
E. and N. of stake 5/4 ft dist
raised mound of earth
1 1/2 ft high 3 1/2 ft base
over it and in E. pit
drove stake 2 ft long
2 ins square 12 ins in
the ground marked 1/6 S. or N. face

7955 To point of beginning
land slightly rolling
Soil 1st rate Not Cultivated

68 388

Sub-Subdivision of T. 3 North R. 34 East

Willamette Meridian, Oregon.

(8093-10 M.)

East on random through
Center of sec. 2
Va 20° East

Beginning at 1/4 sec. cor. bet
secs 2nd and 3.

For temporary ~~and some~~
cors at 20, 40th and 60 chains ^{and at}

1970 Intersect. Q. bdy. 10 kts. N.
of 1/4 sec cor. Thence
N. 84° 56' W. on true line

1992 Deposited charred stakes 12 ins
in the ground for 1/16 sec cor.
dug pits 18 x 18 x 12 ins Q. and W.
of stake 5 1/2 ft dist raised mound
of earth 1 1/2 ft high 3 1/2 ft base
over it and in Q put two
stakes 2 ft long 2 ins square
12 ins in the ground marked
1/16 Sec N. face.

3984 Deposited charred stake
12 ins in the ground for

Subdivisions of T. 3 North R. 34 East
Willamette Meridian, Oregon.

1/4 sec. cor. dug pits 18x18x12 ins
C. 2nd W. of stake 5 1/2 ft dia
raised mound of earth 1 1/2 ft
high 3 1/2 ft base over it
in C. pair drove stake 2 ft
long 2 ins square 12 ins
in the ground marked
1/4 S on N. face

5977 Deposited charred stake
12 ins in the ground for 1/16
sec. cor. dug pits 18x18x12 ins
C. 2nd W. of stake 5 1/2 ft dia
raised mound of earth
1 1/2 ft high 3 1/2 ft base over
it in C. pair drove stake
2 ft long 2 ins square
12 ins in the ground marked
1/16 S on N. face

7970 To point of beginning
land partly rolling
Soil 1st rate

Sub-Subdivisions of T. 3 North R. 34 East
Willamette Meridian, Oregon.

(8093-10 M.)

East on random through
N $\frac{1}{2}$ of sec 2
Cra. 20° East

Beginning at $\frac{1}{16}$ sec cor. 20
chains N of $\frac{1}{4}$ sec. cor bet
secs 2 and 3

79.84 Set temporary ~~sec~~ cor.
at 20, 40 and 60 chains and at
Intersection by at $\frac{1}{16}$ sec
cor. Thence West on true line

1996 Deposited charred stake 12
ins in the ground for $\frac{1}{16}$ sec cor.
dug pits 18x18x12 ins E and W. of
stake. 5 $\frac{1}{2}$ ft dia raised mound
of earth 1 $\frac{1}{2}$ ft high 9 $\frac{1}{2}$ ft base
over it and in E pit drove stake
2 ft long 2 ins square 12 ins
in the ground marked $\frac{1}{16}$ S
on N face.

3992 Deposited charred stake 12 ins
in the ground for $\frac{1}{16}$ sec cor.

Sub-Subdivision of T. 3 North R. 34 East

Willamette Meridian, Oregon.

(U.S. 01-0000)

dug pits 18x18x12 ins E. and W.
 of stake 5/2 ft dist raised mound
 of earth 1 1/2 ft high 3/2 ft base
 over it and in E. side of stake
 1 1/2 ft dist raised mound of
 earth 1 1/2 ft high 3/2 ft base
 over it and in E. side of stake
 2 ft long 2 ins square 12 ins
 in the ground marked
 1/6 S, on N. face

5988 Deposited charred stake 12 ins in
 the ground. for 1/6 sec cor, dug pits
 18x18x12 ins E. and W. of stake
 5/2 ft dist, raised mound
 of earth 1 1/2 ft high 3/2 ft
 base over it and in E. side of stake
 2 ft long 2 ins square 12 ins
 in the ground marked
 1/6 S, on N. face

7984 To point of beginning
 Land level Soil substrate
 Oct-11-1887

Full Subdivisions of T. 30 North R. 34 East
Willamette Meridian, Oregon.

(8093-10 M.)

East on random through
S^h of sec. 34

Va 21° East
Commencing at $\frac{1}{4}$ sec cor
20 chains S of $\frac{1}{4}$ sec. cor. bet
secs 33rd & 34

1980 Set temporary $\frac{1}{4}$ sec. cor
at 20, 40th and 60 chainsrd at
Intersect E. bdy, 60th N. of
 $\frac{1}{4}$ sec. cor. Thence
N. 89° 34' W on true line

1995 Deposited charred stake
12 ins in the ground for
 $\frac{1}{4}$ sec. cor. dug pits 18x18x12
ins E. and N. of stake 5 $\frac{1}{2}$ ft
diam raised mound of earth
1 $\frac{1}{2}$ ft high 3 $\frac{1}{2}$ ft base over
it and in E pit drove stake
2 ft long 2 ins square
12 ins in the ground marked
 $\frac{1}{4}$ Sec on N. face.

Sub Division of T. 3 North R. 34 East 393

Willamette Meridian, Oregon.

2500 Canon bears S. E. -50

3990 Deposited charred stake 12 ins in the ground for 1/6000 cor. dug pits 18 x 18 x 12 ins @ End N. of stake 5 1/2 ft diam. raised mound of earth 1 1/2 ft high 3 1/2 ft base over it and in @ pit drove stake 2 ft long 2 ins square 12 ins in the ground marked 1/6 South N. face

5985 Deposited charred stake 12 ins in the ground marked 1/6 South N. face raised mound of earth 1 1/2 ft high 3 1/2 ft base over it and in @ pit drove stake 2 ft long 2 ins square 12 ins in the ground marked 1/6 South N. face.

6000 Leave field N. and S.

7950 To point of commencement Land rolling Soil 1st grade Partly cultivated

Sub-Subdivision of T. 3 North R. 34 East

Willamette Meridian, Oregon.

(8093-10 M.)

East on random through
Center of sec 20 34
on 20 1/2 East

Commencing at 4 sec. cor.
bet sec. 30 and 34
Set temporary ~~at~~ ^{at} sec. cor.
at 20.40 and 60 chains and at

7996

Intersect E. bdy. 70 ft
N. of 4 sec cor. Thence
N. 89' 30 West on true line.

1200

Once and leave field

1999

Deposited charred stake
12 ins in the ground for
1/6 Sec cor And dig pits
18 x 18 x 12 ins E. and N. of
stake 5 1/2 ft dist raised
mound of earth 1 1/2 ft high
3 1/2 ft base over it and in E.
pit drove stake 2 ft long,
2 ins square 12 ins in the
ground marked 1/6 Sec N. face

Sub-Subdivision of T. 8 North R. 84 East
Willamette Meridian, Oregon.

3998 Deposited charred stake 12 ins in
the ground for $\frac{1}{4}$ sec. cor. dug
pits 18 x 18 x 12 ins E. and W. of stake
 $5\frac{1}{2}$ ft dia raised mound of earth
 $1\frac{1}{2}$ ft high $3\frac{1}{2}$ ft base over it
and in E. pit drove stake 2 ft
long 2 ins square 12 ins in
the ground marked $\frac{1}{4}$ S
on N. face

4200 Canon bars S.

-50

5997 Deposited charred stake 12 ins
in the ground for $\frac{1}{6}$ sec. cor.
dug pits 18 x 18 x 12 ins E. and W.
of stake $5\frac{1}{2}$ ft dia raised
mound of earth $1\frac{1}{2}$ ft high
 $3\frac{1}{2}$ ft base over it and in E.
pit drove stake 2 ft long
2 ins square 12 ins in the
ground marked $\frac{1}{6}$ S on N. face

7996 To point of beginning
Land level Soil 1st rate

76

396

Sub-Subdivision of T. 3 North R. 34 East

Willamette Meridian, Oregon.

(8093-10 M.)

East on random through
N. 2 of sec 34
Va 21st East

Commencing at $\frac{1}{4}$ sec. cor. 20
chains N of $\frac{1}{4}$ sec. cor. bk. sec.
93 and 94 Set temporary $\frac{1}{4}$ sec.
cor. at 20.40 and 60 chains and at

2012 Intersect E. bdy 72 lbs N
of $\frac{1}{4}$ sec cor. Thence
N. 89 29' West, on true line

2003 Set basalt stone 12 x 8 x 6 ins
ins in the ground for $\frac{1}{4}$ sec. cor.
marked $\frac{1}{4}$ on N face
Dug pits 18 x 18 x 12 ins E. and N.
of stone 5 1/2 ft dist and raised
mound of earth 1 1/2 ft
high 3 1/2 ft base over it

2050 Iron ^{and} ^{leaf} field N. and A

4006 Deposited charred stake 12
ins in the ground for $\frac{1}{4}$ sec
cor dug pits 18 x 18 x 12 ins E. and N.

Sub-Subdivision of T. 3 North R. 34 East
Willamette Meridian, Oregon.

of stake 5 1/2 ft. dist raised mound of earth 1 1/2 ft high 3 1/2 ft base over iron in E pin drove stake 2 ft long 2 ins square 12 ins in the ground marked 1/6 S. on N. face

6009 Deposited charred stake 12 ins in the ground for 1/4 sec. cor dug pits 18 x 18 x 12 ins E. and N. of stake 5 1/2 ft dist raised mound of earth 1 1/2 ft high 3 1/2 ft base over iron in E pin drove stake 2 ft long 2 ins square 12 ins in the ground marked 1/6 S. on N. face.

8012 To point of beginning
Land rolling Soil wet
Partly Cultivated

Sub-Subdivision of T. 3 North R. 34 East
 Willamette Meridian, Oregon.

(8093-10 M.)

- East on random through
 Sh of sec 27
 Va 21st Cont
 Commencing at $\frac{1}{4}$ sec. cor. 20
 chains N of S. H. cor of sec 27
 Set temporary $\frac{1}{4}$ sec. cor.
 at 20, 40th & 60 chainsnd at
 8020 Intersect E. bay 67th N
 of $\frac{1}{4}$ sec. cor. Thence
 N. 89° 31' W. on true line
 1000 Top of ridge Nnd S. +20
 2005 Set basalt stone 10x10x10 ins
 6 ins in the ground for
 $\frac{1}{4}$ sec cor. marked $\frac{1}{4}$
 Son N. face dug pits
 18x18x12 ins End W. of
 stone 5 $\frac{1}{2}$ ft dist raised
 mound of earth 1 $\frac{1}{2}$ ft
 high 3 $\frac{1}{2}$ ft base over it
 3000 Canon bears N. H. -50

Subdivisions of T. 3 North R. 34 East
Willamette Meridian, Oregon.

4010 Deposited charred state 12 ins in
the ground for $\frac{1}{16}$ sec. cov.
dug pits 18 x 18 x 12 ins East
and West of stake 5 $\frac{1}{2}$ ft dist.
raised mound of earth
1 $\frac{1}{2}$ ft high 3 $\frac{1}{2}$ ft base over it
and in pits drove stake 2 ft
long 2 ins square 12 ins in
the ground marked $\frac{1}{16}$ S on
N. face

5200 Gulch N. — 20

6013 Set basalt stone 9 x 8 x 7 ins
6 ins in the ground for $\frac{1}{16}$ sec
cov. marked $\frac{1}{16}$ on N. face
dug pits 18 x 18 x 12 ins East & W
of stake 5 $\frac{1}{2}$ ft dist and raised
mound of earth and stone 2 ft
high 4 $\frac{1}{2}$ ft base over it

8020 To point of beginning
land rolling soil 1st rate
Not under cultivation

FD

400

Sub Subdivision T. 2 North R. 34 East

Willamette Meridian, Oregon.

(8093-10 M.)

East on random through
Center of sec 27 Va 20° East

Commencing at 1/4 sec. cor. bet
secs 27 and 28

Set temporary 1/4 sec. cor.
at 20 40 and 60 chains and at

8030 Intersect E. bdy 65 ft. N.
of 1/4 sec. cor. Thence
N. 89° 32' W. on true line

2007 Set basalt stone 10 x 8 x 8 ins
6 ins in the ground for
1/4 sec. cor. marked 1/4 on
N. face. dug pits 18 x 18 x 12
ins East and West of stake
5 1/2 ft dist and raised mound
of earth 1 1/2 ft high 3 1/2 ft
base over it

2980 Enter field

4015 Set post 3 ft long 3 ins square
12 ins in in the ground for

Sub-Subdivision of T. 3 North R. 34 East

Willamette Meridian, Oregon.

1/4 sec. cor. marked 1/4 S on N. face. dug pits 18x18x12 ins E. and W. of post 5 1/2 ft dist and raised mound of earth 1 1/2 ft high 3 1/2 ft base around post

5800 Leave field

6022 Deposited charred stake 12 ins in the ground for 1/6 sec. cor. dug pits 18x18x12 ins E. and W. of stake 5 1/2 ft dist raised mound of earth 1 1/2 ft high 3 1/2 ft base over it and in E. pin drove stake 2 ft long 2 ins square 12 ins in the ground marked 1/6 S on N. face

8030 To point of beginning land rolling soil 1st rate partly cultivated

82 402

Sub-Subdivision T. 3 North R. 34 East

Willamette Meridian, Oregon.

(8093-10 M.)

Coast on random through
N. h of sec. 27 Va. 21° East

Commencing at $\frac{1}{4}$ sec. cor.
20 chains N. of $\frac{1}{4}$ sec. cor. bet
sec 27 and 28

Set temporary $\frac{1}{4}$ sec. cor.
at 20, 40 and 60 chains and at
8040 Intersect E. bdy. 80th St.
of $\frac{1}{4}$ sec. cor. Thence

A. 89° 26' West on true line,

2016 Deposited charred stake 12 ins
in the ground for $\frac{1}{4}$ sec. cor.
dug pits 18 x 18 x 12 ins E. Ed N.
of stake 5 1/2 ft diam. raised mound
of earth 1 1/2 ft high 3 1/2 ft base
over it and in E. pin door stake
2 ft long 2 ins square 12 ins
in the ground marked
 $\frac{1}{4}$ S. on N. face

Sub-Sub-Sub of T. 3 North R. 34 East

Willamette Meridian, Oregon.

4020 ^{marked} S.W. basalt stone 14x8x6 ins 10 ins
 in the ground for $\frac{1}{16}$ sec. cov. ^{marked $\frac{1}{16}$ on N. face}
 dug pits 18x18x12 ins E. and W.
 of stone $5\frac{1}{2}$ ft. dist. raised mound
 of earth $1\frac{1}{2}$ ft high $3\frac{1}{2}$ ft base
 over it ~~in 3rd sec. of state~~
~~with low ground in 3rd sec. of state~~
~~the corner marked in~~
~~Office.~~

5850 Gulch - 50

6030 S.W. basalt stone 9x8x7 ins 6 ins
 in the ground for $\frac{1}{16}$ sec. cov. marked
 $\frac{1}{16}$ on N. face. dug pits 18x18x12
 ins E. and W. of stake $5\frac{1}{2}$ ft. dist.
 raised mound of earth $1\frac{1}{2}$ ft
 high $3\frac{1}{2}$ ft base over it

7500 Top of ridge bears S 750

8040 Top point of beginning
 sand rolling soil 120 rate
 partly cultivated

84
404

Sub-Subdivisions of T. 3 North R. 34 East

Willamette Meridian, Oregon.

(8093-10 M.)

Goat on random through
S¹/₂ of sec 22 Va 20° East

Commencing at ¹/₁₆ sec. cor.
20 chains N. of S. H. cor. of sec. 22.
Set temporary ¹/₁₆ sec. cor.
at 20, 40 and 60 chains and at

8030 Intersect. E. bdy. 85 lbs N.
of ¹/₁₆ sec. cor. Thence

1520 N. 89° 23' West on true line
fence N. and S. and into field

2007 Deposited charred stake 12 ins
in the ground for ¹/₁₆ sec. cor.
dug pits 18 x 18 x 12 ins E. and W.
of stake 5 1/2 ft dia raised
mound of earth 1 1/2 ft high
3 1/2 ft. base over it and in E
pit drove stake 2 ft long
2 ins square 12 ins in the
ground marked ¹/₁₆ S on
N. face.

Sub-Subdivision of T. 3 North R. 34 North

Willamette Meridian, Oregon.

- 3980 Spring branch 2 kts wide N.W.
- 4015 Set post 9 ft long 3 ins square
24 ins in the ground for $\frac{1}{6}$ sec
cor. marked $\frac{1}{6}$ S. on N. face
dug pits 18 x 18 x 12 E. Ed W. of
stake 5 $\frac{1}{2}$ ft dia raised mound
of earth 1 $\frac{1}{2}$ ft high 3 $\frac{1}{2}$ ft base
around post
- 4030 Cox of door yard of dwelling of
Mr Russia
- 6022 Set post 9 ft long 3 ins square
24 ins in the ground marked
 $\frac{1}{6}$ S. on N. face for $\frac{1}{6}$ Sec
cor. dug pits 18 x 18 x 12 ins E. Ed
W. of stake 5 $\frac{1}{2}$ ft dia raised
mound of earth 1 $\frac{1}{2}$ ft high
3 $\frac{1}{2}$ ft base over ivy
- 6120 Leave field N. Ed S.
- 6300 Wagon road N. Ed S.
- 8030 Topoint of beginning
Land mostly level Soil 1st rate

86 406

Sub-Subdivision of T. 3 North R. 34 East

Willamette Meridian, Oregon.

(8093-10 M.)

Easton random through
Center of sec 22.

Pa 20° East

Beginning at $\frac{1}{4}$ sec. cor. bet
secs 21 and 22:

Set temporary $\frac{1}{4}$ sec. cor.
at 20.40 and 60 chains and at

8020 Intersect E. bdy 95 lks N.
of $\frac{1}{4}$ sec. cor. Thence
N. 89° 19' West on true line

2005 Deposited a pint flask
12 ins in the ground for
 $\frac{1}{4}$ sec. cor. dug pits 18 x 18 x 12
ins E and N. of stake 5 1/2 ft
diam. raised mound of earth
1 1/2 ft high, 3 1/2 ft base over
it and in E. side drove stake
2 ft long 2 ins square 12
ins in the ground marked
46 Sou N. face

3500 Spring branch 2 lks N.E.

Sub-Subdivision of T. 3 North R. 34 East

Willamette Meridian, Oregon.

4010 Set post 3 ft long sine square ^{2 1/2 ins} in the ground, for ^{marked 1/4 S on N face} ~~1/4 sec. cor.~~ dug pits 18 x 18 x 12 ins Q. and H. of stake 5 1/2 ft dis raised mound of earth 1 1/2 ft high 3/4 ft base around post.

4800 Enter field S. H.

6015 Deposited charred stake 12 ins in the ground, for ~~1/4 sec. cor.~~ dug pits 18 x 18 x 12 ins Q. and H. of stake 5 1/2 ft dis raised mound of earth 1 1/2 ft high 3/4 ft base over it. ^{raised mound} ~~Q. and H. of stake 2 ft~~ long 2 ins square 12 ins in the ground marked 1/4 S. on N. face

8020 To point of beginning Land rolling Soil 1st rate Party cultivated

Sub Subdivision of T. 3 North R. 34 East
Willamette Meridian, Oregon.

(8093-10 M.)

East on random through
N $\frac{1}{2}$ of sec 22

Va 20° East
Commencing at $\frac{1}{4}$ sec. cor.
20 chains N. of $\frac{1}{4}$ sec. cor.
bet sees 21 & 22.

Set temporary $\frac{1}{4}$ sec. cor.
at 20, 40 & 60 chains E of at

8012 Intersect E. by 100 lbs N
of $\frac{1}{4}$ Thence N 89° 17' West
on true line

2009 Deposited charred stake 12 ins
in the ground for $\frac{1}{4}$ sec. cor.
dug pits 18x18x12 ins E & N
of stake 5 $\frac{1}{2}$ ft diam, raised
mound of earth 1 $\frac{1}{2}$ ft high
3 $\frac{1}{2}$ ft base over it in E. pit
dug stake 2 ft long 2 ins
square 12 ins in the ground
marked $\frac{1}{4}$ S. on N. face

Sub-Subdivision T. 3 North R. 34 East
Willamette Meridian, Oregon.

- 4006 Deposited charred stake 12 in
in the ground for $\frac{1}{16}$ sec. cor.
dug pits 18 x 18 x 12 in C. & D. H.
of stake $5\frac{1}{2}$ ft diam raised
mound of earth $1\frac{1}{2}$ ft high
 $3\frac{1}{2}$ ft base over it $\frac{1}{4}$ in
E pin drove stake $2\frac{1}{2}$ ft long
2 in square 12 in in the
ground marked $\frac{1}{16}$ S. on N. face
- 4440 Wagon road bears N.
- 5300 Gulch and Spring branch bears N. - 75-
- 5350 Wagon road bears N.
- 6009 Deposited charred stake 12 in in the ground
for $\frac{1}{16}$ sec. cor. dug pits 18 x 18 x 12 in C. & D. H.
of stake $5\frac{1}{2}$ ft diam raised mound of
earth $1\frac{1}{2}$ ft high $3\frac{1}{2}$ ft base over it $\frac{1}{4}$ in
E pin drove stake $2\frac{1}{2}$ ft long 2 in square
12 in in the ground marked $\frac{1}{16}$ South N. face
- 8012 To point of beginning
Land rolling Soil 1st rate
Partly Cultivated

Sub-Subdivision of T. 3 North R. 34 East
Willamette Meridian, Oregon.

(8093-10 M.)

East on random through
S. 1/2 of sec. 15
Pa 204° East

Beginning at 1/4 sec. cor. 20 chains
N. of S. 1/4 cor. of sec 15

Set temporary ~~60~~ 60 chains
20.40 and 60 chains and at

20.00 Intersect Ebdy 100 lbs N of
1/4 sec cor. Thence 189° 17' N
on true line

20.00 Deposited charred stake
12 ins in the ground for
1/4 sec. cor. dug pits 18x18x12 ins.
End N. of stake 5 1/2 ft dia
raised mound of earth
1 1/2 ft high 9 1/2 ft base over
it and in E. side drove stake
2 ft long 2 ins square 12 ins
in the ground marked
1/4 S on N. face

Sub-Subdivision of T. 3 North R. 34 East
Willamette Meridian, Oregon.

4000 Deposited charred stake 12 ins in
the ground for $\frac{1}{4}$ sec cor dug
pits 18x18x12 ins. Q. and W. of
stake $5\frac{1}{2}$ ft dist raised
mound of earth $1\frac{1}{2}$ ft high.
 $3\frac{1}{2}$ ft base over in Q. and W. pit
dug stake 2 ft long 2 ins square
12 ins in the ground marked
 $\frac{1}{4}$ S. on N. face

6000 Deposited charred stake 12
ins in the ground for $\frac{1}{4}$
sec. cor. dug pits 18x18x12
ins Q. and W. of stake $5\frac{1}{2}$ ft
dist raised mound of earth
 $1\frac{1}{2}$ ft high $3\frac{1}{2}$ ft base over
in Q. and W. pit dug stake
2 ft long 2 ins square
12 ins in the ground marked
 $\frac{1}{4}$ S. on N. face

8000 To point of beginning
Land selling Soil 1st rate

92

412

Sub-Subdivision T. 3 North R. 84 East

Willamette Meridian, Oregon.

(8093-10 M.)

Cast on random through
Center of sec 15
Va $20\frac{1}{2}^{\circ}$ East

Beginning at $\frac{1}{4}$ sec. cor.
bet sec. 15 and 16

For temporary $\frac{1}{4}$ sec. cor.
at 20.40 and 60 chains and at

2012 Intersect Q. bdy. 106 lks N
of $\frac{1}{4}$ sec. cor. Thence
N $89^{\circ} 15'$ West on true line

2003 Deposited charred stake 12 ins
in the ground for $\frac{1}{4}$ sec. cor.
dug pits 18 x 18 x 12 ins E. and W.
of stake 5 1/2 ft dia. raised
ground of earth 1 1/2 ft high
3 1/2 ft base over it and in
Q. pit drove stake 2 ft
long 2 ins square 12 ins
in the ground marked
1/4 S on N. face

Sub-Subdivision of T. 3 North R. 34 East

Willamette Meridian, Oregon.

4006

Deposited charred stake 12 ins in the ground for $\frac{1}{4}$ sec. cor, dug pits 18 x 18 x 12 ins E. and N. of stake 5 1/2 ft dia raised mound of earth 1 1/2 ft high 3 1/2 ft base over it and in E. pit drove stake 2 ft long 2 ins square 12 ins in the ground marked $\frac{1}{4}$ Sec. N. face

6009

Deposited charred stake 12 ins in the ground for $\frac{1}{6}$ sec. cor, dug pits 18 x 18 x 12 ins E. and N. of stake 5 1/2 ft dia raised mound of earth 1 1/2 ft high 3 1/2 ft base over it and in E. pit drove stake 2 ft long 2 ins square 12 ins in the ground marked $\frac{1}{6}$ Sec. N. face

8012

To point of beginning
Land rolling Soil 1st rate

99 414

Sub-Subdivision of T. 8 North R. 34 East
Willamette Meridian, Oregon.

(8093-10 M.)

East on random through
N¹/₂ of sec 15

On 21° East

Commencing at ¹/₄ sec. cor.
20 chains S. of ¹/₄ sec. cor.
bet sees. 15th & 16

Set temporary ¹/₄ sec. cor.
at 20.40th & 60 chains and at

8020

Intersect E. bdy 110 lbs N.
of ¹/₄ sec. cor. Thence N. 89° 13' W
on true line

2005

Deposited charred stake 12 ins
in the ground for ¹/₄ sec. cor.
dug pits 18 x 18 x 12 ins E and
W. of stake 5 1/2 ft diam
raised mound of earth 1 1/2 ft
high 8 1/2 ft base over it
in E. pit drove stake 2 ft
long 2 ins square 12 ins
in the ground marked
¹/₄ S. on N. face.

Sub-Subdivision of T. J. North R. 34 Coas
Willamette Meridian, Oregon.

4010 Deposited charred stake 12 ins. in
the ground for $\frac{1}{16}$ sec. cor. dug
pits 18 x 18 x 12 ins. E. End H. of stake
 $\frac{5}{16}$ ft dist raised mound of earth
 $1\frac{1}{2}$ ft high $3\frac{1}{2}$ ft base over in
End in E. pit drove stake 2 ft. long
2 ins square 12 ins in the ground
marked $\frac{1}{16}$ S. on N. face.

6015 Deposited charred stake 12 ins in
the ground for $\frac{1}{16}$ sec. cor. dug
pits 18 x 18 x 12 ins. E. End H. of stake
 $\frac{5}{16}$ ft dist raised mound of earth
 $1\frac{1}{2}$ ft high $3\frac{1}{2}$ ft base over in
in E. pit drove stake 2 ft long
2 ins square. 12 ins in the
ground marked $\frac{1}{16}$ S. on N. face

8020 To point of beginning, land
gently rolling Soil 1st rate

96 416

Sub Subdivision of T. 3 North R. 34 East

Willamette Meridian, Oregon.

(8093-10 M.)

North on random through
E $\frac{1}{2}$ of sec 10
Va 20 $\frac{1}{2}$ East

Commencing at $\frac{1}{16}$ sec. cor.
20.05 ch. N. of S. E. cor. of Sec 10
Set temporary $\frac{1}{16}$ sec. cor.
at 20.40 and 60 chains and at

7976

Intersect N. bdy 10 N. of
of $\frac{1}{16}$ sec. cor. Thence
S 4' N on true line

1994

Deposited charred stake
ins in the ground for
sec. cor. dug pits 18x18x12
ins O. and N. of stake 5 $\frac{1}{2}$
ft. dish raised mound
of earth 1 $\frac{1}{2}$ ft high 3 $\frac{1}{2}$ ft
base over it and in E. pit
drove stake 2 ft long
2 ins square 12 ins in
the ground marked
 $\frac{1}{16}$ S. on N. face

Sub-Subdivisions 3 North 84 East

Willamette Meridian, Oregon.

- 3988 Deposited charred stake 12
ins in the ground for $\frac{1}{16}$
sec. cor. dug pits 18x18x12
ins E. and N. of stake $5\frac{1}{2}$
ft dia. raised mound of
earth $1\frac{1}{2}$ ft high $3\frac{1}{2}$ ft base
over it and in E. pin drove
stake 2 ft long 2 ins square
12 ins in the ground marked
 $\frac{1}{16}$ S on N. face
- 5982 Deposited charred stake 12 ins
in the ground for $\frac{1}{16}$ sec. cor.
dug pits 18x18x12 ins E. and
W. of stake $5\frac{1}{2}$ ft. dia. raised
mound of earth $1\frac{1}{2}$ ft high
 $3\frac{1}{2}$ ft base over it and in
E. pin drove stake 2 ft long
2 ins square 12 ins in the ground
marked $\frac{1}{16}$ S on N. face
- 7976 To point of beginning
Soil good Land level (Oct-13, 1887)

FINAL OATHS FOR SURVEYS.

A list of the names of the individuals employed by James P. Curwin
and James E. Holman, U. S. Deputy Surveyors, to assist in
 running, measuring and marking the lines and corners described in the foregoing field
 notes of the survey of the Sub-Subdivisional
lines of Township 3 North
Range 34 East Willamette Meridian, Oregon,
 showing the respective capacities in which they acted:

- L. J. Woolley -----, **Compassman.**
- E. J. Perry -----, **Chainman.**
- Aug. Davis -----, **Chainman.**
- J. R. Hadley -----, **Chainman.**
- C. E. Roper -----, **Chainman.**
- J. H. Moses -----, **Axeman.**
- J. H. Henderson -----, **Axeman.**
- , **Flagman.**

FINAL OATHS OF ASSISTANTS.

We hereby certify that we assisted James P. Curwin and
James E. Holman, U. S. Deputy Surveyors, in surveying all
 those parts or portions of the Sub-Subdivisional
lines of T 3 North
Range 34 East Willamette Meridian, Oregon,
 as are represented in the foregoing field notes as having been surveyed by him and under
 his direction; and that said survey has been in all respects, to the best of our knowledge
 and belief, well and faithfully surveyed, and the corner monuments established, according
 to the instructions furnished by the U. S. Surveyor General of Oregon.

- L. J. Woolley -----, **Compassman.**
- E. J. Perry -----, **Chainman.**
- Aug. Davis -----, **Chainman.**
- J. R. Hadley -----, **Chainman.**
- C. E. Roper -----, **Chainman.**
- J. H. Moses -----, **Axeman.**
- J. H. Henderson -----, **Axeman.**
- , **Flagman.**

Subscribed and sworn to before me, this Fifth day of

November 1887

[SEAL.] James E. Holman
U. S. Deputy Surveyor

FINAL OATH OF DEPUTY SURVEYOR.

We, James P. Currier & James E. Holand
United States Deputy Surveyor, do solemnly swear that in pursuance of

instructions received from Douglas H. Taylor

U. S. Surveyor General for Oregon, bearing date of the 20th

day of August 1887, I have well, faith-

fully and truly, in ^{of the} my own proper person, and in strict conformity with
the instructions furnished by the U. S. Surveyor General for Oregon, the
Surveying Manual, and the laws of the United States, surveying all those

parts or portions of Township 3 North

Range 34 East

Willamette Meridian, in the State of Oregon, as are represented in the
foregoing field notes as having been surveyed by me and under my direc-
tions; and I do further solemnly swear that all the corners of said survey
have been established and perpetuated in strict accordance with the Sur-
veying Manual, printed instructions, the special written instructions of
the U. S. Surveyor General for Oregon, and in the specific manner de-
scribed in the field notes, and that the foregoing are the *true* field notes of
such survey, and should any fraud be detected I will suffer the penalty of
perjury under the provisions of an Act of Congress approved August 8,
1846.

James P. Currier
James E. Holand U. S. Deputy Surveyor

Subscribed and sworn to before me, this 15th

day of March 1888

Chas Woodcock
Notary Public
for Oregon

FINAL OATH OF DEPUTY SURVEYOR

Office U. S. Surveyor General,

Portland, Oregon, August 10. 1888

The ^{following} ~~following~~ Field Notes of the Survey of the *Sub.*
Subdivisional lines of
 Township 3 North Range
 34 East Will. Mer Oregon
 executed by James P. Currier and James C. Nolan
 Special Joint U. S. Deputy Surveyors
 under his Contract No. _____, dated *May*

4th _____ 1887, having been critically examined, the
 necessary corrections and explanations made, the said Field Notes
 and the survey they describe, are hereby approved.

Douglas W. Taylor.
 Surveyor General.