

FIELD NOTES

165

Of the survey of the

Exterior

Lines of

*the diminished Umatilla
Reservation*

Willamette Meridian,

Oregon, as surveyed by

*Jas. G. Carrin and
Geo. E. Poland*

U. S. Deputy Surveyor, under his Contract No.

dated

May 4th 188*8* *1887* ✓

Survey commenced,

Oct 24th

188*7*

Survey completed,

November 4th

188*7*

NAMES AND DUTIES OF ASSISTANTS,

<i>L. J. Woolley</i>	, Compassman.
<i>E. L. Perry</i>	, Chainman.
<i>Guy Davis</i>	, Chainman.
<i>J. R. Hadley</i>	, Chainman.
<i>C. L. Raper</i>	, Chainman.
<i>C. Moore</i>	, Axeman.
<i>J. W. Gordon</i>	, Axeman.
	, Flagman.

PRELIMINARY OATHS OF ASSISTANTS.

We, _____

G. S. Perry, Guy Davis, J. R. Madley, C. Kaper

do solemnly swear that we will faithfully execute the duties of Chain Carriers, that we will level the chain over even and uneven ground, and plumb the tally pins, either by sticking or dropping the same; that we will report the true distance to all notable objects, and the true length of all lines that we will assist in measuring, to the best of our skill and ability, and in accordance with the instructions given us in

the survey of the _____

Exterior

lines of _____

Diminished

Reservation

Willamette Meridian, Oregon.

_____, Chainman.

G. S. Perry

_____, Chainman.

Guy Davis

_____, Chainman.

J. R. Madley

_____, Chainman.

C. Kaper

Subscribed and sworn to before me, this _____

Twenty fourth

day of _____

October

188____

[SEAL.]



James E. Holand

U.S. Dept. Surveyor

We, _____

C. Moses, J. H. Stendon

and _____

do solemnly swear that we will well and truly perform the duties of Axemen in the establishment of corners and other duties, according to instructions given us, and to the best of our skill and ability, in the survey of the _____

Exterior lines of

the Diminished Reservation

Willamette Meridian, Oregon.

_____, Axeman.

C. Moses

_____, Axeman.

J. H. Stendon

Subscribed and sworn to before me, this _____


Twenty fourth

day of _____

October

188____

[SEAL.]

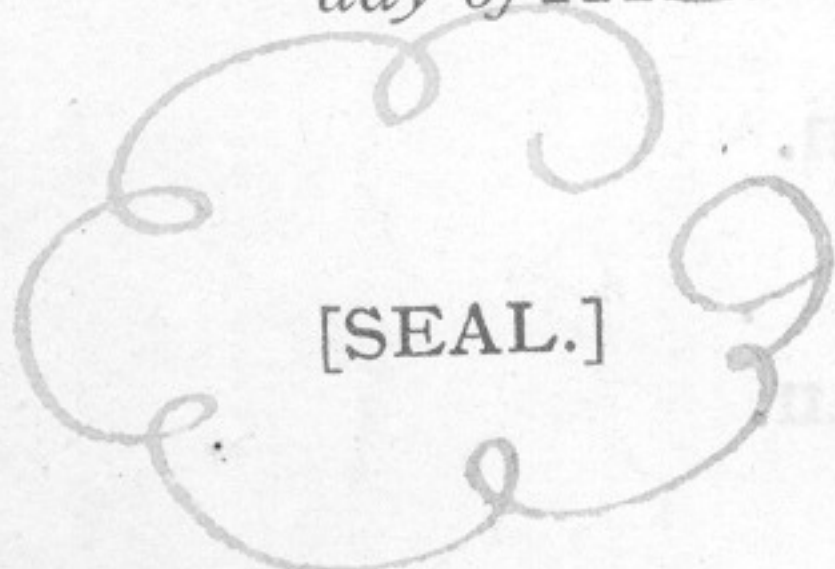

James E. Holand

U.S. Dept. Surveyor

R33E

R34E *Index*

R35E

R36E

168

T4N

169

T4N

T3N

T3N

T2N

T2N

T1N

T1N

R33E

R34E

R35E

R36E



222
Exteriors of T. Quinnishod R. Reservation
Willamette Meridian, Oregon.

(8093-10 M.)

Thence East retracing
Township line bet sec 31^{and} 32
Tps 2^{and} 3 North R 36 East
Wa 18°45'E

110 Cor to Townships 3 North
Ranges 35^{and} 36 East which
is a basalt stone in mound of
stone and which I mark Q. R.
on N. face

1660 Top of ridge N + 600
Descend steep mountain side

4140 1/4 sec. cor. on S bdy sec 31
T. 3 N. R. 36 E which is a stone
in a mound of stone and marked
Q. R. on N. face

6090 Meacham creek 60 ft wide course

7090 Q. R. and Rail road course N. and S.

8140 Cor to sec 31^{and} 32 T. 3 N. R. 36 E
which is a stone in mound of
stone which I mark Q. R. on N. face
mountainous 8140 chs
land very rough, soil 2nd rate

Exterior of T. Diminished R. Reservation
 Willamette Meridian, Oregon.

(8093-10 M.)

N. 35° W. 4.40 chains

N. $43^{\circ}30'$ W. 4.00 "

N. $16\frac{1}{4}^{\circ}$ W. 5.00 " To

8000

27th M. post. a basalt stone
 in stone mound which
 I marked D.R. on S. face.
 Land rough and rocky

Sail 4th rate line

underbrush scattering pine timber

8000 chs.

Oct-31-1887

Thence retracing meanders
 of 27th Mile

to $21\frac{1}{2}^{\circ}$ East

N. $16\frac{1}{4}^{\circ}$ W. 1.50 chains to meander

cor to fractional sec 13 and 18

Townships 30 N. Rgs 35 and 36 E

basalt stone in stone mound
 which I marked D. Row S. W. face

N. $49\frac{1}{2}^{\circ}$ W. 4.00 chains

N. $50\frac{1}{2}^{\circ}$ W. 5.20 "

N. $61\frac{3}{4}^{\circ}$ W. 15.00 "

Exterior of T. Amished. Reservation
Willamette Meridian, Oregon.

(11-01-1855)

N. 36 1/2° W. 4.30 chs
 N. 61° W. 195 To meander cor.
 to fractional sec. 12 and 13 T3R
 R. 35 Q. a stone in mound of
 stone which I mark Q. R. on S. face
 N 61° W 8.05 chains To
 1/2 M. post. a basalt stone in
 stone mound which I mark
 Q. R. on S. W. face
 N 69 1/4° W 8.50 chains to forks
 of Wild Horse creek
 S 32° W 6.50 chains
 S 50 1/4° W. 1.40 " To meander
 cor. to sec 12 and 13 a basalt stone
 in stone mound which I mark
 Q. R. on S. face
 S. 50 15' W. 2.60 chains
 N 76 30 W 3.27 " To
 meander cor. to sec 12 and 13
 a stone in stone mound
 which I marked Q. R. on S. face

4000

FINAL OATHS FOR SURVEYS.

A list of the names of the individuals employed by James P. Carrin
and James C. Roland, U. S. Deputy Surveyor, to assist in
 running, measuring and marking the lines and corners described in the foregoing field
 notes of the survey of the Exterior
Umatilla Reservation lines of the Diminished
Willamette Meridian, Oregon,
 showing the respective capacities in which they acted:

- L. J. Woolley -----, **Compassman.**
- E. G. Perry -----, **Chainman.**
- Guy Davis -----, **Chainman.**
- J. R. Hadley -----, **Chainman.**
- C. Kaper -----, **Chainman.**
- H. Moses -----, **Axeman.**
- J. H. Henderson -----, **Axeman.**
- , **Flagman.**

FINAL OATHS OF ASSISTANTS.

We hereby certify that we assisted James P. Carrin and
James C. Roland, U. S. Deputy Surveyor, in surveying all
 those parts or portions of the Exterior
lines of the Diminished
Umatilla Reservation Willamette Meridian, Oregon,
 as are represented in the foregoing field notes as having been surveyed by him and under
 his direction; and that said survey has been in all respects, to the best of our knowledge
 and belief, well and faithfully surveyed, and the corner monuments established, according
 to the instructions furnished by the U. S. Surveyor General of Oregon.

- L. J. Woolley -----, **Compassman.**
- E. G. Perry -----, **Chainman.**
- Guy Davis -----, **Chainman.**
- J. R. Hadley -----, **Chainman.**
- C. Kaper -----, **Chainman.**
- H. Moses -----, **Axeman.**
- J. H. Henderson -----, **Axeman.**
- , **Flagman.**

Subscribed and sworn to before me, this fourth day of
November 1887

[SEAL.] James C. Roland
U. S. Deputy Surveyor

FINAL OATH OF DEPUTY SURVEYORS

We James P. Currier and James E. Holand
United States Deputy Surveyors, do solemnly swear that in pursuance of

instructions received from Douglas H. Taylor

U. S. Surveyor General for Oregon, bearing date of the 20th

day of August 1888, I have well, faith-

fully and truly, in my own proper person, and in strict conformity with the instructions furnished by the U. S. Surveyor General for Oregon, the Surveying Manual, and the laws of the United States, surveying all those

parts or portions of the Exterior bdy. of the Diminished Reservation

Willamette Meridian, in the State of Oregon, as are represented in the foregoing field notes as having been surveyed by me and under my directions; and I do further solemnly swear that all the corners of said survey have been established and perpetuated in strict accordance with the Surveying Manual, printed instructions, the special written instructions of the U. S. Surveyor General for Oregon, and in the specific manner described in the field notes, and that the foregoing are the true field notes of such survey, and should any fraud be detected I will suffer the penalty of perjury under the provisions of an Act of Congress approved August 8, 1846.

James P. Currier, James E. Holand
U. S. Deputy Surveyors

Subscribed and sworn to before me, this 23rd

day of February 1888

Allen Woodcock
Notary Public
for Oregon



Office U. S. Surveyor General,

Portland, Oregon, October 6th - 1888The ~~following~~ ^{foregoing} Field Notes of the Survey of the _____of the Boundary Lines
of the Diminished __________ Unatilla Indian
Reservation Oregon
executed by James P. Curran and James O. Nolan
Special U. S. Dept. Surveyors.
under his Contract No. _____, dated May 4_____ 1887, having been critically examined, the
necessary corrections and explanations made, the said Field Notes
and the survey they describe, are hereby approved.Douglas W. Taylor
Surveyor General.