

250 250 B


Index

Referring to the pages of the field notes.

Town 3 N. Range 36 E. Will. Mer-

| | | | | | | |
|----|----|----|----|----|----|----|
| 14 | 15 | 16 | 17 | 18 | 19 | |
| 6 | 5 | 4 | 3 | 2 | 1 | 13 |

all of this

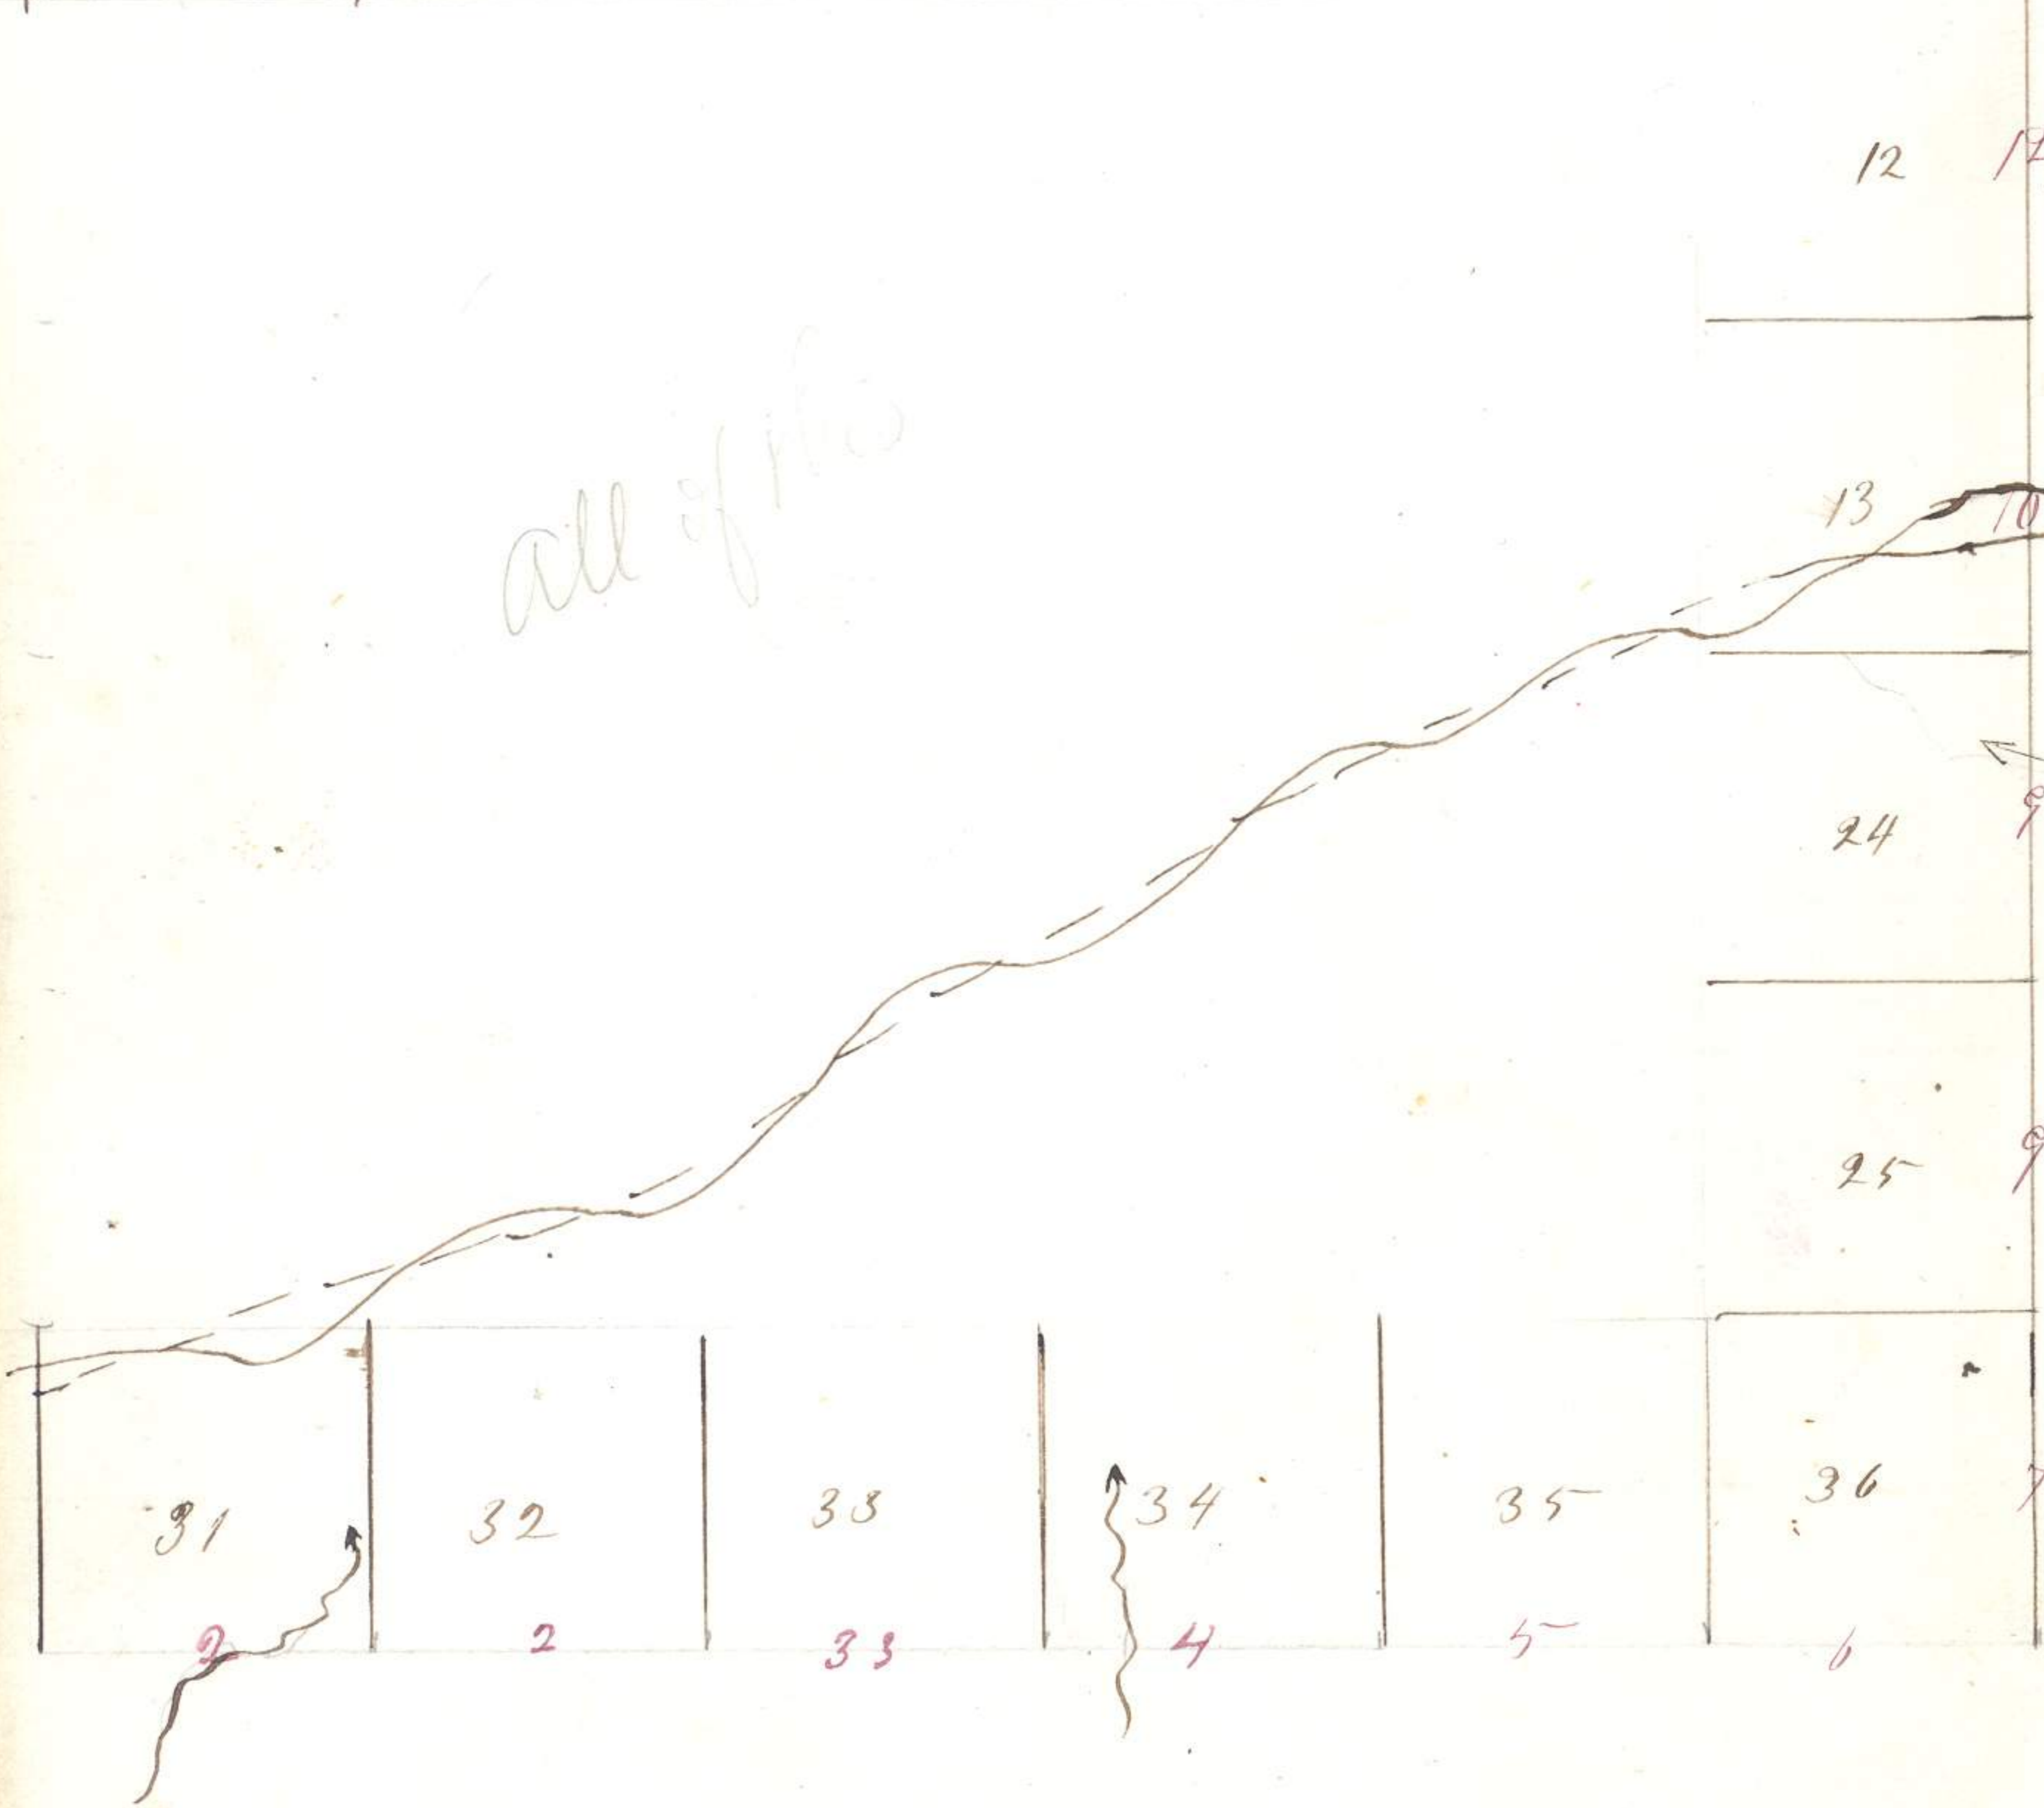

Field notes of the survey of
the exterior lines of Township
number 3 North of the Base
Line of Range 36 East of Willamette
Meridian in the State of Oregon
by William H. Odell, deputy
Surveyor under his contract
No 114 bearing date July
2nd 1866.

Commenced September 3rd
1866 and completed
September 25th 1866.

Township 3 North Range 36 East

40.00 Set post corner for 1/4 section ⁺350 ⁺350
 from which

A Fir 12 in - dia - bears S 70° East 14 ft
 no other tree near
 dug pit and raised mound
 as per instructions,

6.00 Summit of ridge course S, W, ⁺500 ⁺500
 Bar 21° East =

8.00 Set Bassalt Stone 7x9x24. on ⁵⁰ ⁵⁰
 steep side hill facing the south,
 This line passes over very
 broken mountain ridge
 quite rocky -

East on South boundary
 of section 36

Bar 20° East

40.00 Set post corner for 1/4 section ⁺700
 on mountain side facing
 the west, drove charred stake
 dug pit and raised mound
 as per instructions

257⁹

Township 3 North Range 36 East

8000 Set post corner for townships 243

+
100

North Ranges 36 & 37 East section

1. 6. 31. 436, ~~xxxx~~ which on
a Fir 24 in dia - ~~xxxx~~ was made
for corner, from which

a Fir 20 in dia - bears S 20° W 21 Mo
do - do - 18 do - do - do - N 30° W 65 do -
do - do - 16 do - do - do - N 65° E 40 do -
no tree near in section 6,

This line passes up the
mountain the corner is near
the summit of the Blue Mountain

The last 20, 111 ch through
timber Fir Larch & Pine
Undergrowth the same
with Willow,

September 3rd 1866,

North on East boundary
of section 36,

Bar 21° East,

4000

Set post corner for $\frac{1}{4}$ section

Township 3 North Range 36 East

on side hill on brink
of mountain from which

A Fir 20 in dia bears S40°E, 21 lbs

do-do- 10 do-do-do- N, 10°W, 50 do-

8000 Set post corner for sections 250 250

25, 36, 30 & 31, on east side of ridge

near summit, from which

A Fir 6 in dia bears N10°E, 35 lbs

do-do- 8 do-do-do- N, 20°W, 56 do-

no tree near in sections 31 & 36

Made Mound of stone as per
instructions,

This line on the south half
passes over level land, through
timber consisting of Fir & Larch

The north half passes across
head of canyon on to ridge
sides of canyon on the
south timbered,

Township 3 North Range 3 East - ²⁵⁹

North on East boundary
of section 25

Bar 20° E -

40.00 Set post corner for $\frac{1}{4}$ section 200
on steep mountain side on east
side of ridge from which
A Pine 36 in dia - bears $S 2^{\circ}$ E - 100 lbs
do - do - 8 do - do - do - $N 6^{\circ}$ E - 50 do -

80.00 Set post corner for sections 300
24. 25. 19430. in ravine corner
west, deposited marked
stone and raised stone mound
as per instructions.

Land broken & rocky
timber in the canyons on
south side, consisting of
Fir Larch & Pine,

North on East boundary of
section 24.

Bar 20° East

40.00 Set post corner for $\frac{1}{4}$ section 175

Township 3 North Range 36 East -
on hill side facing the East
from which

A Fir 6 in - dia bears South 65° 0 lbs
no tree near on west side 7000

59.50 Small creek 3 lbs wide course N W \checkmark 7000

80.00 Set post corner for sections 13. 24,
18 & 19 on summit of ridge course $+500$ + 500

North West, deposited stone &
marked stone marked as per
instructions from which

A Pine 8 in - dia - bears N 26° W, 200 lbs

do - do - 10 do - do - do - N, 27° E, 210 lbs

This line passes across deep
Canyon on the south side
through thick timber, North
side open some grass, soil
stony,

North on East boundary
of section 13

Bar 20° E -

32.50 Boise City Stage Road course 550

269 71

Township 3 North Range 36 East -

South of West

39,850 Amatilla River course S.W. 6

40,000 Middle of river, Made corner
for 4-section 60 links south
of true corner on Fir 8 in dia -
on left bank of the river
from which

A Fir 7 in dia - bears S 20° W 12 links

do - do - 10 dia do - do N 85° E 27 do -

September 4th 1866 -

8000 Set Basalt Stone 6 x 8 x 16 800.

corner for sections 12, 13,

7 & 18, on steep mountain side
facing the south,

This line passes
over very broken lands

Timber along the Amatilla
River Fir Pine & Balsm

The mountain sides on the
south are bald on the
north timbered, all
more or less rocky.

Township 30 North Range 36 East,
The open lands have fair
yield of grass,

North on East boundary
of section 12,

Bar 15° East

4000

Set post corner for $\frac{1}{4}$ section ⁴⁰⁰ ⁺ 4000
on summit of Ridge Course
S, W. deposited Marked
Stone and Made Stone

Mound as per instructions,

8000

Set post corner for sections ¹⁰⁰ ⁺ 100
1, 12, 6 & 7, on hill side
facing the East, Made
Stone Mound as per
instructions, after deposit-
ing Marked Stone,

This line crosses up
mountain side from Amatta
River some grass on the
ridges, Soil Stony,

Township 3 North Range 36 East

North on East boundary
of section 1,

Bar 16° East,

40.00 Set post corner for 1/4 section ⁵⁰

from which,

A Larch 10 in. dia bears N 15° W, 32 lbs

do - do - 12 do - do - do - S 35° E 26 do

Bar 20° East -

80.00 Set post corner for Townships

374. North Range 36 437

East Sections 1, 6, 31, 436,

from which

A Fir 10 in dia bears N 10° W, 24 lbs

do - do - 8 do - do - do - N 55° E, 20 do,

do - do - 6 do - do - do - S 45° E, 30 do -

do - do - 12 do - do - do - S 3° W, 18 do,

This line passes through
thick timber, considerable
of it fallen. Timber Fir and
Larch. Undergrowth the
same with Willow

September 5th / 1866,

A list of the names of
 the persons employed to assist
 in running measuring or marking
 the lines and corners described in
 the foregoing field notes of the
 Exterior boundaries of Township No
 3 North of the Base Line of Range 36 East
 of Willamette Meridian, showing the
 respective capacities in which
 they acted.

J. J. Henderson, }
 John A. Riggs } Chairman
 P. M. Denney Axeman.

Carroll J. Applegate

William H. Odell, ²⁷⁵

Deputy surveyor, do solemnly swear that in pursuance of a Contract entered into with E. L. Applegate surveyor of the public lands of the United States in the State of Oregon, bearing date July 2^d 1866, and in strict conformity to the laws of the United States and the instructions furnished by said Surveyor General, I have faithfully surveyed the Exterior boundaries of Township number 3 North of the Base line of Range 36 East of Willamette Meridian, in the State aforesaid, and do further solemnly swear the foregoing are the true and original field Notes of such survey.

William H. Odell

State of Oregon

County of Lane

} ss. Subscribed, and

Sworn to before me, this 23^d day of December 1866.

Joel Ware

Notary Public

We hereby certify that we assisted
 William H. Odell Deputy surveyor, in
 surveying the exterior boundaries of
 Townships No 3 North of Ranges No
 35 & 36 East of Willamette Meridian, also
 No. 4 North of Ranges 34 & 35 East of
 Willamette Meridian, and that said
 exterior boundaries have been in all
 respects, to the best of our knowledge and
 belief well and faithfully surveyed and the
 boundary monuments planted according
 to the instructions furnished by the Surveyor
 General.

| | |
|-----------------|-----------|
| J. J. Henderson | Chairman |
| J. A. Trigg | Chairman |
| P. A. Demey | Assessors |

State of Oregon }
 Sworn to before me this day
 of September A. D. 1866.

William Luellen Justice of the Peace

com

278

Surveyor General's Office
Eugene City January 17 1867

The foregoing field notes of the survey
of the Exterior boundaries of Township
N^o 3 North Range 36 East Will. Mer
Oregon executed by William H
Odell. Deputy Surveyor under his
contract N^o 114. bearing date
July 2nd. 1866 having been critic-
ally examined, the necessary correc-
tions and explanations made
the field notes and the surveys
they describe are hereby approved

E. I. Applegate

Surveyor General of Oregon

Recd
to his