


Township N 3 North, Range W 37 East W.M. Mer.

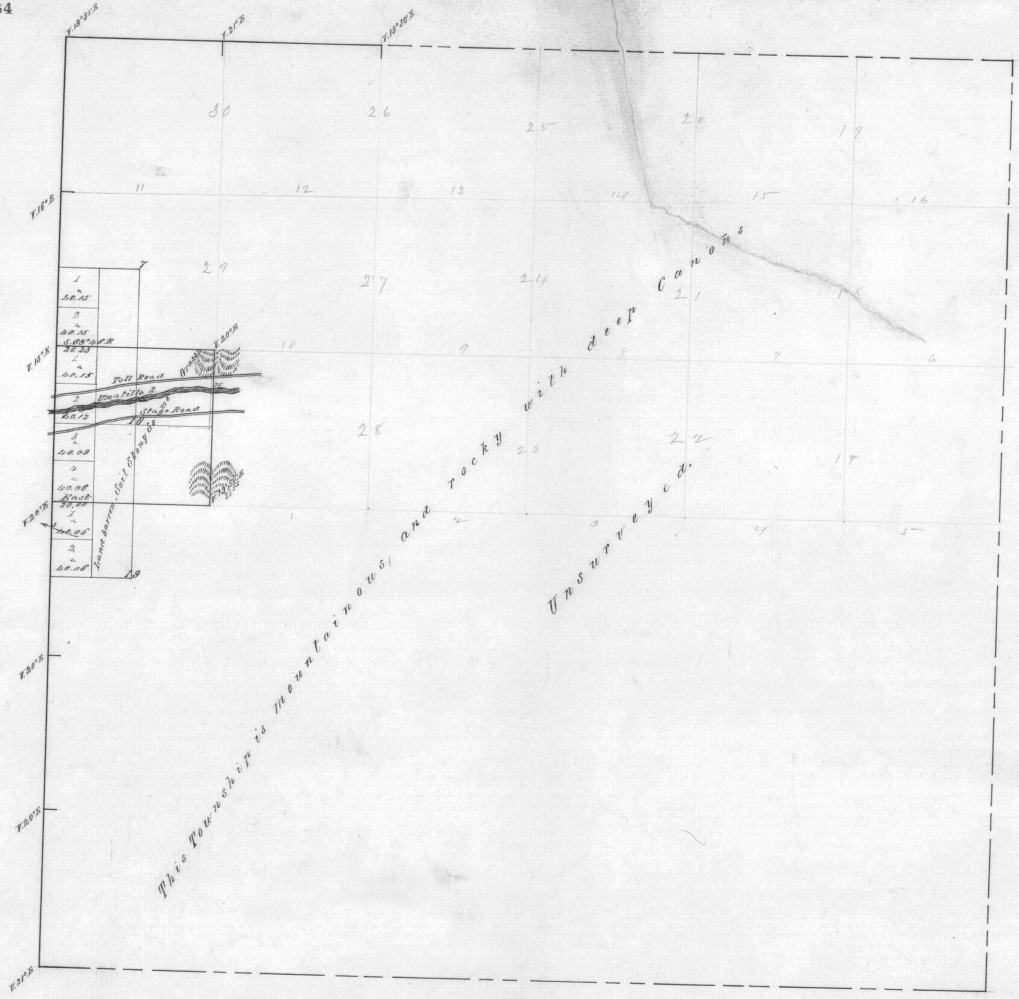

Scale 40 Chs to an Inch

Lines	Contractors	Contract		Int. Order No. Chs. Trs.	Completed
		No.	Date		
Subdivisions	W. H. Odell	31	July 2 <sup>d</sup> 1887	3 00 00	Sept. 7 <sup>th</sup> 1887
<u>Total Acres 260.00</u>					

This plan map of fractional Township N 3 North, Range W 37 East, W.M. Mer., Oregon, is hereby confirmed to the original field notes of the Survey being on file in this office, which has been examined & approved.  
 Surveyor General's Office  
 Oregon City Feb. 18<sup>th</sup> 1887  
 E. L. Applegate  
 Surveyor Genl. of Oregon.