

FIELD NOTES

Of the survey of the *Subdivisional* -----

Lines of Township -----

Willamette Meridian, Oregon,

Executed by *George S. Pershin* -----

U. S. Deputy Surveyor, under his contract No. *332* -----

dated *July 29*, -----, 18*79*

List of the names of the persons employed to assist in running, measuring and marking the lines of the foregoing survey :

Homer C. Pershin ----- Chainman.

Valentine B. Peterson ----- Chainman.

----- Chainman.

Corrington S. Newell ----- Axeman.

----- Axeman.

----- Flagman.

PRELIMINARY OATHS OF ASSISTANTS:

We, Homer C. Perskin and
Valentine B. Peterson

do solemnly swear that we will faithfully execute the duties of Chain Carriers, that we will level the chain upon uneven ground, and plumb the tally pins, whether by sticking or dropping the same; that we will report the true distance to all notable objects, and the true length of all lines, that we assist in measuring, to the best of our skill and ability.

Homer C. Perskin Chainman.

Valentine B. Peterson Chainman.

----- Chainman.

Subscribed and sworn to before me, this fourth
day of September 1879

Geo. S. Perskin
U.S. Dep Sur

Corrington S. Newell and

do solemnly swear that ~~we~~ ^I will well and truly perform the duties for which ~~we~~ ^I have been severally employed according to instructions, and to the best of ~~our~~ ^{my} skill and ability.

Corrington S. Newell Axeman.


----- Axeman.

Subscribed and sworn to before me, this fourth
day of September 1879

Geo. S. Perskin
U.S. Deputy Sur.

Subdivisions of Township No. 3 South Range 30 1/2 East
Willamette Meridian, Oregon.

460

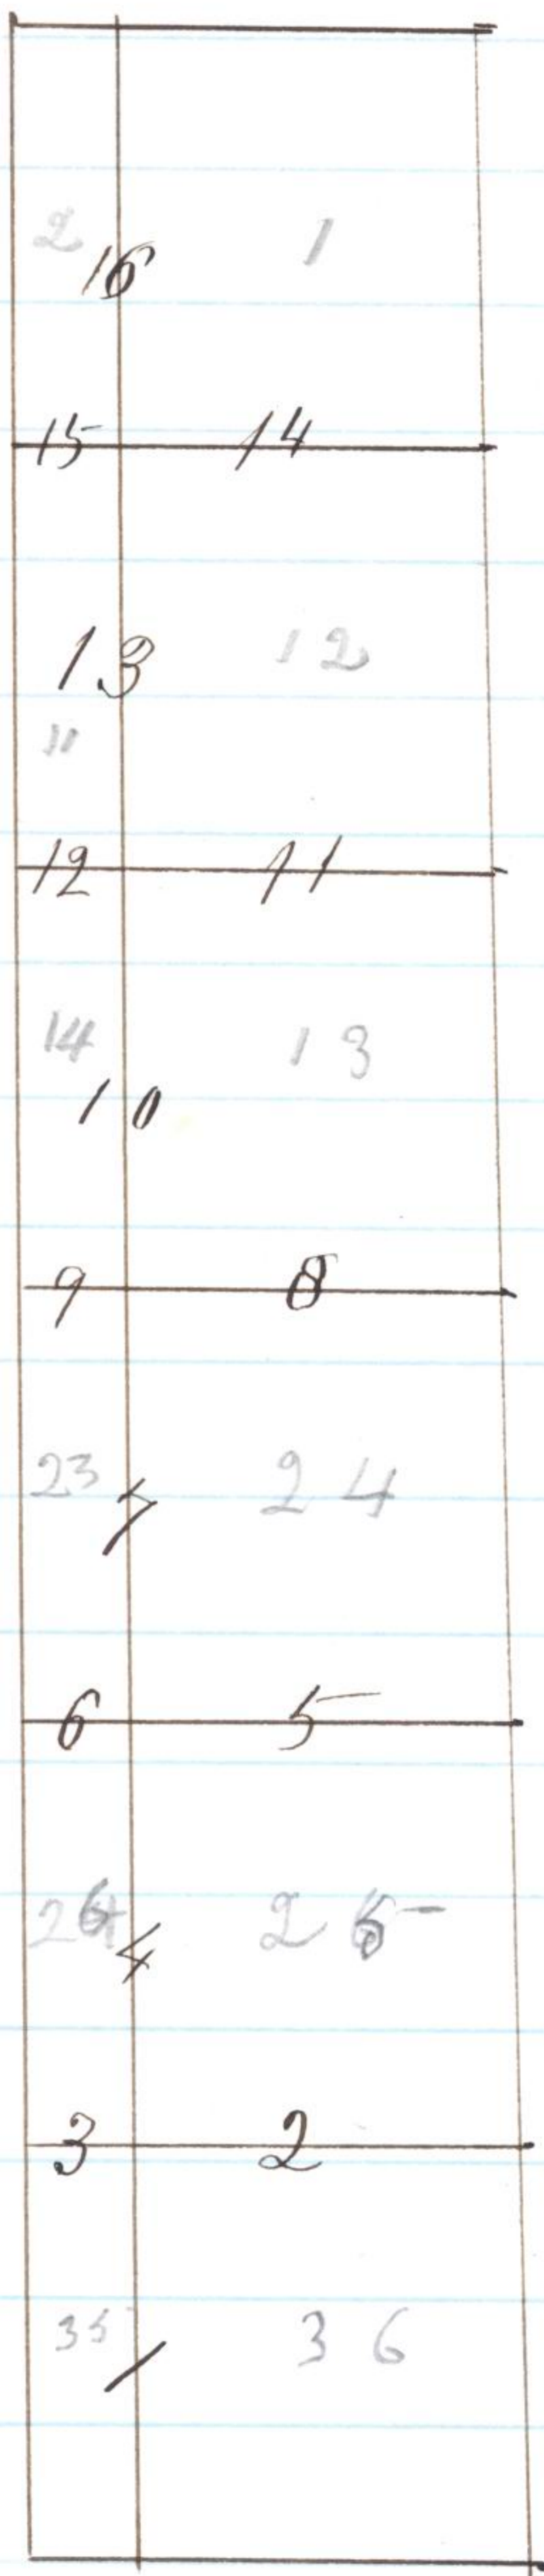

7
Subdivisions of Township No. 3 South Range 30 1/2 East
461
Willamette Meridian, Oregon.

Begin at the cor. to Sec. 35 & 36 on the south
Boundary of the Township & I run
North between Sec. 35 & 36
Ora. 21° 15' East

39.50 A Ravine opens N.W.

40.00 Set Basalt Stone 15 x 8 x 7 on
S.W. face of ridge for 1/4 Sec. cor

76.00 Enter grove of timber 68 M.

80.00 Set Basalt Stone 16 x 10 x 5 on ⁻⁴⁵⁰ -450

North slope of spur for cor to
Sec. 25, 26, 35, & 36 from which
A Pine 6 in. di. brs. N. 22° E 51' lbs dist

" " 50 " " " S. 45° E 28 " "

" Fir 8 " " " S 85° W. 65 " "

" Pine 11 " " " N. 17° W. 27 " "

Land: Surface Mountainous;

Soil 3rd rate; good grass;

valuable for grazing; some
good pine timber

Subdivisions of Township No. 3 South Range 30 1/2 East -
Willamette Meridian, Oregon.

462

East on a random line between Sec. 25 & 36

Pa. 20° 45' East -

^{40.00} 40.00 Set post for temporary 1/4 Sec. cor.

^{80.56} 80.56 Intersected E Boundary 132 lks
South of cor. to Sec. 25 and 36 from
which cor. ^o I run

S. 89° 03' West on a true line

between Sec. 25 & 36

Pa 20° 00' East -

^{38.00} 38.00 Center timber N.W. & S.E.

^{39.00} 39.00 Spring Branch cor N.W.

^{40.28} 40.28 Set Basalt Stone 16x10x7 on N.E.

Slope for 1/4 Sec. cor.

A Fir in indi. brs. N. 22° E 48 lks. dist.

" " 8 " " " S. 10° W. 31 " "

^{44.00} 44.00 Leave timber cor N & S

^{76.00} 76.00 Center " " " "

^{80.56} 80.56 The Cor to Sec. 25, 26, 35 & 36 - 600

Land: Surface Mountainous: soil

3rd rate some good timbers Pine Fir

& Tamarack: good grass: about 1/3 of

Sec. 36 has good timber

Subdivisions of Township No. 3 South Range 30 1/2 East

463

Willamette Meridian, Oregon.

West on a random line between sec. 26 & 35

Pa 20° 45' East

11.26 Intersected West-Boundary 28

lhs. North of cor. to sec. 26 & 35-

from which cor. I run

N. 88° 35' East on a true line

between sec. 26 & 35-

Pa 14° 15' East

8.00 Gulch opens. N.E. -150 -150

11.26 The cor. to sec. 25-26. 35-36 -40 -40

Land surface steep hillsides
Soil 3rd rate good grass

Subdivisions of Township No. 3 South Range 30 1/2 East
Willamette Meridian, Oregon.

464

North between sec 25 & 26

Pa. 20° 45' East

^{60.50} 6.50 Gulch opens N. E & leave timber -50

^{40.00} 4.00 Set Basalt Stone 17 x 12 x 4 on E. hillside for 1/4 sec. cor. -50

A Pine 12 in. di. brs. S. 33° E 122 lbs dist

No tree on west side

^{42.00} 42.00 Enter timber co S. E & N. W.

^{46.00} 46.00 Leave "gulch" opens N. W. also -120

^{80.00} 8.00 Set Basalt Stone 16 x 8 x 6 and +200 post in mound of stone on west side of ridge for cor to sec.

23. 24. 25 & 26

Land: Surface Mountainous:
Soil third rate; good grass;
Some good timber Pine & Fir

5

Subdivisions of Township No. 3 South Range 30 1/2 East

465

Willamette Meridian, Oregon.

East on a random line between Sec 24 & 25

Pa. 19° 15' East

40.00 Set post for temporary 1/4 Sec. cor

80.74 Intersected E. Boundary 118 lks

South of cor to Sec. 24 & 25

from which cor. I run

S. 89° 09' West on a true line

between Sec. 24 & 25

Pa. 21° 15' East

40.37 Set Basalt stone 16 x 10 x 8 on

N. W. Slope for 1/4 Sec. cor.

80.74 The cor. to Sec. 23, 24, 25 & 26 ⁻⁷⁰⁰ -700

Land: Surface Mountainous;
Soil: 3rd & 2nd rate; good
grap. About 1/3 of Sec. 25
is covered with good
timber in the S. E part
Pine Tamarack & Fir

Subdivisions of Township No. 3 South Range 30 1/2 East
 Willamette Meridian, Oregon.

466

West on a random line between sec 23 & 26

11.28 Pa. $19^{\circ}15'$ East

11.28. Intersected West Boundary 20 lks
 North of cor. to sec. 23 & 26 from
 which cor. I run

N. $89^{\circ}00'$ East on a true line
 between sec. 23 & 26

11.28 Pa. $22^{\circ}45'$ East

11.28 The cor. to sec. 23, 24, 25 & 26 +250

Land: surface steep hillside
 soil 3rd rate good grass

September 3rd 1879

Subdivisions of Township No. 3 South Range 30 1/2 East -
Willamette Meridian, Oregon.

467

North between Sec. 23 & 24

Qa. 19° 15' East

- 34.00 Gulch opens N.W.
- 40.00 Set Basalt Stone 18x8x5
on S.W. face of hill for 1/4 sec. cor.
- 60.00 Leave Mountain proper. ⁻²⁵⁰ 250
- 80.00 Set Basalt Stone 18x12x4 on
E. slope of ridge. and post on
Mound of Stone for cor. to
Sec. 13. 14. 23 & 24

Land: Surface Mountain
res. soil 3rd & 2nd rate
good grass. good for
grazing

Subdivisions of Township No. 3 South Range 30 1/2 East
Willamette Meridian, Oregon.

468

East on a random line between Sec. 13 & 24

Pa. 19° 15' East -

^{40.00}
40.00 Set Post for temporary 1/4 sec. cor
^{80.68}
80.68 Intersected East Boundary 142 lbs
South of cor to Sec. 13 & 24 from
which cor. I run

S 88° 59' West on a true line
between Sec. 13 & 24

Pa 21° 00' East

^{40.34}
40.34 Set Basalt Stone 18 x 12 x 5 on
knoll for 1/4 sec. cor.

^{63.50}
63.50 Brook 10 lbs under co. N.M. - 200

^{80.68}
80.68 The cor. to Sec. 13. 14. 23 & 24 + 200

Land: Surface some broken
soil 3rd rate small part on brook
1st rate & good for farming
some Pine & Balsm timber
on Brook

9

Subdivisions of Township No. 3 South Range 30 1/2 East
Willamette Meridian, Oregon.

469

West on a random line between Sec. 14 & 23

Bearing: 19° 15' East

11.28 Intersected West Boundary 18 lbs
South of cor. to Sec. 14 & 23 from
which cor. I run

in 89° 04' East on a true line
between Sec. 14 & 23

Bearing 20° 00' East

11.28 The cor. to Sec. 13, 14, 23 & 24

Land: Surface rolling;
Soil 3rd rate good grass

Subdivisions of Township No. 3 South Range 30 1/2 East
Willamette Meridian, Oregon.

470

North between Sec. 13 & 14

va. 19° 15' East -

along on E slope of ridge

^{40.00}
4,000 Set Basalt Stone 12 x 10 x 8 on N. descent of ridge for 1/4 Sec. cor.

^{69.50}
69,50 A Brook 12 ft. wide co. N.W. - 200

^{20.00}
80,00 Set Basalt Stone 20 x 8 x 5 on S.W. + 100

face of hill for cor. to Sec. 11, 12, 13 and 14 also set post in mound of Stone

Land: Surface some broken;
Soil 3rd & 2nd rate good grass
Alder, & Willow brush along
Brook.

Subdivisions of Township No. 3 South Range 30 1/2 East

Willamette Meridian, Oregon.

471

East on a random line between Sec. 12 & 13

Ba. 21° 30' East -

40.00 Set post for temporary 1/4 Sec. cor.

80.52 Intersected E. Boundary 122 lks

South of Stone cor. to Sec. 12 & 13

from which cor. I run

S. 89° 08 West on a true line

between Sec. 12 & 13

Ba 20° 00' East -

House bears th 37° W

" " th 24° W

15.00 1 1/2 " " th. 20° W

2 " " " th. 10' E

40.20 Set Basalt Stone 18x10x7 on N.

Slope for 1/4 Sec. cor.

80.52 The cor. to Sec. 11, 12, 13 & 14 -50 -50

Land: Surface rolling; soil
1st & 3rd rate good grass: good
farming land.

About 1/3 of Sec. 13 is good
farming land

Subdivisions of Township No. 3 South Range 30 1/2 East
Willamette Meridian, Oregon.

472

West on a random line between Sec. 11 & 14

Pa 21° 30' East

^{11.12} 11.12 Intersected N. Boundary 26 lks.
North of cor. to Sec. 11 & 14 from
which cor. I run
N 88° 42' East on a true line
between Sec. 11 & 14

Pa 24° 30' East

^{11.12} 11.12 The cor. to Sec. 11, 12, 13 & 14 + 80

Land: Surface: Steep
hillside Soil 3rd rate
good grass

13

Subdivisions of Township No. 3 South Range 30 1/2 East

473

Willamette Meridian, Oregon.

North between Sec 11 & 12

Pa. 21° 30' East

4000 Set Basalt Stone 16 x 8 x 5 on

North Slope for 44 Sec cor

Mound of Stone

4800 in Ravine opens to W. ⁻¹⁰⁰ -100

8000 Set Basalt Stone 14 x 10 x 8 ⁺¹⁵⁰ +150

and Stake in mound of
Stone on top of hill for
Cor. to Sec. 1, 2, 11 & 12

Land: surface rolling; soil
3rd & 2nd rate good grass
some good farming land

Subdivisions of Township No. 3 South Range 30 1/2 East
Willamette Meridian, Oregon. 474

East on a random line between Sec 1 & 12

On 21° 15' East

^{40.00} 40.00 Set post for temporary 1/4 Sec. cor.

^{80.54} 80.54 Intersected E. Boundary 140 lbs
South of cor to sec. 1 & 12 from
which cor. Run

S. 89° 00' West on a true line between
Sec. 1 & 12

On 21° 00' East

^{00.00} 00.00 Jack Baker's house brs. N. 47° W. about
4.00 lbs

^{22.00} 22.00 Griswold's house brs. N. 33° W. about
30. chs and cannot be seen from
any other point

^{40.27} 40.27 Set Basalt Stone 17x12x5 on East slope
for 1/4 Sec. cor

^{80.54} 80.54 The cor. to sec. 1, 2, 11 & 12

Land: Surface rolling; Soil
grey & 3rd rate good grass;

Nearly all of Sec. 12 is good
farming land

15

Subdivisions of Township No. 3 South Range 30' in East

Willamette Meridian, Oregon.

475

West on a random line between Sec 2 & 11

Ba 21° 15' East

11.2.6 Intersected N. Boundary 38 chs
North of cor. to Sec 2 & 11
from which cor. I run
N. 88° 00' East on a true line
between Sec 2 & 11

Ba 20° 00' East

11.2.6 The cor. to Sec. 1.2.11 & 12⁺⁶⁰ + 60

Land: Surface west-
hillside; soil 3rd rate
good grass

Subdivisions of Township No. 3 South Range 30 1/2 East
Willamette Meridian, Oregon. 476

North on a random line between Sec 1 & 2
Cba. 21° 15' East

^{40.00}
4000 Set post for temporary 1/4 Sec. cor
^{79.86}
79.86 Intersection N. Boundary 38 lks
west of cor. to Sec. 1 & 2 from
which cor. I run
S. 00° 17' West on a true line
between Sec. 1 & 2

Cba.
^{39.86}
39.86 Set Basalt Stone 20 x 10 x 6 on west
^{79.86}
79.86 face of knoll for 1/4 Sec. cor.
The cor. to Sec. 1, 2, 11 & 12. +100

Land: Surface undulating;
Soil 2nd & 3rd rate good
grass good for farming or
grazing: Nearly all of
Sec. 1 is good farming
land

September 4th 1879

Note - I raised mounds of stone at corners instead
of digging pits and making mounds of earth because
they are more permanent and more easily found

17

Subdivision of Township No. 3 South Range 30 1/2 East

Willamette Meridian, Oregon.

477

General description

Surface. The South half is mostly
 mountainous and N 1/2
 rolling or undulating; soil in
 South half nearly all 3rd rate;
 North 1/2 2nd rate and nearly
 all good for farming; It is
 well watered by springs &
 small streams. Sections
 36 & 25 are each about
 1/3 covered with good timber
 Section 24 has some timber
 in scattering groves but is
 mostly valuable for grazing
 There are 5 settlers in this
 Township. 2 on Sec. 1. 2 on
 Sec. 12 and 1 on Sec. 13

FINAL AFFIDAVIT OF ASSISTANTS.

484

We hereby certify that we assisted George S Pershin Deputy Surveyor, in surveying the Subdivision lines of Township 3 South Range 30 1/2 East Willamette Meridian, Oregon, and that said lines have been in all respects, to the best of our knowledge and belief, well and faithfully surveyed and the boundary monuments planted according to the instructions furnished by the Surveyor-General; and we do further swear that we each of us performed the work assigned us, faithfully to the best of our ability, in the capacity hereby indicated by our signatures.

Homer C. Pershin Chainman.

Vaentine Peterson Chainman.

Chainman.

Borington J. Newell Axeman.

Axeman.

Compassman.

STATE OF OREGON,

County of Umatilla }

Subscribed and sworn to before me, this 17th day of September 1879

S G Lightfoot
Justice of Peace

FINAL AFFIDAVIT OF ASSISTANTS.

We hereby certify that we assisted George S

Pershin Deputy Surveyor, in surveying

the Subdivision lines of Township
3 South Range 30 East Willamette Meridian, Oregon,

and that said lines have been in all respects, to the best of our knowledge and belief, well and faithfully surveyed, and the boundary monuments planted according to the instructions furnished by the Surveyor General; and we do further swear that we each of us performed the work assigned us, faithfully to the best of our ability, in the capacity hereby indicated by our signatures.

Homer C. Pershin Chainman.

Valentine B. Peterson Chainman.

Chainman.

Cornington S. Newell Axeman.

Axeman.

STATE OF OREGON,

County of Umatilla

Subscribed and sworn to before me, this 17th

day of September 1879.

S. Hightfoot

Justice of the Peace

George S. Perkins

Deputy Surveyor, do solemnly swear that in pursuance
of a contract with James C. Tolman

U. S. Surveyor General of the State of Oregon, bearing
date the 29th day of July 1879,

and in strict conformity with the Printed Manual of
Instructions, and the instructions given me by the Sur-
veyor General, I have faithfully surveyed the

Subdivision lines of Township 8
3 South Range 30 & 3 1/2 East aforesaid, and do
further solemnly swear that the foregoing are the true
and original field notes of such survey.

George S. Perkins

Deputy Surveyor.

STATE OF OREGON,

County of Multnomah

Subscribed and sworn to before me, a Justice
of the Peace in and for the said County
and State, this 23 day of September 1879

A. W. Davis

Justice of the Peace

Office U. S. Surveyor General,Portland, Oregon, *Oct 2* ----- 18*79*..

The foregoing Field Notes of the survey of *the* -----
Subdivisional lines of T3 S. Rgs 30 & 30 1/2 East -----
Will Meer Oregon -----

executed by *George S. Pershin* U.S. Deputy
Surveyor ----- under his contract No. *332* -----

dated *July 29* ----- 18*79*., having been
critically examined, the necessary corrections and ex-
planations made, the said field notes and the survey
they describe, are hereby approved.

James C. Tolson -----
Surveyor General.