

FIELD NOTES

Of the survey of the *Exterior*

Lines of Townships 3, 4 & 5 S. Rg 33 $\frac{1}{2}$ T 34 E.

Town 3 S. R. 33 E. of Willamette Meridian,
and part of 1st Standard Parallel South
Oregon, as surveyed by Rufus S. Moore

U. S. Deputy Surveyor, under his Contract No. 451

dated June 28th 1882

Survey commenced, October 12th 1882

Survey completed, November 11th 1882

NAMES AND DUTIES OF ASSISTANTS.

Rufus S. Moore, Compassman.

Jamie Gullidge, Chainman.

John Gullidge, Chainman.

, Chainman.

, Chainman.

Joe Parodi — Axeman.

, Axeman.

, Flagman.

184 PRELIMINARY OATHS OF ASSISTANTS:

We, James Guttridge and
John Guttridge

do solemnly swear that we will faithfully execute the duties of Chain Carriers, that we will level the chain over even and uneven ground, and plumb the tally pins, either by sticking or dropping the same; that we will report the true distance to all notable objects, and the true length of all lines that we will assist in measuring, to the best of our skill and ability, and in accordance with the instructions given us in

the survey of the Exterior lines of Townships 3.4 + 5 South

R 33 1/2 E & R 34 E and T. 3.8 R 33 E and part of 1st Standard Parallel S. through R 34 E Willamette Meridian, Oregon.

James Guttridge, Chainman.

John Guttridge, Chainman.

, Chainman.

, Chainman.

Subscribed and sworn to before me, this Fifteenth

day of August 1882

[SEAL.]

Rufus D. Moore

Notary Public

Joe Parodi

and

, do solemnly swear that we will well and truly perform the duties of Axemen in the establishment of corners and other duties, according to instructions given us, and to the best of our skill and ability,

in the survey of the Exterior of Twp 3.4 + 5 S. Rq 34 E + 38 R 33 1/2 E

part of 1st Hand - far. through R 34 E Willamette Meridian, Oregon.

Joe Parodi, Axeman.

, Axeman.

Subscribed and sworn to before me, this

day of August 1882


[SEAL.]

Rufus D. Moore

Notary Public

Inclined
referring the lines to page
in field notes

Diagram of T. 3 South R. 33 East

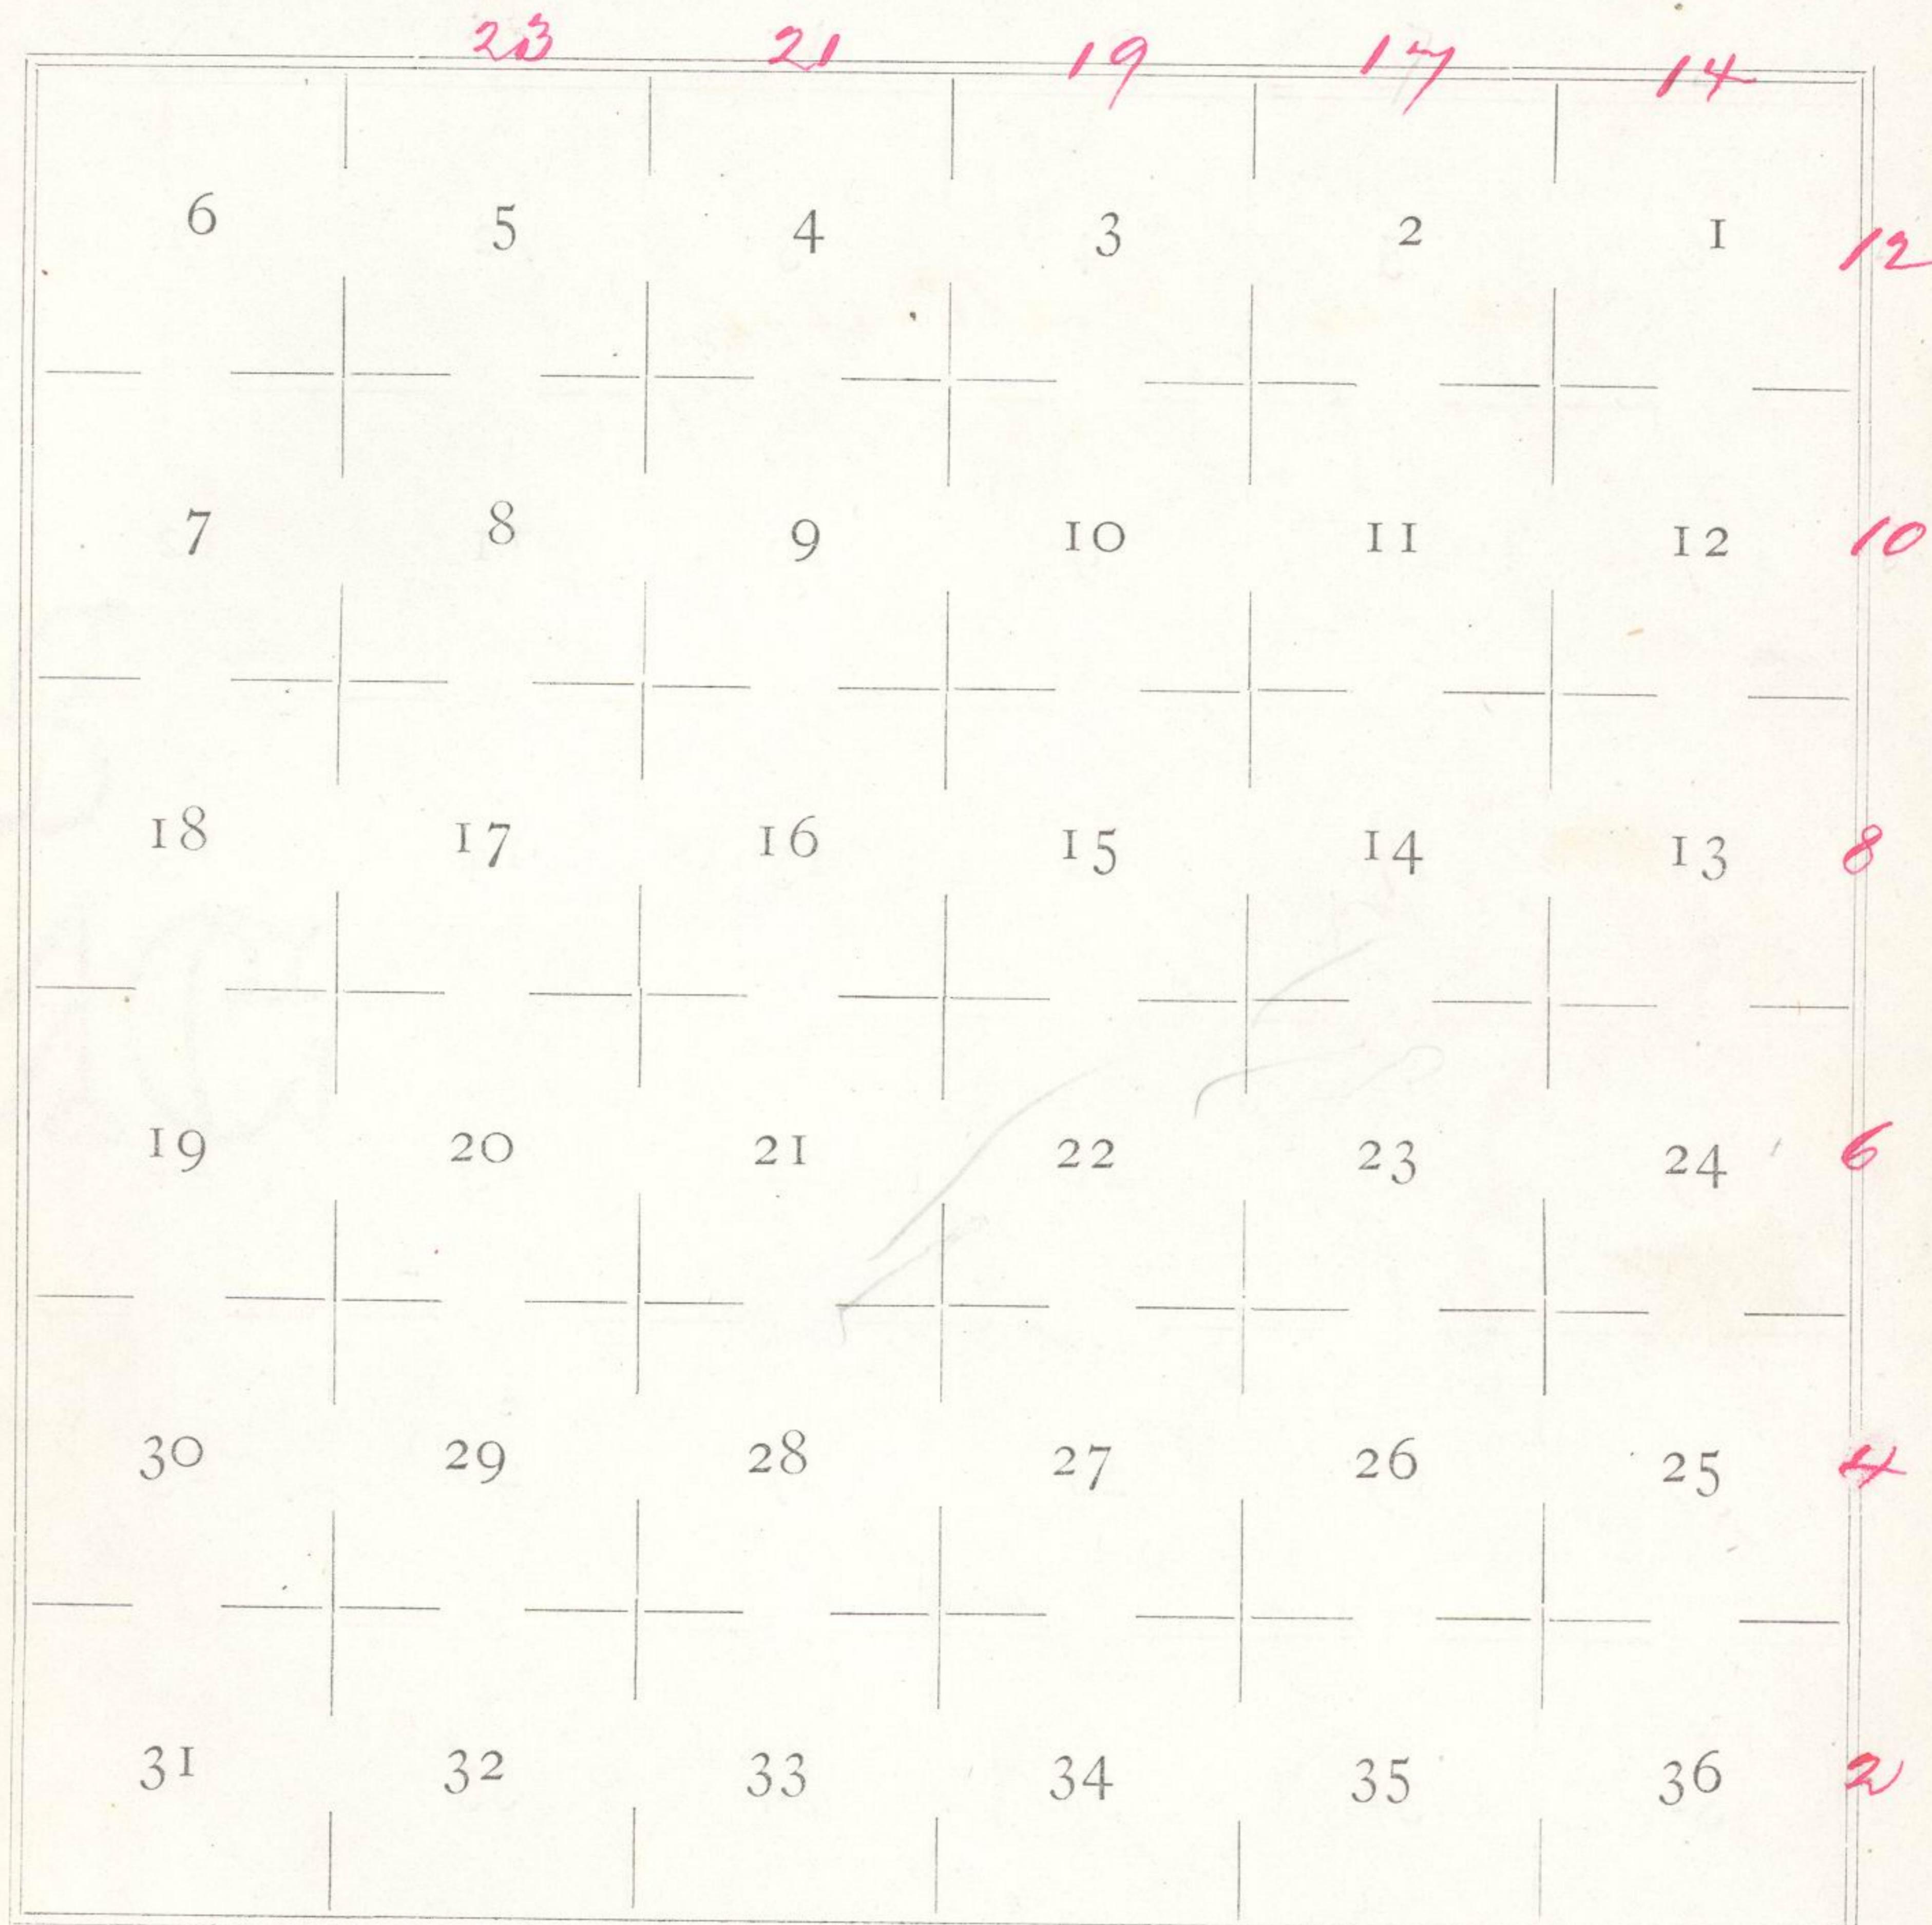

1

Exterior of T. 3 South R. 33 East 191

Willamette Meridian, Oregon.

From the corner to Township
3 and 4 South Range 33 East
which is a basalt stone
18 x 12 x 5 ins marked with
6 notches on each edge
from which

A pine 6 in diam beam N 38°
E 80° Ely dirt marked T 3 S.
R 34 E S 30 B.T.

A pine 16 in diam beam S 38°
E 48° Ely dirt marked T 3 S.R.
34 E S 31 B.T.

As I destroyed mark refer-
ring to Sec. 31 and T. 4 S.

A pine 15 in diam beam
S 50° W 13° Ely dirt marked
T 4 S R 33 E S 1 B.T.

A pine 12 in diam beam
N 74° W 23° Ely dirt marked
T 3 S.R. 33 E S 36 B.T.

I own

Sistering of T. 3 South. R. 33 East

Willamette Meridian, Oregon.

North on East boundary
of Sec. 36.

Var 20° 30' East

- 34.90 Enter open glade beav
NE & SW.
- 39.50 Only timber beav NE & SW.
- 40.00 Set basalt stone 16x8x7 in
12 in in ground for $\frac{1}{4}$ sec.
corner marked $\frac{1}{4}$ on W face
from which
a fir 24 in diam beav N 35°
E 42 deg dirt marked $\frac{1}{4}$ S.B.T.
- A pine 8 in diam beav N 65°
W 26 deg dirt marked $\frac{1}{4}$ S.B.T.
- 80.00 Set post 4 ft long 4 in square
24 in in ground for corner to
25 + 36 marked T. 3 S R 33 E
on W. S 36 on S and S 25
on N. face with 5 notches
on N and 1 notch on S
edge from which

3

Entering of T. 3 South R. 33 Oct 1913

Willamette Meridian, Oregon.

A pine 8 in diam bearing N 35°
E 26 ch^d dist marked T. 3 S.
R. 34 E S. B.T.

A pine 9 in diam bearing N 57° W
48 ch^d dist marked T. 3 S.R.
33 E S 25 B.T.

A pine 9 in diam bearing S 66°
N 5 ch^d dist marked T. 3 S.
R. 33 E S 36 B.T.

A Tamarack 4 in diam bearing
S 49° E 35 ch^d dist marked
T. 3 S R. 34 E B.T.

Land hilly and broken
Soil 2d and 3d ratio
Heavily timbered with pine
fir, tamarack
Dense pine & fir undergrowth

Entering of T. 3 South R. 33 East
194 Willamette Meridian, Oregon.

North on East boundary
of Sec. 25.

Var 21° E

- 10.00 Descend hill bear E & W.
23.75 Ravine course E 400 ft deep.
Ascend
38.50 Small Ravine course S.E.
40.00 Set basalt stone 19 x 12 x 5
in 12 in in ground for
 $\frac{1}{4}$ See corner marked $\frac{1}{4}$ on
W face
from which
A fir 24 in drain bear S 82°
E 55° lk dirt marked $\frac{1}{4}$ S.B.T.
A pine 30 in drain bear N 74°
W 29 lk dirt marked $\frac{1}{4}$ S.B.T.
425 ft above first Ravine
46.00 Top of hill bear N E & SW
150 ft above $\frac{1}{4}$ See corner
80.00 Set post 4 ft long 4 in
square 24 in in the ground
for corner to Secs. 24 & 25

15

Interior of T. 3 South R. 33 East 195

Willamette Meridian, Oregon.

marked T. 3 S R 33 E on N
S. 24 on N and S. 25 on S.
facey with 4 notches on N
and 2 notches on S. facey
from which

a pine 4 in diam bears N 33° E
32 lby dirt marked T. 3 S.R.
34 E B.T.

a fir 34 in diam bears N 33°
W 34 lby dirt marked T. 3 S.R.
33 E S 24 B.T.

a fir 32 in diam bears S. 18°
W 8 lby dirt marked T. 3 S.R.
33 E S 25 B.T.

a fir 24 in diam bears S 55° E
8 lby dirt marked T. 3 S.R.
34 E B.T.

Land mountainous
Soil 2 d + 3 d ratio
Heavily timbered with
pine fir & tamarack

Postering of T. 3 South R. 33 East
Willamette Meridian, Oregon.

North on East boundary
of Sec. 24

Var 19° 30' E

8.00 Descend hill bearing E & W
36.00 Enter bottom bearing E & W
400 ft below corner
40.00 Set post 3 ft long 3 in square
24 in in ground for $\frac{1}{4}$ sec
corner marked $\frac{1}{4}$ S on W face
from which

a pine 10 in diam bearing N
63° E 13 chd dist marked
 $\frac{1}{4}$ S.B.T.

a pine 9 in diam bearing S 87°
W 86 chd dist marked $\frac{1}{4}$ S.B.T.

4075 Creek 20 ch wide runs E

4430 Corral bearing E & W

4600 Leave Corral & ascend hill
bearing E & W

5840 Spring branch 2 ch wide
runs S.W.

8000 Set basalt stone 16 x 12 x 7 in
12 in in ground for corner

7

Onterior 197
of T. 3 South R. 33 East
Willamette Meridian, Oregon.

to Sess 13 & 24 marked
with 3 notches on N & S.
edger from which
a pine 5 in diam being N 19°
E 118 ly dist marked T. 3 S.
R 34 E B.T.

A pine 8 in diam being N 21°
W 99 ly dist marked T. 3 S.
R 33 E S 13 B.T.

a pine 24 in diam being S
22° W 68 ly dist marked
T. 3 S R 33 E S 24 B.T.

A pine 34 in diam being S 13°
E 35 ly dist marked T. 3
S R. 34 E B.T.

300 ft above 1/4 Sec corner

Land mountainous

Soil 1st & 2d rate

Heavily timbered with
pine fir & tamarack

Dense pine & fir undergrowth

Outlines of T. 3 South. R. 33 East

Willamette Meridian, Oregon.

North on East boundary
of Sec. 13

Var 23° 30' East

1625 Spring branch 2 lkgs with
run S. 25° E

4000 Set basalt stone 18x12x12
in 12 in ground for $\frac{1}{4}$
Sec corner marked $\frac{1}{4}$ on W.
face from which
a pine 14 in draw being
N 57° E 118 lkgs dirt marked
 $\frac{1}{4}$ S.B.T.

A pine 12 in draw being
N 23° W 41 lkgs dirt marked
 $\frac{1}{4}$ S.B.T. 700 ft above Sec. con.

4400 Top of hill being E & W

8000 Set post 4 ft long 4 in
square 24 in ground for
corner to Secs 12 & 13 marked
T. 3 S. R. 33 E on W. S 12
on N and S. 13 on S face
with 4 notches on S and

9
199

Entering of T. 3 South R. 33 East

Willamette Meridian, Oregon.

2. on N face
from which
a pine 6 in diam being N
52° E 20 ft dist marked
T. 3 S R 34 E B.T.

A pine 5 in diam being N
57° W 14 ft dist marked
T. 3 S R 33 E S. 12 B.T.

A pine 12 in diam being S 26°
W 36 ft dist marked T. 3 S
R 33 E S 13 B.T.

A pine 5 in diam being S 47°
E 16 ft dist marked T. 3 S
R 34 E B.T.

Land mountainous
Soil 2d & 3d rate

Heavily timbered with pine
fir & tamarack
Dense pine & fir
undergrowth

200
Entering

T. 3 South R. 33 East

Willamette Meridian, Oregon.

North on East boundary
of Sec 12

Var 19° 30' East

- 34.40 Old road bearing E & W
- 4000 Set post 3 ft long 3 in square
24 in in ground for $\frac{1}{4}$ sec corner marked $\frac{1}{4}$ S on W.
face; from which
a fir 14 in diam bearing S 82°
E 45° ely dirt marked $\frac{1}{4}$ S.B.T.
a pine 9 in diam bearing S 67°
W 18° ely dirt marked $\frac{1}{4}$ S.B.T.
- 8000 Set post 4 ft long 4 in
square 24 in in ground
for corner to Secs 1 and 12
marked T. 3 S R 33 E on W
S 1 on N and S. 12 on S.
face with 5 notes on S.
and 1 note on N
face; from which
a pine 6 in diam bearing
N 38° E 33° ely dirt marked

201

Interior of T. 3 South. 33 East

Willamette Meridian, Oregon.

T 3 S R 34 E B.T.

A few 28 in. diam. being
N 58° W 74 ly dist marked

T. 3 S. R. 33 E S 1 B.T.

A few 24 in. diam. being S 52°
W 29 ly dist marked T. 3 S.

R 33 E S 12 B.T.

A few 20 in. diam. being S 64°
E 19 ly dist marked T. 3 S

R 34 E B.T.

Low rolling table land

Soil 2 drato

Heavily timbered with
pine fir & tanasawh

Dense pine and fir
undergrowth

~~800~~ ~~800~~
Parties of T. 3 South R. 33 East

Willamette Meridian, Oregon.

North on East boundary
of Secs 1.

Vari 21° East

- 1330 Old road bearing N W & S E.
 4000 Set post 3 ft. long 3 in square
 24 in in ground for $\frac{1}{4}$ Sec
 corner marked $\frac{1}{4}$ S on W
 face; from which
 a pine 8 in diam bearing N 84°
 & 15 ly dirt marked $\frac{1}{4}$ S.B.T.
 a tamarack 15 in diam bearing
 N 47° W 23 ly dirt marked
 $\frac{1}{4}$ S.B.T.
 8000 Set post 5 ft long 4 in
 square 24 in in ground
 for corner to townships
 2 and 3 South Range 33
 East marked
 R 33 E on W
 T. 2 S S 36 on N. and
 T. 3 S S 1 on S face
 with 6 rods on N & S.

103

Interior of T. 3 South R. 33 East
Willamette Meridian, Oregon.

and W faces from which
A tamarack 6 in diam bears
N 27° E 42 ly dist marked
T. 2 S. R. 34 E B.T.
a fir 15 in diam bears N 23°
W 44 ly dist marked T. 2
S. R. 33 E S 36 B.T.
a fir 9 in diam bears S 28°
W 25 ly dist marked T. 3
S. R. 33 E S 1 B.T.
a pine 11 in diam bears S 45°
E 63 ly dist marked T. 3 S
R. 34 E B.T.

Land high & mountainous
Soil 2d rate

Heavily timbered with
pine fir and tamarack
Dense pine & fir undergrowth

November 6th 1882

FINAL OATHS FOR SURVEYS.

A list of the names of the individuals employed by

Rufus S. Moore, U. S. Deputy Surveyor, to assist in running, measuring and marking the lines and corners described in the foregoing field notes of the survey of the *Exterior lines of Township's 3, 4 & 5 South Range 33 $\frac{1}{2}$ East, and Township 3 South Range 33 E.* Willamette Meridian, Oregon, showing the respective capacities in which they acted :

, Compassman.

James Guttridge, Chainman.

John Guttridge, Chainman.

, Chainman.

, Chainman.

Joe Parodi, Axeman.

, Axeman.

, Flagman.

FINAL OATHS OF ASSISTANTS

We hereby certify that we assisted

Rufus S. Moore

, U. S. Deputy Surveyor, in surveying all

those parts or portions of the *Exterior lines of Township 3, 4 & 5 South Range 33 $\frac{1}{2}$ East and Township 3 South Range 33 E.*

Willamette Meridian, Oregon, as are represented in the foregoing field notes as having been surveyed by him and under his direction ; and that said survey has been in all respects, to the best of our knowledge and belief, well and faithfully surveyed, and the corner monuments established, according to the instructions furnished by the U. S. Surveyor General of Oregon.

, Compassman.

James Guttridge, Chainman.

John Guttridge, Chainman.

, Chainman.

, Chainman.

Joe Parodi

, Axeman.

, Axeman.

, Flagman.

Subscribed and sworn to before me, this *Twenty First* day of *November* 1882.

[SEAL.]

Rufus S. Moore

Notary Public

FINAL OATH OF DEPUTY SURVEYOR.

I, Rufus D. Moore

United States Deputy Surveyor, do solemnly swear that in pursuance of instructions received from

U. S. Surveyor General for Oregon, bearing date of the

day of June, 1882, I have well, faithfully and truly, in my own proper person, and in strict conformity with the instructions furnished by the U. S. Surveyor General for Oregon, the Surveying Manual, and the laws of the United States, surveying all those

parts or portions of Exterior lines of Towns, 3, 4, & 5
S. Range 34 E. and T. 3 S. R. 33 East of

Willamette Meridian, in the State of Oregon, as are represented in the foregoing Field Notes as having been surveyed by me and under my directions;
and I do further solemnly swear that all the corners of said survey have been established and perpetuated in strict accordance with the Surveying Manual, printed instructions, the special written instructions of the U. S. Surveyor General for Oregon, and in the specific manner described in the field notes, and that the foregoing are the *true* field notes of such survey, and should any fraud be detected I will suffer the penalty of perjury under the provisions of an Act of Congress approved August 8, 1846.

Rufus D. Moore

U. S. Deputy Surveyor.

Subscribed and sworn to before me, this

10th

day of

February

1883

Barnford Robb,
Notary Public

222

Office U. S. Surveyor General,

Portland, Oregon, June 5, 1883.

The following Field Notes of the Survey of the
Exteriors of Twp. 3, 4, & 5 S. R. 34 E.
and Twp. 3 S. R. 33 E., Well.

Mer, Oregon

executed by Rufus S. Moore

under his Contract No. 451, dated June
12th, 1882, having been critically examined, the

necessary corrections and explanations made, the said field notes
and the survey they describe, are hereby approved.

James C. Tolman
Surveyor General.