

Bk 280

# FIELD NOTES

Of the survey of the Estevan

Lines of Townships 3.4+5 S. Rg 38 1/2 T 34 E.

Town 3 S. R. 33 E of, Willamette Meridian,  
and part of 1st Standard Parallel South  
Oregon, as surveyed by Rufus S. Snow

U. S. Deputy Surveyor, under his Contract No. 451

dated June 28 ~~28~~ 12th, 1882

Survey commenced, October 12th, 1882

Survey completed, November 11th, 1882

## NAMES AND DUTIES OF ASSISTANTS.

Rufus Snow, Compassman.

James Cuttidge, Chainman.

John Cuttidge, Chainman.


\_\_\_\_\_, Chainman.

\_\_\_\_\_, Chainman.

Joe Proodi, Axeman.

\_\_\_\_\_, Axeman.

\_\_\_\_\_, Flagman.

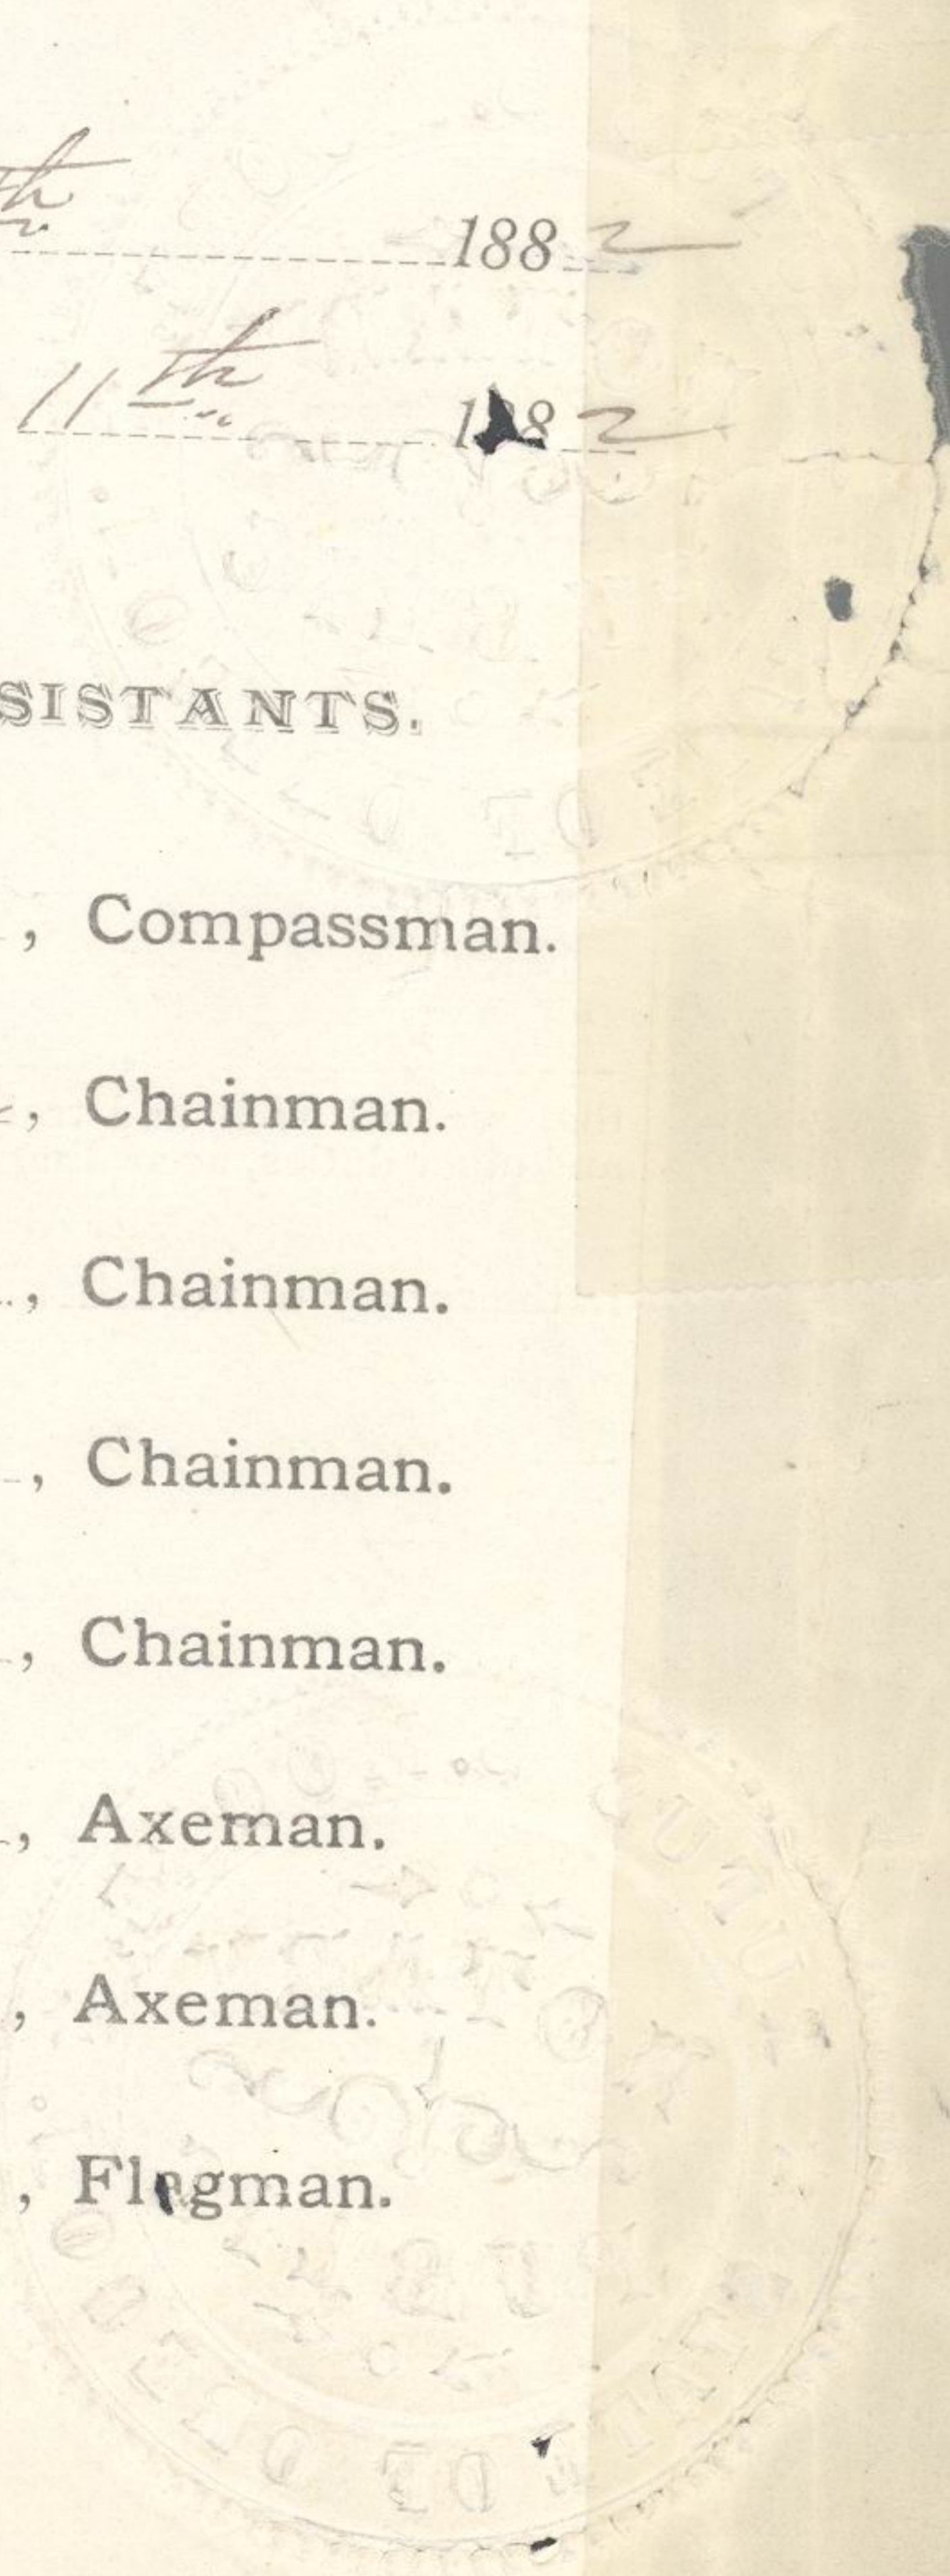



184

# PRELIMINARY OATHS OF ASSISTANTS:

We, James Guttridge and  
John Guttridge

do solemnly swear that we will faithfully execute the duties of Chain Carriers, that we will level the chain over even and uneven ground, and plumb the tally pins, either by sticking or dropping the same; that we will report the true distance to all notable objects, and the true length of all lines that we will assist in measuring, to the best of our skill and ability, and in accordance with the instructions given us in

the survey of the Exterior lines of Townships 3.4 + 5 South

R. 33 1/2 E + R. 34 E and T. 3. S R 33 E and part of 1<sup>st</sup> Standard  
Parallel S. through R. 34. E Willamette Meridian, Oregon.

James Guttridge, Chainman.

John Guttridge, Chainman.

\_\_\_\_\_, Chainman.

\_\_\_\_\_, Chainman.

Subscribed and sworn to before me, this Fifteenth

day of August 1882

[SEAL.]

Rufus S. Moore

Notary Public

Joe Parodi

and

\_\_\_\_\_, do solemnly swear that we will well and truly perform the duties of Axemen in the establishment of corners and other duties, according to instructions given us, and to the best of our skill and ability,

in the survey of the Exterior of Twp 3.4 + 5 S. Rg 34 E + 38 R 33 E +  
Ts 3.4 + 5 S R 33 1/2 E  
part of 1<sup>st</sup> Stand-par. through R 34 E Willamette Meridian, Oregon.

Joe Parodi, Axeman.

\_\_\_\_\_, Axeman.

Subscribed and sworn to before me, this Fifteenth

day of August 1882

[SEAL.]


Rufus S. Moore

Notary Public



Inches  
referring the lines to page  
in field notes

Diagram of T. 3 South R. 33 East

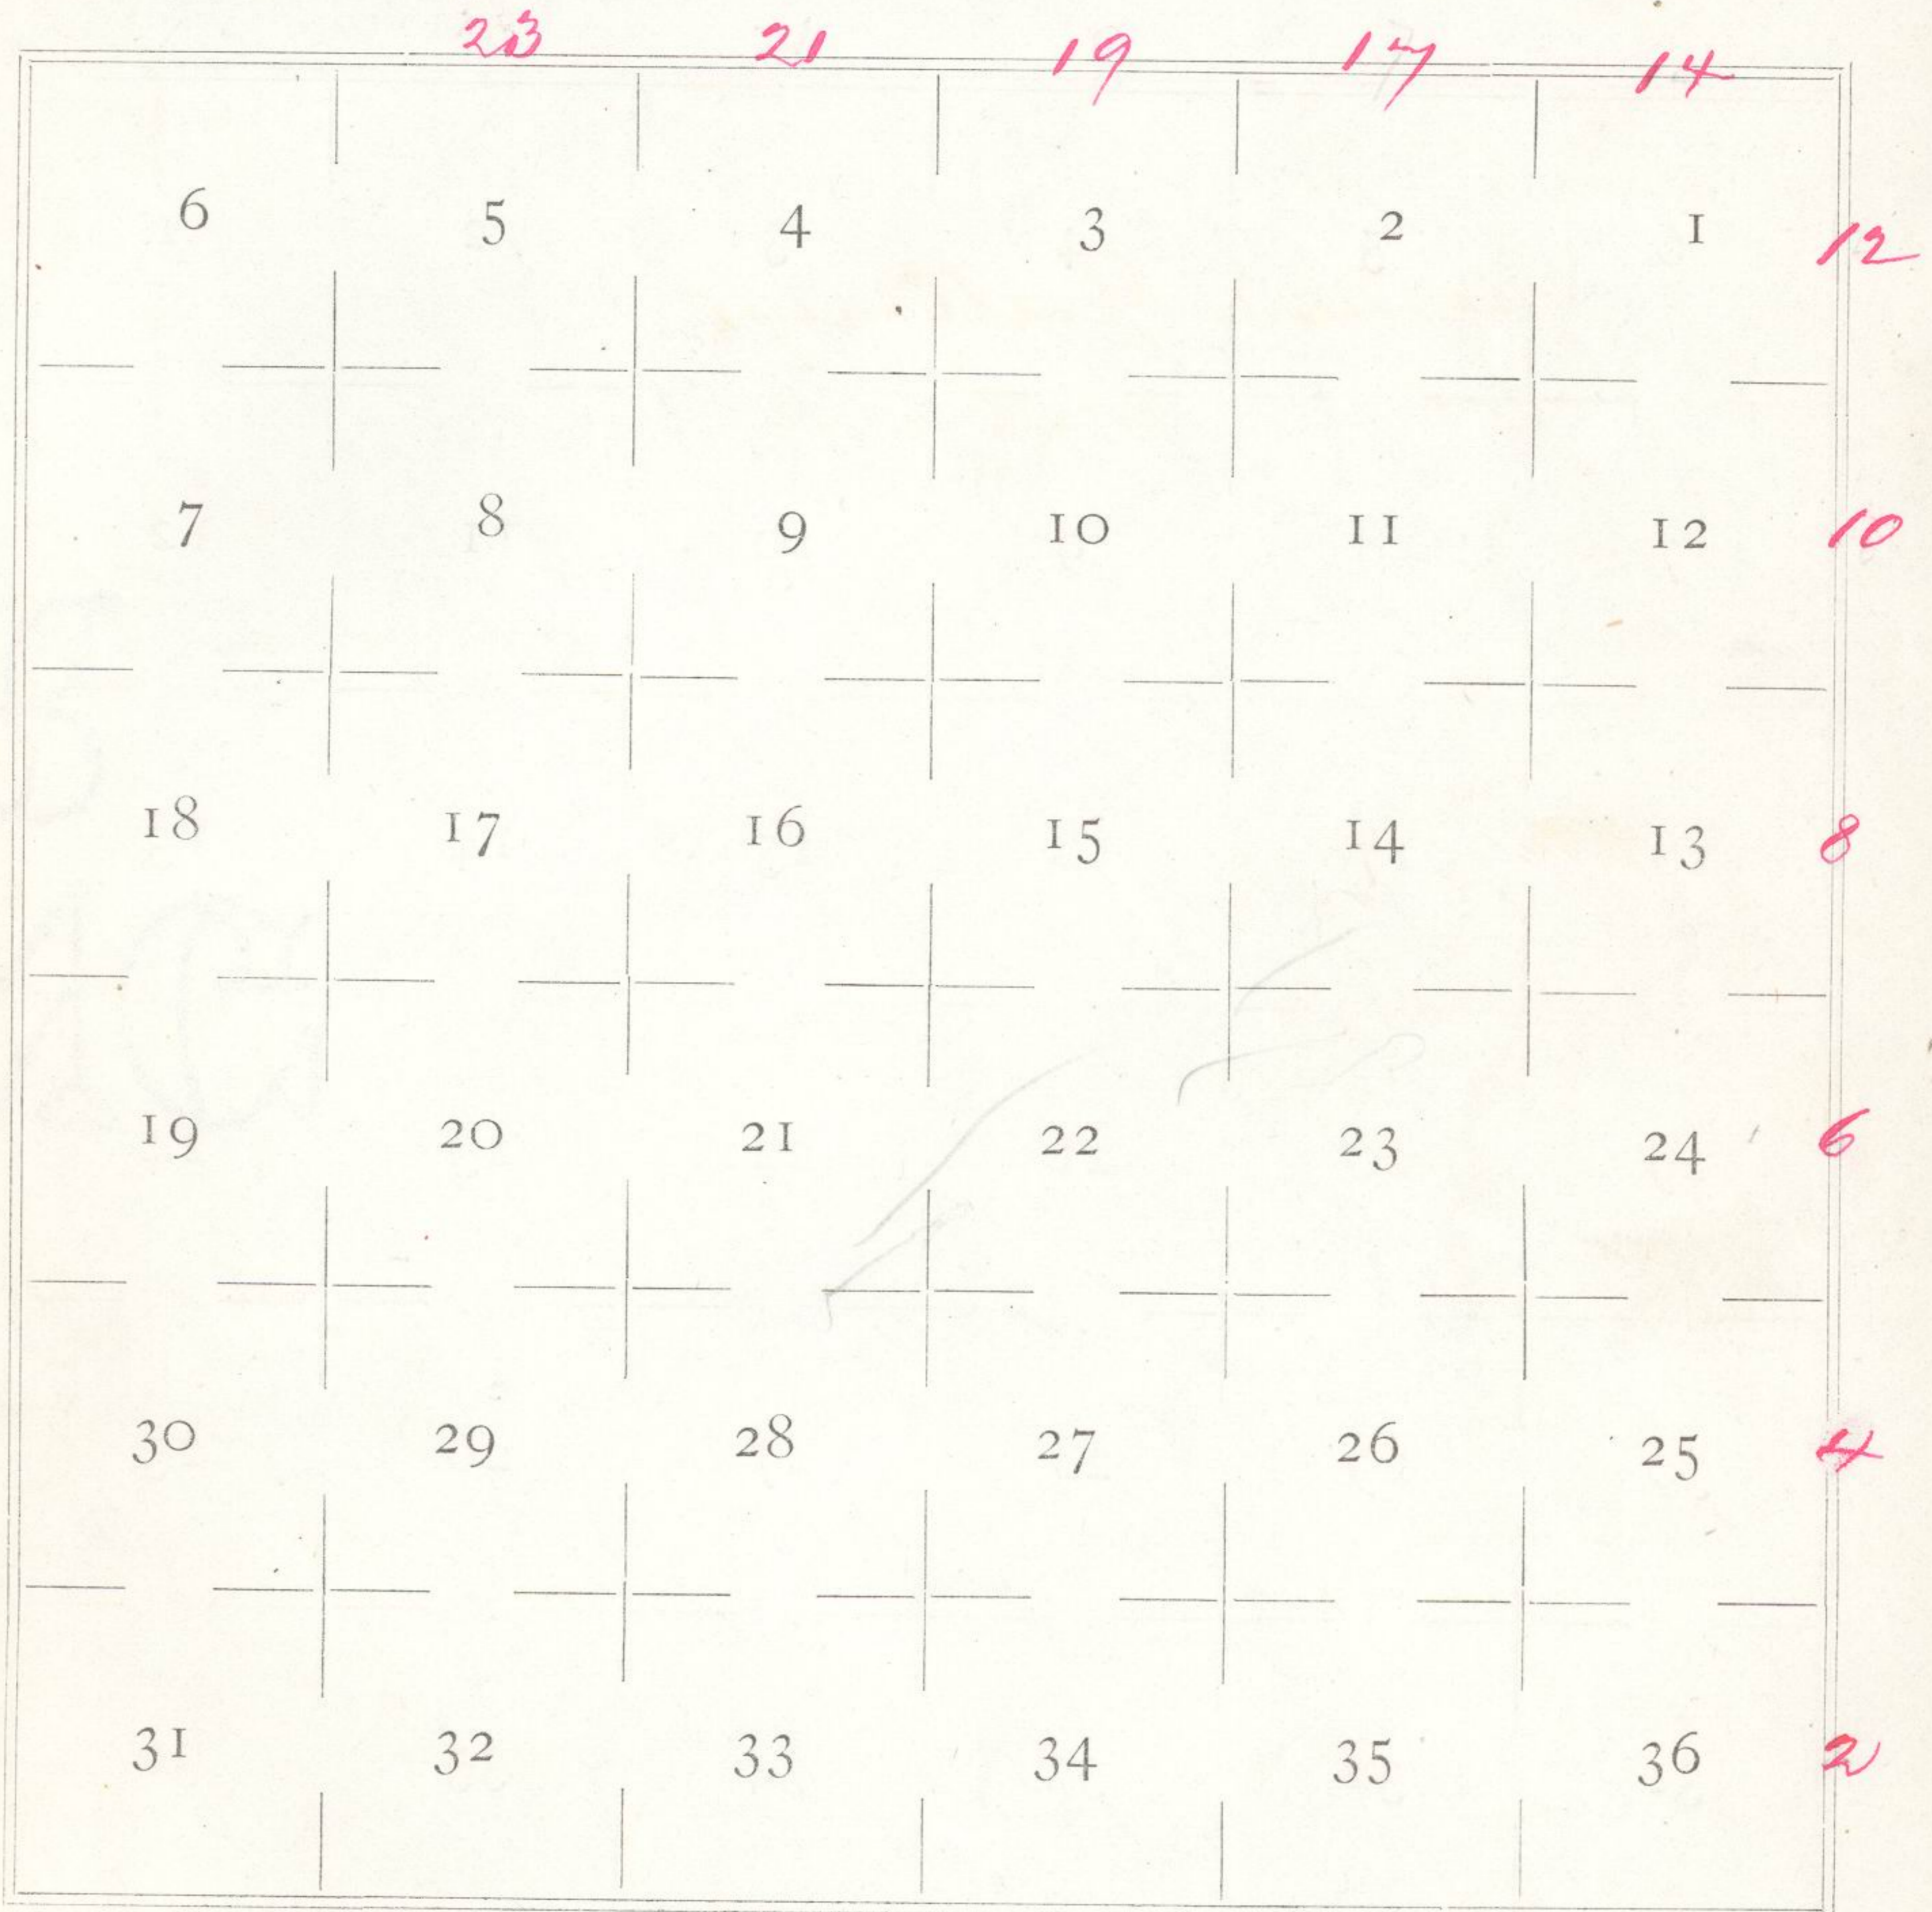



191

Interior of T. 3 South R. 33 East

Willamette Meridian, Oregon.

From the corner to Township  
3 and 4 South Range 33 East  
which is a basalt stone  
18 x 12 x 5 ins marked with  
6 notches on each edge  
from which  
A pine 6 in diam bears N 38°  
E 80 lb dirt marked T 3 S  
R 34 E S 30 B.T. 31

A pine 16 in diam bears S 58°  
E 48 lb dirt marked T 3 S R.  
34 E S 31 B.T.

As I destroyed mark refer-  
ring to Sec 31 and T. 4 S.

A pine 15 in diam bears  
S 50° W 13 lb dirt marked  
T. 4 S R 33 E S 1 B.T.

A pine 12 in diam bears  
N 74° W 23 lb dirt marked  
T. 3 S R. 33 E S 36 B.T.

I run



# FINAL OATHS FOR SURVEYS.

A list of the names of the individuals employed by \_\_\_\_\_  
 *Rufus S. Moore* , U. S. Deputy Surveyor, to assist in  
 running, measuring and marking the lines and corners described in the foregoing field  
 notes of the survey of the  *Exterior lines of Township's*   
 *3, 4 & 5 South Range <sup>33 1/2</sup> 34 East, and*   
 *Twp. 3 South Range <sup>33</sup> 33 E.*  Willamette Meridian, Oregon,  
 showing the respective capacities in which they acted :

- \_\_\_\_\_, Compassman.
- James Guttridge* , Chainman.
- John Guttridge* , Chainman.
- \_\_\_\_\_, Chainman.
- \_\_\_\_\_, Chainman.
- Joe Parodi* , Axeman.
- \_\_\_\_\_, Axeman.
- \_\_\_\_\_, Flagman.

## FINAL OATHS OF ASSISTANTS

We hereby certify that we assisted  *Rufus S. Moore*   
 \_\_\_\_\_, U. S. Deputy Surveyor, in surveying all  
 those parts or portions of the  *Exterior lines of Township's*   
 *3, 4 & 5 South Range <sup>33 1/2</sup> 34 of East and Twp.*   
 *3 South Range <sup>33</sup> 33 East*  Willamette Meridian, Oregon,  
 as are represented in the foregoing field notes as having been surveyed by him and under  
 his direction; and that said survey has been in all respects, to the best of our knowledge  
 and belief, well and faithfully surveyed, and the corner monuments established, according  
 to the instructions furnished by the U. S. Surveyor General of Oregon.

- \_\_\_\_\_, Compassman.
- James Guttridge* , Chainman.
- John Guttridge* , Chainman.
- \_\_\_\_\_, Chainman.
- \_\_\_\_\_, Chainman.
- Joe Parodi* , Axeman.
- \_\_\_\_\_, Axeman.
- \_\_\_\_\_, Flagman.

Subscribed and sworn to before me, this  *Twenty First*  day of  
 *November*  188 *2*

[SEAL.]

*Rufus S. Moore*   
 Notary Public



## FINAL OATH OF DEPUTY SURVEYOR.

I, Rufus S. Moore

United States Deputy Surveyor, do solemnly swear that in pursuance of in-

structions received from

James C. Tolman

U. S. Surveyor General for Oregon, bearing date of the

Twelfth  
~~Twenty Eighth~~day of June, 1882, I have well, faithfully and truly, in my own proper person, and in strict conformity with the instructions furnished by the U. S. Surveyor General for Oregon, the Surveying Manual, and the laws of the United States, surveying all thoseparts or portions of Exterior line of Twp. 3, 4, & 533 1/2  
S. Range 34 E. and T. 3 S. R. 33 East of  
Willamette Meridian, in the State of Oregon, as are represented in the foregoing Field Notes as having been surveyed by me and under my directions; and I do further solemnly swear that all the corners of said survey have been established and perpetuated in strict accordance with the Surveying Manual, printed instructions, the special written instructions of the U. S. Surveyor General for Oregon, and in the specific manner described in the field notes, and that the foregoing are the true field notes of such survey, and should any fraud be detected I will suffer the penalty of perjury under the provisions of an Act of Congress approved August 8, 1846.Rufus S. Moore

U. S. Deputy Surveyor.

Subscribed and sworn to before me, this

10th

day of

February1883Benford Robb  
Notary Public



222

**Office U. S. Surveyor General,**

Portland, Oregon, *June 5,* 188*3*

The following Field Notes of the Survey of the

~~Extremities of Twp. 3, 4, & 5 S. R. 34 E.~~  
~~and Twp. 3 S. R. 33 E., Will.~~

*Mer., Oregon*

executed by *Refus S. Moore*

under his Contract No. *451*, dated *June*

*12<sup>th</sup>*, 188*2*, having been critically examined, the

necessary corrections and explanations made, the said field notes

and the survey they describe, are hereby approved.

*James C. Salzman*

Surveyor General.

