

FIELD NOTES

223

Of the survey of the Subdivisional

Lines of Township 3 South

Range 33 East of, Willamette Meridian,

Oregon, as surveyed by Rufus S. Moore

U. S. Deputy Surveyor, under his Contract No. 451

dated June 28<sup>th</sup>, 1882

Survey commenced, November 22<sup>nd</sup> 1882

Survey completed, November 29<sup>th</sup> 1882

NAMES AND DUTIES OF ASSISTANTS.

....., Compassman.

James Guttridge, Chainman.

John Guttridge, Chainman.


....., Chainman.

....., Chainman.

Joe Parodi, Axeman.

....., Axeman.

....., Flagman.

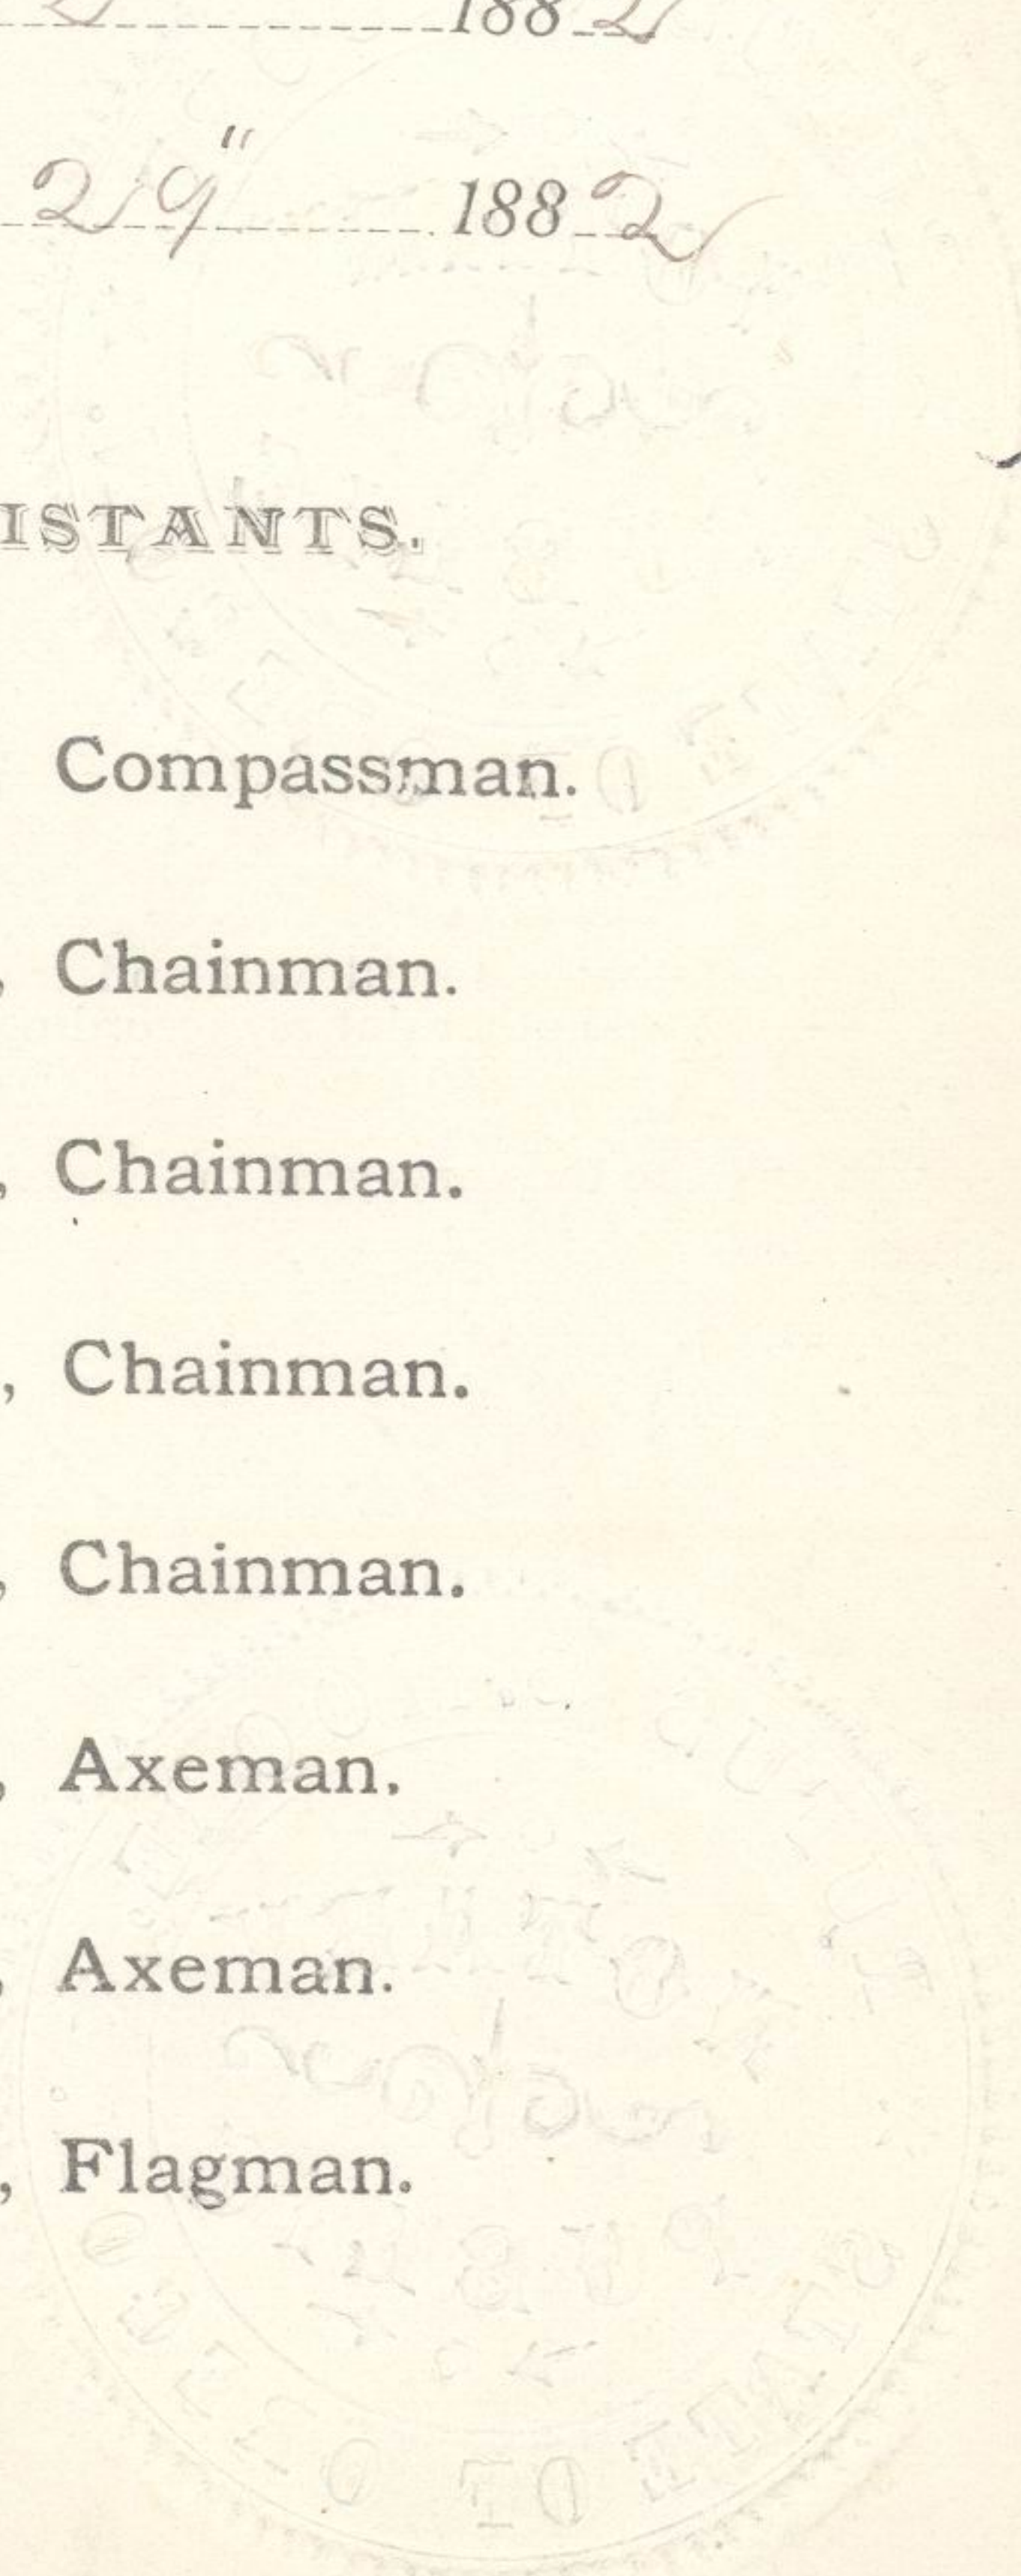

224

# PRELIMINARY OATHS OF ASSISTANTS:

We, James Guttridge and  
John Guttridge

do solemnly swear that we will faithfully execute the duties of Chain Carriers, that we will level the chain over even and uneven ground, and plumb the tally pins, either by sticking or dropping the same; that we will report the true distance to all notable objects, and the true length of all lines that we will assist in measuring, to the best of our skill and ability, and in accordance with the instructions given us in

the survey of the Subdivisional

lines of Township 3 South

Range 33 East of Willamette Meridian, Oregon.

James Guttridge, Chainman.

John Guttridge, Chainman.

, Chainman.

, Chainman.

Subscribed and sworn to before me, this Fifteenth

day of August 1882

[SEAL.]

Rufus S. Moore  
Notary Public

We, \_\_\_\_\_ and \_\_\_\_\_

Joe Parodi, do solemnly swear that we will well and truly perform the duties of Axemen in the establishment of corners and other duties, according to instructions given us, and to the best of our skill and ability,

in the survey of the Subdivisional lines of

Township 3 South R. 33E of Willamette Meridian, Oregon.

Joe Parodi, Axeman.

, Axeman.

Subscribed and sworn to before me, this Fifteenth

day of August 1882

[SEAL.]

Rufus S. Moore  
Notary Public

# INDEX.

Referring the Lines to the Pages of the field Notes.

T. 3 South R. 33 East Will. Mer.

6	97	5	69	4	51	3	33	2	16	1
95		94		68		50		32		15
7	92	8	66	9	48	10	31	11	14	12
90		89		64		47		29		12
18	87	17	62	16	45	15	28	14	10	13
85		84		61		44		26		9
19	82	20	59	21	42	22	24	23	7	24
80		78		58		41		23		5
30	76	29	56	28	39	27	21	26	4	25
75		74		55		38		20		2
31	72	32	53	33	36	34	18	35	0	36

Meanders of \_\_\_\_\_ Pages \_\_\_\_\_ to \_\_\_\_\_

Meanders of \_\_\_\_\_ Pages \_\_\_\_\_ to \_\_\_\_\_

Subdivision of T. 3 South R. 33 East  
Willamette Meridian, Oregon.

West on random line between Sec 30 + 31  
var 211° E.

4000 Set temporary 1/4 Sec corner.

78.25 Intersect West boundary of Township  
18 lbs south of corner to Sec 30, 31  
25 + 36 which is a Basalt Stone  
16 x 10 x 4 ins. with mound of stone  
alongside marked with 1 notch on D and 5 notches  
from which on meager

A pin 15 ins. in dia. bears N 7° E 234 LR.  
dist. marked T 3 D R 33 E D 30 B J

A pin 16 ins. in dia. bears S 16° W 169 LR. dist.  
marked T 3 D R 32 E D 36 B J

A pin 18 ins. in dia. bears N 8° W 241 LR.  
dist. marked T 3 D R 32 E D 25 B J

Hence I run

889° 52' E on true line between Sec 30 + 31

38.25 Set post 3 ft long 3 in square 24 in  
var, 2045' East  
in ground for 1/4 Sec. corner  
marked 1/4 on N face.

Subdivision of T. 3 South R. 33 East

Willamette Meridian, Oregon.

First on random line between Sec 19, 30  
over 20° E.

21.00 Level 6 to wide runs N 20° E.

Ascend along hillside

22.00 Same level runs S 80° E.

Ascend along S. hillside

4000 Set temporary 1/4 Sec. corner  
100 ft above level.

71.60 Ravine corner N.

Ascend,

78.10 Intersect of boundary of  
Township 21 to South of line  
to Sec 24, 25, 19 & 30 which is

a Basalt Stone 16 x 12 x 10 ins. set  
firmly in the ground marked  
with 2 notches on D and 4 notches on  
Wedges. from which

A tamarack 8 ins. in dia. bears N 68° E 46

lks. dist. marked, T 3 R 33 E D 19 B J

A pine 5 ins. in dia. bears S 40° E 26 lks. dist.

marked, T 3 R 33 E D 30 B J

A pine 6 ins. in dia. bears S 42° W 24 lks. dist

marked T 3 R 32 E D 25 B J

Subdivision of T. 3 South R. 33 East  
 Willamette Meridian, Oregon.

A pine 4 ins. in dia. bears  $N45^{\circ}W$  31 R.,  
 dist. marked. T 3 D R 32 E S 24 B T  
 Hence I run

889°57'E on true line between Secs 19 & 20  
 38.10 Set post 3 ft long 3 in. <sup>Var. 19° East</sup> square 24  
 in in ground for 1/4 Sec. corners  
 marked 1/4 S. on N face  
 from which:

A pine 4 in dia bears  $N53^{\circ}E$  12 lb dist  
 marked 1/4 S. B. T.

A pine 4 in dia bears  $S19^{\circ}E$  31 lb dist  
 marked 1/4 S. B. T.

78.10 The loc to Secs 19, 20, 29 + 30.

Low Mountainous

Soil 2<sup>nd</sup> rate

Heavily timbered <sup>with</sup> pines and fir  
 some pines + fir undergrowth.

Subdivision of T. 3 South R. 33 East

Willamette Meridian, Oregon.

Heavily Soil 2<sup>nd</sup> and 3<sup>rd</sup> rates  
 Heavily timbered <sup>with</sup> Fir and Larch  
 Spruce fir and Fir underneath

West on

Historical random line between Sec 18 & 19  
 over 21° E.

600 Descend hill bears N 80° W

17.00 Ravine crosses S. E. 350 ft  
 below Sec. corner and  
 Ascend.

30.00  
 3000 Top of hill bears N 70° E. 350 ft  
 above Ravine.

40.00  
 4000 At temporary 1/4 Sec. corner

40.50  
 4050 Descend hill bears N 70° E.

48.25 Brook 4 lb wide runs S. 20° E.  
 300 ft below 1/4 Sec. corner

Ascend.

6800 Top of hill bears N 70° E.

7600 Old road bears N 70° + S E.

78.20  
 78.20 Intersect West boundary of Township  
 20 lb South of corner to Sec

Subdivision of T. 3 South R. 33 East  
Willamette Meridian, Oregon.

18, 19, 20, 24, which is A  
Basalt Stone 14 x 10 x 8<sup>ins</sup> set firmly in the  
ground marked with 3 notches on W  
edges. from which

A pine 10 ins. in dia. bears S 72° E 43 R, dia  
marked, T 3 D R 33 E D 19 B J

A pine 10 ins. in dia. bears N 38° E 60 R, dia  
marked, T 3 D R 33 E D 18 B J

A pine 6 ins. in dia. bears S 28° W 45 R, dia  
marked, T 3 D R 32 E D 24 B J

A pine 6 ins. in dia. bears N 45° W 31 R, dia  
marked, T 3 D R 32 E D 13 B J

Thence I run

S 89° 51' E on true line between Sec 18 & 19

38, 20 Set Basalt Stone 16 x 10 x 6<sup>ins</sup> 12<sup>ins</sup> in  
ground for "4 Sec. corner"  
marked "4 on N face.

from which;

A pine 15 in dia. bears S 20° W 40 R, dia

marked "4 S. B. L.

A pine 15 in dia. bears N 70° W 53 R, dia

marked "4 S. B. L.



Subdivision of T. 3 South R. 33 East

Willamette Meridian, Oregon.

78.00

Interest West boundary of Township  
at corner to Sec 7, 18, 12 & 13.

which is A Basalt Stone, 14 x 8 x 7 ins.

Set firmly in the ground marked with  
4 notches on S. and 2 notches on N. edge.

A pin 10 ins. in dia. bears <sup>from which</sup> N 28° E 39 lks. dist.  
marked. T 3 S R 33 E D 7 B J

A pin 12 ins. in dia. bears S 66° E 52 lks. dist.  
marked T 3 S R 33 E D 18 B J

A pin 8 ins. in dia. bears S 55° W 129 lks. dist.  
marked. T 3 S R 32 E D 13 B J

A pin 6 ins. in dia. bears N 34° W 94 lks. dist.  
marked. T 3 S R 32 E D 12 B J

Three more

East on true line between Sec 7 & 18,

38.00

Set Basalt Stone 12 x 8 x 6 <sup>ins</sup> 8 in

in ground for 1/4 Sec. corners  
marked 1/4 on N face.

From which;

A 4 in diam bears N 60° E 68 lks. dist.  
marked 1/4 S. B. J.

A 15 in diam bears S 54° E 39 lks. dist.

Subdivision of T. 3 South R. 33 East

Willamette Meridian, Oregon.

39.50

Road bears N. & S.

40.00

Set temporary 1/4 Sec. corner

69.00

Small Ravine corner NW

78.00

Intersect West boundary of the Township 35 lks South of the Corner to Secs 6, 7, 1 & 12 which is a Basalt Stone 20 x 18 x 4<sup>ins</sup> marked with 5 notches on S and 1 on N edges with mound of stone alongside.

From which:

A line 22 mi down bears S 78° E 70 lks dist marked T. 3, S. R. 33, E. S. 4, B. T.

A line 10 mi down bears S 50° W 132 lks dist marked T. 3, S. R. 32 E. S. 12 B. T.

A line 10 mi down bears N 76° W 121 lks dist marked T. 3, S. R. 32 E. S. 1 B. T.

Thence I run

S 89° 49' E on true line between Secs 6 & 7 with same bar

38.00

Set post 3ft long 3mi square 24 mi in ground for 1/4 Sec corner marked 1/4 Sec NW corner

From which

# FINAL OATHS FOR SURVEYS.

A list of the names of the individuals employed by \_\_\_\_\_

Rufus S. Moore, U. S. Deputy Surveyor, to assist in running, measuring and marking the lines and corners described in the foregoing field notes of the survey of the Subdivisional

lines of Township 3 South  
Range 33 East of Willamette Meridian, Oregon, showing the respective capacities in which they acted :

- \_\_\_\_\_, Compassman.
- James Guttridge, Chainman.
- John Guttridge, Chainman.
- \_\_\_\_\_, Chainman.
- \_\_\_\_\_, Chainman.
- Joe Parodi, Axeman.
- \_\_\_\_\_, Axeman.
- \_\_\_\_\_, Flagman.

## FINAL OATHS OF ASSISTANTS.

We hereby certify that we assisted Rufus S. Moore

\_\_\_\_\_, U. S. Deputy Surveyor, in surveying all those parts or portions of the Subdivisional

lines of Township 3 South  
Range 33 East of Willamette Meridian, Oregon, as are represented in the foregoing field notes as having been surveyed by him and under his direction ; and that said survey has been in all respects, to the best of our knowledge and belief, well and faithfully surveyed, and the corner monuments established, according to the instructions furnished by the U. S. Surveyor General of Oregon.

- \_\_\_\_\_, Compassman.
- James Guttridge, Chainman.
- John Guttridge, Chainman.
- \_\_\_\_\_, Chainman.
- \_\_\_\_\_, Chainman.
- Joe Parodi, Axeman.
- \_\_\_\_\_, Axeman.
- \_\_\_\_\_, Flagman.

Subscribed and sworn to before me, this Thirtieth day of November 1882

[SEAL.]

Rufus S. Moore  
Notary Public

## FINAL OATH OF DEPUTY SURVEYOR.

I, Rufus S. Moore  
 United States Deputy Surveyor, do solemnly swear that in pursuance of in-  
 structions received from James B. Tolman  
 U. S. Surveyor General for Oregon, bearing date of the Twelfth  
 day of June, 1882, I have well, faith-  
 fully and truly, in my own proper person, and in strict conformity with  
 the instructions furnished by the U. S. Surveyor General for Oregon, the  
 Surveying Manual, and the laws of the United States, surveying all those  
 parts or portions of The Subdivisions at lines  
of Township 3 South - Range 33 East of  
 Willamette Meridian, in the State of Oregon, as are represented in the fore-  
 going Field Notes as having been surveyed by me and under my directions;  
 and I do further solemnly swear that all the corners of said survey have been  
 established and perpetuated in strict accordance with the Surveying Manual,  
 printed instructions, the special written instructions of the U. S. Surveyor  
 General for Oregon, and in the specific manner described in the field notes,  
 and that the foregoing are the *true* field notes of such survey, and should  
 any fraud be detected I will suffer the penalty of perjury under the pro-  
 visions of an Act of Congress approved August 8, 1846.

Rufus S. Moore  
 U. S. Deputy Surveyor.

Subscribed and sworn to before me, this 10<sup>th</sup>  
 day of February 1883

Bamford Robb  
 Notary Public

334

**Office U. S. Surveyor General,**

Portland, Oregon, *June 5* 188*3*

The following Field Notes of the Survey of the

*Subdivisional lines of*  
*T. 3 S. R. 33 E.*

*Will. Mer. Or.*

executed by

*Rufus S. Moore*

under his Contract No. *451*, dated

*June*  
*12<sup>th</sup>* 188*2*, having been critically examined, the

necessary corrections and explanations made, the said field notes

and the survey they describe, are hereby approved.

*James C. Tolman*

Surveyor General.

