


Field notes of the survey of the  
exterior boundaries of Township  
N<sup>o</sup> 4 North of Range N<sup>o</sup> 29 East  
of the Willamette Meridian in the  
State of Oregon, by Wm. J. Campbell  
deputy surveyor, under his con-  
tract N<sup>o</sup> 93, bearing date the  
19<sup>th</sup> day of September 1860

Commenced Oct. 15<sup>th</sup> 1860  
Finished October 17<sup>th</sup> 1860

Index Diagrams

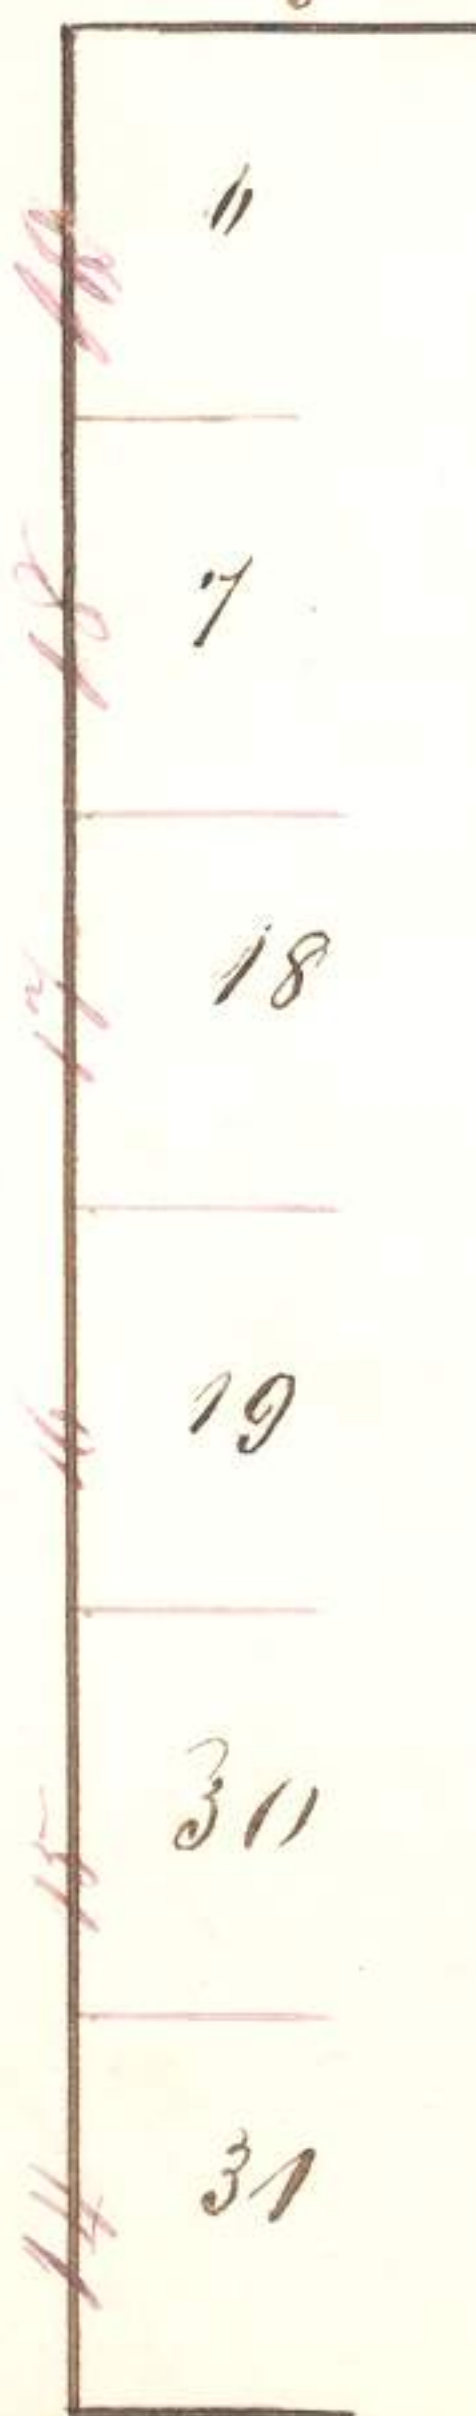

Township 4 Range 29<sup>th</sup> T. 11th Meridian  
Chs.

North, Between Sec 7 & 12,

Variation 20° 20' E.

18.00 by iron nail gentle descent

40.00 Set a post for quarter sec. corner

draw char'd stake raised mound with  
trench & pits as per instructions.

62.00 1/2 foot of descent, + 150

81.00 Set a post for corner to sec. 11. 1. 10

7 & 12. draw a char'd stake  
raised mound, with trench  
& pits, as per instructions. Soil

Sand & brick prairie Soil 2<sup>nd</sup> & 3<sup>rd</sup> rate

North, Between Sec 1 & 6

Variation 20° E

40.00 Set a post for quarter sec corner

in mound of earth with trench, pits  
as per instructions.

83.45 Intersect 1<sup>st</sup> Standard Parallel N.

1/3. 811 chains West of Standard corner

Draw char'd stake raised mound of earth  
(for closing cor. to Group 4 N. Rgs 27 & 28 East)  
with trench & pits as per instructions. Soil Sage  
plain. Soil 3<sup>rd</sup> rate

190

## List of names.

A list of the names of the individuals employed to assist in running, measuring, or marking the lines and corners described in the foregoing field notes of <sup>the Survey of</sup> Township No. 4 North of the Base Line of Range No. 29 East of the Willamette Meridian, showing the <sup>respective</sup> capacities in which they acted;

Samuel Campbell chairman  
Josephus Tompkins chairman  
Robert Farfield Assessor

We hereby certify that we assisted  
S. B. Campbell deputy surveyor  
in surveying the exterior ~~line~~  
~~lines~~ of Township number  
four North of the base line of Ranges  
number twenty nine and thirty  
East of the Willamette Meridian,

and that said Townships lines  
 have been in all respects to the  
 best of our knowledge and belief  
 well and faithfully surveyed,  
 and the boundary monuments  
 planted according to the  
 instructions furnished by the  
 Surveyor General,  
 Samuel L. Campbell chairman  
 Josephus Tompkins chairman  
 Robert F. Caufield Assessor

Subscribed and sworn to  
 before me this 3<sup>rd</sup> day of Decr  
 AD 1860, <sup>at Oregon city</sup> J. C. Dawson  
 Clerk of the Circuit  
 Court for the County  
 of Clackamas State  
 of Oregon

192

I, Wm. D. Campbell, deputy surveyor

do solemnly swear that, in pursuance  
of a contract with J. W. Chapman.

Surveyor of the public lands of the  
United States, in ~~the~~ ~~state~~ of Oregon,  
bearing date the 19<sup>th</sup> day of September  
1860, and in strict conformity to the  
laws of the United States, and the  
instructions furnished by the said  
Surveyor General, I have faithfully  
surveyed, the exterior boundaries of  
Townships number four North  
of the base of Range number twenty-  
nine and thirty East of the Willam-  
ette Meridian, in the State afore-  
said, and do further solemnly  
swear that the foregoing are  
the true and original field  
notes of such surveys.

Wm. D. Campbell

Deputy Surveyor

Subscribed and sworn  
to before me at Oregon

City this 3<sup>rd</sup> day of December  
AD 1860

Geo. W. W. W. W.  
Clerk of the Circuit  
~~Court~~ for Blackham  
County State of Oregon

194

Surveyor General's Office,  
Eugene City, Jan'y 29<sup>th</sup> 1860.  
The foregoing field notes of  
the Survey of the Exterior Line  
of Townships No. 4 North of  
Ranges No. 29 & 30 East of  
the Willamette Meridian; ex-  
ecuted by Wm. B. Campbell,  
deputy Surveyor, under his con-  
tract of the 19<sup>th</sup> day of Septem-  
ber 1860 - having been critically  
examined, the necessary cor-  
rections and explanations  
made, the said field notes  
and the surveys they describe  
are hereby approved.

A. N. Chapman  
Sur: Genl. of Oregon