3818

UNITED STATES RECLAMATION SERVICE
UMATILLA PROJECT OREGON
TOWNSHIP 4 NORTH, RANGE 28 EAST, WILLAMETTE MER.

AMENDED FARM UNIT PLAT ACCOMPANYING FIELD NOTES
OF RESUBDIVISION OF FARM UNITS ALONG THE OREGON R.R.
AND NAVIGATION CO'S TRACK THRU THE S½ SECTION 3.
SURVEYED MARCH 1909 BY W. ROY SAXTON, ASS'T ENGINEER U.S.R.S.
UNDER AUTHORITY OF DEPARTMENTAL INSTRUCTIONS OF OCT. 24 1906.

7 different plats 7/28/14

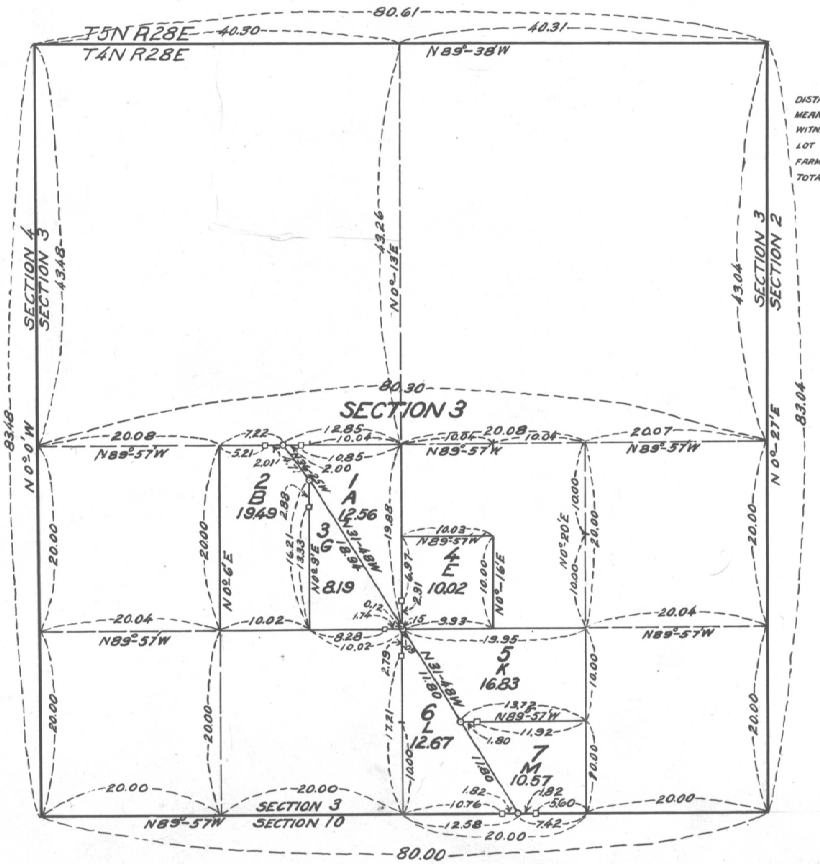

EXPLANATION

DISTANCES ARE SHOWN IN CHAINS
MEANDER CORNERS ARE SHOWN THUS:
WITNESS CORNERS ARE SHOWN THUS:
LOT NUMBERS ARE SHOWN THUS: 4
FARM UNIT LETTERS ARE SHOWN THUS: B
TOTAL ACREAGE IN EACH FARM UNIT SHOWN THUS: 13.22

THE ABOVE DIAGRAM OF THE SURVEY OF FARM UNITS BORDERING ON THE O. R. R. & N. CO.'S TRACK IN SEC. 3, T. 4 N., R. 28 E., W. M. OREGON, EXECUTED UNDER AUTHORITY OF DEPARTMENTAL INSTRUCTIONS OF OCTOBER 24, 1906, IS CORRECT AND ACCORDING TO THE FIELD NOTES ON FILE IN THIS OFFICE, WHICH HAVE BEEN EXAMINED AND APPROVED.

U. S. RECLAMATION SERVICE,
WASHINGTON, D. C., May 21, 1909.

Morris Bien
ACTING DIRECTOR.

DEPARTMENT OF THE INTERIOR
GENERAL LAND OFFICE
WASHINGTON, D. C., June 8, 1909.

THE ABOVE DIAGRAM OF THE SURVEY OF FARM UNITS BORDERING ON THE O. R. R. & N. CO.'S TRACK IN SECTION 3, T. 4 N., R. 28 E., W. M. OREGON, IS CONFORMABLE TO THE FIELD NOTES WHICH HAVE BEEN EXAMINED AND ACCEPTED.

Fred Dennett
COMMISSIONER.

ACCESSION NO. 11078