

Rec'd Dec 6, 1870

Washington Transcript made
David S. Murphy

William B. Campbell
Deputy Surveyor

1A 293

XX

not comp

Rem'd.

I Samuel L. Campbell and Josephus Tompkins having been appointed chairmen in the service of Wm. S. Campbell deputy Surveyor in Oregon do solemnly swear that we will level the chain in measuring over uneven ground, that we will well and truly plumb the tally pins, whether in ^{that I will report the true distance to all notable objects, and the true length of all things that I may assist in measuring} sticking or dropping the same, that we will correctly and distinctly mark all letters and figures that we maybe required to mark, and that we will further act as required by said deputy in the discharge of his surveying duties to the best of our skill and abilities

Subscribed and sworn to before me
 Samuel L. Campbell
 Josephus Tompkins
 at Dallas City, Wasco County
 Oregon, this 4th day
 of October A. D.
 1850
 N. H. Courteney, J. P.
 in and for Wasco County Oregon


I Robert F. Canfield having
 been appointed Assessor in
 the service of J. M. Campbell
 Deputy Surveyor in Oregon. do
 solemnly swear that I will well
 and ~~faithfully~~ faithfully perform the duties of
 Assessor or Assman according
 to instructions given me, and to
 the best of my skill and ability
 Robert F. Canfield

Subscribed and sworn to before
 me at Dallas City Wasco County
 Oregon this 4th day of October
 A. D. 1860
 W. H. Condon
 J. P.
 in and for Wasco County
 Oregon

Field Notes of the survey of the
 exterior boundaries of Townships No
 11 North of Ranges No 29 & 30
 East of the Willamette Meridian,
 in the State of Oregon, by Wm B,
 Campbell, deputy surveyor, under
 his Contract No 95, bearing date
 the 19th day of September 1860

Commenced Oct. 13th 1860
 Finished Oct. 23rd 1860

Index Diagram

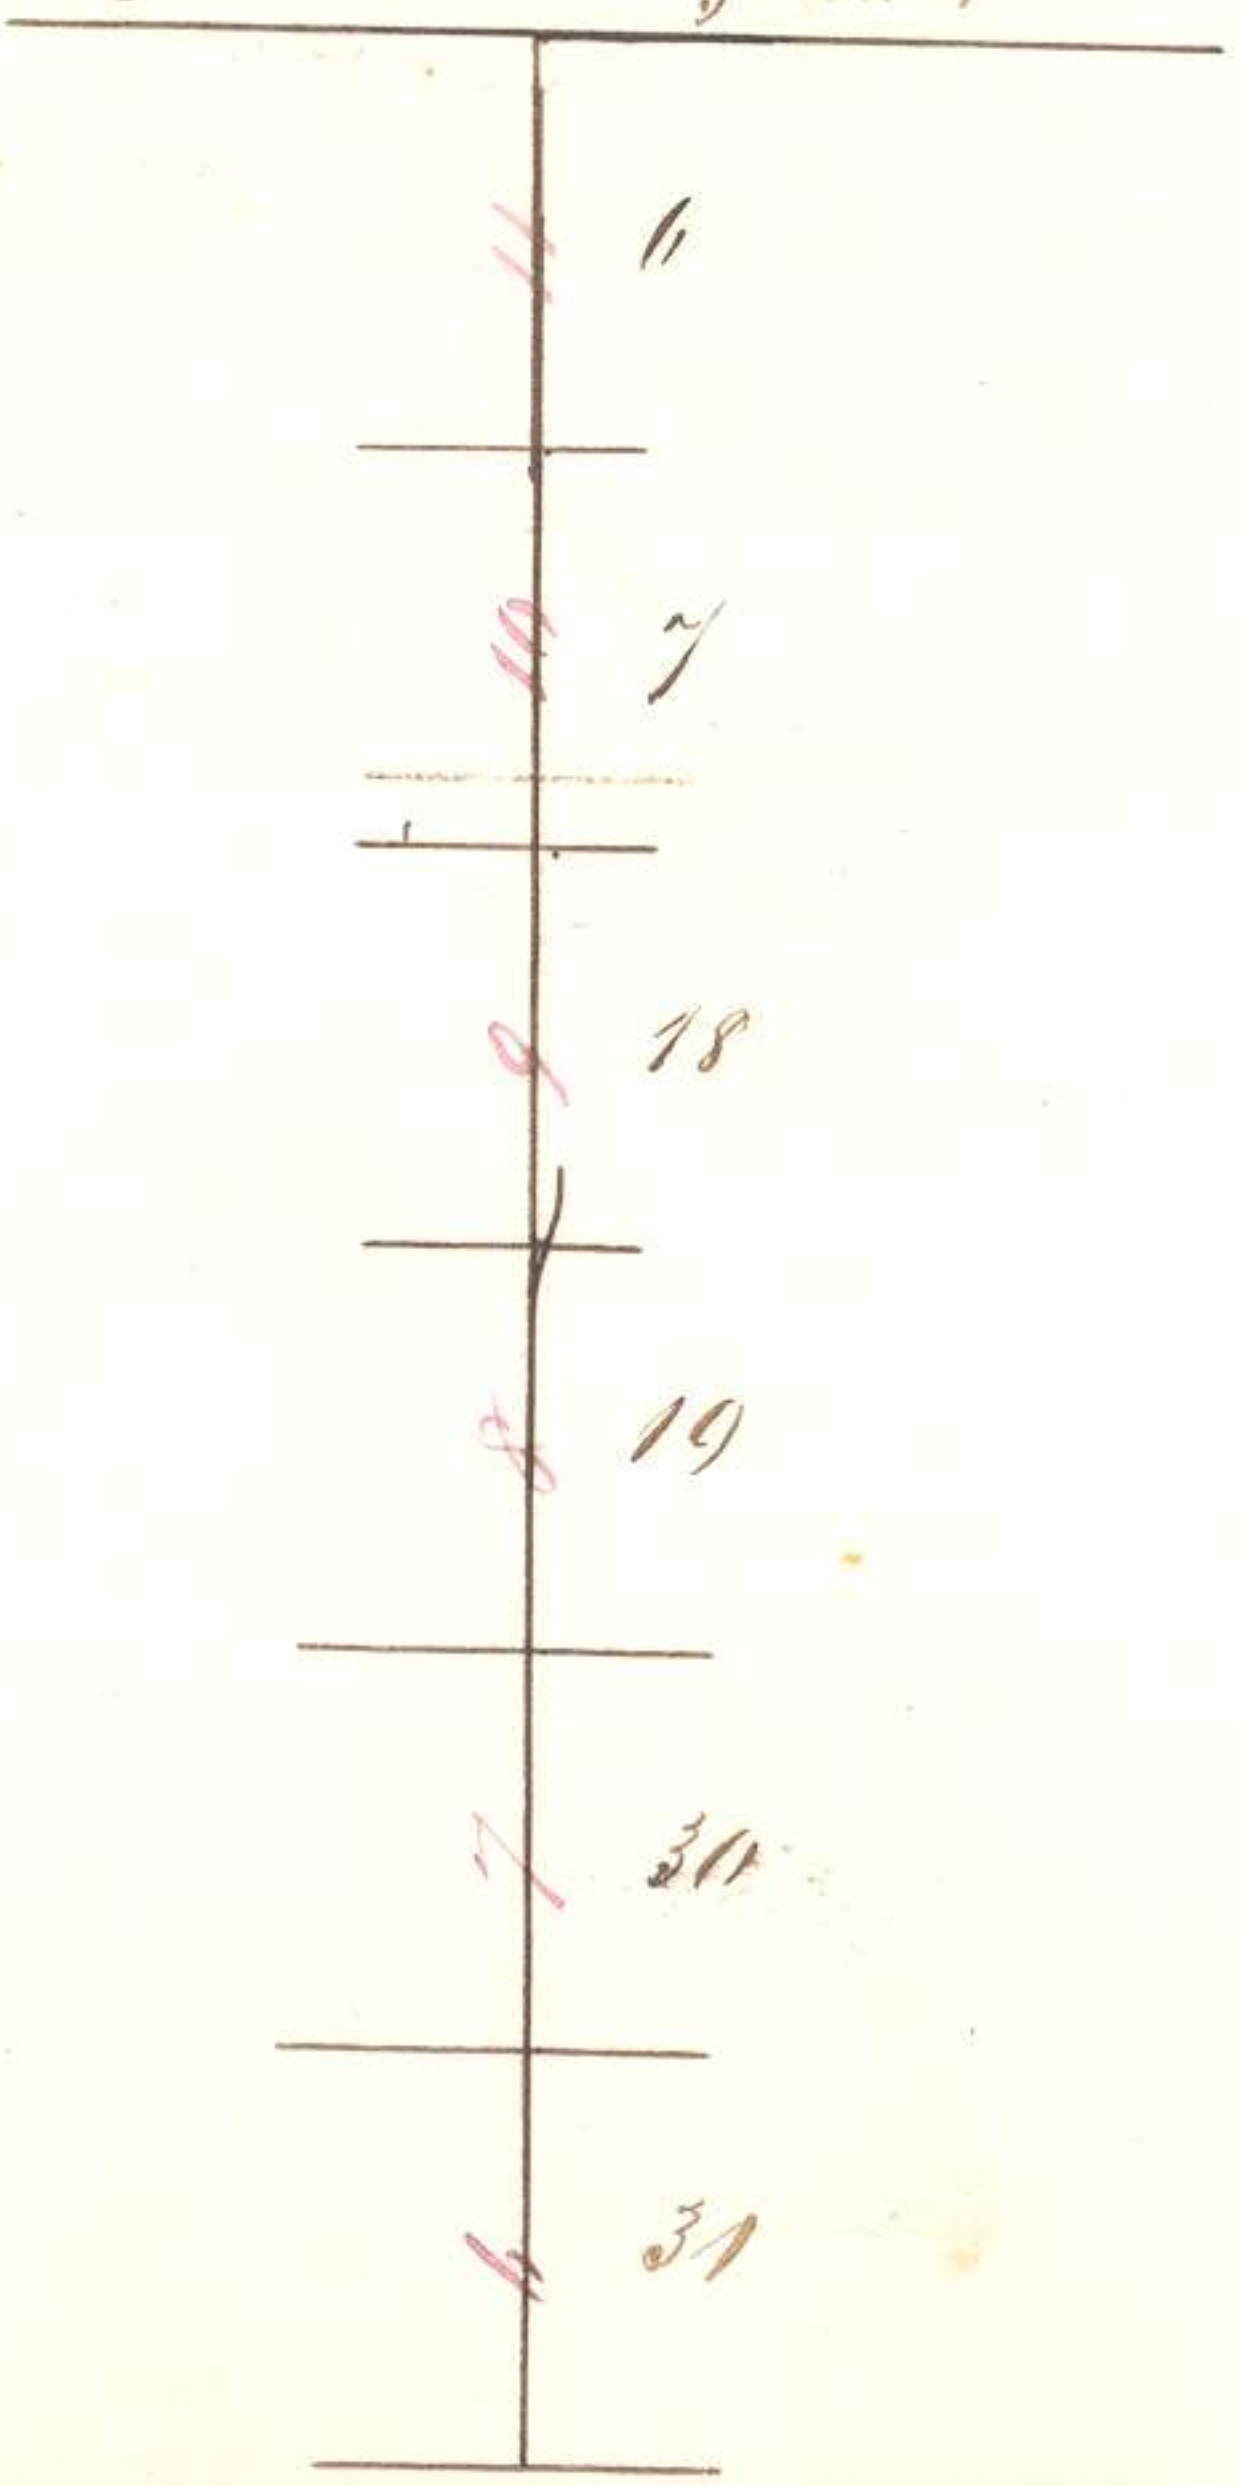

chains

North, Between Secs 1 & 6

Variation 20° 45' E,

44.00 Set post for quarter section
corner. Drove a char'd stake
raised mound of earth with
trench and pits, as per
instructions,

79.90 Intersect 1st Standard
parallel North, 7th ~~11th~~ chains,
West of standard corner,
Drove a char'd stake for
closing corner to sec 1 & 6 & raised
in mound of earth with trench
and pits, as per instructions,
A big rock near the mouth of
the Umatilla river bears S 89° W.
from closing corner. Sand
rolling prairie Soil 3rd rate
& sandy.

October 13th 1860

190

List of names.

A list of the names of the individ-
-uals employed to assist in running,
measuring, or marking the lines and
corners described in the foregoing field
notes of ^{the Survey of} Township No 4 North
of the Base Line of Range No 29
East of the Pittamette Meridian,
showing the ^{respective} capacities in which
they acted;

- Samuel Campbell chairman
- Joseph Tompkins chairman
- Robert Farfield Assn

We hereby certify that we assisted
Wm B Campbell deputy surveyor
in surveying the exterior ~~line~~
~~lines~~ of Township number
four North of the base line of Ranges
number twenty nine and thirty
East of the Pittamette Meridian,

and that said Townships
 have been in all respects to the
 best of our knowledge and belief
 well and faithfully surveyed,
 and the boundary monuments
 planted according to the
 instructions furnished by the
 Surveyor General,

Samuel L. Campbell chairman
 Josephus Tompkins chairman
 Robert F. Caufield Assnans

Subscribed and sworn to
 before me this 3rd day of Decr
 AD 1860, ^{at Oregon city} J. C. Dawson

Clerk of the Circuit
 Court for the County
 of Clackamas State
 of Oregon

192

Wm. D. Campbell, deputy surveyor

do solemnly swear that, in pursuance
of a contract with W. H. Chapman.

Surveyor of the public lands of the
United States, in ~~the~~ ~~state~~ of Oregon,
bearing date the 19th day of September
1860, and in strict conformity to the
laws of the United States, and the
instructions furnished by the said
Surveyor General, I have faithfully
surveyed, the exterior boundaries of
Townships number four North
of the base of Ranges number twenty-
nine and thirty East of the Willam-
ette Meridian, in the State afore-
said, and do further solemnly
swear that the foregoing are
the true and original field
notes of such surveys.

Wm. D. Campbell

Deputy Surveyor

Subscribed and sworn
to before me at Oregon

City this 3rd day of December
AD 1860 Geo. W. W. W. W.
Clerk of the Circuit
~~Court~~ for Blackham
County State of Oregon

194

Surveyor General's Office,
Eugene City, Jan'y 29th 1860.
The foregoing field notes of
the Survey of the Exterior Line
of Townships No. 4 North of
Ranges No. 29 & 30 East of
the Willamette Meridian; ex-
ecuted by Wm. B. Campbell,
deputy Surveyor, under his con-
tract of the 19th day of Septem-
ber 1860 - having been critically
examined, the necessary cor-
rections and explanations
made, the said field notes
and the surveys they describe
are hereby approved.

A. N. Chapman
Sur: Genl. of Oregon