


Field notes of the survey of the
exterior boundaries of Township
N^o 4 North of Range N^o 29 East
of the Willamette Meridian in the
State of Oregon, by Wm. B. Campbell
deputy surveyor, under his con-
tract N^o 93, bearing date the
19th day of September 1860

Commenced Oct. 15th 1860
Finished October 17th 1860

Index Diagrams

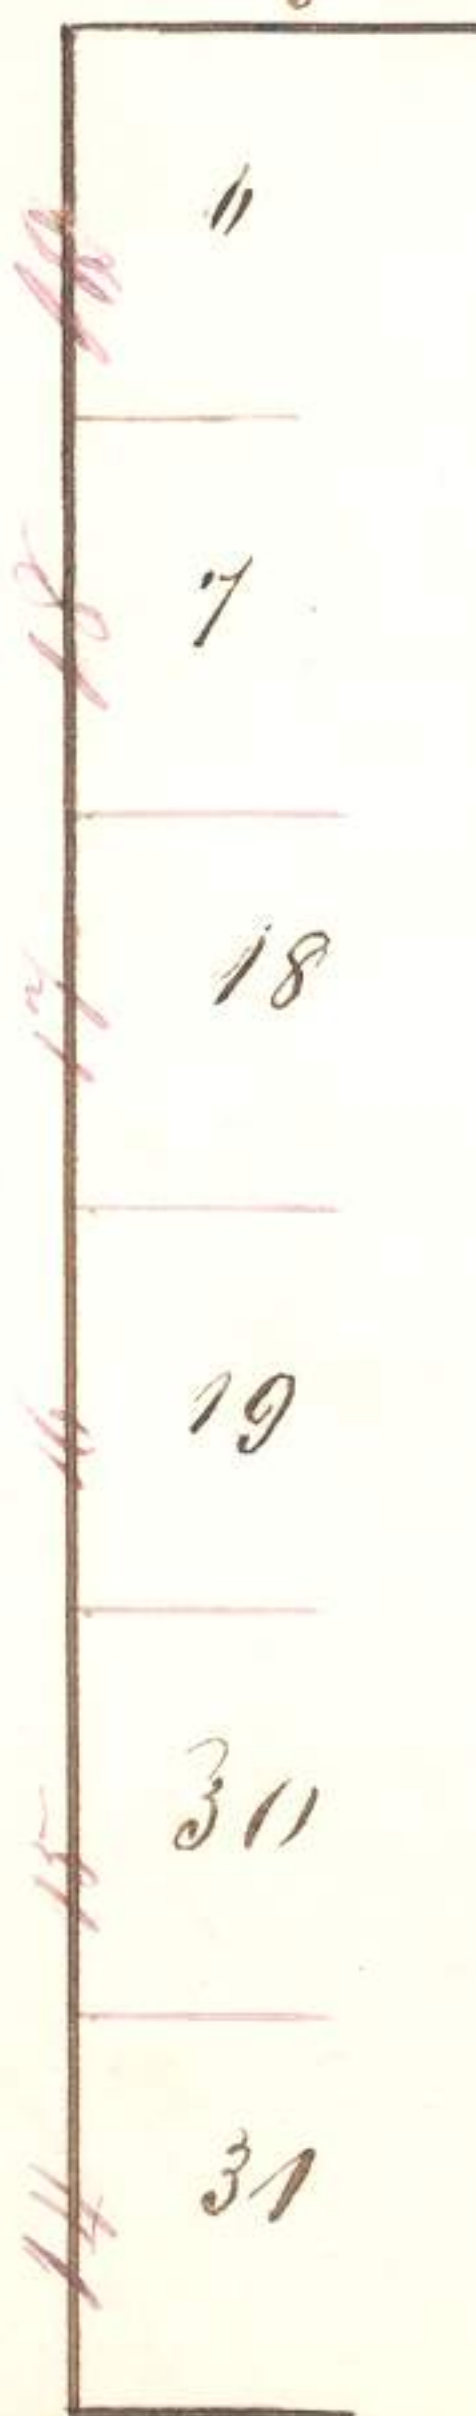

Chs.

North, Between Sec 7 & 12,

Variation 20° 20' E.

18.00 by iron nail gentle descent

40.00 Set a post for quarter sec. corner

draw char'd stake raised mound with
trench & pits as per instructions.

62.00 1/2 foot of descent, + 150

81.00 Set a post for corner to sec. 11. 1. 10

7 & 12. draw a char'd stake

raised mound, with trench
& pits, as per instructions. Soil

Sand & brick prairie Soil 2nd & 3rd rate

North, Between Sec 1 & 6

Variation 20° E

41.00 Set a post for quarter sec corner

in mound of earth with trench, pits
as per instructions.

83.45 Intersect 1st Standard Parallel N.

1/3. 811 chains West of Standard corner

Draw char'd stake raised mound of earth
(for closing cor. to Group 4 N. Rgs 27 & 28 East)
with trench & pits as per instructions. Soil Sage
plain. Soil 3rd rate

190

List of names.

A list of the names of the individuals employed to assist in running, measuring, or marking the lines and corners described in the foregoing field notes of ^{the Survey of} Township No. 4 North of the Base Line of Range No. 29 East of the Pittamette Meridian, showing the ^{respective} capacities in which they acted;

Samuel Campbell chairman
Joseph Tompkins chairman
Robert Farfield Assessor

We hereby certify that we assisted
S. B. Campbell deputy surveyor
in surveying the exterior ~~line~~
~~lines~~ of Township number
four North of the base line of Ranges
number twenty nine and thirty
East of the Pittamette Meridian,

and that said Townships lines
 have been in all respects to the
 best of our knowledge and belief
 well and faithfully surveyed,
 and the boundary monuments
 planted according to the
 instructions furnished by the
 Surveyor General,
 Samuel L. Campbell chairman
 Josephus Tompkins chairman
 Robert F. Caufield Assessor

Subscribed and sworn to
 before me this 3rd day of Decr
 AD 1860, ^{at Oregon city} J. C. Dawson
 Clerk of the Circuit
 Court for the County
 of Clackamas State
 of Oregon

192

I, Wm. D. Campbell, deputy surveyor

do solemnly swear that, in pursuance
of a contract with W. H. Chapman.

Surveyor of the public lands of the
United States, in ~~the~~ ~~state~~ of Oregon,

bearing date the 19th day of September
1860, and in strict conformity to the

laws of the United States, and the
instructions furnished by the said

Surveyor General, I have faithfully
surveyed, the exterior boundaries of

Townships number four North
of the base of Range number twenty-

nine and thirty East of the Willam-
ette Meridian, in the State afore-

said, and do further solemnly
swear that the foregoing are

the true and original field
notes of such surveys.

Wm. D. Campbell

Deputy Surveyor

Subscribed and sworn

To before me at Oregon

City this 3rd day of December
AD 1860 Geo. W. W. W. W.
Clerk of the Circuit
~~Court~~ for Blackham
County State of Oregon

194

Surveyor General's Office,
Eugene City, Jan'y 29th 1860.
The foregoing field notes of
the Survey of the Exterior Line
of Townships No. 4 North of
Ranges No. 29 & 30 East of
the Willamette Meridian; ex-
ecuted by Wm. B. Campbell,
deputy Surveyor, under his con-
tract of the 19th day of Septem-
ber 1860 - having been critically
examined, the necessary cor-
rections and explanations
made, the said field notes
and the surveys they describe
are hereby approved.

A. N. Chapman
Sur: Genl. of Oregon