

FIELD NOTES

Of the survey of the *Subdivisional*

Lines of *T. 3 N., R. 33 E. 2nd Tps. 4 N.*

R. 37 2nd 35 E. Willamette Meridian, Oregon,

as surveyed by *Jas. P. Curvin 2nd Jos. E. Poland*

U. S. Deputy Surveyor, ^{their} under his Contract No. _____

dated *May 4th*, 1887

Survey commenced, *Aug 15th*, 1887

Survey completed, *" 17th*, 1887

NAMES AND DUTIES OF ASSISTANTS.

_____, Compassman.

J. D. Madley, Chainman.

W. C. Madley, Chainman.

Frank Belshaw, Chainman.

Guy Davis, Chainman.

P. B. Crown, Axman.

J. R. Madley, Axman.

_____, Flagman.

PRELIMINARY OATHS OF ASSISTANTS.

We,

J. D. Medley W. H. Medley
Frank Belshaw and Guy Davis

do solemnly swear that we will faithfully execute the duties of Chain Carriers; that we will level the chain over even and uneven ground, and plumb the tally pins, either by sticking or dropping the same; that we will report the true distance to all notable objects, and the true length of all lines that we will assist in measuring, to the best of our skill and ability, and in accordance with the instructions given us in the survey of the

Subdivisional lines of T. 3 N. R. 33 E. and
T. 4 N. R. 34 and 35 E. Willamette Meridian, Oregon.

J. D. Medley, Chainman.
W. H. Medley, Chainman.
Frank Belshaw, Chainman.
Guy Davis, Chainman.

Subscribed and sworn to before me this 11th

day of August, 1887

[SEAL.]

James P. Plourrin
U.S. Deputy Surveyor

We,

B. B. Cromer
J. A. Hadley

and

do solemnly swear that we will well and truly perform the duties of Axmen in the establishment of corners and other duties, according to instructions given us, and to the best of our skill and ability, in the survey of the

Subdivisional lines of T. 3 N. R. 33 E. and
T. 4 N. R. 34 and 35 E. Willamette Meridian, Oregon.

B. B. Cromer, Axman.
J. A. Hadley, Axman.

Subscribed and sworn to before me this 11th

day of August, 1887


[SEAL.]

James P. Plourrin
U.S. Deputy Surveyor

INDEX

Referring the Lines to the Pages of the Field Notes.

T. *3 North* R. *33 East.* Will. Mer.

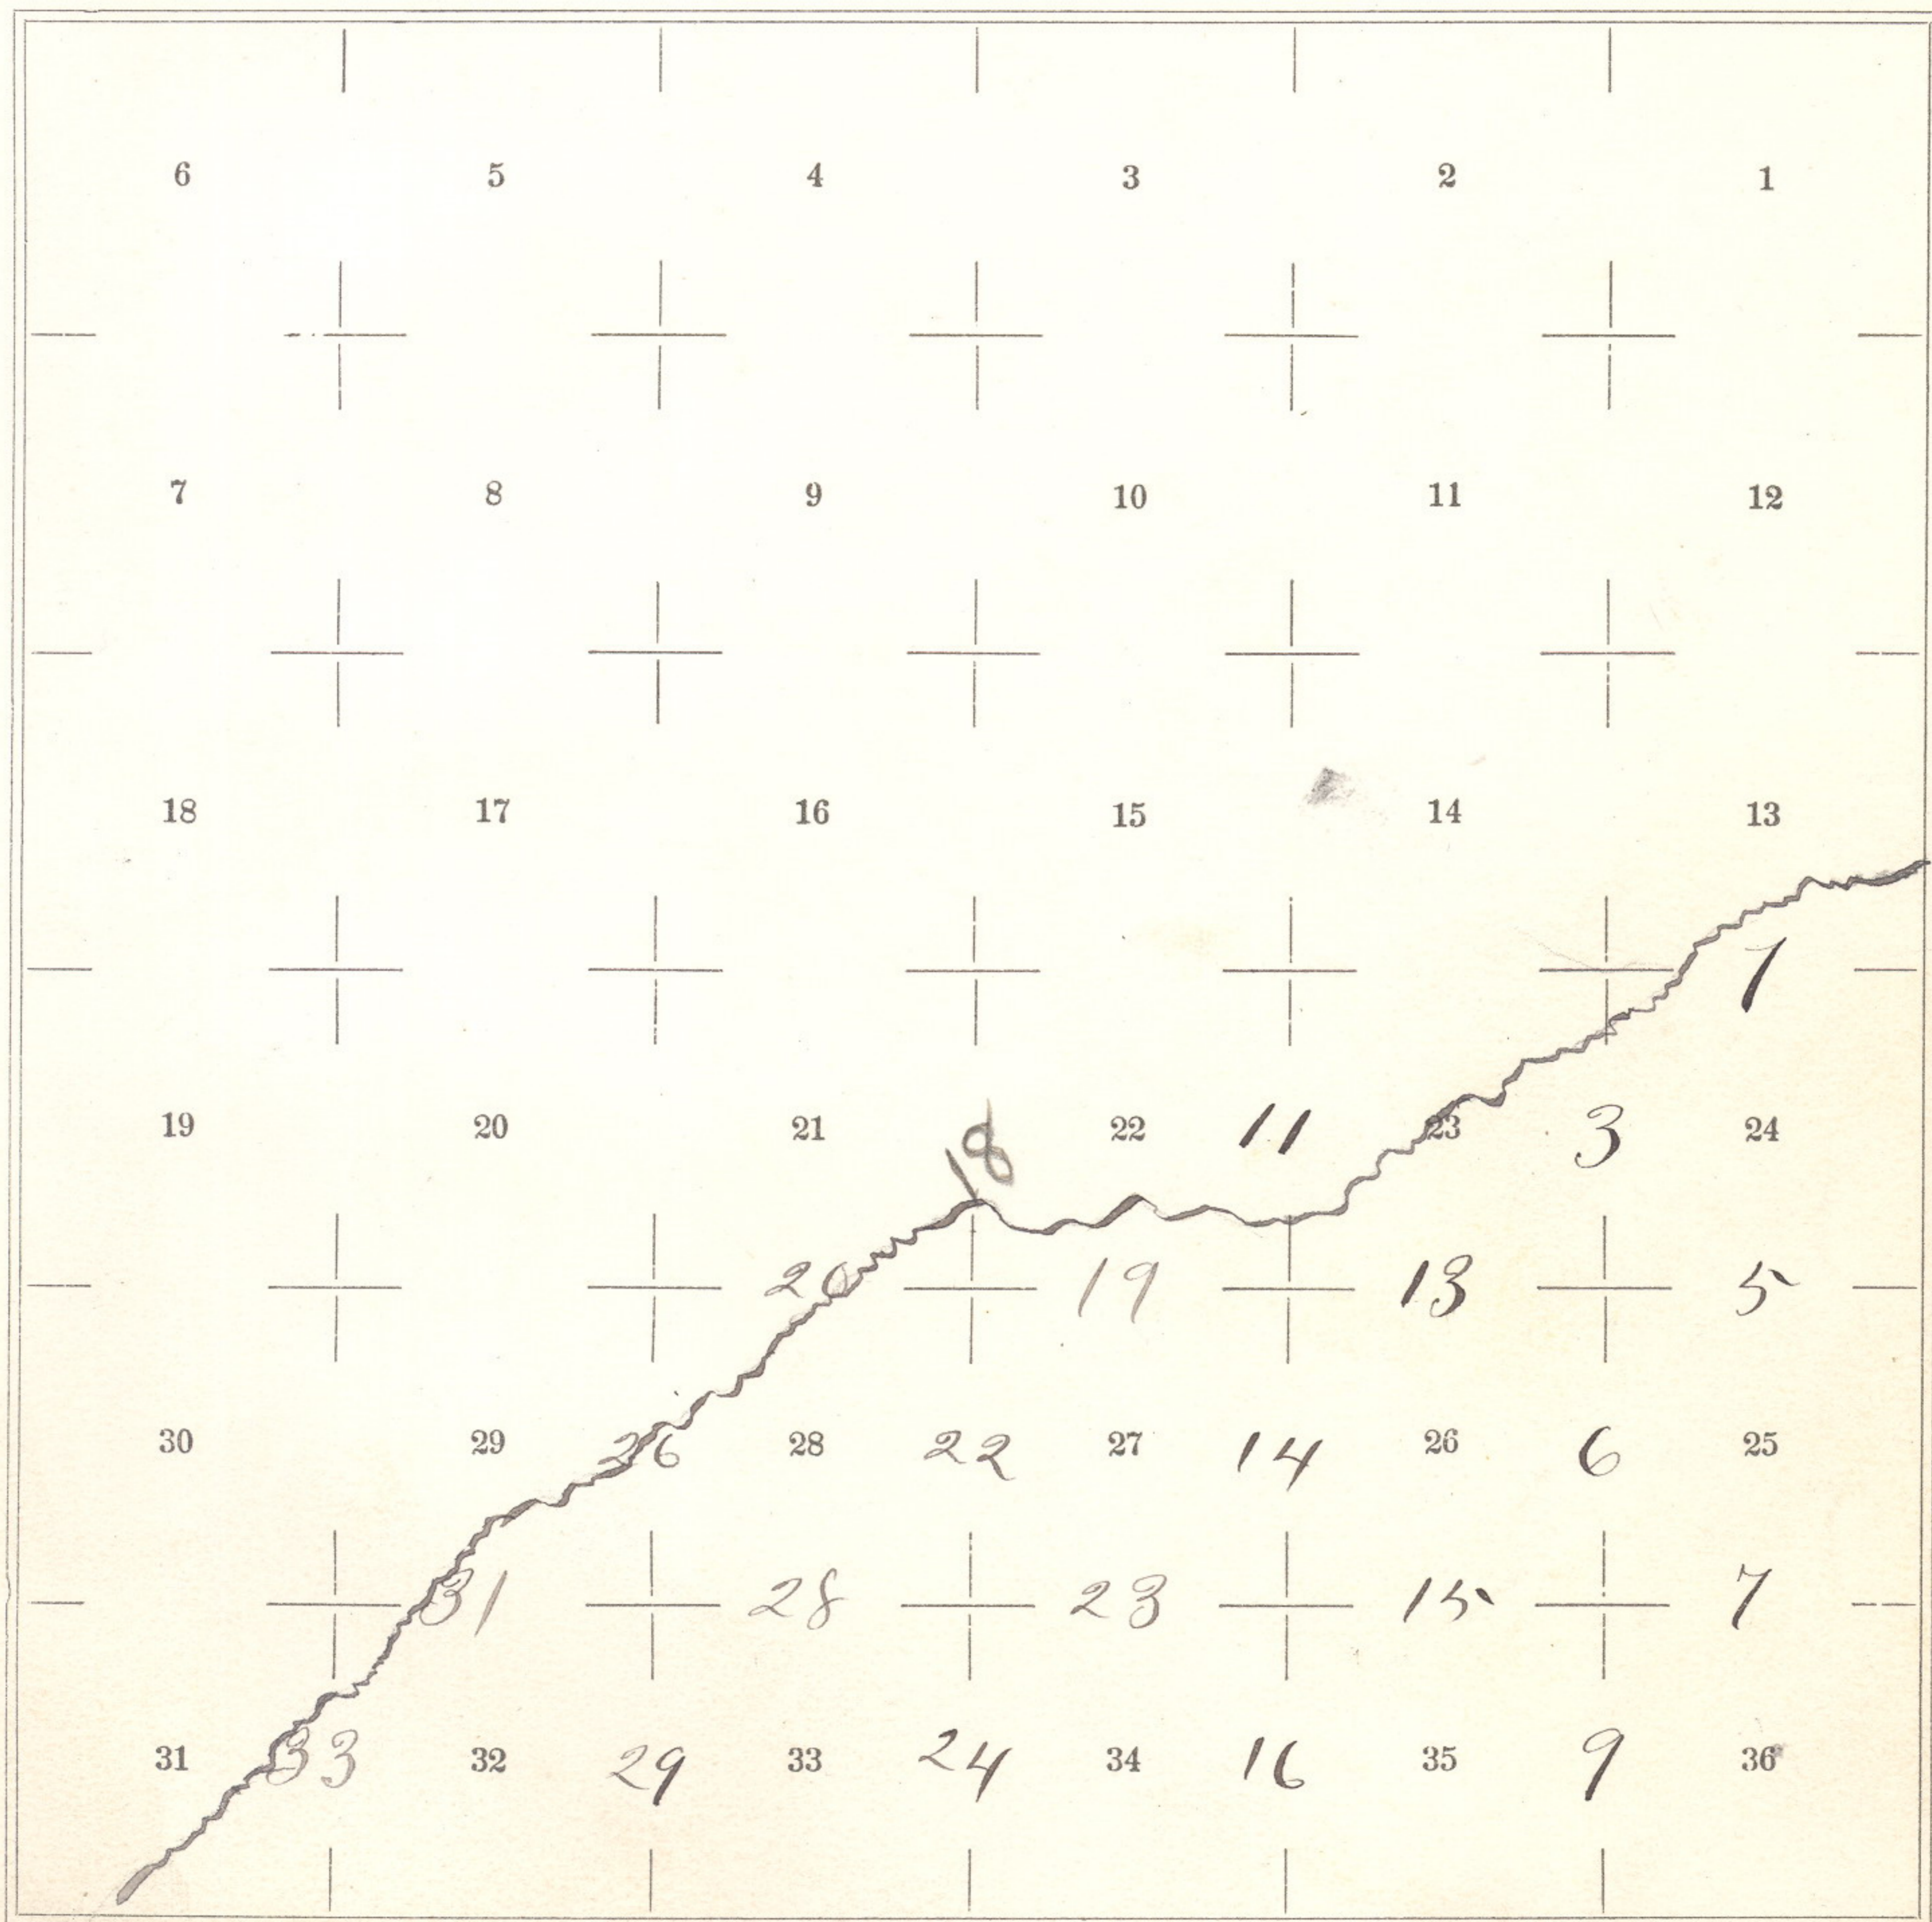

Meanders of _____, Pages _____ to _____

Meanders of _____, Pages _____ to _____

INDEX

Referring the Lines to the Pages of the Field Notes.

T. *H North* R. *34 East* Will. Mer.

6	5	4	3	2	I
7	8	9	10	11	12
18	17	16	15	14	13
19	20	21	22	23	24
					35
30	29	28	27	26	37 25
				43	39
31	32	33	34	35	41 36


Meanders of _____ Pages _____ to _____

Meanders of _____ Pages _____ to _____

INDEX

Referring the Lines to the Pages of the Field Notes.

T. *4 North* R. *35 East* Will. Mer.

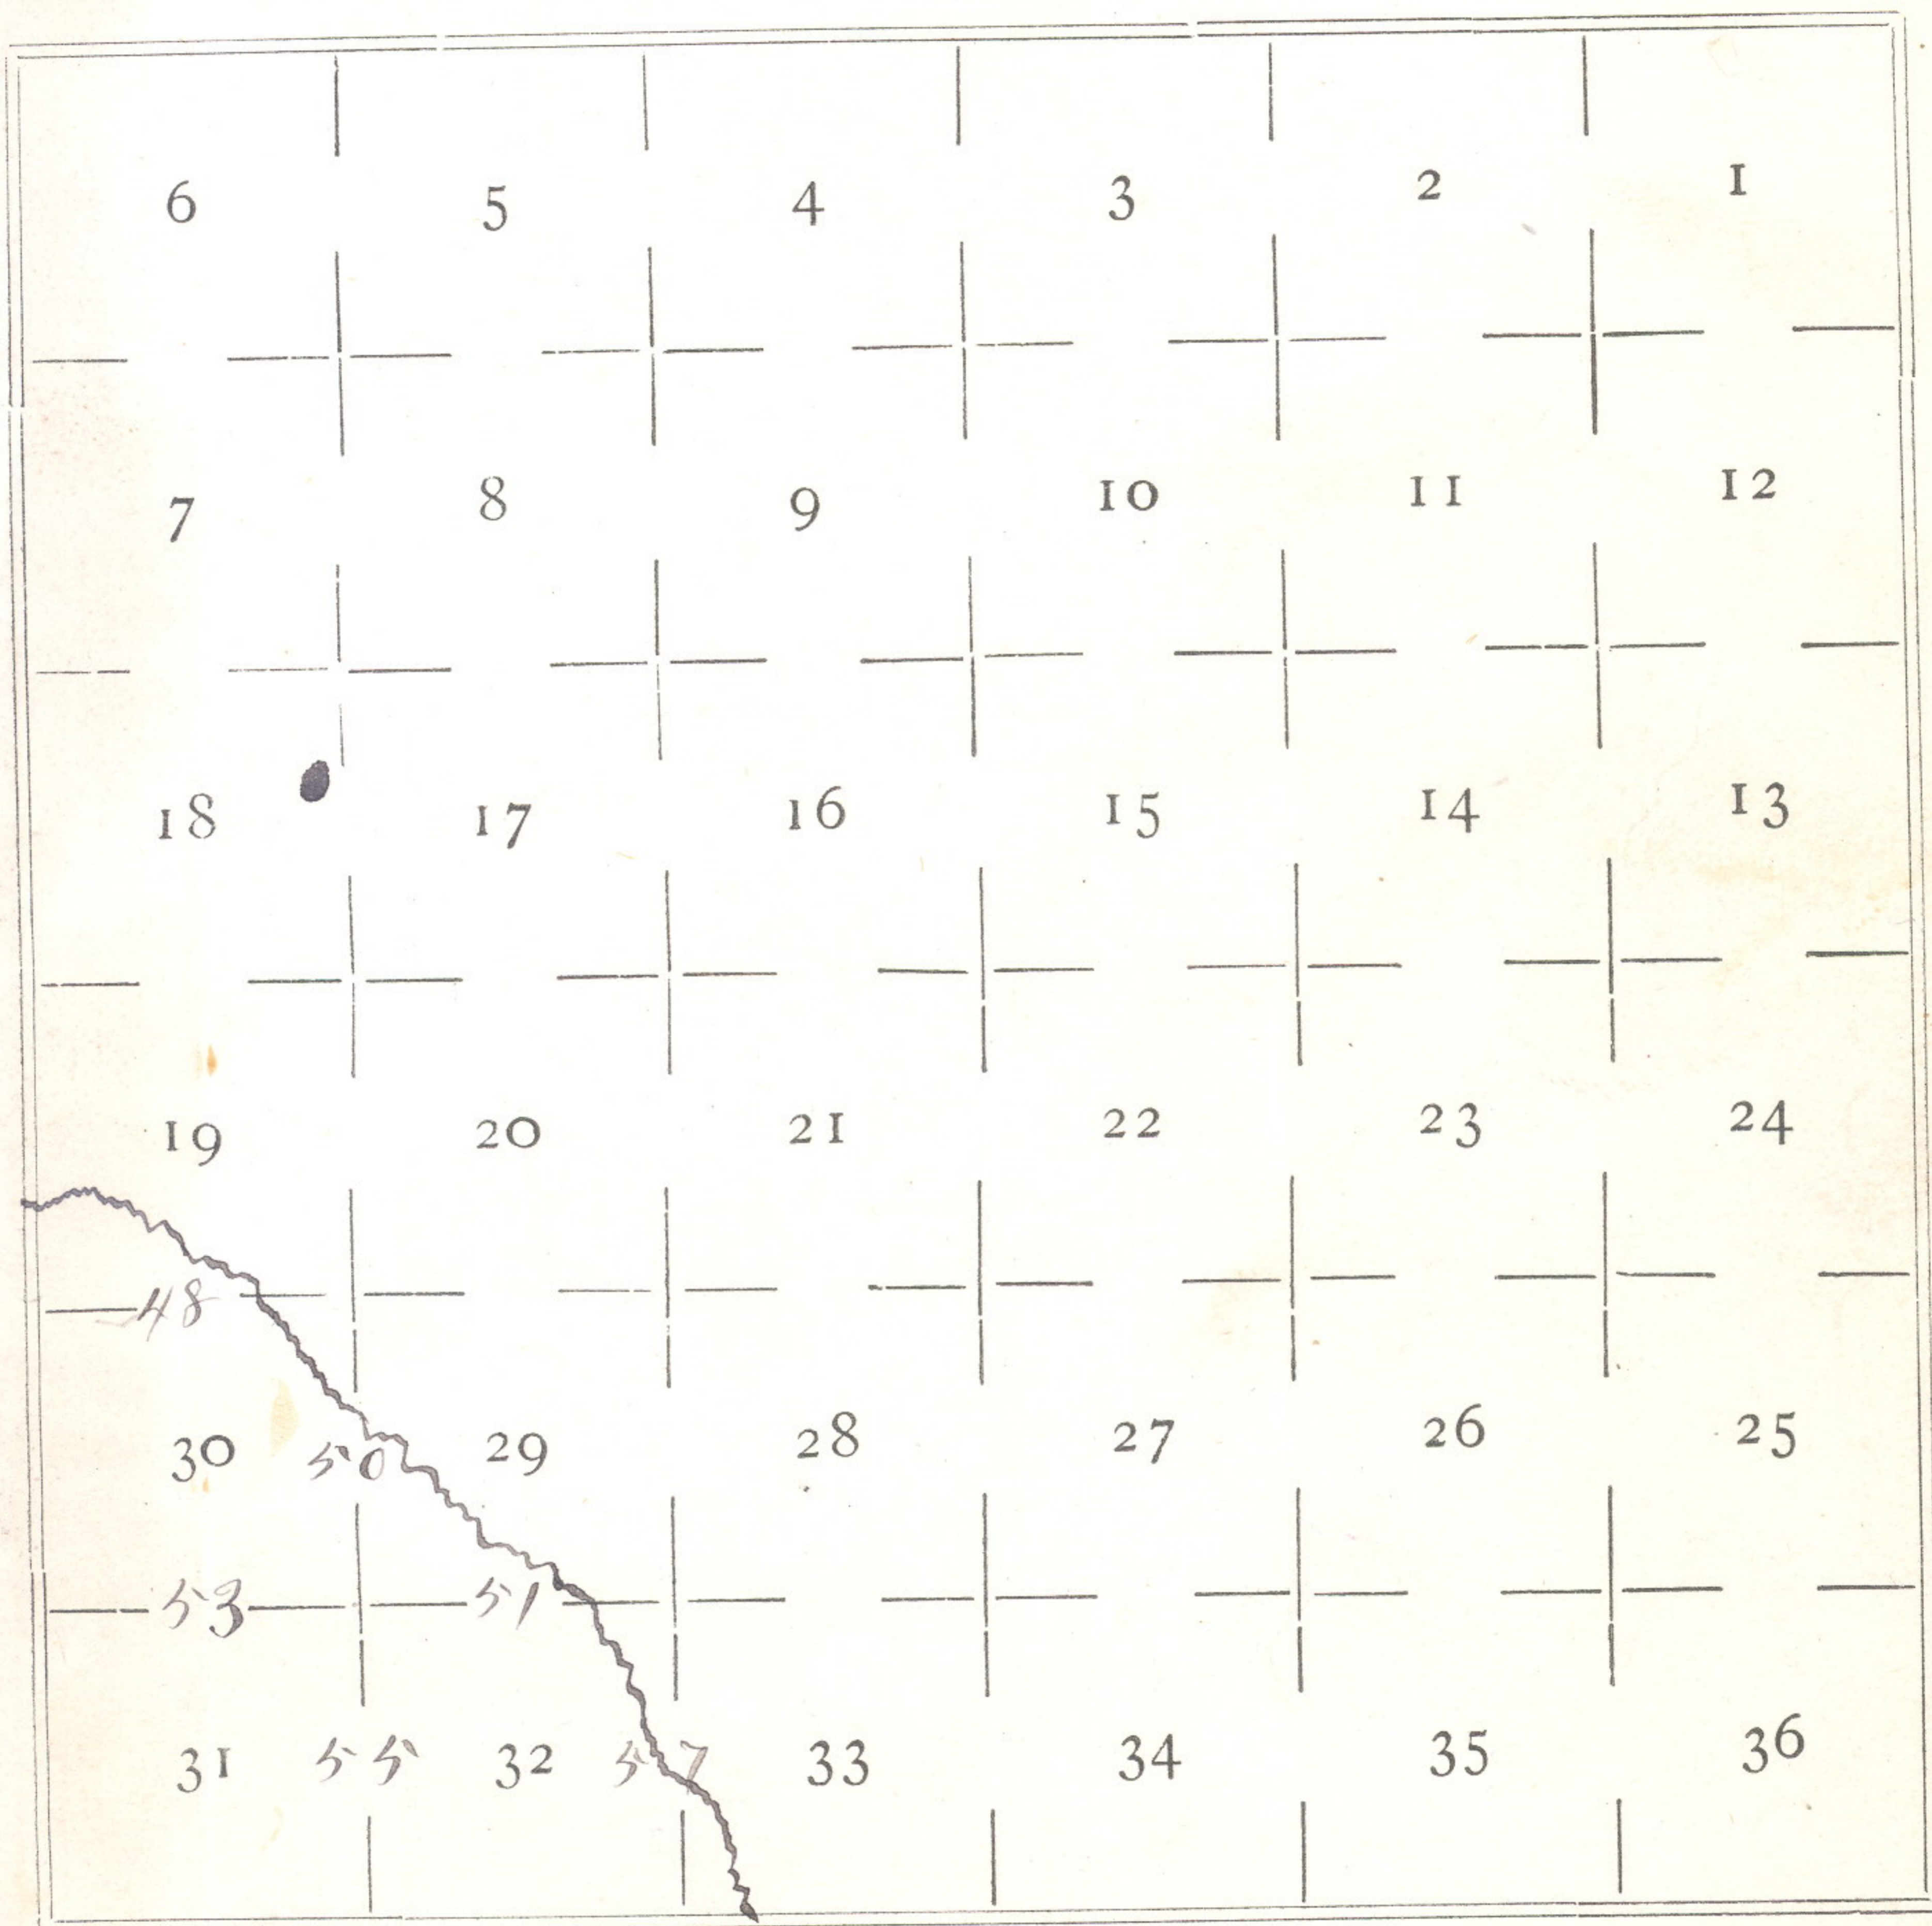

Meanders of _____ Pages _____ to _____

Meanders of _____ Pages _____ to _____

Subdivisions of T. 4 North R. 34 East
Willamette Meridian, Oregon.

Survey commenced August 16th 1887
 with Burts improved solar compass
 Commencing at cor to secs
 23, 24, 25 and 26 which is
 an old post 4 ft. long, 4 ins
 square 24 ins. in the ground
 marked T. 4 N. S 24 on N.E.
 R 34 E S 25 on S.E.
 S 26 on S. W. and S. 23 on N. W.
 face with 2 notches on
 S and 1 notch on E. edges
 fairly well preserved with
 a pit in each sec. 5 1/2 ft
 dist. I run
 East on random bet secs
 24 and 25-

Pa 18 1/2° East

40.00
40.00
80.64
80.64

Set temporary 1/4 sec. cor. and at
 Intersect E. bdy. Township
 at cor to secs 24, 25, 19 and 30
 Thence N on true line

Pa 21° East

26.00
26.00

Wire fence N. E. and leave field

Subdivision of T. 4 North R. 94 East

Willamette Meridian, Oregon.

(8093-10 M.)

2700 Centerville and Adams Wayon road
N.E. - 7 & 8 H.

2950 O. R. and N. R. R. N.E.

3600 Wayon road, N.E. and S.H.

3900 Wire fence and enter field N.E.

4064 Set post 3 ft long 9 ins
square 24 ins in the ground
marked 4 T on N. face for
1/4 sec. cor. dug pits 18x18x12
ins E and W. of post 5 1/2 ft.
dist raised mound of earth
1 1/2 ft high, 3 1/2 ft. base around it.

47.14 Set post 4 ft long 4 ins square
24 ins in the ground for
Meander cor to fractional
secs. 24 and 25 marked
W.R.M.C. with
T 4 H on E
R 94 E S 24 on N. face and
S 25 on S face and dug
a pit 3 ft square 1 ft deep

Subdivision of T. 4 North R. 34 East
Willamette Meridian, Oregon.

- 8 lbs E of post and raised
mound of earth 2 ft high
4 1/2 ft. base around it.
- 4780 Dry ditch or old channel of
Wild horse creek, S. H.
- 5000 Wild horse creek 10 lbs wide S. H.
- 8064 Cor to secs 23, 24, 25 and 26
Land level.
Soil 1st rate
No timber Mostly cultivated

South bet secs 25 and 26
Ca. 18 1/2° East

- 2700 Set post 4 ft. long, 4 ins square
24 ins in the ground for witness
Meander cor to fractional secs
25 and 26 marked W. R. M. C. H. C.
with T H Now N
R 34 E S 25 on E and
S 26 on N faces and dug a pit
3 ft square 1 ft deep 8 lbs N of

Subdivisions of T. 4 North R. 34 East

Willamette Meridian, Oregon.

(8093-10 M.)

of post which is 20 lbs N. of true cor. and raised mound of earth 2 ft. high 4 1/2 ft base around it.

2720 Middle of Wild horse creek - 10 lbs wide run S. W.

3525 Leave field ^{corner} and W.

3750 Road N. R. R. ^{corner} S. W.

4000 Set post 4 ft. long 4 ins square 24 ins in the ground for 1/4 sec. cor. marked 1/4 S. on W. face. dug pits 18x18x12 ins N. and S. of post 5 1/2 ft. dist raised mound of earth 1 1/2 ft. high 8 1/2 ft. base around it -

4000 Set post 4 ft. long 4 ins square 24 ins in the ground for cor to sec 25, 26, 35 and 36 marked

T 4 N S 25 on N. E.

Subdivision of T. 4 North R. 34 East
Willamette Meridian, Oregon.

R. 34 O. S. 36 on S. E.
S 35 on S. W. and S 26 on N. W.
faces, with 1 notch on S. and E.
edges, and raised mound of
stone 2 ft high 4 1/2 ft base
around post.

Land mostly level.

Soil rich, bottom, sandy.

Mostly cultivated

Cast on random between 25 and 36
Va 19 3/4 East

Set temporary 1/4 and 1/6 sec. corrs.
at 20, 40 and 60 chains and at

2050 Intro set E. bdy. Township.
75 lbs N. of cor. to sec 25, 36,
30 and 31 Thence N 89° 28' W.
on true line

Va 20 1/4 East

2050 Deposited charred stake 12 ins
in the ground for 1/6 sec

Subdivisions of T. 4 North R. 34 East
Willamette Meridian, Oregon.

(8093 10 M.)

cor. dug pits 18x18x12 ins
E. and W. of stake 5 1/2 ft. dist.
raised mound of earth
1 1/2 ft high 9 1/2 ft. base ^{over it} and
in E. pit. drove stake 2 ft.
long 2 ins square 2 ins.
in the ground marked
1/4 D. on N. face

4050

Set post 3 ft. long, 2 ins. square
24 ins in the ground for
1/4 sec. cor. marked 1/4 D on

N. face dug pits 18x18x12 ins
E. and W. of post 5 1/2 ft. dist.
and raised mound of earth
1 1/2 ft high 9 1/2 ft base
around it.

6020

Wire fence, ^{course} E. and W.

6050

Deposited charred stake 12 ins
in the ground for 1/6 sec.
cor. dug pits 18x18x12 ins
E. and W. of stake 5 1/2 ft. dist.

Subdivisions of T. 4 North R. 34 East
Willamette Meridian, Oregon.

raised mound of earth 1 1/2
ft. high 3 1/2 ft. base over
it and in E. pit drove stake
2 ft. long, 2 ins square 12 ins
in the ground marked
1/6 S on N. face.

8050

Cor. to sees. 25, 26, 35 and 36
Land mostly level
Soil 1st rate
All cultivated

South on ran. bet sees.
35 and 36

Pa. 19 3/4 East.

Set temporary corners
at 20, 40 and 60 chains and at

8070

Intersect S. bdy, Township
70 lbs N. of cor. to sees.
1, 2, 35 and 36 Thence
North 30' W on true line

Pa 21 1/4 East

X

Subdivision of T. 4 North R. 34 East

Willamette Meridian, Oregon.

(8093-10 M.)

- | | |
|------|---|
| 100 | leave garden |
| 200 | Wagon road E. and N.
Ascend hill +250 |
| 2070 | Deposited charred stake 12 ins.
in the ground for $\frac{1}{16}$ sec.
cor. dug pits 18 x 18 x 12 ins.
N. and S. of stake 5 $\frac{1}{2}$ ft. dist.
raised mound of earth
1 $\frac{1}{2}$ ft. high 3 $\frac{1}{2}$ ft. base over
it and in N. pin drove
stake 2 ft. long, 2 ins square
12 ins in the ground marked
$\frac{1}{16}$ S on N. face. |
| 3000 | Wagon road E. and N. |
| 4070 | Set post 3 ft long, 3 ins square
24 ins in the ground for
$\frac{1}{4}$ sec. cor. marked $\frac{1}{4}$ S
on N. face dug pits
18 x 18 x 12 ins N. and S.
of post 5 $\frac{1}{2}$ ft dist raised
mound of earth 1 $\frac{1}{2}$ ft high. |

Subdivisions of T. 4 North R. 94 East
 Willamette Meridian, Oregon.

4970 3 1/2 ft base around it
 Wire fence, and Enter field

6070 3 ft post 3 ft long. 3 ins
 square 24 ins in the ground
 for 1/6 acre cor. marked
 1/6 D on N face. dug pits
 18 x 18 x 12 ins N. and S. of
 cor 5 1/2 ft dist. raised mound
 of earth 1 1/2 ft high. 3 1/2 ft base
 around post

8070 Cor to sees 25, 26, 35 and 36
 Land rolling
 Soil 1st rate
 No timber Can all be cultivated

Commencing at cor to sees
 26, 27, 34 and 35 which is stone
 buried in the ground 12 ins
 deep in old mound, old pits
 in each see 5 1/2 ft dist. Thence
 Run East on random line bet

Subdivisions of T. 4 North R. 34 East
Willamette Meridian, Oregon.

(8093-10 M.)

Secs 26 and 35

Ca 19⁹⁴ E

40.00
7935

Set temporary 1/4 sec. cor. and at
Intersect E. bdy at cor to secs
25, 26, 35 and 36 Thence
West on true line

Ca same

39.67

Set post 3 ft long 8 ins
square 24 ins in the ground
for 1/4 sec. cor. marked
1/4 E. on N. face dug pits
18 x 18 x 12 ins E. and W.
of post 5 1/2 ft. dist. raised
mound of earth 1 1/2 ft high
3 1/2 ft base around it.

4090

leave field S. W.

43.25

O. R. and N. R. R. S. W.

47.00

Wagon road S. W.

52.25

Set stone 12 x 11 x 10 ins
in the ground for Meander
cor to fractional secs 26 and 35

Subdivisions of T. 4 North R. 94 East

Willamette Meridian, Oregon.

marked W.R. M.C. on E face
and dug pits 3 ft square 12 ins
in the ground 8ths E of ston
and raised mound of earth
2 ft high 4 1/2 ft. base over it.

5350 Child horse creek 10ths wide

5600 Bend of same S. 1/4

7995 Cor to aces 26, 27, 34 and 35

Land rolling
Soil 1st rate

No timber All cultivated

South on random bet aces.

34 and 35

Ra. 19 1/4 East

4000 5079 Cor temporary 1/4 sec. cor. and at

Intersect S. bdy Township

55ths S. of cor to aces 2, 3

34 and 35 Thence N 23 1/2 W.

on true line

Subdivisions of T. 4 North R. 34 East
Willamette Meridian, Oregon.

(8093-10 M.)

- Taz 20° East
- 3950 Wagon road N.E.
- 4079 Set post four ft long 4 ins square 24 ins. in the ground for $\frac{1}{4}$ sec. cor. marked $\frac{1}{4}$ D. on N. face, Aug pits 18 x 18 x 12 ins N. and S. of post $5\frac{1}{2}$ ft. dist raised mound of earth $1\frac{1}{2}$ ft. high $3\frac{1}{2}$ ft base around it.
- 4200 O. R. and N. R. R. N.E. & S.W.
- 4300 Fence and Field E. and N.
- 6150 Wild horse creek 10000 wide down S.W.
- 6229 Set post 4 ft. long, 4 ins. square 24 ins in the ground, for Meander cor to sec. fractional, 34 and 35, marked W.R.M.C. with D.K. on S. R. 34 O. S. 35 on E. and S. 34 on N. face and dug.

Subdivision of T. 4 North R. 34 East

Willamette Meridian, Oregon.

a pit 9 ft square 1 ft deep
S. of cor. and raised
mound of earth 2 ft high
4 ft. base around it.

7250 Wire fence O. and H.

8000 Fence E. and H.

8079 Cor to sec 26, 27, 34 and 35

Land level

Soil 1st rate

Mostly cultivated

Aug 17th 1887

*

General Description

This Township is rolling with level
land near the wild horse creek

The soil is a rich sandy loam &
produces splendid grain -

There is no timber excepting a fine
body of cotton wood known as
"The Grove" in Sec. 34 & some
scattered cottonwood along the
wild horse

Subdivision of T. 4 North R. 85 East

Willamette Meridian, Oregon.

Survey commenced Aug 17th 1887
with a Burt's improved solar

(8093-10 M.)

compass.

Commencing at cor to secs
19, 20, 29nd and 30 which is
old mound with pit in each
sec 5 1/2 ft dist the stake or
post having disappeared from
West on random bet secs 19nd and 30
Ba 21° East.

4000 Set temporary 1/4 sec. cor. ^{and} at
7560 Intersect N. bdy. Township
36 links S of cor to secs
19, 30, 24nd and 25. Thence
S 89° 44' E on true line
Ba. same.

1500 Lane Nnd and S 30 ft wide
3560 Set post 3 ft. long 3 ins square
24 ins in the ground
for 1/4 sec. cor. marked 1/4 S on
N. face dug pits 18 x 18 x 12 ins
End and N. of post 5 1/2 ft dist
raised mound of earth 1 1/2 ft.
high 3 1/2 ft base around it.

Subdivision of T. 4 North R. 85 East
Willamette Meridian, Oregon.

4910 House about 24 ft x 16 ft. one story.

5516 Fence N. and S.

5600 Wagon road, N. and S.

5697 E bank of Wild Horse creek

5737 in the wide end set post
4 ft long 4 ins square 24 ins
in the ground for Meander
cor. to fractional sees. 19 and 20
marked W.R.M.C. with
T 4 N on W
R 85 E S. 19 on N and
S 30 on S faces and dug a
pit 3 ft square 1 ft deep
2 ft W of post and raised mound
of earth 2 ft. high 4 1/2 ft. base
around it.

7560 Cor to sees 19, 20, 29 and 30

Land level

Soil 1st rate

All cultivated

Subdivision of T. 4 North R. 35 East

Willamette Meridian, Oregon.

(8093-10 M.)

South bet sees 29nd and 30

Q 21° E

2500

Enter orchard E and N.

3000

S bank of Wild Horse creek
10 lbs wide and set basal

stone 10 x 10 x 10 ins 7 ins in
the ground for Meander corner

to fractional sees 29nd and 30

marked W. R. M. C. on S

face and dug a pit 3 ft square
1 ft deep 8 lbs S. of stone and

raised mound of earth 2 ft.

high 4 1/2 ft. base over it.

3725

Fence and enter field

4000

Set post 9 ft long, 3 ins.

square 24 ins. in the

ground marked 1/4 S on N.

face, dug pits 18 x 18 x 12 ins

N. and S. of post 5 1/2 ft. dist.

raised mound of earth 1 1/2 ft

high 3 1/2 ft. base around it.

Subdivisions of T. 4 North R. 85 East
Willamette Meridian, Oregon.

8000

Set post 4 ft long 4 in square
 24 in in the ground for cor. to
 sec. 29, 30, 31 and 32, marked
 T. 4 N. S. 29 on N. E.
 R. 34 E. S. 32 on S. E.
 S. 31 on S. W. and S. 30 on N. E. faces
 with 1 notch on S and 5 notches
 on E edges, dug pits 18x18x12
 ins. in each sec. 5 1/2 ft diam
 and raised mound of earth
 2 ft high 4 1/2 ft base around it.
 Land rolling
 Soil 1st rate
 Mostly cultivated

East on ran. bet. sec 29 and 32
 on 20° East

8068

Set temporary cor.
 at 20.40 and 20 chains. And at
 Intersect E. bdy. 65 lbs
 S of cor to sec 28, 29, 32 and 33

Subdivisions of T. 41 North R. 85 East
Willamette Meridian, Oregon.

(8093-10 M.)

Thence S $89^{\circ}32'$ West on true line
Va 21° East

2910 A willow 6 ins diam on E bank
of wild Horse creek which I mark
W. R. M. C. with
T 4 N on E face
R 85 E S 29 on N. and
S 82 on S face for Mander
cor to fractional sec 29 and 82,

from which
A salm 16 ins diam. bears N 5° E 20 ft dist
marked W. R. M. C. B. T. S 29.
no other trees in limits and
raised mound of stam
alongside

4094 Set post 3 ft long 8 ins square
24 ins in the ground for $\frac{1}{4}$ sec,
cor marked $\frac{1}{4}$ S on N. face
dug pits 18 x 18 x 12 ins E and W,
of post 5 ft dist and raised mound
of earth 1 1/2 ft high 3 1/2 ft base over it

Subdivision of T. 4 North R. 35 East

Willamette Meridian, Oregon.

6057

Deposited charred stake 12 ins
 in the ground for $\frac{1}{16}$ sec.
 cor. dug pits 18 x 18 x 12 ins.
 E and W. of stake $5\frac{1}{2}$ ft. dist.
 raised mound of earth
 $1\frac{1}{2}$ ft high $3\frac{1}{2}$ ft. base
 over it and in E pit drove
 stake 2 ft. long 2 ins. square
 12 ins in the ground marked
 $\frac{1}{16}$ D on N. face

8068

Cor to sees 29, 30, 31 and 32

Land mostly level

Soil 1st rate

Cultivated

Went on random bet sees 30 and 31
 Va 20 East

Set Temporary ... (cor.)
 at 20, 40 and 60 chains and at

7590

Intersect W. bdy. Township
 32 N. S. of cor to see 30, 31, 25 and 36

Subdivision of T. 4 North R. 35 East
Willamette Meridian, Oregon.

(8093-10 M.)

Thence S 79° 46' E on true line
bet Secs 30 & 31 Pa 19 3/4 East

1440

Wagon road N. and S.

1590

Deposited charred stake
12 ins in the ground
for 1/4 sec. cor. dug pits
18 x 18 x 12 ins E and N. of stake
5 1/2 ft. diam. raised mound
of earth 1 1/2 ft. high 3 1/2 ft
base over it and in E pit
drove stake 2 ft. long 2 ins
square 12 ins in the ground
marked 1/4 S on N. face

33-90

Deposited charred stake
12 ins in the ground for 1/4 sec
cor. dug pits 18 x 18 x 12 ins. E and N.
of stake 5 1/2 ft diam raised mound
of earth 1 1/2 ft high 3 1/2 ft base
over it and in E pit drove stake
2 ft. long. 2 ins square. 12 ins.
in the ground marked 1/4 S on N. face

Subdivision of T. 4 North R. 35 East
Willamette Meridian, Oregon.

- 5340 Hayon road in law N^{and} S.
- 5590 Deposited charred stake 12 ins in the ground for $\frac{1}{6}$ sec. cor. dug pits 18x18x12 ins. E^{and} H of stake 5 $\frac{1}{2}$ ft. dist raised mound of earth 1 $\frac{1}{2}$ ft. high. 3 $\frac{1}{2}$ ft. base over it^{and} in E^{and} pit drove stake 2 ft. long, 2 ins square 12 ins. in the ground marks $\frac{1}{6}$ S. on N. face.
- 7590 Cor to sec 29, 30, 25^{and} 36
Land level or slightly rolling
Soil 1st rate
All cultivated

South on true line between 31^{and} 32
R. 20 East

- 2000 Deposited charred stake 12 ins in the ground for $\frac{1}{6}$ sec. cor. dug pits 18x18x12 ins N^{and} S of stake 5 $\frac{1}{2}$ ft. dist raised mound of earth 1 $\frac{1}{2}$ ft. high 3 $\frac{1}{2}$ ft. base over it^{and} in N^{and} pit drove stake 2 ft. long 2 ins square 12 ins in the ground

Subdivisions of T. 4 North R. 95 East
Willamette Meridian, Oregon.

(8093-10 M.)

- marked $\frac{1}{6}$ D. on N. face.
- 2050 Fence & field E. end N.
- 4000 Deposited charred stake 12 ins. in the ground for $\frac{1}{4}$ sec. cor. dug pits $18 \times 18 \times 12$ ins N. and S. of stake $5\frac{1}{2}$ ft. dist. raised mound of earth $1\frac{1}{2}$ ft. high $3\frac{1}{2}$ ft. base over it. And in N. pit drove stake 2 ft. long 2 ins. square 12 ins in the ground marked $\frac{1}{4}$ D. on N. face.
- 6000 Deposited charred stake 12 ins. in the ground for $\frac{1}{4}$ sec. cor. dug pits $18 \times 18 \times 12$ ins N. and S. of stake $5\frac{1}{2}$ ft. dist. raised mound of earth $1\frac{1}{2}$ ft. high $3\frac{1}{2}$ ft. base over it. And in N. pit drove stake 2 ft. long 2 ins. square 12 ins in the ground marked $\frac{1}{6}$ D. on N. face.
- 7920 Intersect S. bdy of Township 123 N. of cor to secs 5 and 6 T. 3 N. R. 35 E. and for post

Subdivision of T. 4 North R. 35 East
Willamette Meridian, Oregon.

4 ft. long 4 ins square 24 ins in ground
for closing cor to sees 31 and 32. marked
C. C. T 4 N on N
R 35 E S 32 on E and S 31 on W.
faces with 5 notches on E and 1
notch on W. edges, dug pits
18 x 18 x 12 ins N. E and W of cor
5 1/2 ft. dist. raised mound of earth
2 ft. high 4 1/2 ft base around it.
Land mostly level
Soil 1st rate partly cultivated

Commencing at cor to sees 28, 29, 32 & 33
which is charred stake 12 ins in the
ground and pits in each see 5 1/2 ft. dist
almost obliterated + Iron
South ^{on true line} bet sees 32 and 33
Va 21° East

4000 no sign of old 1/4 sec. cor. and owing
to the land being cultivated and outside
reservation I did not establish one

Subdivision of T. 4 North R. 35 East

Willamette Meridian, Oregon.

(8093-10 M.)

5700 Set post 4 ft. long 4 ins square
24 ins in the ground on S bank
of the Wild Horse creek for
Meander cor to fractional sec
32 and 33 marked W.R.M.C.
with T 4 N on S
R 35 E S 33 on E and S 32 on N
face. dug a pit 3 ft. square 1 ft.
deep S. W. of post and raised
mound of earth 2 ft. high 4 1/2
ft. base around post.

6000 Dep. on the charged stake 12 ins in
the ground for 1/6 sec cor.
dug pits 18 x 18 x 12 ins N. and S.
of stake 5 1/2 ft. dist raised
mound of earth 1 1/2 ft. high
3 1/2 ft. base over it and in
N. pit drove stake 2 ft. long
2 ins square 12 ins in the
ground marked 1/6 S.
on N. face.

Subdivision of T. 4 North R. 35 East
Willamette Meridian, Oregon.

7950

Wagon road and lane
E. and W.

7980

Intersect S. bdy. Township
24 lbs W of cor. to sees
4 and 5 T. 3 N. R. 35 East.
And set post 4 ft long 4 ins
square 24 ins in the ground
for closing cor. to sees
32 and 38 marked
C.C. T 4 N R 35 E on N.
D 33 on E and D 32 on W face
with 4 notches on E and 2 notches
on W. face dug pits
18 x 18 x 12 ins N. E and W
of stake 5 ft dist and
raised mound of earth
2 ft high 4 1/2 ft. base around it.
Land mostly level
Soil 1st rate
Mostly cultivated
Aug. 17th 1887.

Subdivision of T. 4 North R. 35 East -
 Willamette Meridian, Oregon.

(8093-10 M.)

General Description

This township is raising
 The Soil is a rich loam
 Sandy on higher ground &
 very black & rich along the
 wild horse. Producing fine
 grain fruit & vegetables &
 Scattering Callamwood along
 the wild horse with Thick Thorn
 & willow underbrush

Subdivision of T. 4 North R. 35 East
 Willamette Meridian, Oregon.

In accordance with
 the requirements of the manual
 of surveys we have carefully
 tested the adjustment of our
 instruments by taking the latitude
 daily weather permitting during the
 progress of the surveys repres-
 ented in the foregoing field notes
 and in ^{all} cases they ^{were} found to be
 in correct-adjustment-

James P. Currier
 James E. Roland
 U. S. Deputy Surveyors

PAGES 164 & 165 ARE BLANK.

FINAL OATHS FOR SURVEYS.

A list of the names of the individuals employed by 166 Jas P. Currin and E. Noland, U. S. Deputy Surveyor, to assist in running, measuring, and marking the lines and corners described in the foregoing field notes of the survey of the Subdivisional lines of T 34 N R 33 E and T 4 N. Rgs 34 and 35 E. Willamette Meridian, Oregon, showing the respective capacities in which they acted:

-, Compassman.
- J. S. Medley....., Chairman.
- W. H. Medley....., Chairman.
- Frank Belshaw....., Chairman.
- Guy Davis....., Chairman.
- B. B. Cramer....., Axman.
- J. R. Hadley....., Axman.
-, Flagman.

FINAL OATHS OF ASSISTANTS.

We hereby certify that we assisted Jas P. Currin and Jas. Noland, U. S. Deputy Surveyor, in surveying all those parts or portions of the Subdivisional lines of T 34 N. R. 33 E. and T 4 N. Rgs. 34 and 35 E. Willamette Meridian, Oregon, as represented in the foregoing field notes as having been surveyed by him and under his direction; and that said survey has been in all respects, to the best of our knowledge and belief, well and faithfully surveyed, and the corner monuments established, according to the instructions furnished by the U. S. Surveyor General of Oregon.

-, Compassman.
- J. S. Medley....., Chairman.
- W. H. Medley....., Chairman.
- Frank Belshaw....., Chairman.
- Guy Davis....., Chairman.
- B. B. Cramer....., Axman.
- J. R. Hadley....., Axman.
-, Flagman.

Subscribed and sworn to before me this 17th day of August, 1887.

[SEAL.]

James P. Currin
U. S. Deputy Surveyor

FINAL OATH OF DEPUTY SURVEYOR.

Mr. Jas. P. Furrin and Jas. E. Holand, United States
Deputy Surveyor, do solemnly swear that in pursuance of instructions
received from *Douglas H. Taylor*, U. S.
Surveyor General for Oregon, bearing date of the *13th*

day of *May*, 188*7*. We have well, faithfully,
and truly, in ^{our} my own proper person, and in strict conformity with the
instructions furnished by the U. S. Surveyor General for Oregon, the
Surveying Manual, and the laws of the United States, surveying all

those parts or portions of *T. 3 N. R. 33 E. and*
Townships 4 N. Ranges 34 and 35 East

Willamette Meridian, in the State of Oregon, as are represented in the
foregoing field notes as having been surveyed by me and under my
directions; and I do further solemnly swear that all the corners of said
survey have been established and perpetuated in strict accordance with
the Surveying Manual, printed instructions, the special written instruc-
tions of the U. S. Surveyor General for Oregon, and in the specific man-
ner described in the field notes, and that the foregoing are the *true* field
notes of such survey, and should any fraud be detected I will suffer the
penalty of perjury under the provisions of an act of Congress approved
August 8, 1846.

James P. Furrin
James E. Holand

U. S. Deputy Surveyors.

Subscribed and sworn to before me this *Fifteenth*
day of *February*, 188*8*.

A. C. Woodcock
Notary Public
for Oregon

Office of U. S. Surveyor General,

Portland, Oregon, August 8th, 1888.

The ^{foregoing} following Field Notes of the Survey of the
 Subdivisional lines of Township
 3. N. R. 33 E. and T. 4 N. R.
 34 and 35 E. Will Mar Oregon
 executed by James J. Currier and James E. Holand,
 Special Joint U. S. Dept Surveyors
 under his Contract No. —, dated May
 4th, 1887, having been critically examined,
 the necessary corrections and explanations made, the
 said Field Notes and the survey they describe, are
 hereby approved.

Douglas W. Taylor.

Surveyor General.