

FIELD NOTES

Of the survey of the Sub-Subdivisional

Lines of Tps. 3rd & 4th N. Rgs 34th & 35th E.

T 4th N. R 35th E.

Willamette Meridian,

Oregon, as surveyed by Jas. P. Carrin & Jas. C. Holland

U. S. Deputy Surveyor, under ^{their} his Contract No. _____

dated May 4th 1887

Survey commenced, Oct 4th 1887

Survey completed, Oct 13th 1887

NAMES AND DUTIES OF ASSISTANTS.

L. A. Woolley _____, **Compassman.**

E. G. Perry _____, **Chainman.**

Guy Davis _____, **Chainman.**

J. R. Hadley _____, **Chainman.**

W. S. Raper _____, **Chainman.**

J. W. Herndon _____, **Axeman.**

C. Moses _____, **Axeman.**

_____, **Flagman.**

PRELIMINARY OATHS OF ASSISTANTS.

We, E. Perry, Guy Davis
J. R. Hadley, C. S. Raper

do solemnly swear that we will faithfully execute the duties of Chain Carriers, that we will level the chain over even and uneven ground, and plumb the tally pins, either by sticking or dropping the same; that we will report the true distance to all notable objects, and the true length of all lines that we will assist in measuring, to the best of our skill and ability, and in accordance with the instructions given us in

the survey of the Sub. Sub. divisions
lines of T 3 7 4 N R 3 4 E

and T 4 N R 3 5 E, Willamette Meridian, Oregon.

- E. Perry, Chainman.
- Guy Davis, Chainman.
- J. R. Hadley, Chainman.
- C. S. Raper, Chainman.

Subscribed and sworn to before me, this 4th

day of Oct 1887

[SEAL.] James P. Currin
U. S. Deputy Surveyor

We, C. Moses and
J. W. Herndon

do solemnly swear that we will well and truly perform the duties of Axemen in the establishment of corners and other duties, according to instructions given us, and to the best of our skill and ability, in the survey of the

Sub. Sub. divisions of
T 3 7 4 N R 3 4 E, and T 4 N R 3 5 E, Willamette Meridian, Oregon.

- C. Moses, Axeman.
- J. W. Herndon, Axeman.

Subscribed and sworn to before me, this Fourth


day of October 1887

[SEAL.] James P. Currin
U. S. Deputy Surveyor

INDEX

Referring the Lines to the Pages of the Field Notes.

T. N3 North R. 34 East Will. Mer.

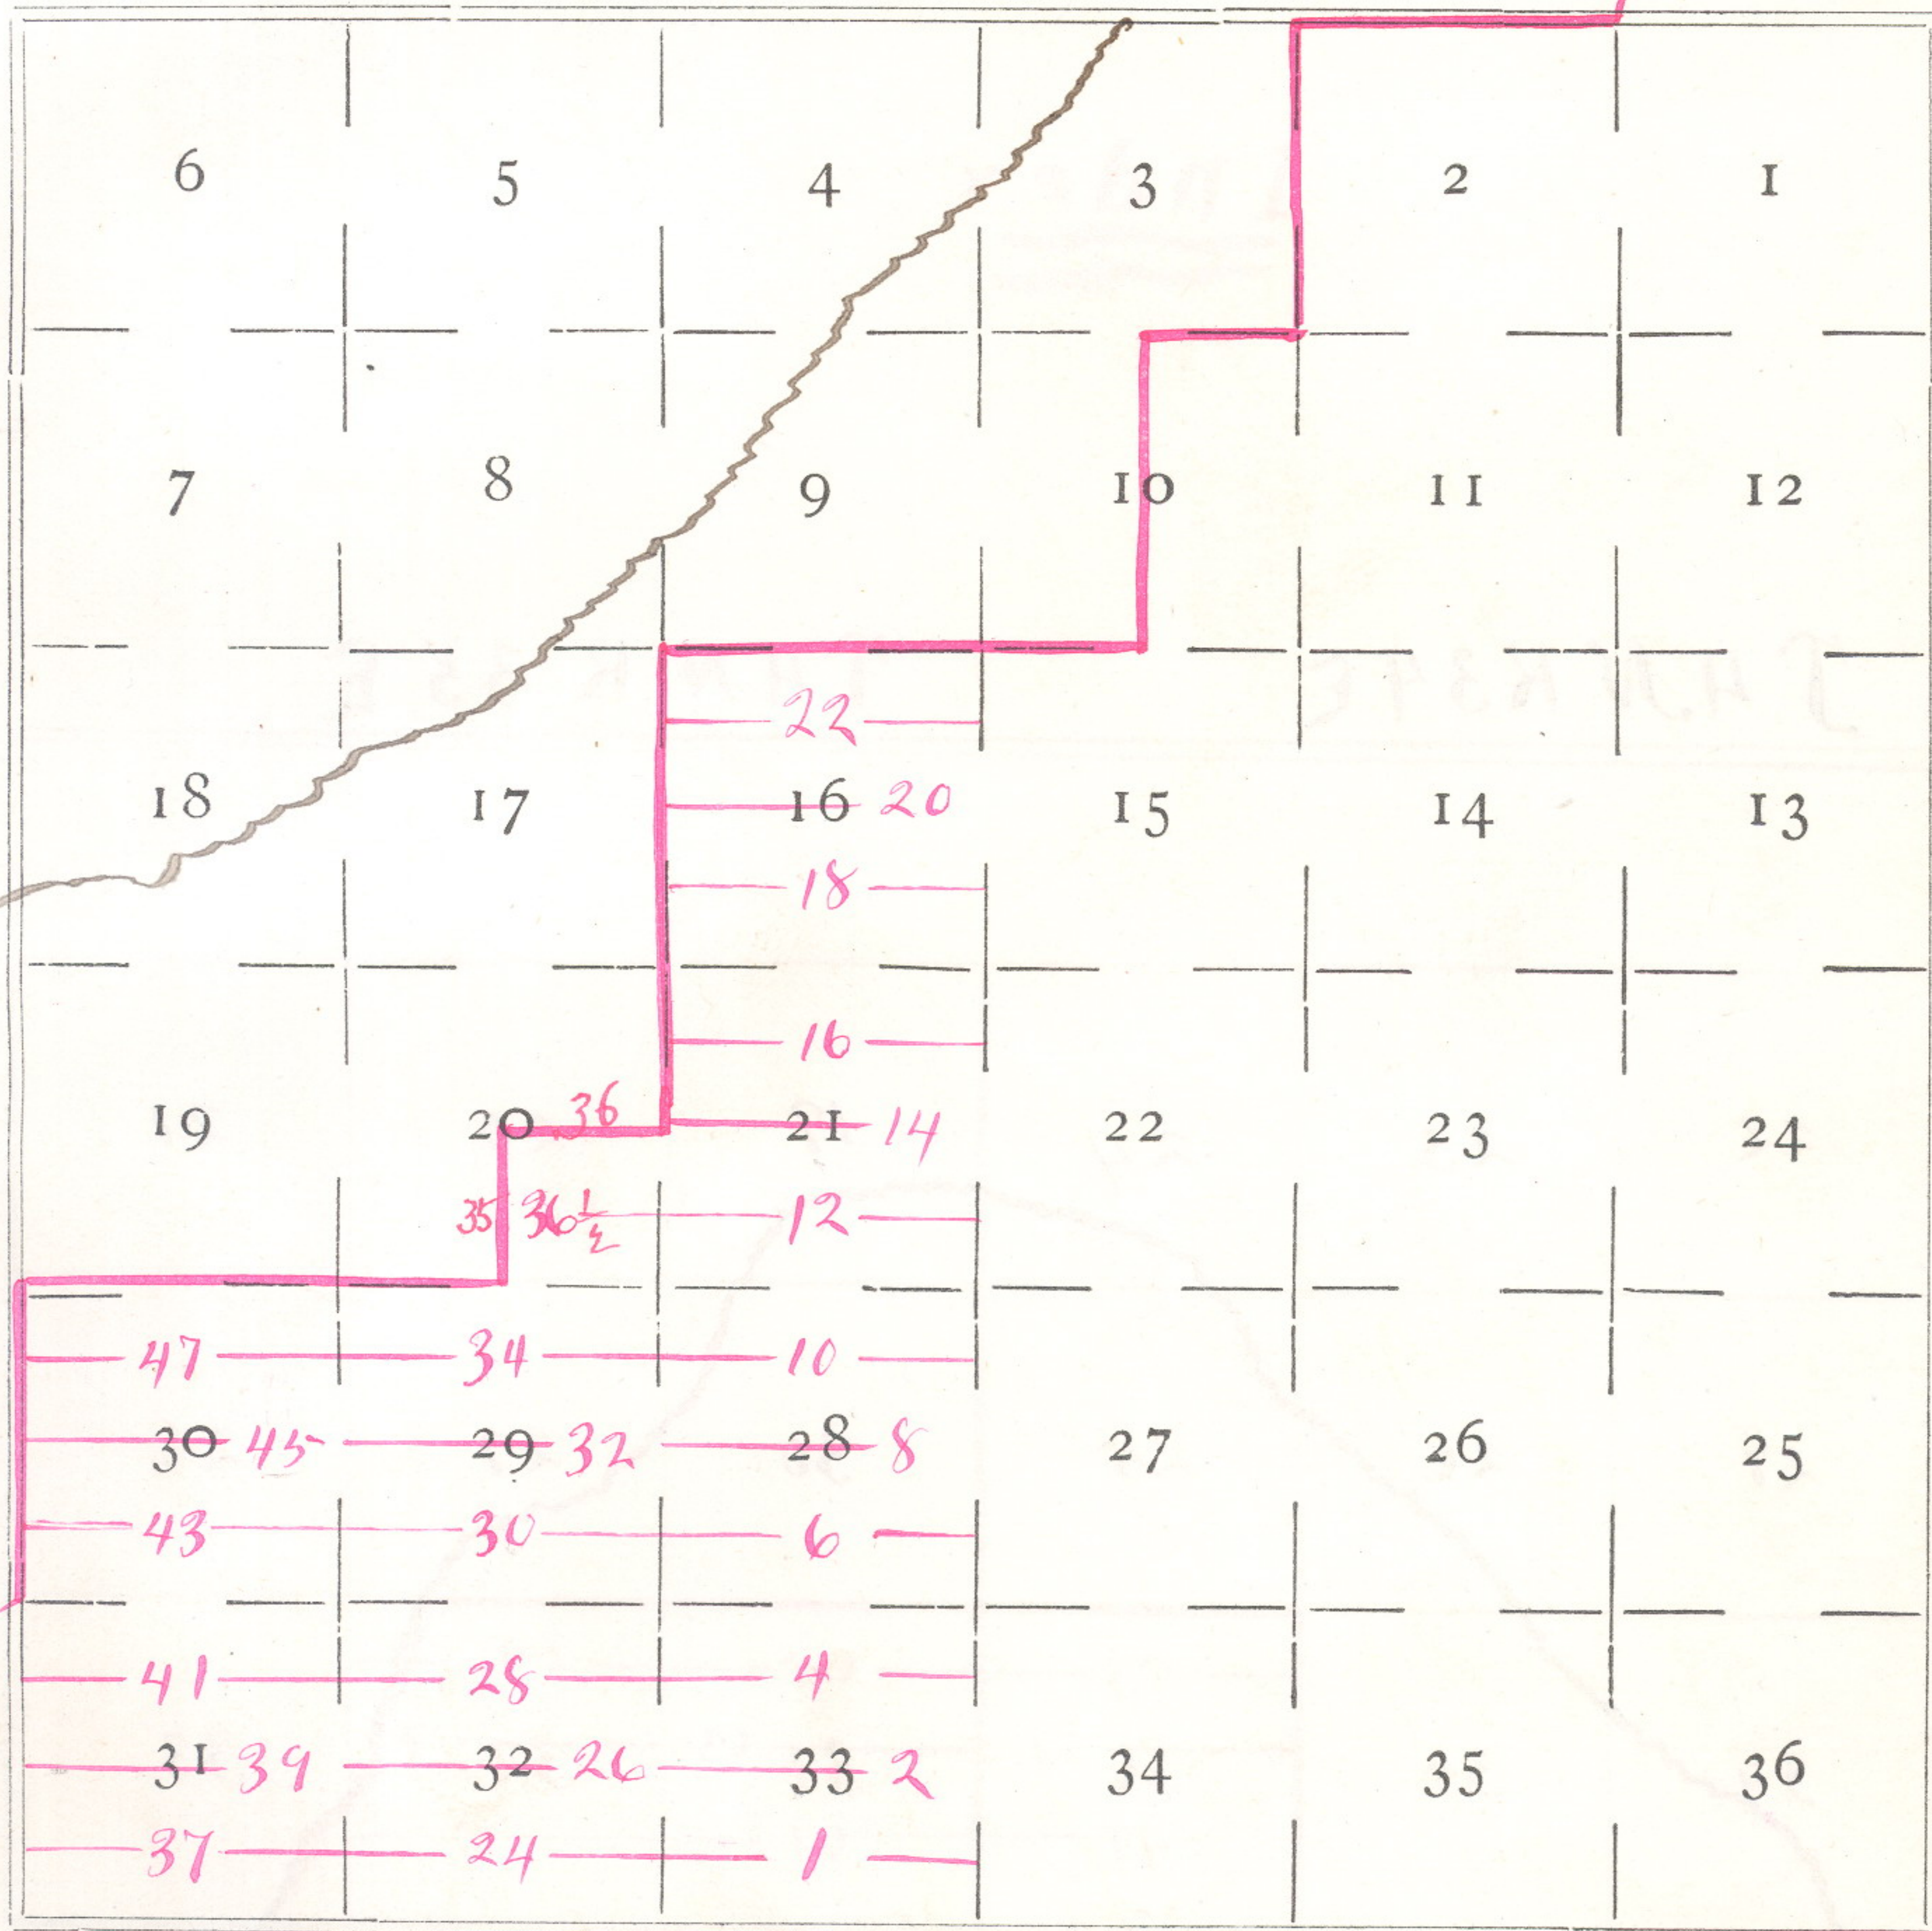

Meanders of _____ Pages _____ to _____

Meanders of _____ Pages _____ to _____

428 429 430


INDEX

Referring the Lines to the Pages of the Field Notes

Index

T4NR34E

T4NR35E

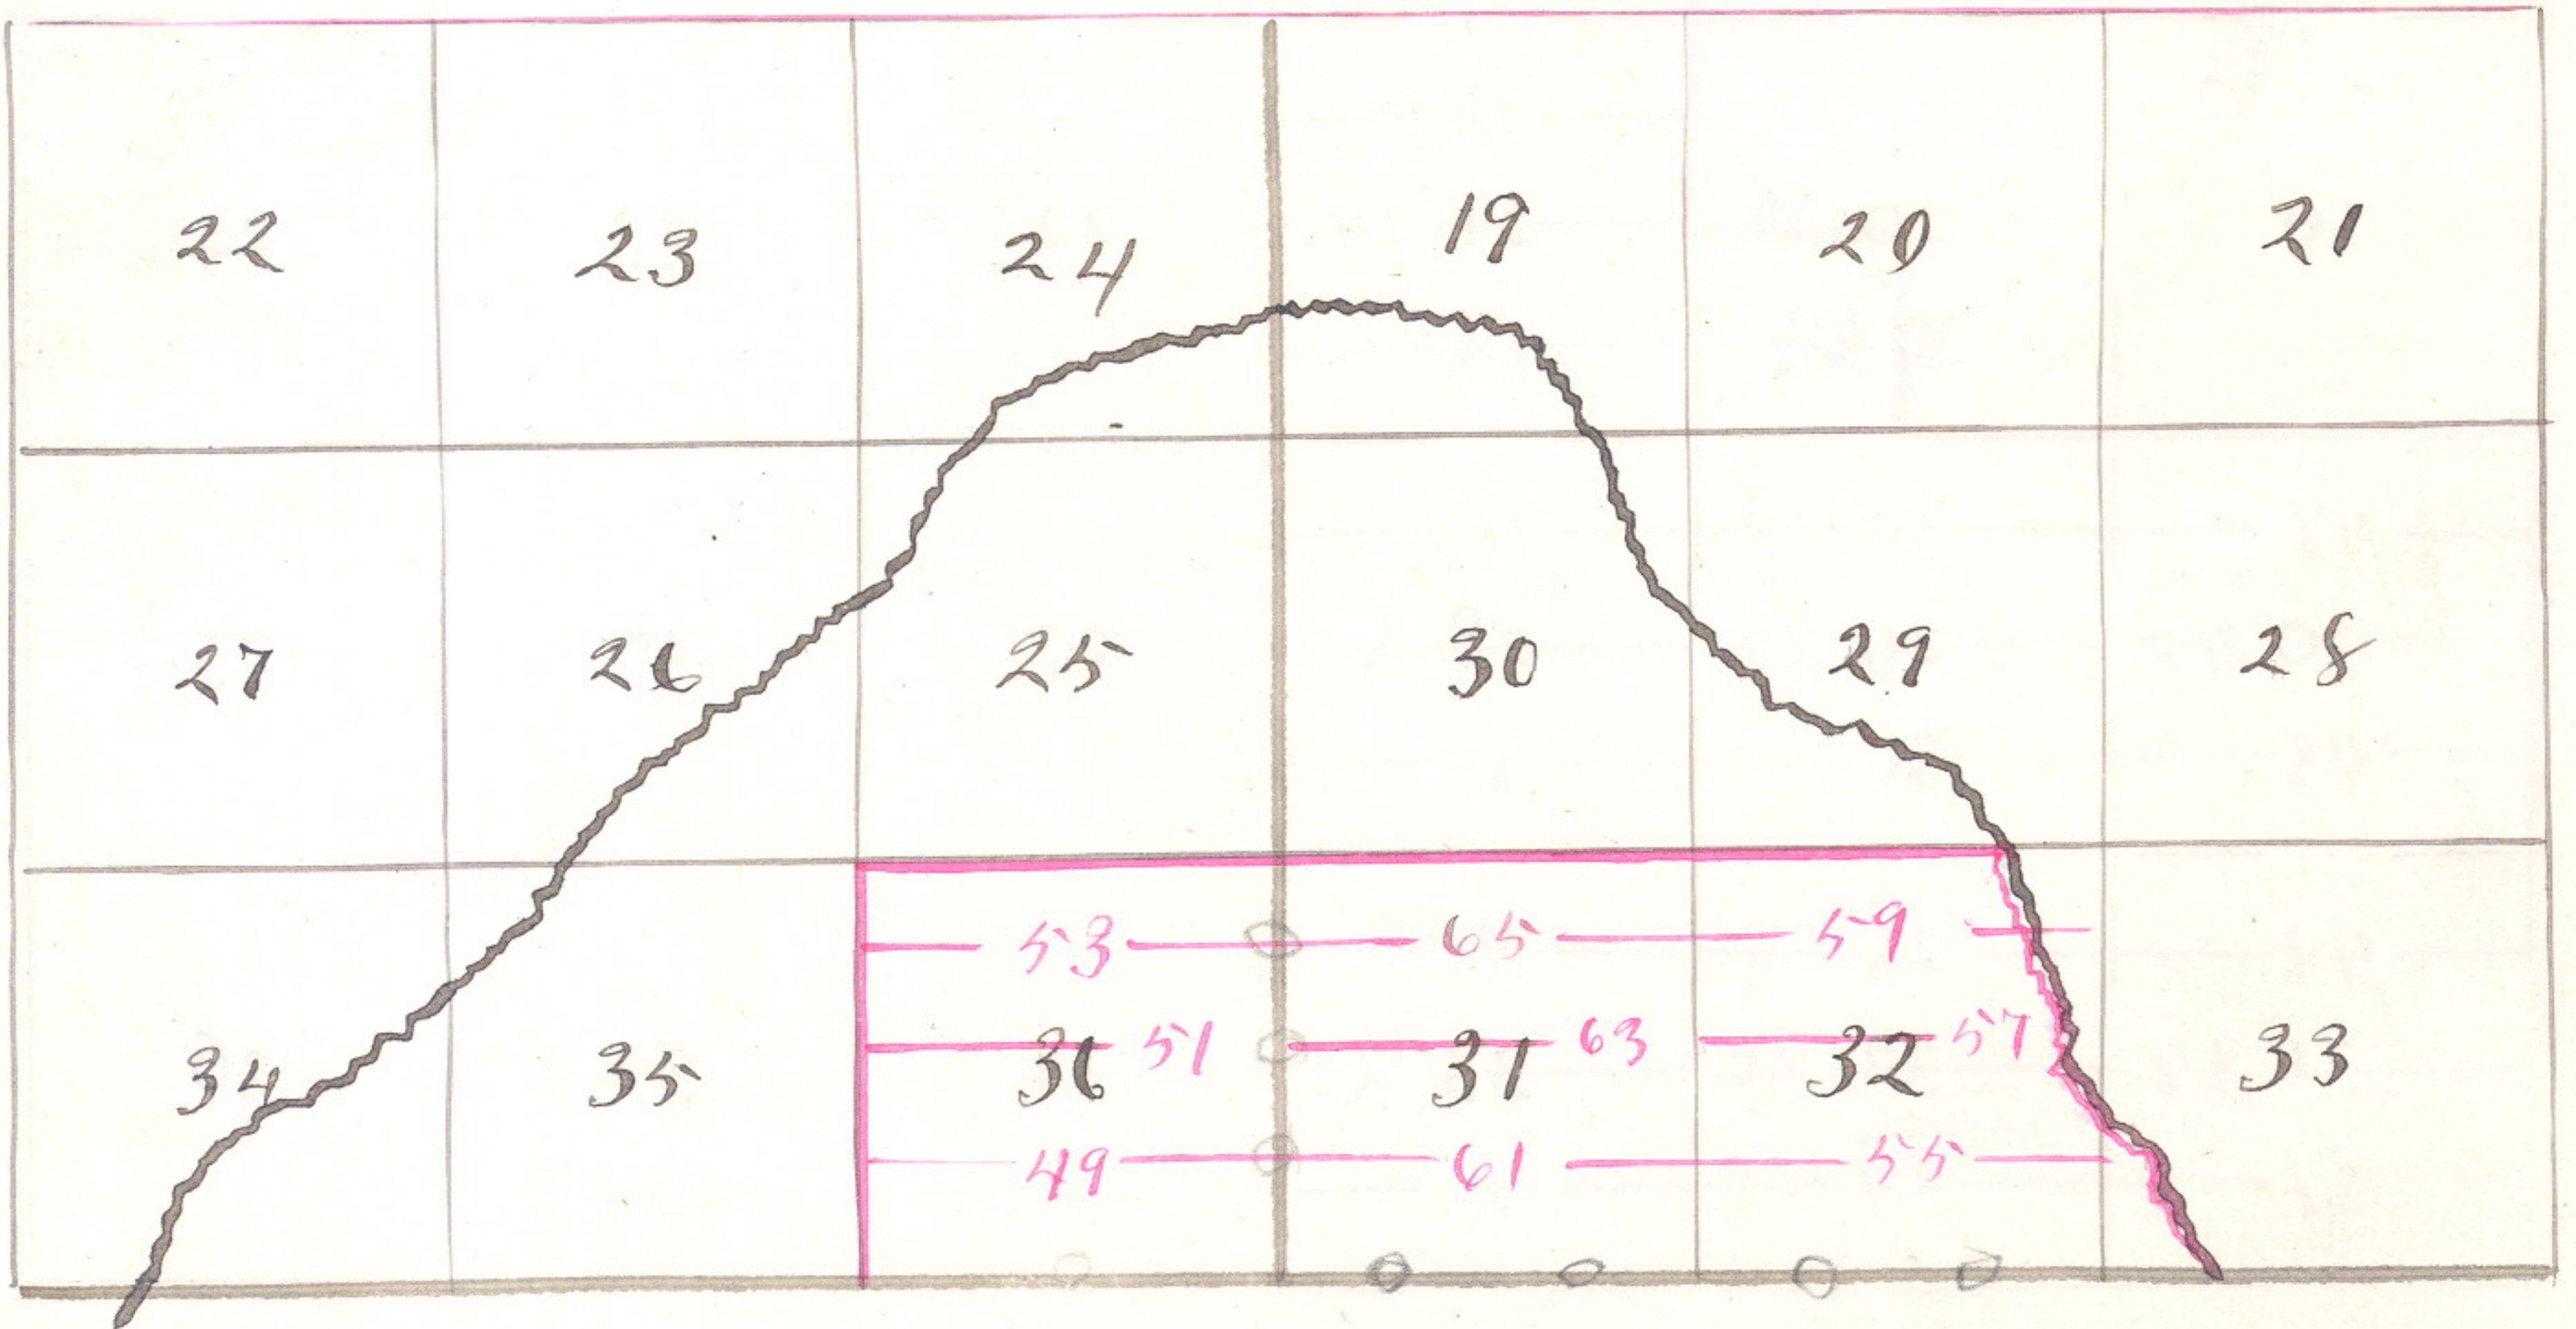

Sub Division of T. 4 North R. 34 East
 Willamette Meridian, Oregon.

Survey commenced October 13th 1887

East on random through
 S¹/₂ of sec 36 T. 4 N. R. 34 East
 Va 20° East

terminating at $\frac{1}{4}$ sec. cor. 20
 chains S of $\frac{1}{4}$ sec. cor. bet sec
 35 and 36. Set temporary $\frac{1}{4}$ sec.
 cor. at 20, 40 and 60 chains and at

8012 Intersect Eddy Township,
 80 ch. N. of $\frac{1}{4}$ sec. cor. Thence
 N. 89° 24' W. on true line

2012 Opposited charred stake 12 ins
 in the ground for $\frac{1}{4}$ sec. cor.
 dug pits 11 x 11 x 12 ins E. and W.
 of stake $5\frac{1}{2}$ ft dist raised
 mound of earth $1\frac{1}{2}$ ft high
 $3\frac{1}{2}$ ft base over it and in
 E. pin drove stake 2 ft long
 2 ins square 12 ins in the
 ground marked $\frac{1}{4}$ S on
 N. face

3970 Fence & leave field N. and S.

Sub Subdivision of T. ⁴ 3 North R: 34 East
 Willamette Meridian, Oregon.

(8093-10 M.)

4012 Deposited charred stake 12
 ins in the ground for $\frac{1}{4}$
 Sec. cor. dug pits 18x18x12
 ins E. and W. of stake
 5 $\frac{1}{2}$ ft. dist. raised mound
 of earth 1 $\frac{1}{2}$ ft. high, 3 $\frac{1}{2}$ ft.
 base over it and in E
 pit drove stake 2 ft long
 2 ins square, 12 ins in the
 ground marked $\frac{1}{4}$ S.
 on N. face

5000 Wagon road bears N. & S.

6012 Deposited charred stake 12 ins
 in the ground for $\frac{1}{4}$ sec. cor. dug
 pits 18x18x12 ins E. and W. of stake
 5 $\frac{1}{2}$ ft ^{distant} high raised mound
 of earth 1 $\frac{1}{2}$ ft high 3 $\frac{1}{2}$ ft
 base over it and in E. pit
 drove stake 2 ft long 2 ins
 square 12 ins in the ground marked $\frac{1}{4}$ S. on
 N. face

8012 To point of beginning. Land level
 Soil 1 $\frac{1}{2}$ rate partly cultivated

Sub-Subdivision of T. 4 North R. 34 East 483
Willamette Meridian, Oregon.

East on random through
Center of sec. 36
Va 20 1/4 East

Commencing at 1/4 sec. cor. bet
secs 35 and 36. Set temporary
corners at 20, 40 and
60 chains and at

8022 Intersect E. bdy of Township
10 kts N. of 1/4 sec. cor. Thence
N 89° 30' West on true line

57 fence & enter field N. and S.

2022 Deposited charred stake 12 ins
in the ground for 1/4 sec cor.
dug pits 18 x 18 x 12 ins E. and W.
of stake 5 1/2 ft dist. raised
mound of earth 1 1/2 ft high
3 1/2 ft base over it and in
E. side drove stake 2 ft long
2 ins square 12 ins in the
ground marked 1/4 Sec. N. face

4022 Deposited charred stake

Subdivisions of T. 4 North R. 34 East
Willamette Meridian, Oregon.

(8093-10 M.)

12 ins in the ground for
1/4 sec. cor, dug pits 18x18x12
ins Q. and N. of stake 5 1/2 ft.
dist. raised a mound of earth 1 1/2 ft. high
3 1/2 ft. base over it
Q. and in Q. pin drove stake
2 ft long 2 ins square
12 ins in the ground marked
1/4 S on N. face

4050 Fence at N. W. cor of field

6022 Deposited charred stake 12 ins
in the ground for 1/4 sec. cor,
dug pits 18x18x12 ins Q. and N.
of stake 5 1/2 ft dist. raised
mound of earth 1 1/2 ft high
3 1/2 ft. base over it Q. and in
Q. pin drove stake 2 ft long
2 ins square 12 ins in the
ground marked 1/4 S on N. face

8022 To point of beginning
land slightly rolling
Soil good. partly cultivated

Subdivision of T. 4 North R. 34 East 485

Willamette Meridian, Oregon.

(18 01-550)

East on random through
N. 1/2 of sec 36 Va. 20° East

Commencing at 1/6 sec. cor. 20
chains N. of 1/4 sec. cor. bet
secs 35 and 36 Set temporary
corners at 20.40 and 60 chains
and at

8035 Intersect E. bdy. 75 lbs. N.
of 1/6 sec. cor. Thence
North 89° 28' West on true line

2085 Opposite chaired stake 12 ins
in the ground for 1/6 sec. cor.
dug pits 18 x 18 x 12 ins E. and W.
of stake 5 1/2 ft diam. raised
mound of earth 1 1/2 ft high
3 1/2 ft base over it and in E
pit drove stake 2 ft long 2 ins
square 12 ins in the ground
marked 1/6 S. on N. face

3990 Fence N. and S.

54

486

Subdivision of T. 4 North R. 34 East

Willamette Meridian, Oregon.

(8093-10 M.)

4035 Deposited charred stake 12 ins
in the ground for $\frac{1}{6}$ sec. cor.
dug pits 18 x 18 x 12 ins Quid H.
of stake 5 $\frac{1}{2}$ ft dia raised
mound of earth 1 $\frac{1}{2}$ ft high
3 $\frac{1}{2}$ ft base over it and in
fir drove stake 2 ft long
2 ins square 12 ins in the
ground, marked $\frac{1}{6}$ S.
on N. face

6035 Deposited charred stake 12 ins
in the ground for $\frac{1}{6}$ sec. cor.
dug pits 18 x 18 x 12 ins Quid H.
of stake 5 $\frac{1}{2}$ ft dia raised
mound of earth 1 $\frac{1}{2}$ ft high
3 $\frac{1}{2}$ ft base over it and in
Q. fir drove stake 2 ft long
2 ins square 12 ins in the
ground marked $\frac{1}{6}$ Sou N. face

8035 To point of beginning
Land rolling Soil good

FINAL OATHS FOR SURVEYS.

A list of the names of the individuals employed by James P. Currier
and Jas. E. Toland, U. S. Deputy Surveyor, to assist in
running, measuring and marking the lines and corners described in the foregoing field
notes of the survey of the Sub-Subdivisional lines
of Tps 3 and 4 North R 34 East and
T. 4 N. R. 35 East Willamette Meridian, Oregon,
showing the respective capacities in which they acted:

- L. D. Wooley -----, **Compassman.**
- E. G. Perry -----, **Chainman.**
- Guy Davis -----, **Chainman.**
- J. R. Hadley -----, **Chainman.**
- C. L. Raper -----, **Chainman.**
- C. Moses -----, **Axeman.**
- J. W. Herndon -----, **Axeman.**
- , **Flagman.**

FINAL OATHS OF ASSISTANTS.

We hereby certify that we assisted James P. Currier and
Jas. E. Toland, U. S. Deputy Surveyor, in surveying all
those parts or portions of the Sub-Subdivisional lines
of Tps 3 and 4 N R 34 E and
T 4 N R 35 E Willamette Meridian, Oregon,
as are represented in the foregoing field notes as having been surveyed by him and under
his direction; and that said survey has been in all respects, to the best of our knowledge
and belief, well and faithfully surveyed, and the corner monuments established, according
to the instructions furnished by the U. S. Surveyor General of Oregon.

- L. D. Wooley -----, **Compassman.**
- E. G. Perry -----, **Chainman.**
- Guy Davis -----, **Chainman.**
- J. R. Hadley -----, **Chainman.**
- C. L. Raper -----, **Chainman.**
- C. Moses -----, **Axeman.**
- J. W. Herndon -----, **Axeman.**
- , **Flagman.**

Subscribed and sworn to before me, this 13th day of

October 1887

[SEAL.]

James P. Currier
U. S. Deputy Surveyor

FINAL OATH OF DEPUTY SURVEYOR.

Mr James P. Currier and Jos E. Holand
United States Deputy Surveyor, do solemnly swear that in pursuance of

instructions received from *Congress W Taylor*

U. S. Surveyor General for Oregon, bearing date of the *20th*

day of *August* 188*7*, I have well, faith-

fully and truly, in ~~my~~ ^{the} own proper person, and in strict conformity with the instructions furnished by the U. S. Surveyor General for Oregon, the Surveying Manual, and the laws of the United States, surveying all those

parts or portions of *Tps 3 and 4 N.R. 34 E.*
and T 4 N.R. 35 E.

Willamette Meridian, in the State of Oregon, as are represented in the foregoing field notes as having been surveyed by me and under my directions; and I do further solemnly swear that all the corners of said survey have been established and perpetuated in strict accordance with the Surveying Manual, printed instructions, the special written instructions of the U. S. Surveyor General for Oregon, and in the specific manner described in the field notes, and that the foregoing are the *true* field notes of such survey, and should any fraud be detected I will suffer the penalty of perjury under the provisions of an Act of Congress approved August 8, 1846.

James P. Currier

James E. Holand U. S. Deputy Surveyor.

Subscribed and sworn to before me, this *15th*

day of *March* 188*8*

A. B. Woodcock
Notary Public
for Oregon

Office U. S. Surveyor General,

Portland, Oregon, *August 10* 1888.

concerning
The following Field Notes of the Survey of the *Sub-*

Subdivisional lines of Tps 3 & 4
N. R. 34 E. & Tp 4 N. R. 35
E. Will Mer Oregon

executed by *James P. Currier and James E. Nolan*
Special Agents, U. S. Dept. Surveyors
under ~~his~~ Contract No. _____, dated *May*

4th 1887, having been critically examined, the
necessary corrections and explanations made, the said Field Notes
and the survey they describe, are hereby approved.

Douglas W. Taylor.
Surveyor General.