


Township 4N R. 34E

20A

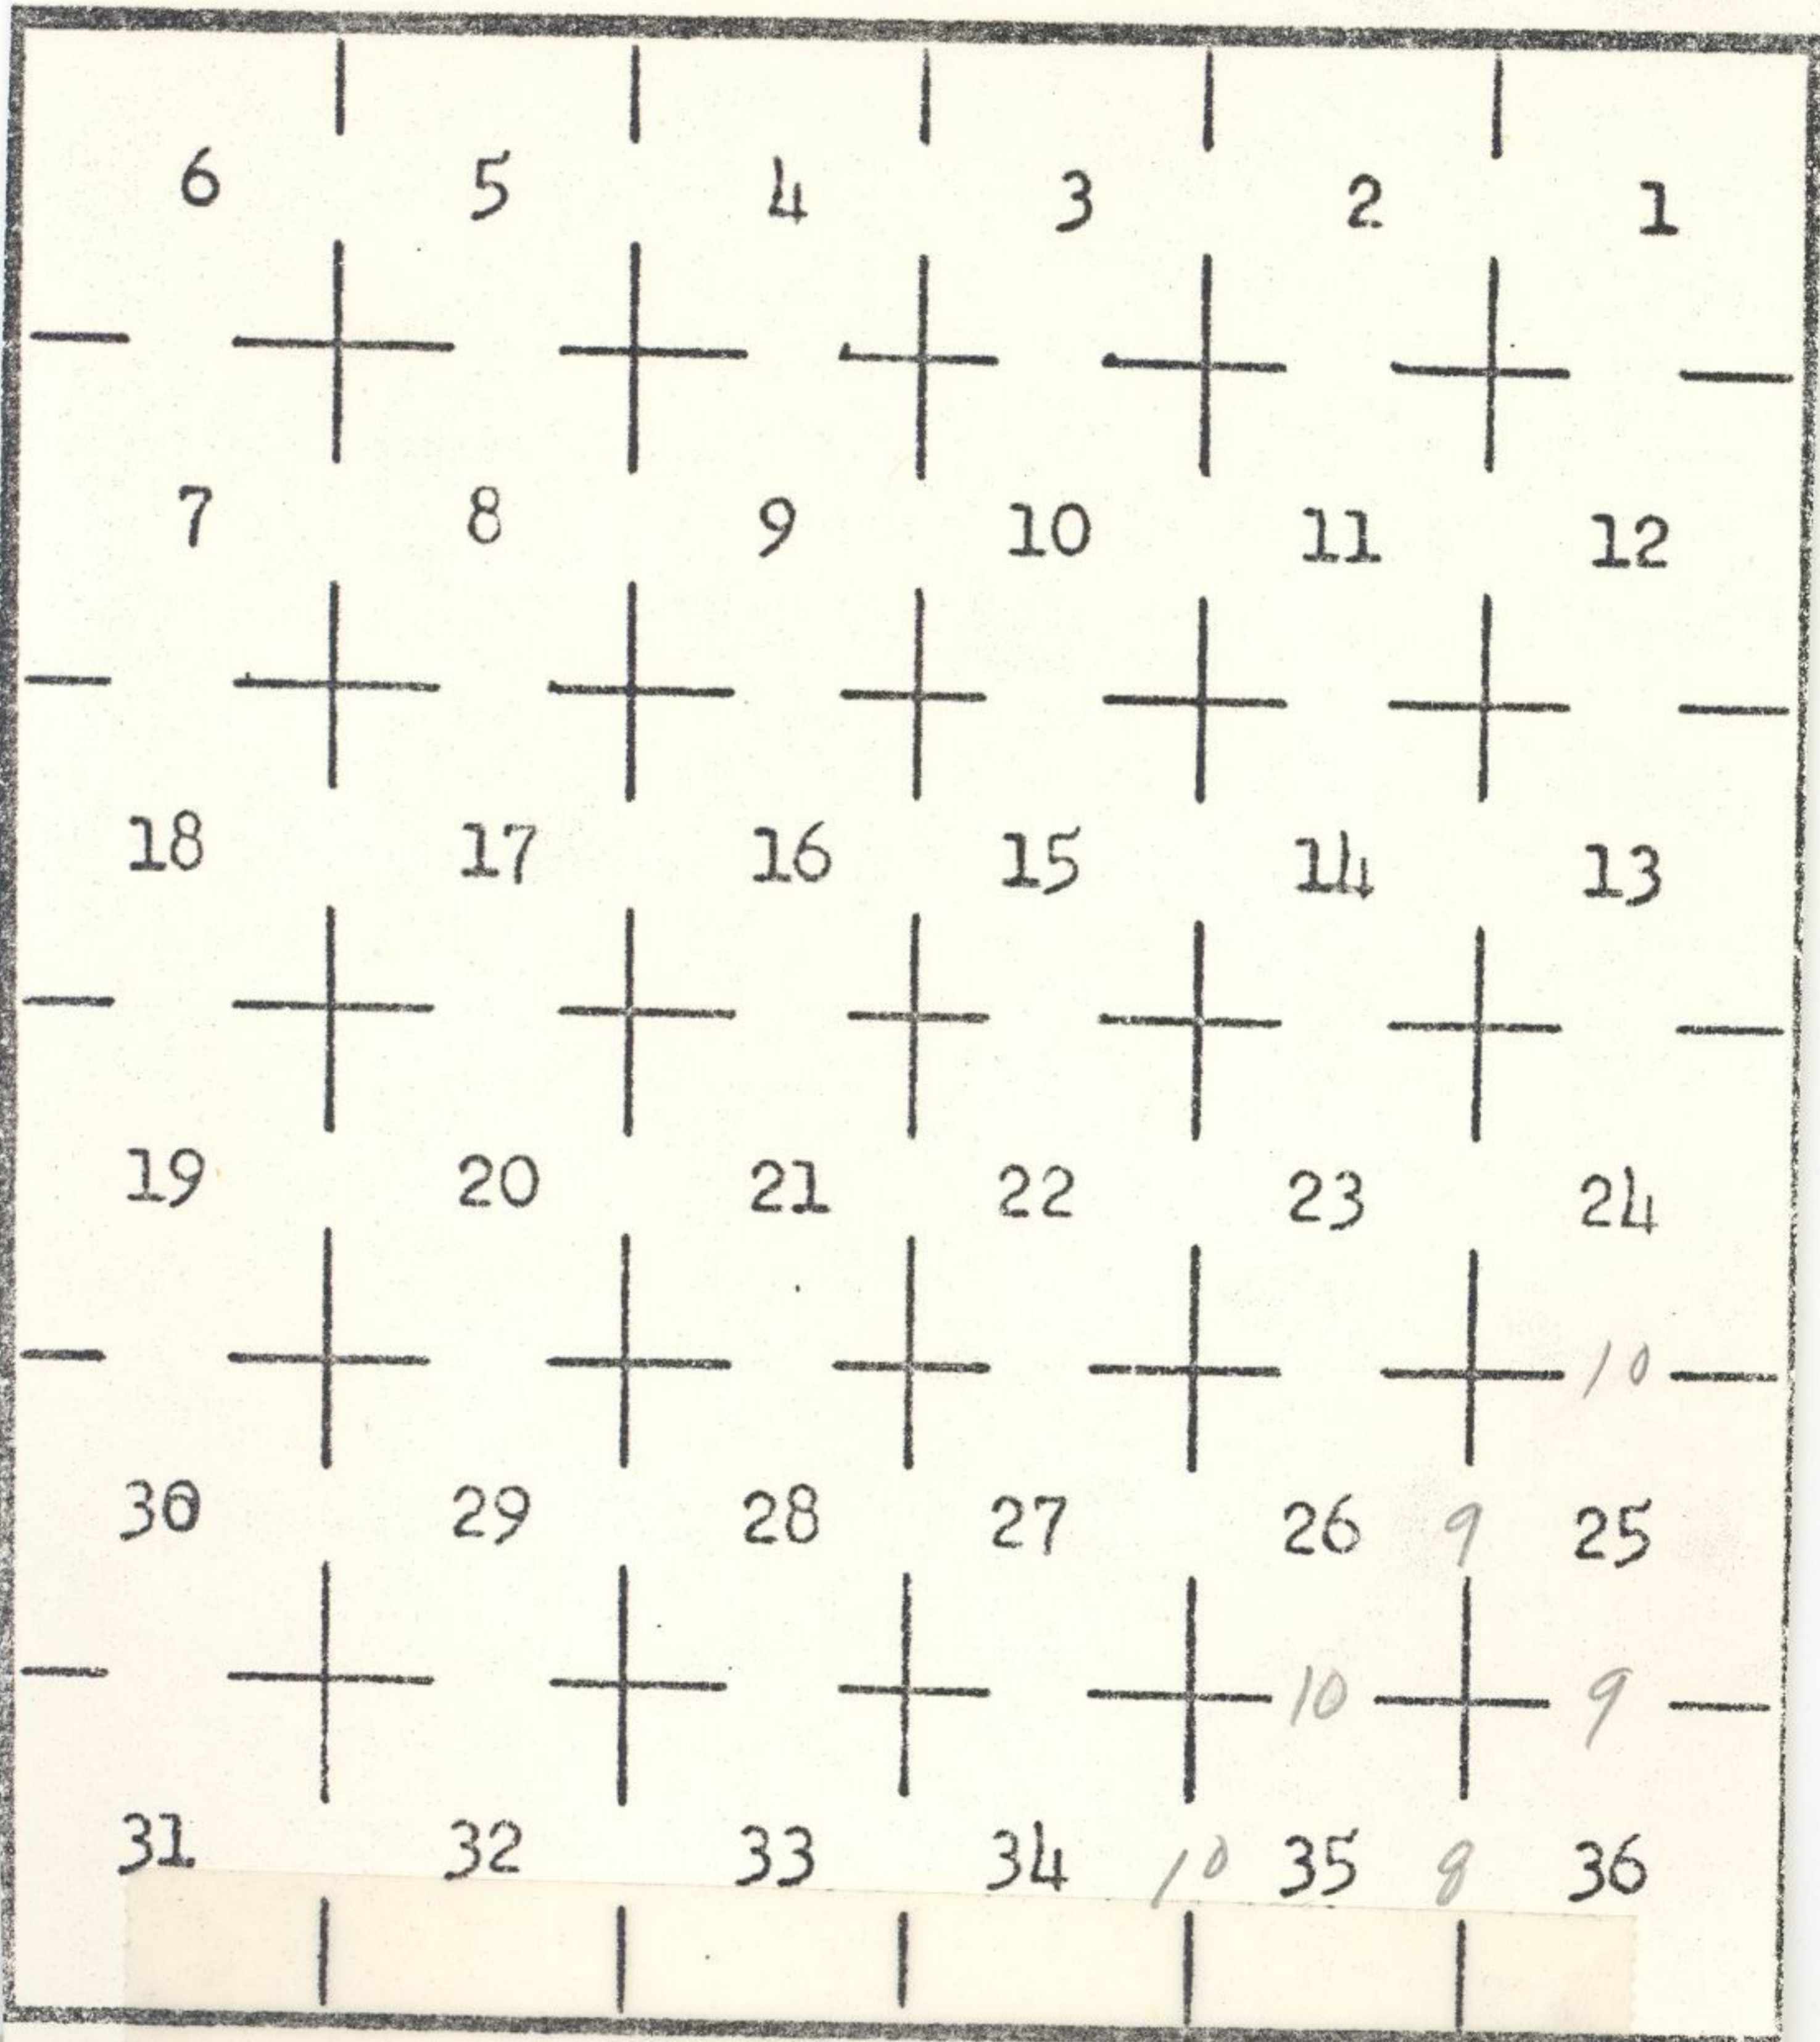

21 8.  
of the Willamette Meridian.

chs Field notes of the Survey of the  
Subdivisional Lines of Sp 4 N.  
R. 34 E. of the Will sur.  
by Z. F. Moody under his  
contract 164. Dated Oct. 4.  
1871.

North bet. Secs. 35 & 36

4000 Set post and made mound of  
Earth for  $\frac{1}{4}$  Sec. corner.

8000 Set post and made mound  
of Earth for corner to Secs.  
35, 36, 25, 26

Land rolling. Soil good  
 $\frac{1}{11}$  rate - Grass.

9 23

Township 4 North Range 34 East

Ch East on random bet. Secs. 25 & 26  
N. 21° E.

4000 Set temporary 1/4 S. corner.

8024 Intersected N & S. line at cor.

N. on true line

4012 Set post and made mound of  
Earth for 1/4 S. cor.

8024 To cor.

Land rolling. Soil good

North bet. Secs. 25 & 26

4000 Set post and made mound  
of Earth for 1/4 S. cor.

53,000 To Wild Horse ck. the Northern  
boundary of the Indian  
Reservation.

Land rolling. Soil good  
Good grass.

of the Willamette

23  
Meridian.

cks West bet Secs. 24 + 25  
40.00 Set post & mound made  
mound of Earth for  $\frac{1}{4}$  S. cor.  
45.40 To Wild Horse ck. The Boundary  
of the Reservation,  
Land rolling, Soil good

North bet. Secs. 34 + 35  
40.00 Set post and made Earth mound for  
 $\frac{1}{4}$  S. cor.  
51.40 Wild Horse ck  
Land rolling, Good grass

West bet. Secs. 26 + 35  
40.00 Set post and made Earth mound  
for  $\frac{1}{4}$  Sec cor.  
52.50 To Wild Horse ck.  
Land level, Soil  $\frac{1}{2}$  pale.  
Oct. 25. 1871.

24  
Township

Range

U. S. Surveyor General's Office  
Oregon City June 21<sup>st</sup> 1872

The foregoing field notes of the survey of Ex-  
terin lines of T 3 N. R 35 E ~~#~~ and  
T 21 N. Ranges 34<sup>th</sup> and 35 East Will  
Mer and the subdivisinal lines  
of T 4 N Rqs 34<sup>th</sup> and 35 E Will  
Mer Oregon executed by J. B.  
Moody deputy Surveyor under con-  
tract No 164 bearing date Oct  
24<sup>th</sup> 1871 having been critically  
examined the necessary cor-  
rections and explanations  
made the said field notes and  
the surveys they describe are  
herby approved

W. H. Bell  
Sur Gen

" I, Genas F. Moody, having been appointed a deputy Surveyor of the lands of the United States in Oregon, do solemnly swear that I will well and faithfully, and to the best of my skill and ability execute the duties confided to me pursuant to a contract with W. H. Odell, Surveyor General of public lands in Oregon, bearing date the 4<sup>th</sup> day of October 1871, according to the laws of the United States and the instructions received from the said Surveyor General.

G. F. Moody

Sworn and Subscribed before me  
this 14<sup>th</sup> day of October 1871  
W. Davenport  
U.S. Comm<sup>r</sup> Dist of Oregon

J. J. Kent, do solemnly swear that I will faithfully execute the duties of chain carrier; that I will level the chain upon uneven ground, and plumb the tally pins, whether by striking or dropping the same; that I will report the true distances to all notable objects, and the true length of all lines that I assist in measuring, to the best of my skill and ability.

J. J. Kent

Sworn and Subscribed before me  
 This 14<sup>th</sup> day of October 1871  
 W. Davenport  
 U.S. Commr. Dist. of Oregon.

I. O. Hathaway do solemnly  
swear that I will well and truly  
perform the duties of Axeman  
according to the instructions given  
me, and to the best of my skill and  
ability

O Hathaway

Sworn and Subscribed before me  
This 14<sup>th</sup> day of October 1871

M. Davenport  
U.S. Commr. Dist. of Oregon.



I, Geo. W. Renne, do  
 solemnly swear that I will faithfully  
 execute the duties of chain carrier; that  
 I will level the chain upon uneven  
 ground, and plumb the tally pins,  
 whether by striking or dropping the  
 same; that I will report the true  
 distances to all notable objects, and  
 the true length of lines that I assist  
 in measuring, to the best of my skill  
 and ability.

Geo. W. Renne

Sworn and Subscribed before me  
 this 14<sup>th</sup> day of October 1871  
 W. Davenport  
 U.S. Comm. Dist. of Oregon

I Edward Gariopy, do  
solemnly swear that I will well  
and truly perform the duties of  
Axeman, according to the in-  
structions given me, and to the  
best of my skill and ability.

Edward Gariopy

Sworn & Subscribed before me  
This 14th day of October 1871  
W. Davenport  
U.S. Commr. Dist. of Oregon.