

FIELD NOTES

281

Of the survey of the Meander

Lines of The Wild Horse Creek in T. 2 N.

³³ R. 32 E. 1. 3 N. R. 33 34 35 36 E, Willamette Meridian, Oregon,

as surveyed by James P. Currier

U. S. Deputy Surveyor, under his Contract No. Special

dated May 4th, 1887

Survey commenced, Sept 10th, 1887

Survey completed, Sept 17th, 1887

NAMES AND DUTIES OF ASSISTANTS.

....., Compassman.

J. S. Medley....., Chainman.

W. H. Medley....., Chainman.

....., Chainman.

....., Chainman.

Frank Poons....., Axman.

....., Axman.

....., Flagman.

PRELIMINARY OATHS OF ASSISTANTS.

We,

282

J. S. Medley & W. H. Medley

do solemnly swear that we will faithfully execute the duties of Chain Carriers; that we will level the chain over even and uneven ground, and plumb the tally pins, either by sticking or dropping the same; that we will report the true distance to all notable objects, and the true length of all lines that we will assist in measuring, to the best of our skill and ability, and in accordance with the instructions given us in the survey

of the Meander Lines of The Wild Horse Creek. lines of

Willamette Meridian, Oregon.

J. S. Medley, Chainman.

W. H. Medley, Chainman.

Chainman.

Chainman.

Subscribed and sworn to before me this

10th

day of

Sept.

, 1887

[SEAL.]

James P. Currin
U.S. Deputy Surveyor

We,

Frank Koons and

do solemnly swear that we will well and truly perform the duties of Axmen in the establishment of corners and other duties, according to instructions given us, and to the best of our skill and ability, in the survey of the

Meander of The Wild Horse Creek. Willamette Meridian, Oregon.

Frank Koons, Axman.

Axman.

Subscribed and sworn to before me this

10th


day of

Sept.

, 1887

[SEAL.]

James P. Currin
U.S. Deputy Surveyor

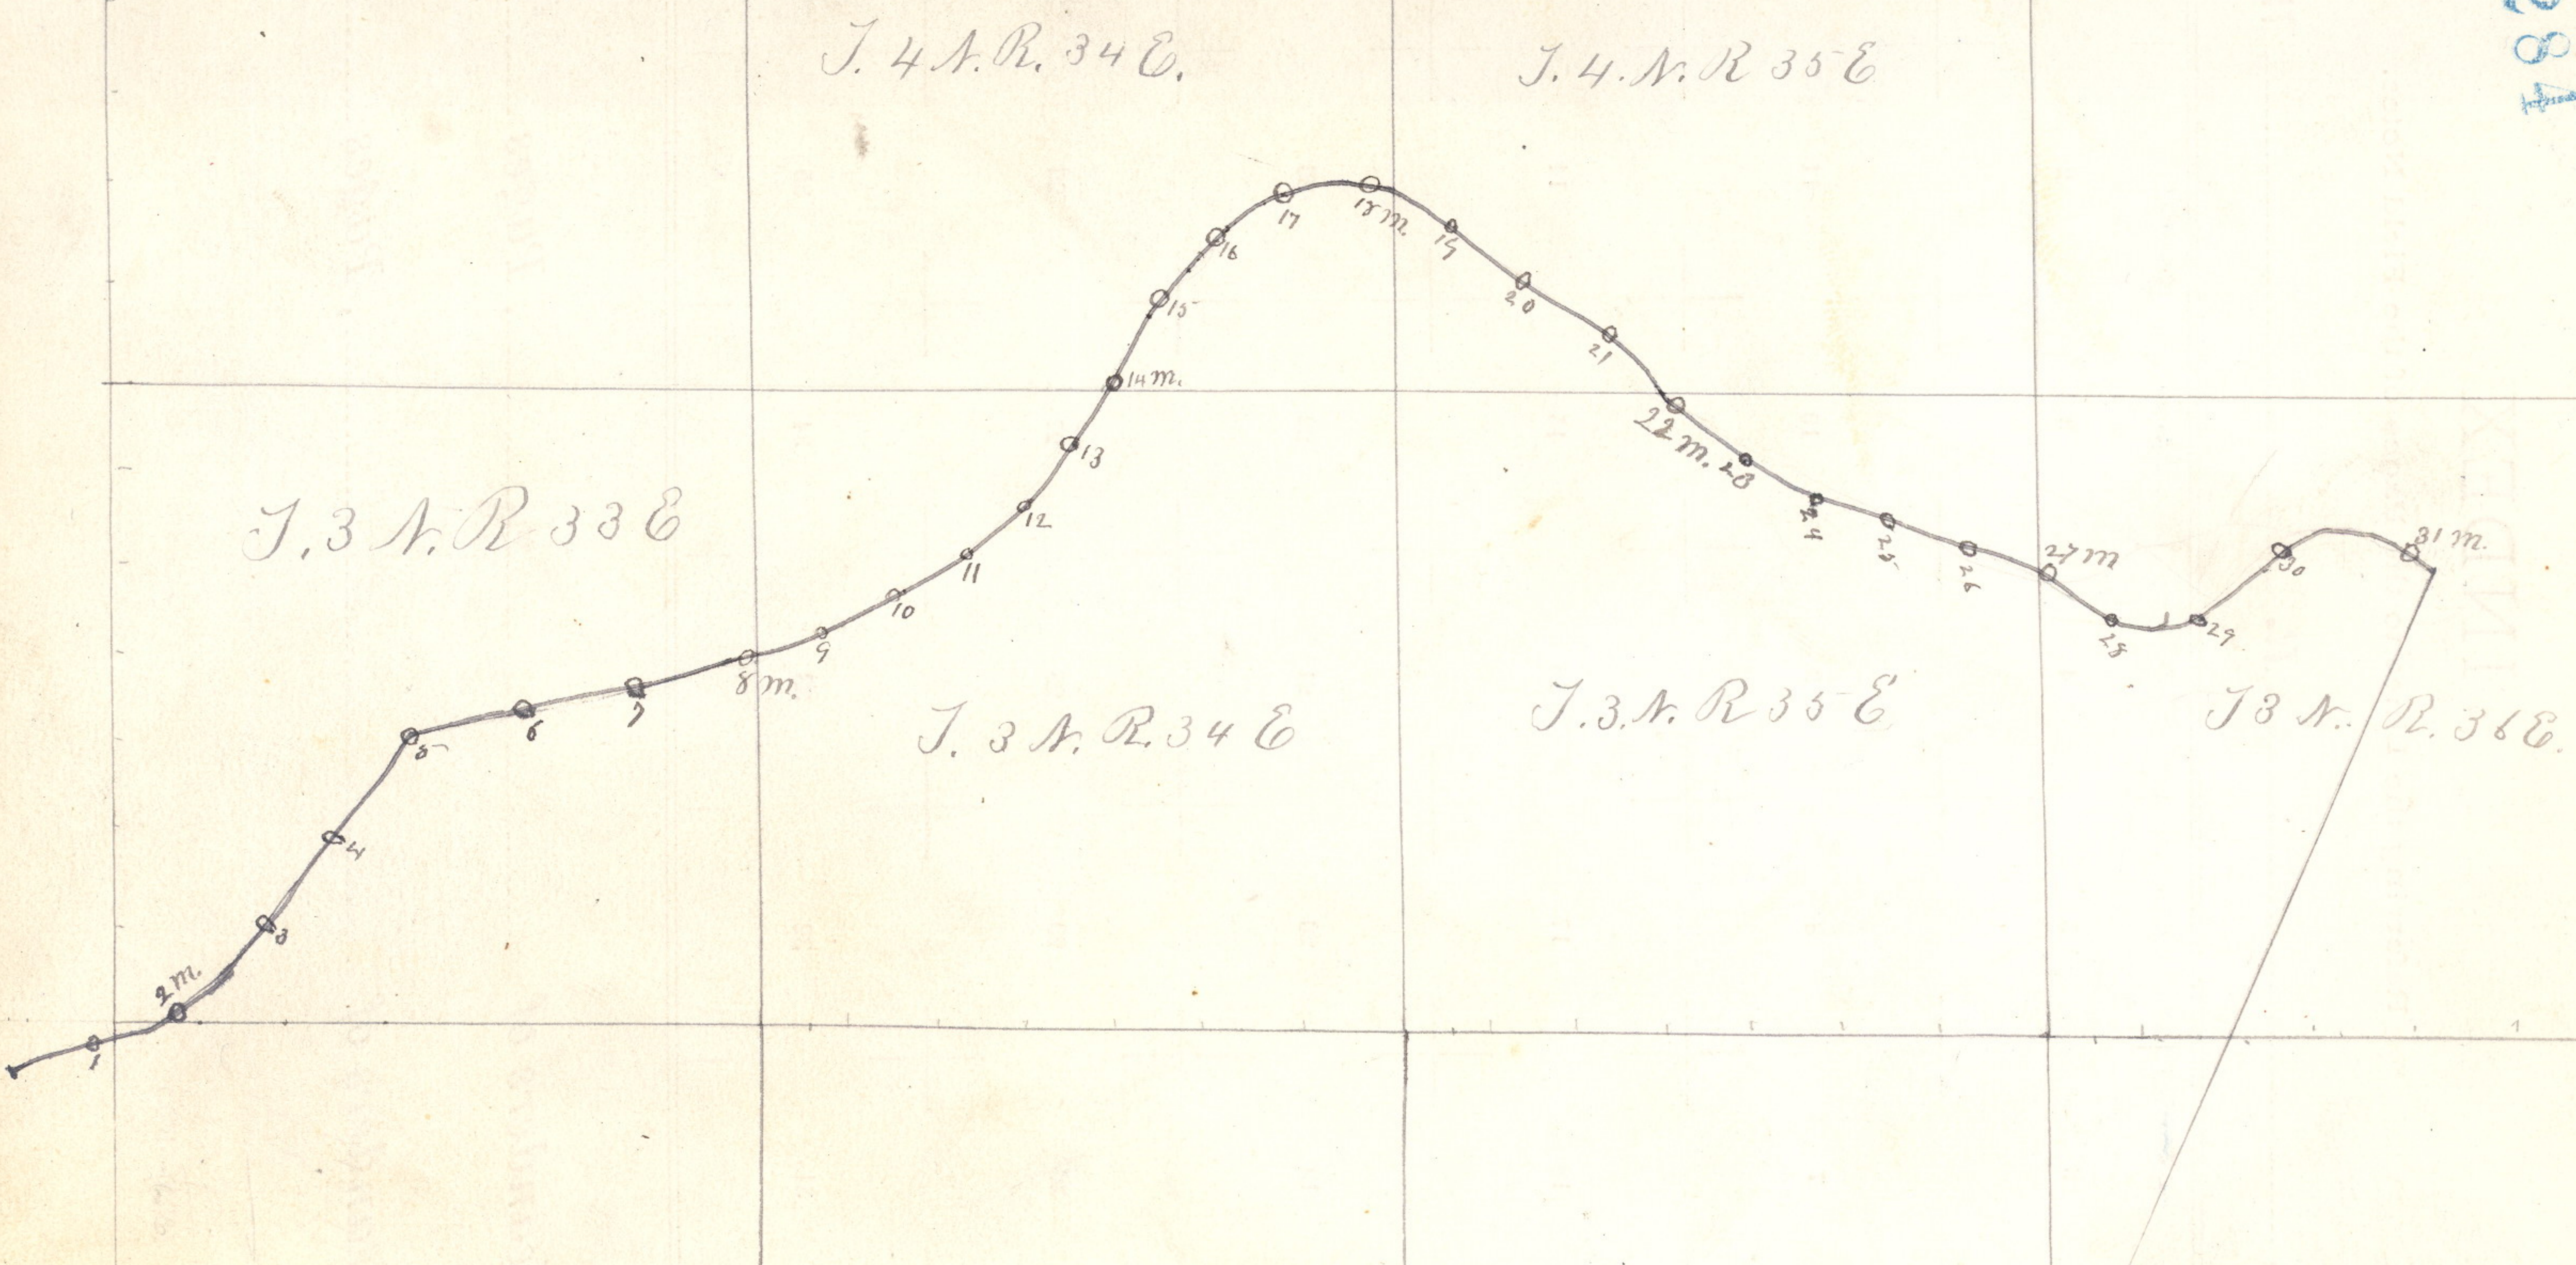

Meander of T. Wild R. Horse
Willamette Meridian, Oregon.

N 60° E 7.70 chs

N 34 1/2° E 5.70 .. To Meander cor.
to secs. 3 & 4

Thence in Sec 3

N 51° E 8.50 chs.

N 3° E 1.00 .. Set a post 48 x
48 x 4 ins 24 ins in the ground for
1/2 mile post - Marked 1/2. N on
S. & N. R. and E. faces. Dug pits 18 x 18
12 ins N. & S. of stone in 5 1/2 ft -
dist. raised earth mound 1 1/2 ft -
high 3 1/2 ft base around post

N 3° E 5.00 chs

N 24° E 8.50 "

N 2 1/4° E 3.30 "

N 8° N 2.50 "

N 56 1/2° N 1.90 "

N 28 1/4° E 12.30

N 16 1/2° N 4.45 To Meander cor to
secs. 3 & 34 on line bet Tps 3 & 4

N. R. 3 & 4 E. Thence in Sec 34

Mander of T. Wild R. Horse

Willamette Meridian, Oregon.

(8093-10 M.)

N 40 $\frac{1}{4}$ ° E 2.05 chs Set a post 48 x
 4 x 4 ins 24 ins in the ground for
 14th mile post marked 14 M. on
 S. W + N. Row S. E. faces, dug pits
 18 x 18 x 12 ins N. S. E. + W of post 5 $\frac{1}{2}$
 ft dist raised earth mound 2
 ft high 4 $\frac{1}{2}$ ft dia E around post
 Land Level bottom
 Soil rich loam. 1st class
 Dense willow under trees 80.00
 chs

Fence on 15th mile
 Var 20° E

N 44 $\frac{1}{4}$ ° E .80 chs
 S 70 $\frac{1}{4}$ ° E 3.80 "
 N 44 $\frac{3}{4}$ ° E 6.70 "
 N 14 $\frac{3}{4}$ ° E 3.10 "
 N 87° E 1.60 "
 N 24 $\frac{1}{2}$ ° E 15.00 "
 N 10 $\frac{1}{2}$ ° E 6.10 "
 N 45° E 2.90 " All at base

Mauder of T. Wild R. Horse

Willamette Meridian, Oregon.

stone 14x10x6 ins 8 ins in the ground
 for 1/2 Mile cor. marked 1/2 M on S.W.
 & N.E. and S.E. faces. Dug pits 18x
 18x12 ins N.E. & S.W. of stone 5 1/2 ft
 dist. raised earth mound 1 1/2 ft
 high 3 1/2 ft base along side
 N 43 1/4° E 630 chs.

N 82 3/4° E 130 " Leaving present
 channel of creek at the lower
 end of "The Grove" & following
 survey of Commissioners by
 Chalk. up what is supposed by
 them to be the old channel -

- N 24° E 140 chs through brush
- N 80° E 600 "
- N 51° E 220 "
- N 41° E 400 "
- N 46° E 410 "
- N 71 3/4° E 190 "
- N 82 1/2° E 200 "
- N 56 1/2° E 190 "

2816

Mauder of T. Wild R. Home

Willamette Meridian, Oregon.

(8093-10 M.)

N 15 1/2° E 1.00 chs

N 46° E 1.80 "

S 88° E 1.20 "

S 40 1/2° E 1.60 "

North 2.30 "

N 86° E 1.00 " Set a post 48 x

4 x 4 ins 24 ins in the ground

Marked 15 M on W face & U.S.

on S ^{face} face which a palm

12 ins in diam. to S 32° E dist.

29 chs Marked 15 M. B. P. 410 other

tree near dug pits 18 x 18 x 12

ins E & W of cor 5 1/2 ft dist

raised cor th mound 2 ft

high 4 1/2 ft - bas alongside

Sand level bottom

Soil rich black loam

Line follows flat blind ditch

through palm timber & dense thorn

see no sign that the wild

horse ever runs along this old

ditch

80.00 chs

Meander of T. Wild R. Horse
 Willamette Meridian, Oregon.

Thence on 16th Mile

Var 27° E

N 86° E. 120 chs Following Chalks Survey

N 47° N 200 "

N 16° N 260 "

N 39° E 170 "

N 48° E 150 "

N 21° E 240 "

N 62° E 270 "

S 84½° E 240 .. To present channel
 of the creek at the upper end of
 "The Grove" Thence following some

N 30° E 250 chs.

N 84¼° E 370 "

N 53½° E 225 " To Meander Cr to
 sec. 34 & 35 - Thence Sec 35

N 63° E 895 chs.

N 10½° E 290 "

N 65¼° E 320 .. Set a post 48x4x4
 ins 24 ins in the ground for ½ Mile
 post marked ½ M. on S.W. & N.E.

28
318

Meander of T. Mild R. J. Tree

Willamette Meridian, Oregon.

(8093-10 M.)

an S.E. faces. Dug pits 18x18x12 ins
N+S. of post 5 1/2 ft dist. raised cor
orth mound 1 1/2 ft high & 3 1/2 ft
base around post

N 65° E 2100 cho

N 75° E 500 "

N 37 1/2° E 370 "

N 49 1/2° E 480 "

N 60 1/2° E 364 " To Meander cor to
secs. 26 + 35. Fence in sec 26

N 70 1/4° E 266 cho.

N 28 1/2° E 570 "

N 54° E 1100 "

N 26° E 1500. Set a post 48x4x4
ins 24 ins in the ground for 16 in

the post. Mark 16 in on S + N. B
an E faces. Dug ^{pits} 18x18x12 ins N.S.

E. & N. of post 5 1/2 ft dist raised
corth mound 2 ft high 4 1/2 ft
base around post. Level bottom

Sail 1st gate & dual brush along creek
80. cho

Mauden of T. Mild R. Hazel
Willamette Meridian, Oregon.

Thence on 17th Mile
To 21st E

N 21 $\frac{3}{4}$ ^oE 15.00 chs

N 3^oE 12.00 "

N 46 $\frac{1}{2}$ ^oE 13.00 " Set a post 48x

4x4 ins 24 ins in the ground worked

$\frac{1}{2}$ M. on S. W. & N. R. on S. E. faces

Dug pits on each line 18x18, 12 ins

5 $\frac{1}{2}$ ft dia - raised earth mound

1 $\frac{1}{2}$ ft high 3 $\frac{1}{2}$ ft base around post

N 69^oE 5.00 chs.

S 87^oE 5.50 "

N 52^oE 4.00 "

N 88^oE 8.85 " To Meander cor.

To Secs. 25 & 26.

Thence in Sec. 25

N 65 $\frac{1}{2}$ ^oE 1.65 chs.

N 53^oE 7.00 "

N 48 $\frac{1}{2}$ ^oE 8.00 " Set a post

48x4x4 ins 24 ins in the ground

for 17th Mile post - Marked 17 M.

Manau of T. Wild R. Horse
Willamette Meridian, Oregon.

(8093-10 M.)

on S. W. & N. R. on S. E. faces. Dug pits
18x18x12 ins N. S. E. & W. of post-
5 1/2 ft. dist raised earth mound
2 ft. high 4 1/2 ft. base around post
Land level bottom
Soil rich loam 1st gate
dense willow & Thorn brush
80.00 ch

Thence on 1/8th Mile
Var. 20° E

N 48 1/2° E 4.00 chs.

N 64 1/4° E 10.00 "

N 48 1/2° E 12.90 " To Meander cor.

To secs 24 & 25

Thence in Sec 24

N 8 1/4° E 9.60 chs.

N 39° E 3.50 " Set a Cost. Stone

12x10x10 ins 8 ins in the ground

for 1/2 Mile cor. Marked 1/2 M on

S. W. & N. R. on S. E. faces. Dug pits

18x18x12 ins on back line 5 1/2 ft. ^{dist}

Mound of T. Wild R. Horse

Willamette Meridian, Oregon.

Raised earth mound $1\frac{1}{2}$ ft high

$3\frac{1}{2}$ ft base alongside x

N 39° E 10.00 chs

N $69\frac{1}{2}^{\circ}$ E 4.20 "

S $86\frac{1}{2}^{\circ}$ E 11.00 "

N 63° E 8.50 "

S $78\frac{1}{4}^{\circ}$ E 6.30 " Set a post 48×4
x 4 ins ^{24 ins} in the ground, for 18th

Mill Cor. Marked 18th M. on N. & W.

R. and S faces Dug pits $18 \times 18 \times 12$
ins NE, NW, SE. & SW of cor $5\frac{1}{2}$

ft dist raised earth mound 2

ft high $4\frac{1}{2}$ ft base ^{around post}

Land level bottom

Soil rich loam 1st rate

Dense brush & scattering ^{74 chs} ~~burn~~

timber, 18th mile post-stands

opposite the town of Centerville

Sept. 14th 1887

Manan of T. Mild R. Horse

Willamette Meridian, Oregon.

(8093-10 M.)

Fence on 19th Mile
Var 20° E

S 78 1/4° E 3.70 chs.

N 58° E 4.90 .. To Member to

secs. 19 & 24 Tps. 4 N. Rs 34 & 35 E

Fence in Sec 19. T 4 N R. 35 E.

S 65 1/2° E 3.90 chs

N 65° E 7.50 ..

N. 81° E 8.50 ..

N. 88 3/4° E 4.50 ..

S 42° E 4.00 ..

S 83° E 3.00 .. Set a post 48x4x

4ins 24ins in the ground for 1/2 mile

post marked 1/2 M on W. & N. R.

on S. faces, from which a

beam 12 ins in diam is North

25 Mts. dist. Marked 1/2 M. N. R. B. D.

* S 83° E 5.00 chs

S 67° E 3.30 ..

S 78° E 1.30 ..

South 1.70 ..

* No other tree near within limits
dug pits 18 x 18 x 12 ins E & W of post
5 1/2 ft diam & raised around 1 1/2 ft high
3 1/2 ft low along side

A list of the names of the individuals employed by _____

360 *James P. Currier*, U. S. Deputy Surveyor, to assist in running, measuring, and marking the lines and corners described in the foregoing field notes of the survey of the *Meander* lines of *The Wild Horse Creek* Willamette Meridian, Oregon, showing the respective capacities in which they acted:

_____, Compassman.
J. S. Medley, Chainman.
W. H. Medley, Chainman.
_____, Chainman.
_____, Chainman.
Frank Hoons, Axman.
_____, Axman.
_____, Flagman.


FINAL OATHS OF ASSISTANTS.

We hereby certify that we assisted *James P. Currier*, U. S. Deputy Surveyor, in surveying all those parts or portions of the *Meander* lines of *The Wild Horse Creek* Willamette Meridian, Oregon, as represented in the foregoing field notes as having been surveyed by him and under his direction; and that said survey has been in all respects, to the best of our knowledge and belief, well and faithfully surveyed, and the corner monuments established, according to the instructions furnished by the U. S. Surveyor General of Oregon.

_____, Compassman.
J. S. Medley, Chainman.
W. H. Medley, Chainman.
James P. Currier, Chainman.
_____, Chainman.
Frank Hoons, Axman.
_____, Axman.
_____, Flagman.

Subscribed and sworn to before me this *17th* day of

Sept., 188*7*.
James P. Currier
U. S. Deputy Surveyor

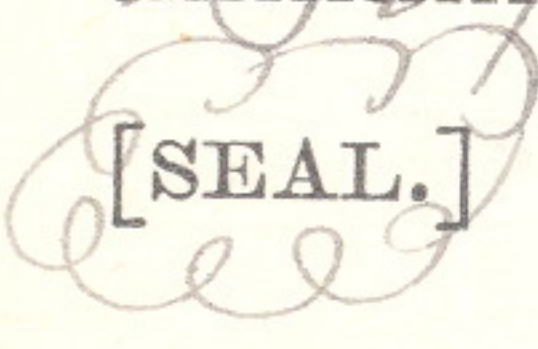

FINAL OATH OF DEPUTY SURVEYOR.

I, James P. Currier, United States
 Deputy Surveyor, do solemnly swear that in pursuance of instructions
 received from Douglas H. Taylor, U. S.
 Surveyor General for Oregon, bearing date of the 13th
 day of May, 1887, I have well, faithfully,
 and truly, in my own proper person, and in strict conformity with the
 instructions furnished by the U. S. Surveyor General for Oregon, the
 Surveying Manual, and the laws of the United States, surveying all
 those parts or portions of The meander
of the Wild Horse Creek
 Willamette Meridian, in the State of Oregon, as are represented in the
 foregoing field notes as having been surveyed by me and under my
 directions; and I do further solemnly swear that all the corners of said
 survey have been established and perpetuated in strict accordance with
 the Surveying Manual, printed instructions, the special written instruc-
 tions of the U. S. Surveyor General for Oregon, and in the specific man-
 ner described in the field notes, and that the foregoing are the *true* field
 notes of such survey, and should any fraud be detected I will suffer the
 penalty of perjury under the provisions of an act of Congress approved
 August 8, 1846.

James P. Currier
 U. S. Deputy Surveyor.

Subscribed and sworn to before me this Fifteenth
 day of February, 1888.

Alvord
Notary Public
for Oregon

Office of U. S. Surveyor General,

Portland, Oregon, June 28, 1888

The following ^{foregoing} Field Notes of the Survey of theMeander lines of the
Wild Horse Creek.executed by James J. Currier U.S.
Joint Special U.S. Dept Surveyors
under his Contract No. —, dated May
4th, 1887, having been critically examined,the necessary corrections and explanations made, the
said Field Notes and the survey they describe, are
hereby approved.Douglas W. Taylor
Surveyor General.