


281

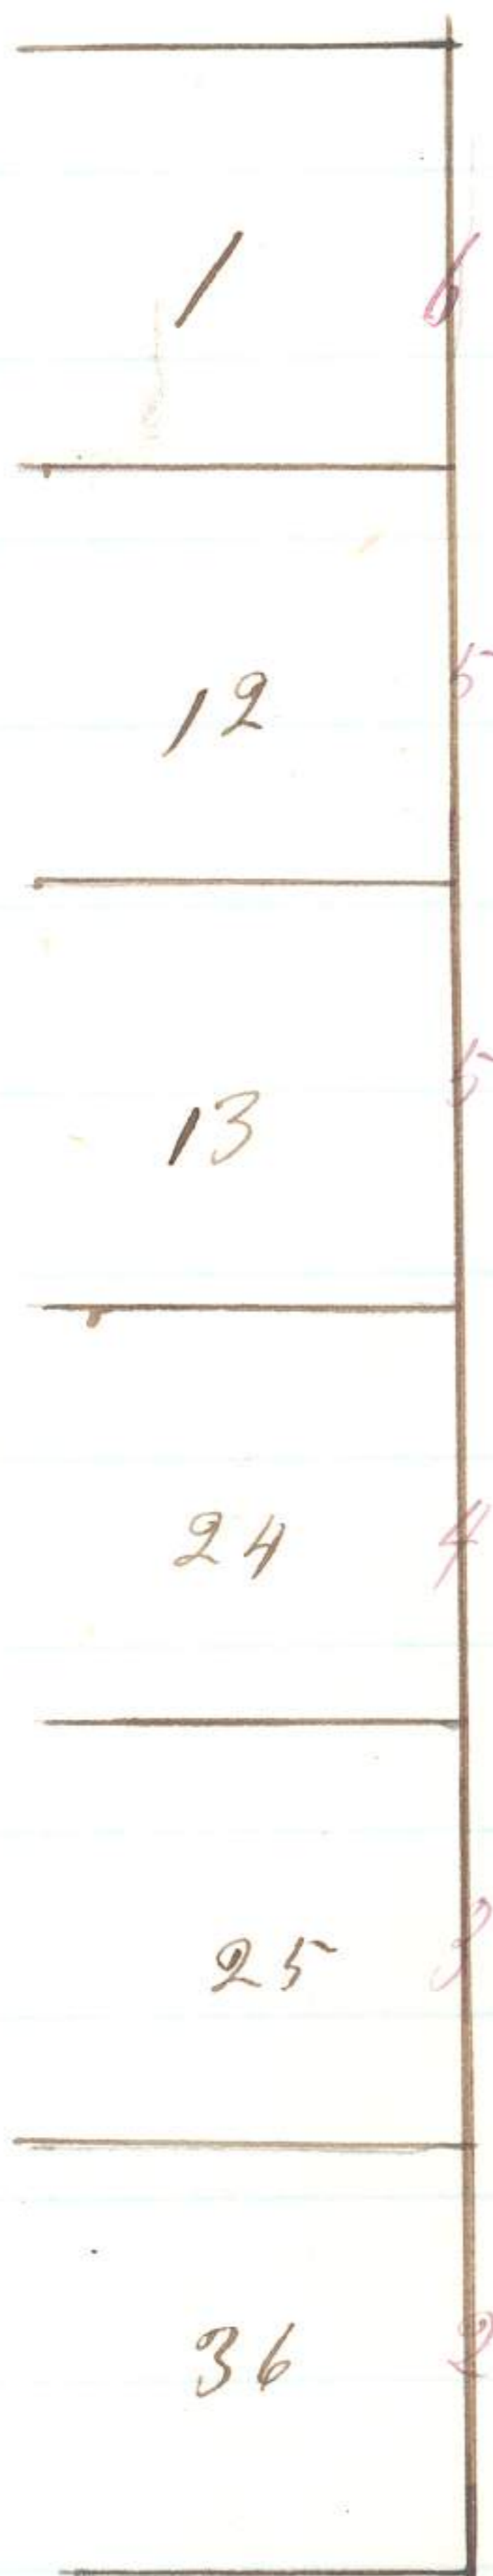

Field Notes of the survey of
 the exterior boundaries of Township
 number 4 North of the Base Line
 of Range 36 East of Willamette
 Meridian, in the State of Oregon
 by William H. Odell, deputy surveyor
 under his contract No. 114. bearing
 date July 2nd 1866.

Commenced September 28th 1866

Completed October 2nd 1866.

East boundary T4 N. R36 E. Will. Mer.
 North on East boundary of section 36.

Bear 19° 30' East -

11.25		
11.25	Pine Creek course West	120

40.00	Set post corner for 1/4 section from which	120
-------	--------------------------------------------	-----

A Pine 8 in. dia - bears N. 45° E. 93 lbs

do - Fir 24 do - do - do - N. 4° W. 61 do -

80.00	Set post corner for sections 25, 36, 30 & 31	
-------	----------------------------------------------	--

from which

A Fir 20 in. dia - bears S. 25° W. 20 lbs

East boundary T-4N-R-36 & Will Mer-

instructions.

Sand broken,

+ Soil 2nd rate -

North on East boundary of section 1

Bar 21° East -

40.00

40.00 Set post corner for 1/4 section \$100

Made Stone Mound as per instructions,

68.35 Intersected first Standard 25-

68.35

Parallel 12,90 chs West of Township Corner for T-5N-R-36 & 37.

Made Closing corner for Townships 4 N Ranges 36 & 37, and sections

1 & 6. Made Stone Mound as per instructions

+ Sand broken, Soil 2nd rate,

This Township contains considerable amount of first rate timbered lands, and some good agricultural lands.

The Township should therefore be subdivided.

October 4th 1866.

x

~~List of names of the individuals employed to assist in running and measuring the foregoing lines,~~

List of names of the individuals employed to assist in running, measuring, or marking the lines and corners described in the foregoing field notes of the boundary lines of T. 4 N. R. 36 E. Willamette Meridian, showing the respective capacities in which they acted;

John Biggs }
Charles Hardisty } Chairman
Samuel Hardisty } Assessor

x

The proper Affidavits to the foregoing
Field Notes of the East boundary
of Township No. 4 North of the
Base line of Range 36 East
of the Willamette Meridian
will be found at the close
of the Field Notes of the Subdivision
of said Township -

+

Surveyor General's Office

Eugene City January 17, 1867

The foregoing field notes of the Survey
of the Exterior boundaries of Township
N^o 4 North Range N^o 36 East Will.

Mer. Oregon, executed by William H.
Adell Deputy Surveyor under his contract
N^o 114, having been critically examined
the necessary corrections and explanations
made the field notes and the Survey
they describe are hereby approved

E. L. Aplegate

Surveyor General of Oregon