


281

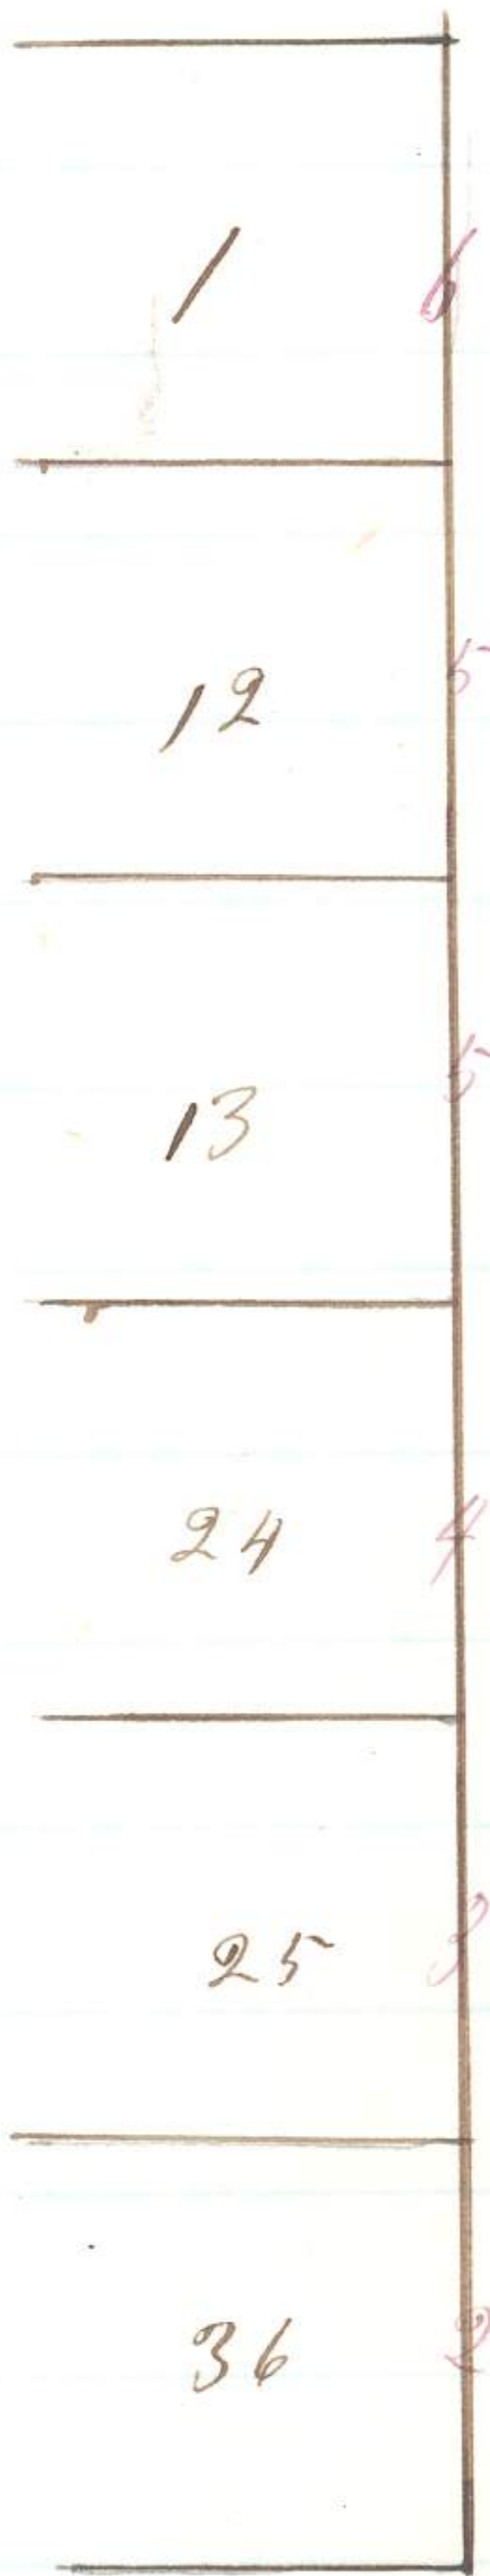

Field Notes of the survey of  
 the exterior boundaries of Township  
 number 4 North of the Base Line  
 of Range 36 East of Willamette  
 Meridian, in the State of Oregon  
 by William H. Odell, deputy surveyor  
 under his contract No. 114. bearing  
 date July 2<sup>nd</sup> 1866.

Commenced September 28<sup>th</sup> 1866

Completed October 2<sup>nd</sup> 1866.

East boundary T4 N. R36 E. Will. Mer.  
 North on East boundary of section 36.

Bar  $19^{\circ}30'$  East -

11.25		
11.25	Pine Creek course West	120

40.00	Set post corner for 1/4 section from which	120
-------	--	-----

A Pine 8 in. dia - bears  $N.45^{\circ}E.$  93 lbs

do - Fir 24 do - do - do -  $N.4^{\circ}W.$  61 do -

80.00	Set post corner for sections 25, 36, 30 & 31	
-------	--	--

from which

A Fir 20 in. dia - bears  $S.25^{\circ}W.$  20 lbs

East boundary T-4N-R-36 & Will Mer-

instructions.

Sand broken,

+ Soil 2<sup>nd</sup> Rate -

North on East boundary of section 1

Bar 21° East -

40.00

40.00 Set post corner for 1/4 section \$100

Made Stone Mound as per instructions,

68.35 Intersected first Standard 25-

68.35

Parallel 12,90 chs West of Township Corner for T-5N-R-36 & 37.

Made Closing corner for Townships 4 N Ranges 36 & 37, and sections

1 & 6. Made Stone Mound as per instructions

+ Sand broken, Soil 2<sup>nd</sup> Rate,

This Township contains considerable amount of first rate timbered lands, and some good Agricultural lands,

The Township should therefore be subdivided.

October 4<sup>th</sup> 1866.

x

~~List of names of the individuals employed to assist in running and measuring the foregoing lines,~~

List of names of the individuals employed to assist in running, measuring, or marking the lines and corners described in the foregoing field notes of the boundary lines of T. 4 N. R. 36 E. Willamette Meridian, showing the respective capacities in which they acted;

John Biggs }  
Charles Hardisty } Chairman  
Samuel Hardisty } Assessor

x

The proper Affidavits to the foregoing  
Field Notes of the East boundary  
of Township No. 4 North of the  
Base line of Range 36 East  
of the Willamette Meridian  
will be found at the close  
of the Field Notes of the Subdivision  
of said Township -

+

Surveyor General's Office

Eugene City January 17, 1867

The foregoing field notes of the Survey  
of the Exterior boundaries of Township  
N<sup>o</sup> 4 North Range N<sup>o</sup> 36 East Will.

Mer. Oregon, executed by William H.  
Adell Deputy Surveyor under his contract  
N<sup>o</sup> 114, having been critically examined  
the necessary corrections and explanations  
made the field notes and the Survey  
they describe are hereby approved

E. L. Aplegate

Surveyor General of Oregon