


281

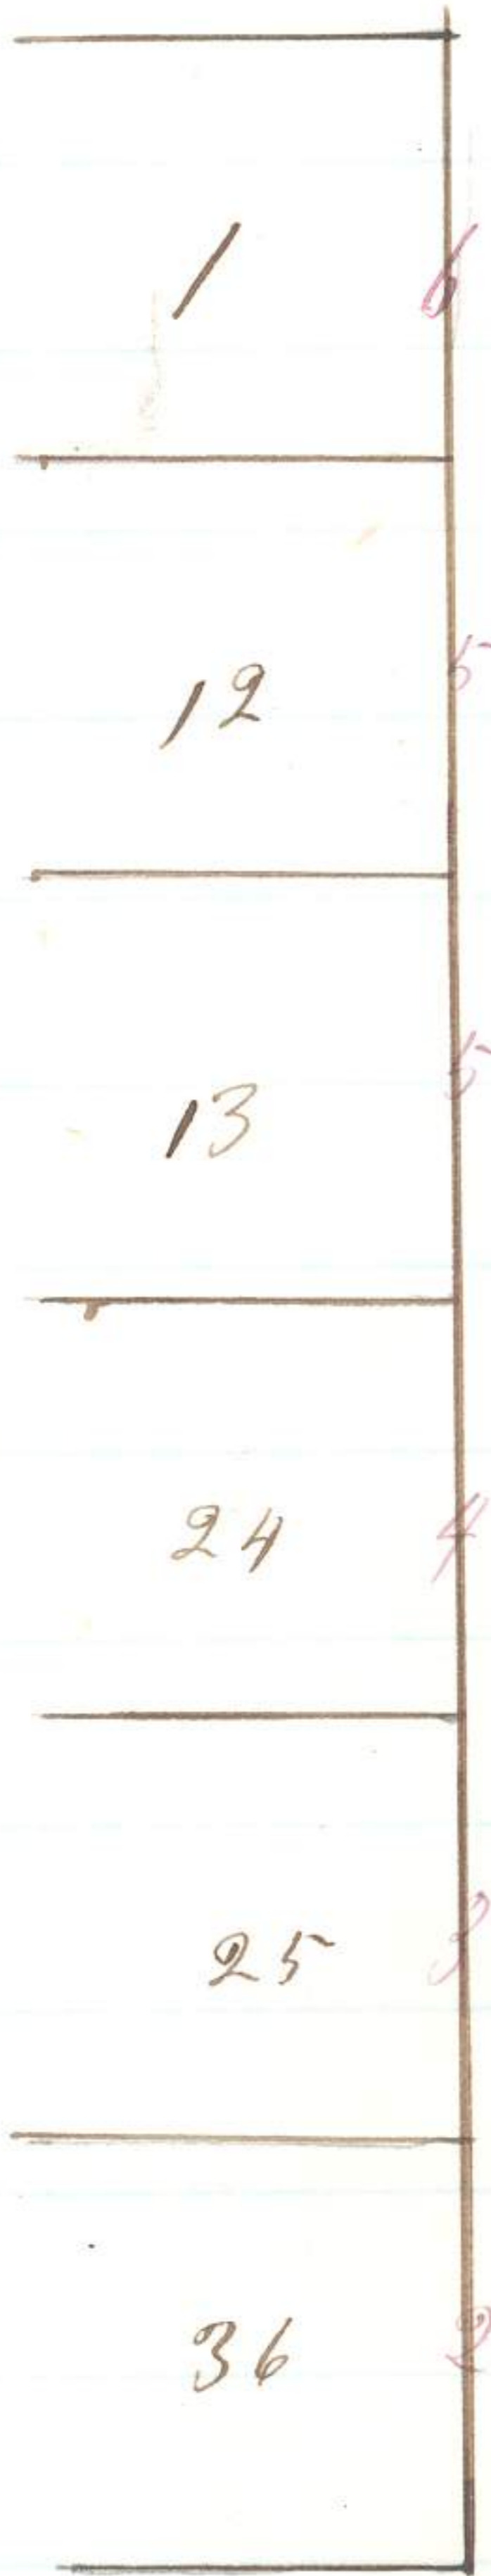

Field Notes of the survey of
 the exterior boundaries of Township
 number 4 North of the Base Line
 of Range 36 East of Willamette
 Meridian, in the State of Oregon
 by William H. Odell, deputy surveyor
 under his contract No. 114. bearing
 date July 2nd 1866.

Commenced September 28th 1866

Completed October 2nd 1866.

East boundary T4 N. R36 E. Will. Mer.
 North on East boundary of section 36.

Bar $19^{\circ}30'$ East -

11.25		
11.25	Pine Creek course West	120

40.00	Set post corner for 1/4 section from which	120
-------	--	-----

A Pine 8 in. dia - bears $N.45^{\circ}E.$ 93 lbs

do - Fir 24 do - do - do - $N.4^{\circ}W.$ 61 do -

80.00	Set post corner for sections 25, 36, 30 & 31	
-------	--	--

from which

A Fir 20 in. dia - bears $S.25^{\circ}W.$ 20 lbs

30 283

East boundary of Sec. R-36 E. Will. Mer-

A Larch 24 in dia bears S 45° E - 19 lbs
do Pine 30 do do do N 50 E - 70 do
do W Fir 12 do do do N 45° W - 32 do

This line passes through timber
Larch Fir and Pine, Undergrowth
the same with Willow,

Land gently rolling,
Soil 2^d rate,

x

North on East boundary of section 25.

Bar 20° East,

4000 Set post corner for 14 section, on ³⁰ 30
side hill in thick underbrush,
from which

A Larch 4 in dia bears S 20° E 12 lbs
do do - 5 do do do N 15° W 15 do

43.75 Bottom of Prairie course N. W. ⁷⁵ 75

8000 Set post corner for sections 24.25. ¹²⁰ 120

19 & 30, on level in edge of pine
Grove, from which,

A Pine 24 in dia bears S 85° W - 38 lbs
do do 24 do do do N 55° W, 42 do

East boundary of T-4 N 36 E Will-Mer-

A Pine 15 in-dia-bears N 30° E - 50 lbs

do - do - 20 do - do - do - S 12° E - 22 do -

This line crosses deep ravine
On South side Timber Fir, Larch,
and Pine, on the North open grassy
land, Soil 2nd Kate -

+ September 28th 1866

North on East boundary of section 24.

Bur 21° East -

^{40.00}
4000 Set post corner for 4 sections
from which

A Pine 30 in-dia-bears West 427 lbs

do - do - 14 do - do - do - N 40° E - 145 do -

^{80.00}
8000 Set post corner for sections 13, 24, 150
18 & 19. from which

A Fir 42 in-dia-bears N 30° E, 28 lbs

A Larch 12 do - do - do - N 45° W, 118 do -

do - do - 20 do - do - do - S 70° W, 92 do -

no tree near in section 19.

Land rolling, good grass,

Soil 2nd Kate, Timber Pine - Scattering)

+

East Boundary of T-4 N-12-36 E- Will-Mer-
 North on East boundary of section 13
 Bar 22° East-

16.25	Bottom of Ravine some water, corner	W 150	
40.00	Set post corner for ¹⁴ / ₄ sections. Made		
	Stone mound as per instructions	300	+ 300
57.50	Board course N-W		
80.00	Set post corner for sections 12. 13. 7418	20	- 20
	from which a		
	A Pine 10 in-dia-bears S 26° E- 242 lbs		
	do- do- 21 do- do- do- S 30° W- 275 do		
	do- do- 15 do- do- do- N 88° W, 375 do-		
	Land broken, soil 2 nd rate,		

X

North on East boundary of section
 12,
 Bar 21° East-

40.00	Set post corner for ¹⁴ / ₄ section, on hill side facing the East, Made Stone mound as per instructions,		
65.00	Creek 5-1/2 mile course N, W,	400	400
80.00	Set post corner for sections 1. 12.	200	+ 200
	647. Made Stone Mound as per		

East boundary T-4N-R-36 & Will Mer-

instructions.

Sand broken,

+ Soil 2nd rate -

North on East boundary of section 1

Bar 21° East -

40.00

40.00 Set post corner for 1/4 section \$100

Made Stone Mound as per instructions,

68.35 Intersected first Standard 25-

68.35

Parallel 12,90 chs West of Township Corner for T-5N-R-36 & 37.

Made Closing corner for Townships 4 N Ranges 36 & 37, and sections

1 & 6. Made Stone Mound as per instructions

+ Sand broken, Soil 2nd rate,

This Township contains considerable amount of first rate timbered lands, and some good agricultural lands,

The Township should therefore be subdivided.

October 4th 1866.

x

~~List of names of the individuals employed to assist in running and measuring the foregoing lines,~~

List of names of the individuals employed to assist in running, measuring, or marking the lines and corners described in the foregoing field notes of the boundary lines of T. 4 N. R. 36 E. Willamette Meridian, showing the respective capacities in which they acted;

John Biggs }
Charles Hardisty } Chairman
Samuel Hardisty } Assessor

x

The proper Affidavits to the foregoing
Field Notes of the East boundary
of Township No. 4 North of the
Base line of Range 36 East
of the Willamette Meridian
will be found at the close
of the Field Notes of the Subdivision
of said Township -

+

Surveyor General's Office

Eugene City January 17, 1867

The foregoing field notes of the Survey
of the Exterior boundaries of Township
N^o 4 North Range N^o 36 East Will.

Mer. Oregon, executed by William H.
Adell Deputy Surveyor under his contract
N^o 114, having been critically examined
the necessary corrections and explanations
made the field notes and the Survey
they describe are hereby approved

E. L. Aplegate

Surveyor General of Oregon