

Rec'd Dec 6, 1870

Washington Transcript made  
David S. Murphy

William B. Campbell  
Deputy Surveyor

1A 293

XX

not comp

Rem'd.

I Samuel L. Campbell and Josephus Tompkins having been appointed chairmen in the service of Wm. S. Campbell deputy Surveyor in Oregon do solemnly swear that we will level the chain in measuring over uneven ground, that we will well and truly plumb the tally pins, whether in <sup>that I will report the true distance to all notable objects, and the true length of all things that I may assist in measuring</sup> sticking or dropping the same, that we will correctly and distinctly mark all letters and figures that we maybe required to mark, and that we will further act as required by said deputy in the discharge of his surveying duties to the best of our skill and abilities

Subscribed and sworn to before me  
 Samuel L. Campbell  
 Josephus Tompkins  
 at Dallas City, Wasco County  
 Oregon, this 4<sup>th</sup> day  
 of October A. D.  
 1850  
 N. H. Courteney, J. P.  
 in and for Wasco County Oregon


I Robert F. Canfield having  
 been appointed Assessor in  
 the service of J. M. Campbell  
 Deputy Surveyor in Oregon. do  
 solemnly swear that I will well  
 and ~~faithfully~~ faithfully perform the duties of  
 Assessor or Assessor according  
 to instructions given me, and to  
 the best of my skill and ability  
 Robert F. Canfield

Subscribed and sworn to before  
 me at Dallas City Wasco County  
 Oregon this 4<sup>th</sup> day of October  
 A. D. 1860  
 W. H. Condon  
 J. P.  
 in and for Wasco County  
 Oregon

Field Notes of the survey of the  
 exterior boundaries of Townships N<sup>o</sup>  
 11 North of Ranges N<sup>o</sup> 29 & 30  
 East of the Willamette Meridian,  
 in the State of Oregon, by Wm<sup>o</sup> B.  
 Campbell, deputy surveyor, under  
 his Contract N<sup>o</sup> 95, bearing date  
 the 19<sup>th</sup> day of September 1860

Commenced Oct. 13<sup>th</sup> 1860  
 Finished Oct. 23<sup>rd</sup> 1860

Index Diagram

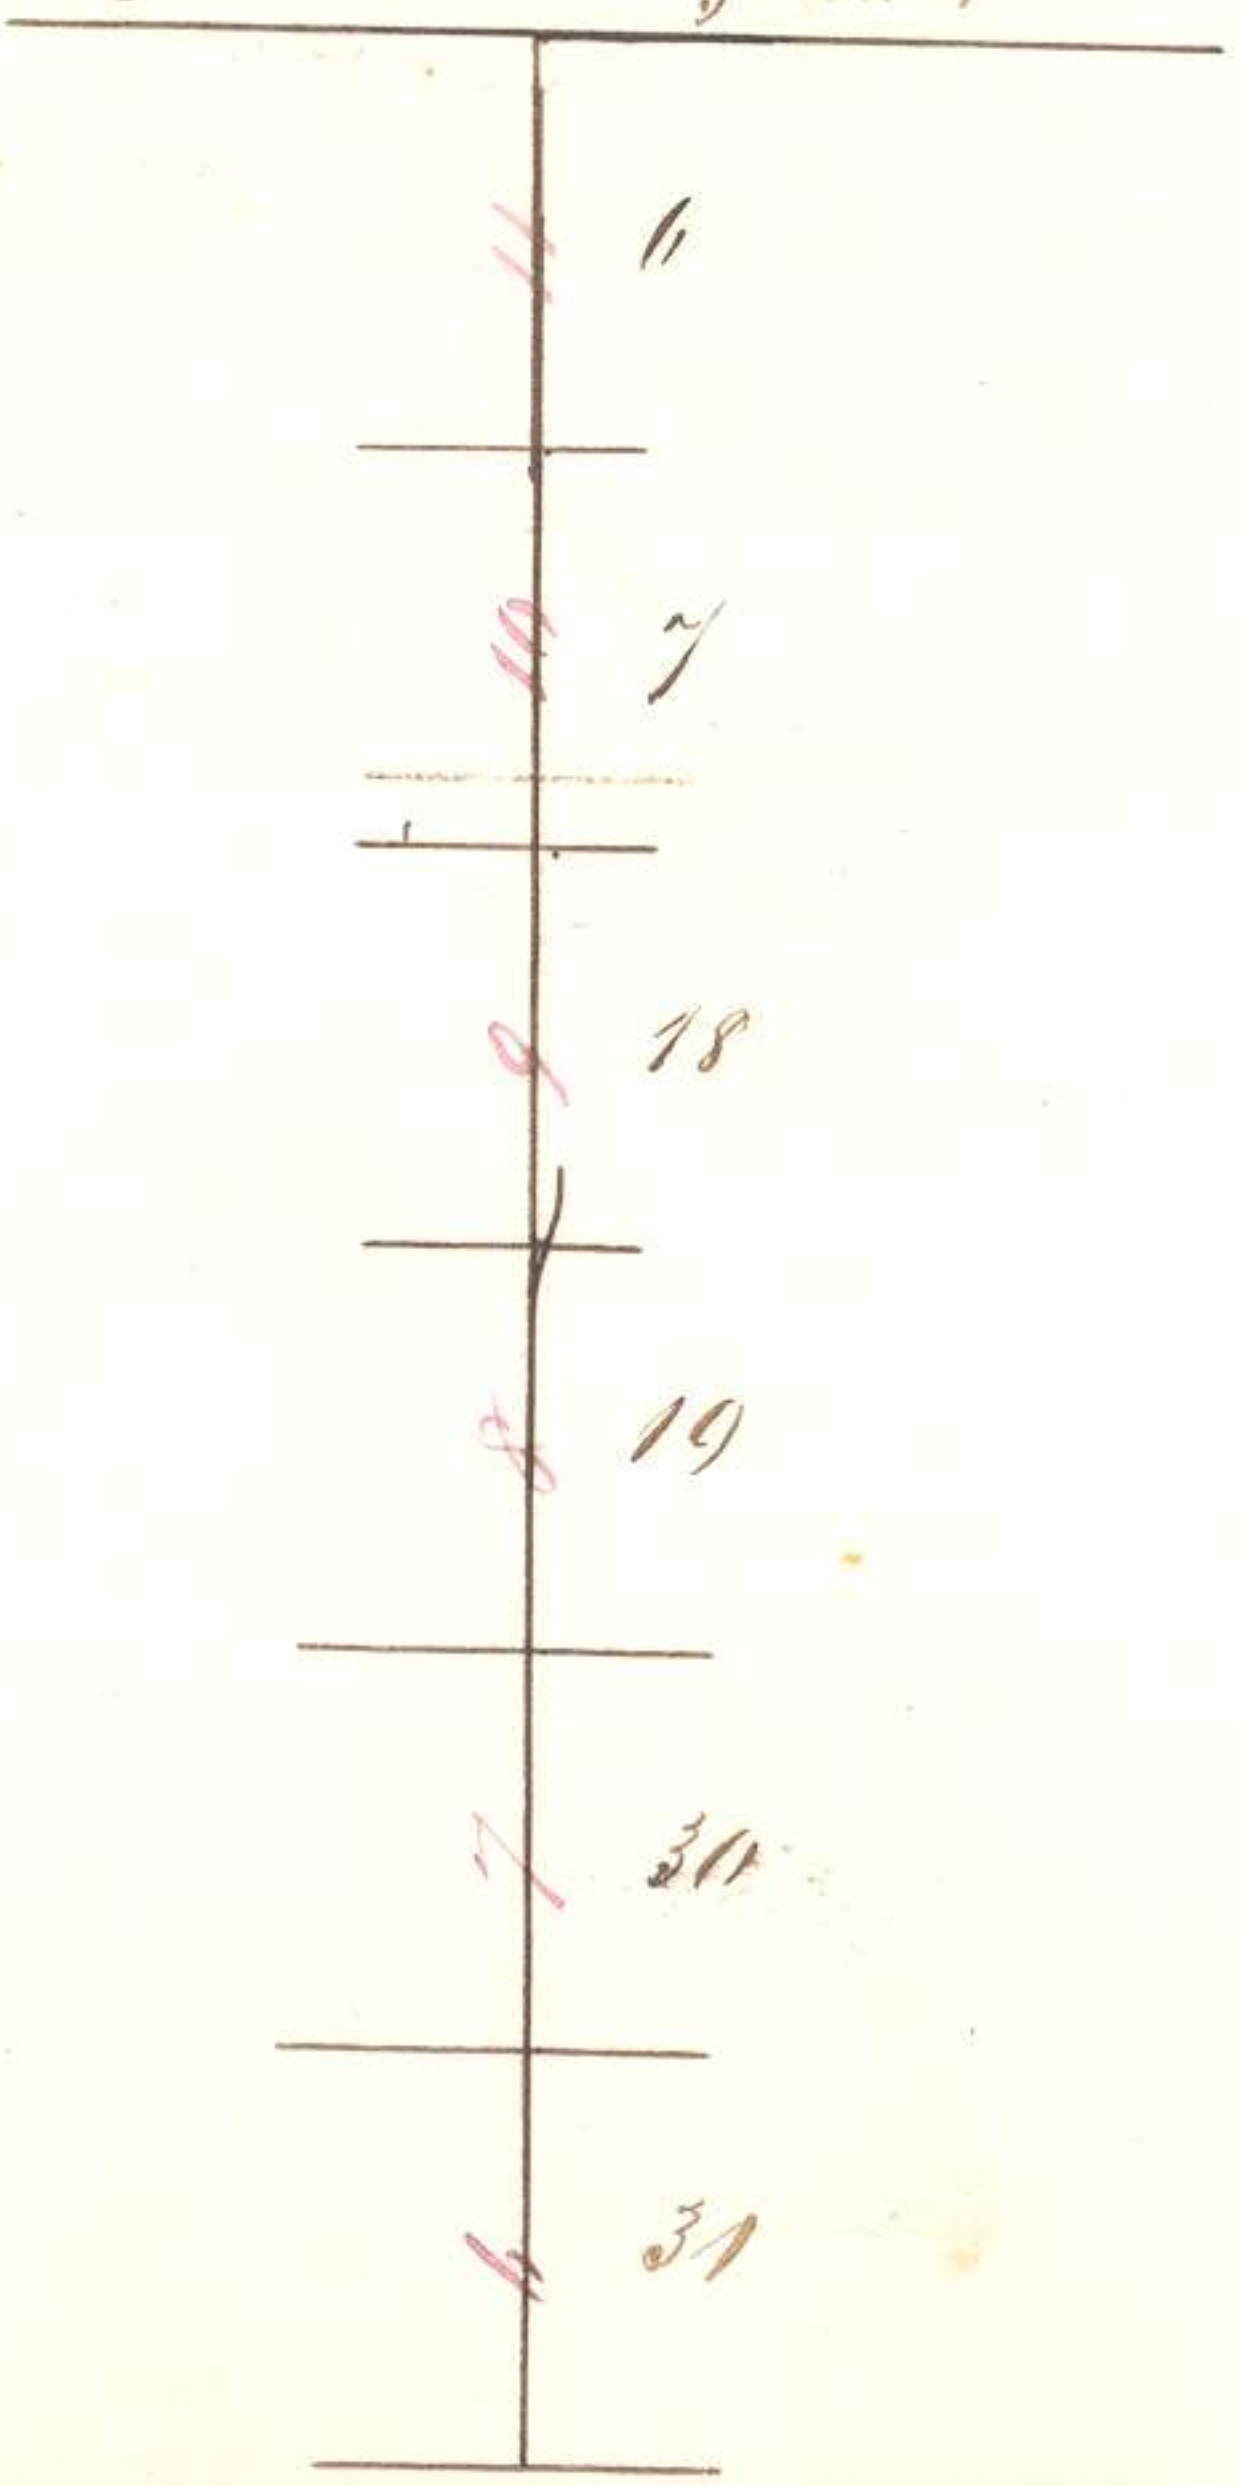

Township 4<sup>th</sup> N. R. 30<sup>th</sup> W. 11<sup>th</sup> N. Meridian  
chains

North, Between Secs 1 & 6

Variation 20° 45' E.

44.00 Set post for quarter section  
corner. Drove a char'd stake  
raised mound of earth with  
trench and pits, as per  
instructions.

79.90 Intersect 1<sup>st</sup> Standard  
parallel North, 7<sup>th</sup> ~~11<sup>th</sup>~~ chains,  
West of standard corner,  
Drove a char'd stake for  
closing corner to sec 1 & 6 & raised  
in mound of earth with trench  
and pits, as per instructions,  
A big rock near the mouth of  
the Umatilla river bears S 89° W.  
from closing corner. Land  
rolling prairie Soil 3<sup>rd</sup> rate  
& sandy.

October 13<sup>th</sup> 1860

190

## List of names.

A list of the names of the individuals employed to assist in running, measuring, or marking the lines and corners described in the foregoing field notes of <sup>the Survey of</sup> Township No. 4 North of the Base Line of Range No. 29 East of the Pittamette Meridian, showing the <sup>respective</sup> capacities in which they acted;

Samuel Campbell chairman  
 Joseph Tompkins chairman  
 Robert Farfield Assessor

We hereby certify that we assisted  
 Wm. B. Campbell deputy surveyor  
 in surveying the exterior ~~line~~  
~~lines~~ of Township number  
 four North of the base line of Ranges  
 number twenty nine and thirty  
 East of the Pittamette Meridian,

and that said Townships lines  
 have been in all respects to the  
 best of our knowledge and belief  
 well and faithfully surveyed,  
 and the boundary monuments  
 planted according to the  
 instructions furnished by the  
 Surveyor General,  
 Samuel L. Campbell chairman  
 Josephus Tompkins chairman  
 Robert F. Caufield Assessor

Subscribed and sworn to  
 before me this 3<sup>rd</sup> day of Decr  
 AD 1860, <sup>at Oregon city</sup> J. C. Dawson  
 Clerk of the Circuit  
 Court for the County  
 of Clackamas State  
 of Oregon

192

Wm. D. Campbell, deputy surveyor

do solemnly swear that, in pursuance  
of a contract with W. H. Chapman.

Surveyor of the public lands of the  
United States, in ~~the~~ ~~state~~ of Oregon,  
bearing date the 19<sup>th</sup> day of September  
1860, and in strict conformity to the  
laws of the United States, and the  
instructions furnished by the said  
Surveyor General, I have faithfully  
surveyed, the exterior boundaries of  
Townships number four North  
of the base of Ranges number twenty-  
nine and thirty East of the Willam-  
ette Meridian, in the State afore-  
said, and do further solemnly  
swear that the foregoing are  
the true and original field  
notes of such surveys.

Wm. D. Campbell

Deputy Surveyor

Subscribed and sworn  
to before me at Oregon



City this 3<sup>rd</sup> day of December  
AD 1860

Geo. W. W. W. W.  
Clerk of the Circuit  
~~Court~~ for Blackham  
County State of Oregon

194

Surveyor General's Office,  
Eugene City, Jan'y 29<sup>th</sup> 1860.  
The foregoing field notes of  
the Survey of the Exterior Line  
of Townships No. 4 North of  
Ranges No. 29 & 30 East of  
the Willamette Meridian; ex-  
ecuted by Wm. B. Campbell,  
deputy Surveyor, under his con-  
tract of the 19<sup>th</sup> day of Septem-  
ber 1860 - having been critically  
examined, the necessary cor-  
rections and explanations  
made, the said field notes  
and the surveys they describe  
are hereby approved.

A. N. Chapman  
Sur: Genl. of Oregon